

W.K. France

ROCK CREEK

15

14

13

16

17

W.P. West

18

19

J.E. Stephens

B. Marick

20

22

23

24

16

6

23

10

14

52

4

17

12

15

22

19

08

106

114

146

52

236

17

112

126

155

222

191

08

56




































W.K. France  
Ditch

CROSS

ROCK

CREEK

BRUSH

BRUSH

BRUSH

BRUSH


BRUSH

ANGE 20 E.


4-2-1

	1
3	2

	12
10	11

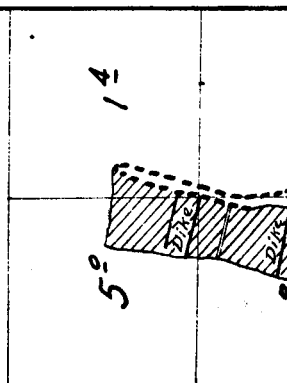

23

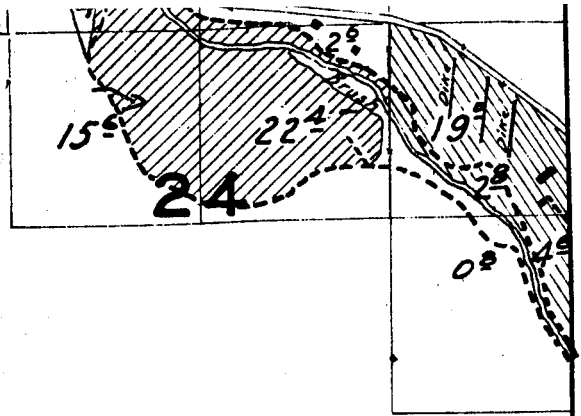

26

25



35

36

19

20


30


29

02  
old ditches  
JOHN DAY RIVER

31

32

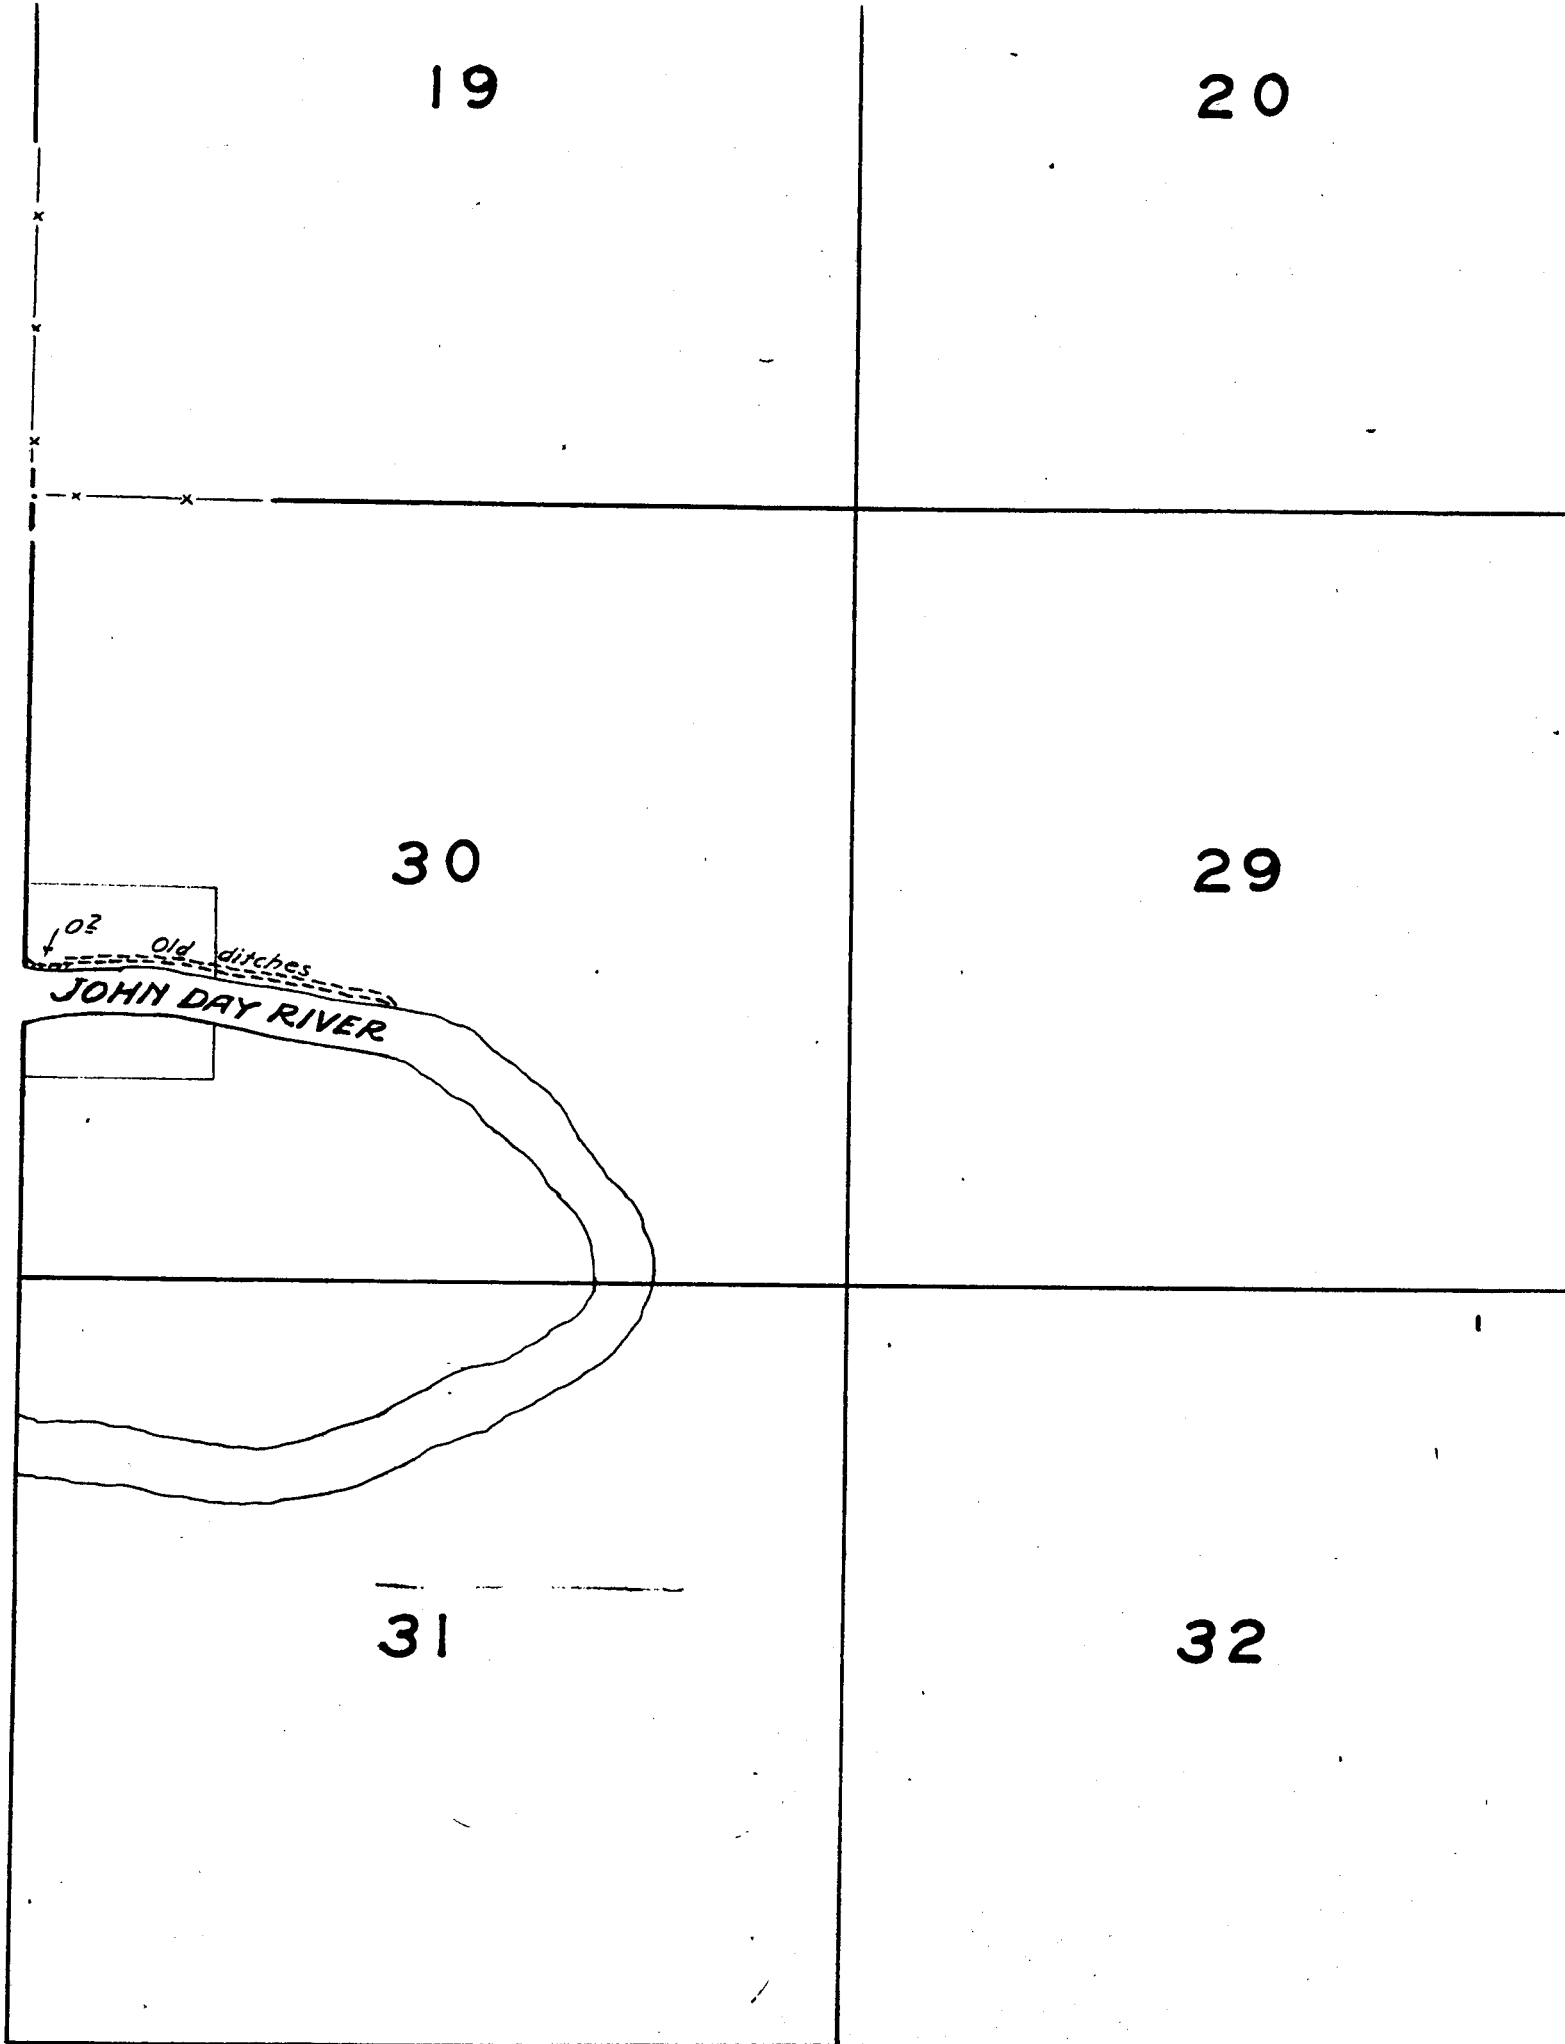

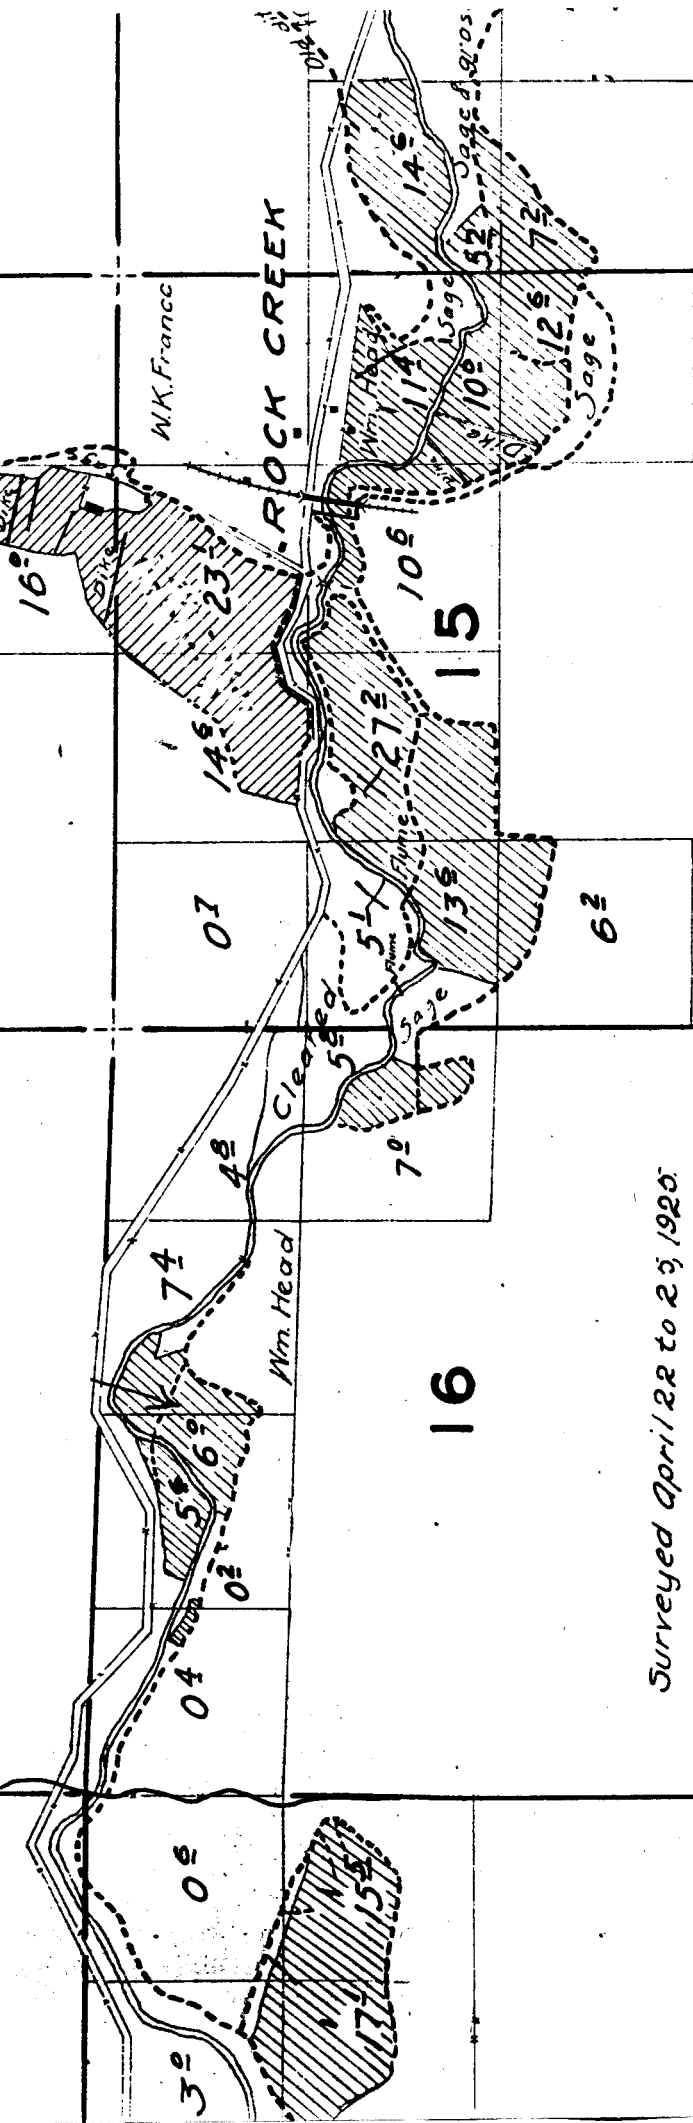

Surveyed April 22 to 29, 1920.

21

Note:  
Streams and roads, except in  
the vicinity of irrigated land,  
are sketched in approximate  
location.

22


28

27

33

34



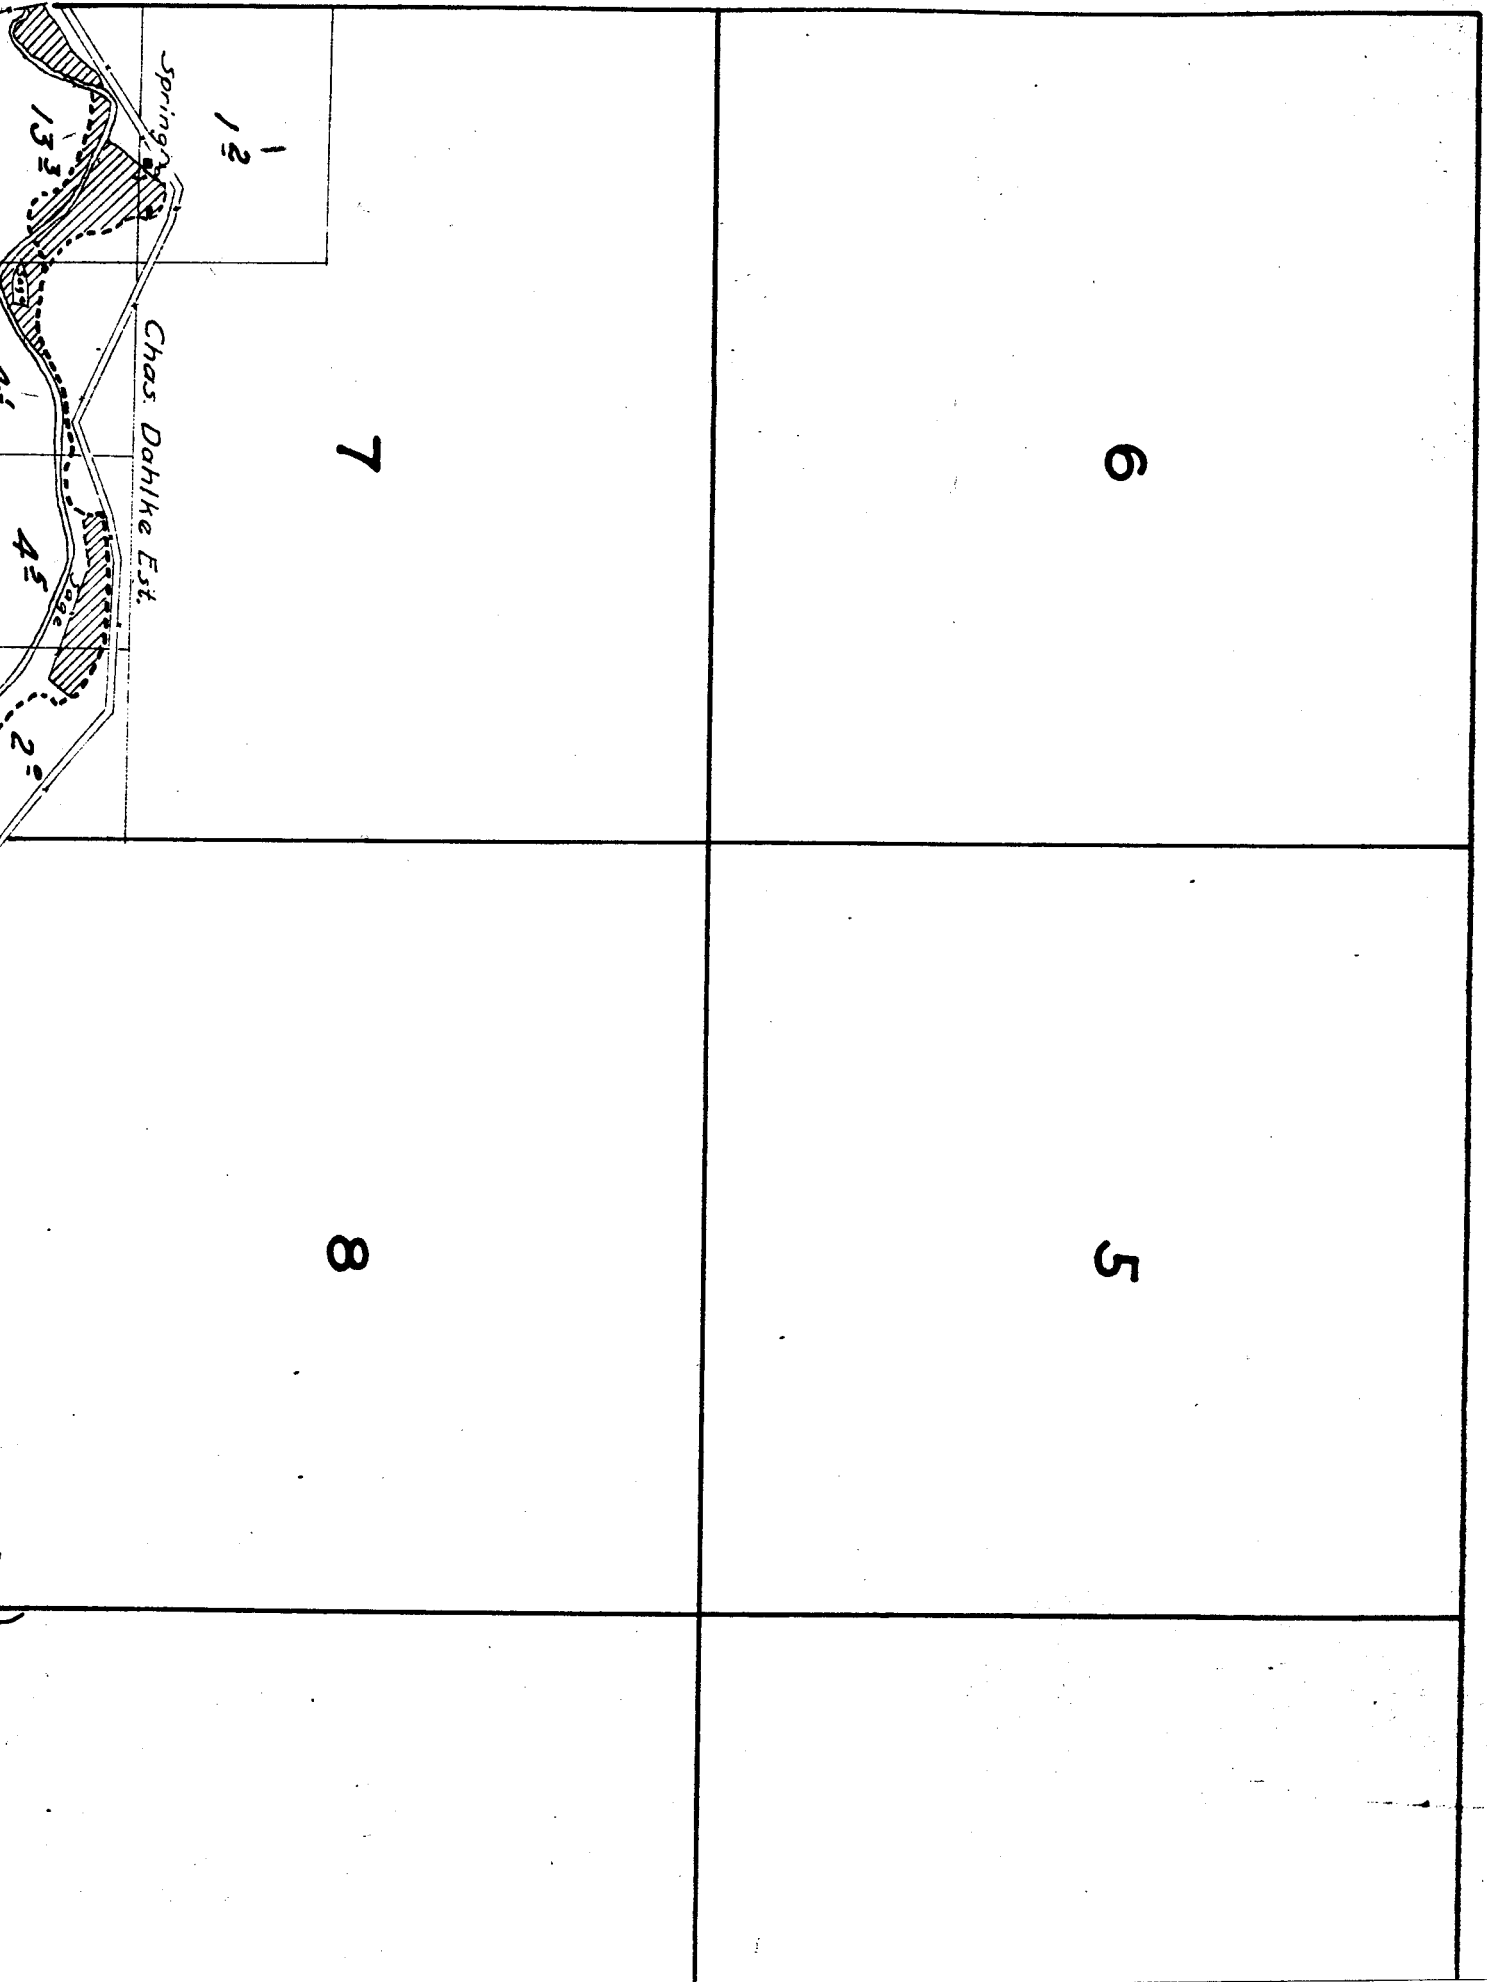



# TOWNSHIP 1 N., RANGE 20 E

4

3

9

10

