


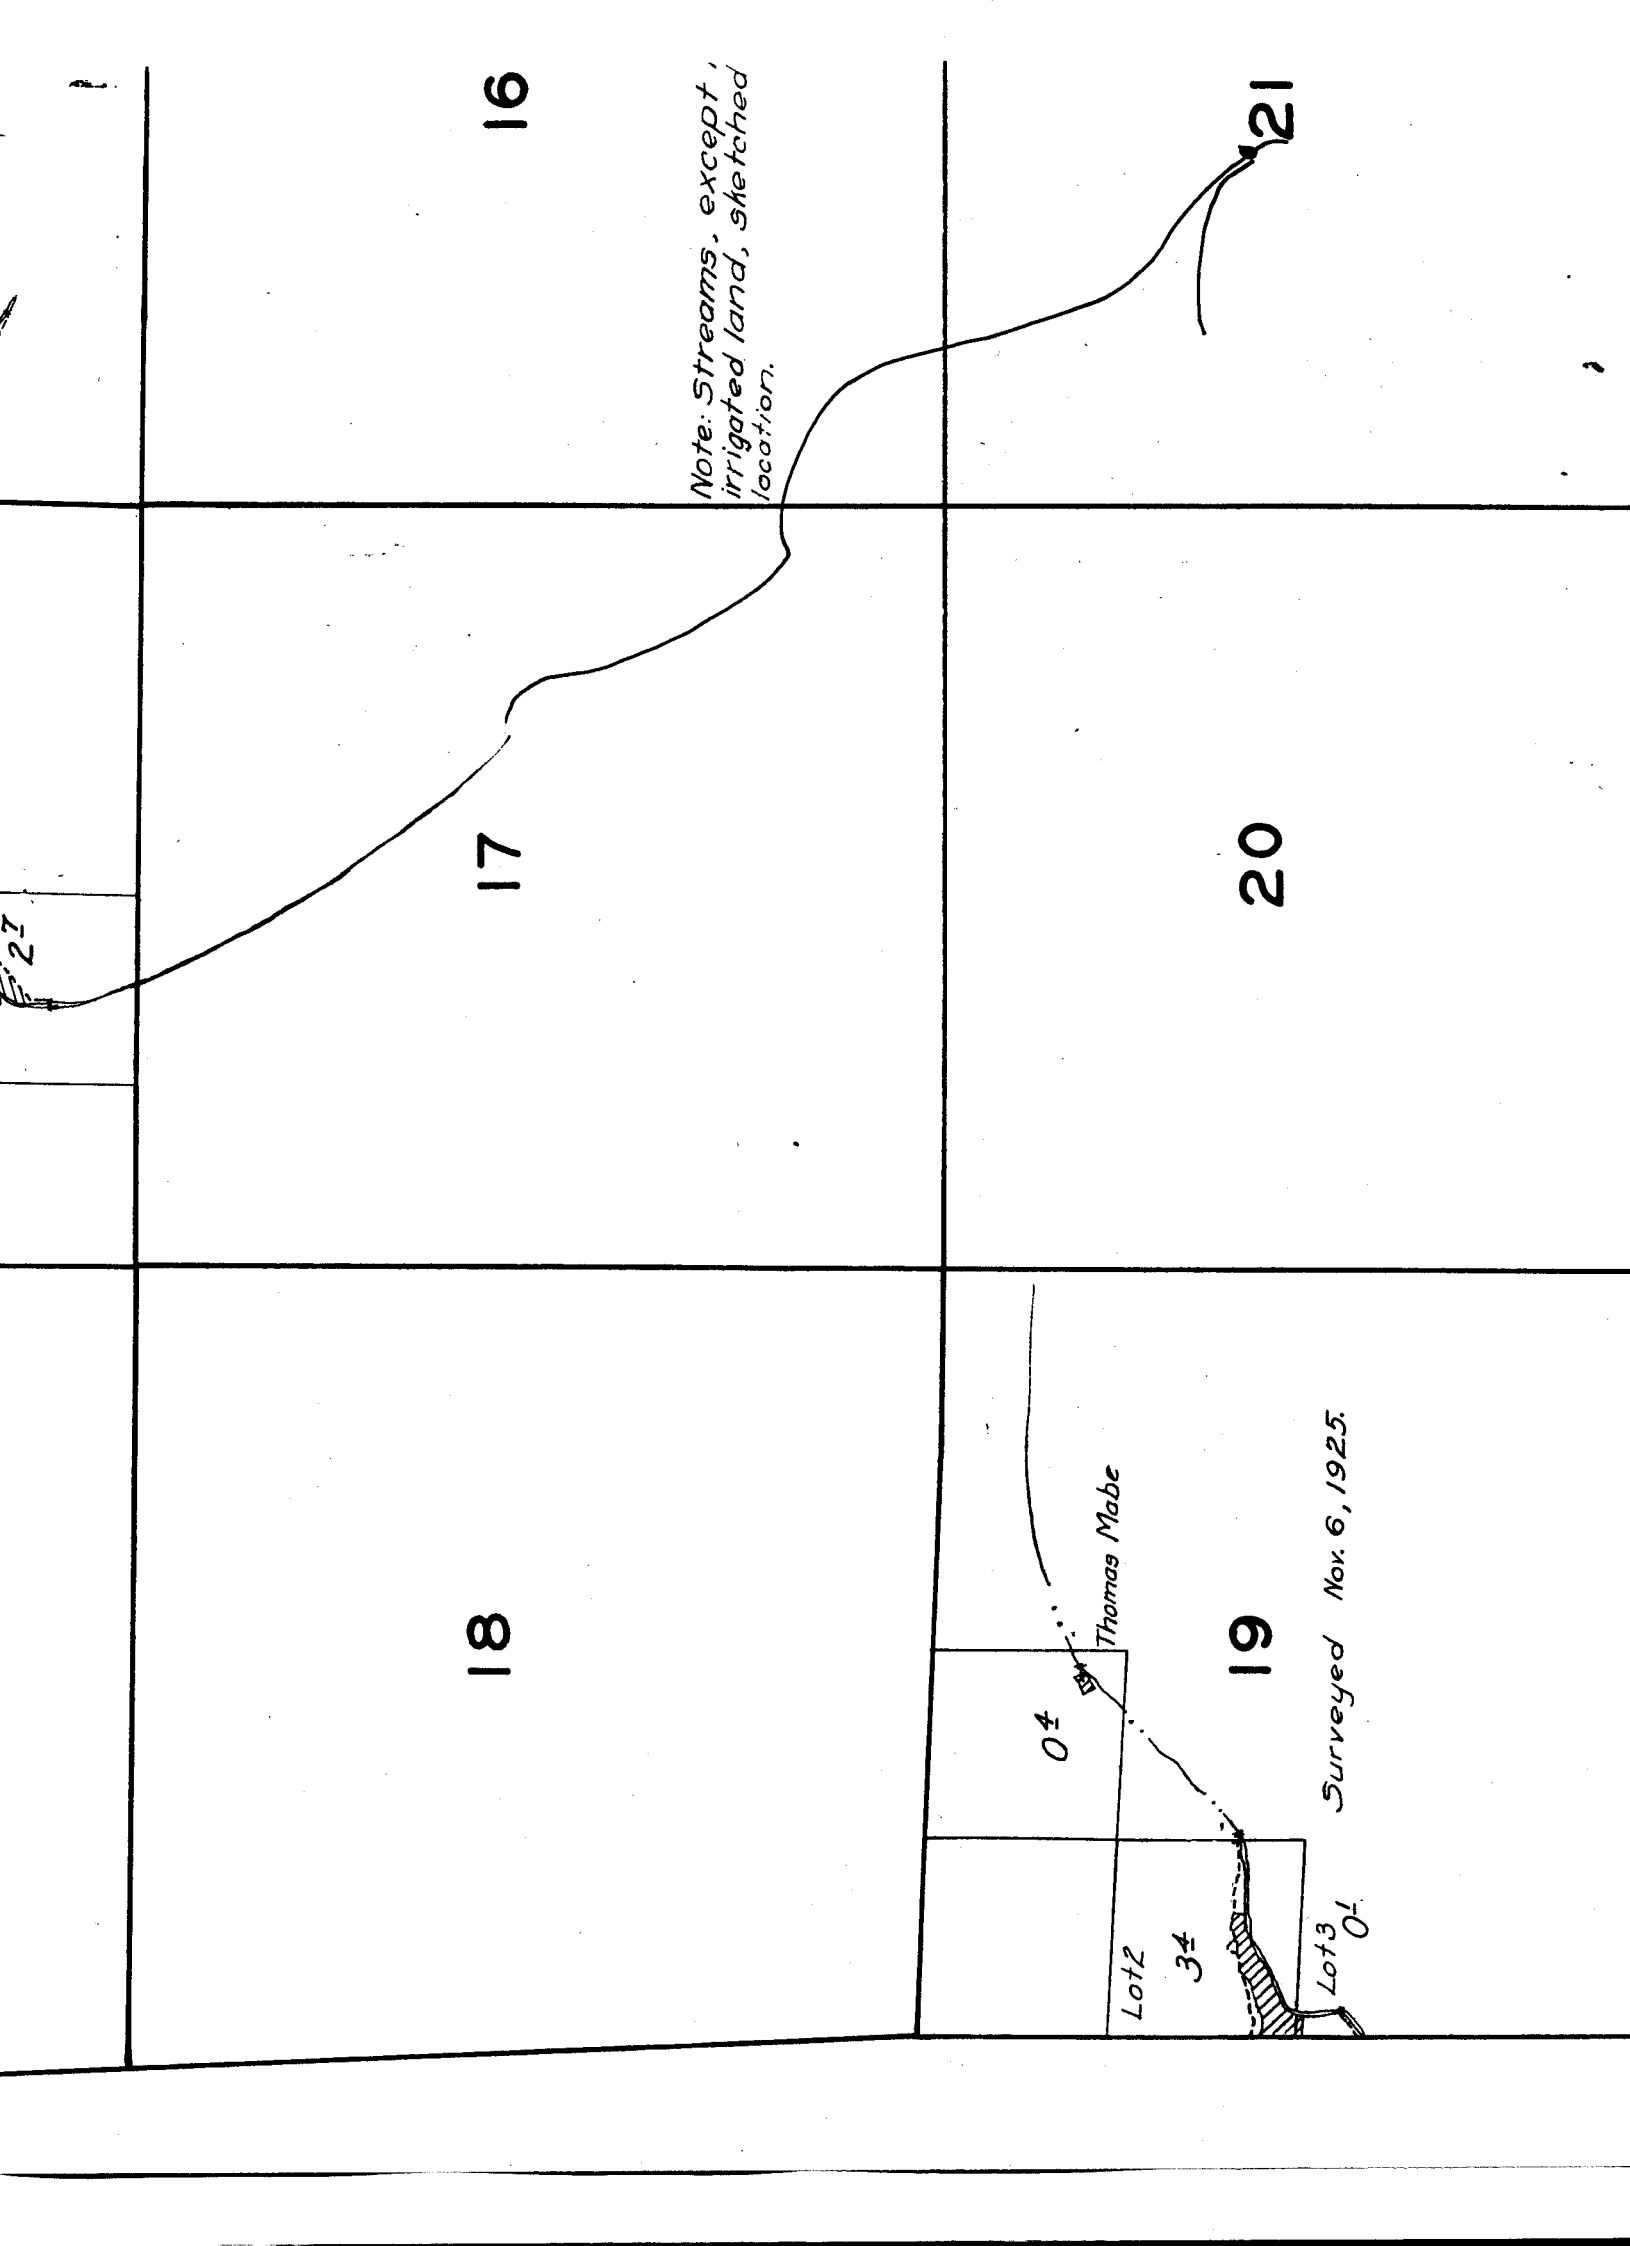

16

*Note: Streams, except,
irrigated land, sketched
location.*

21

17

20

18

19

Thomas Mabe

Surveyed Nov. 6, 1925.

04


Lot 2

34

Lot 3

01

TOWNST

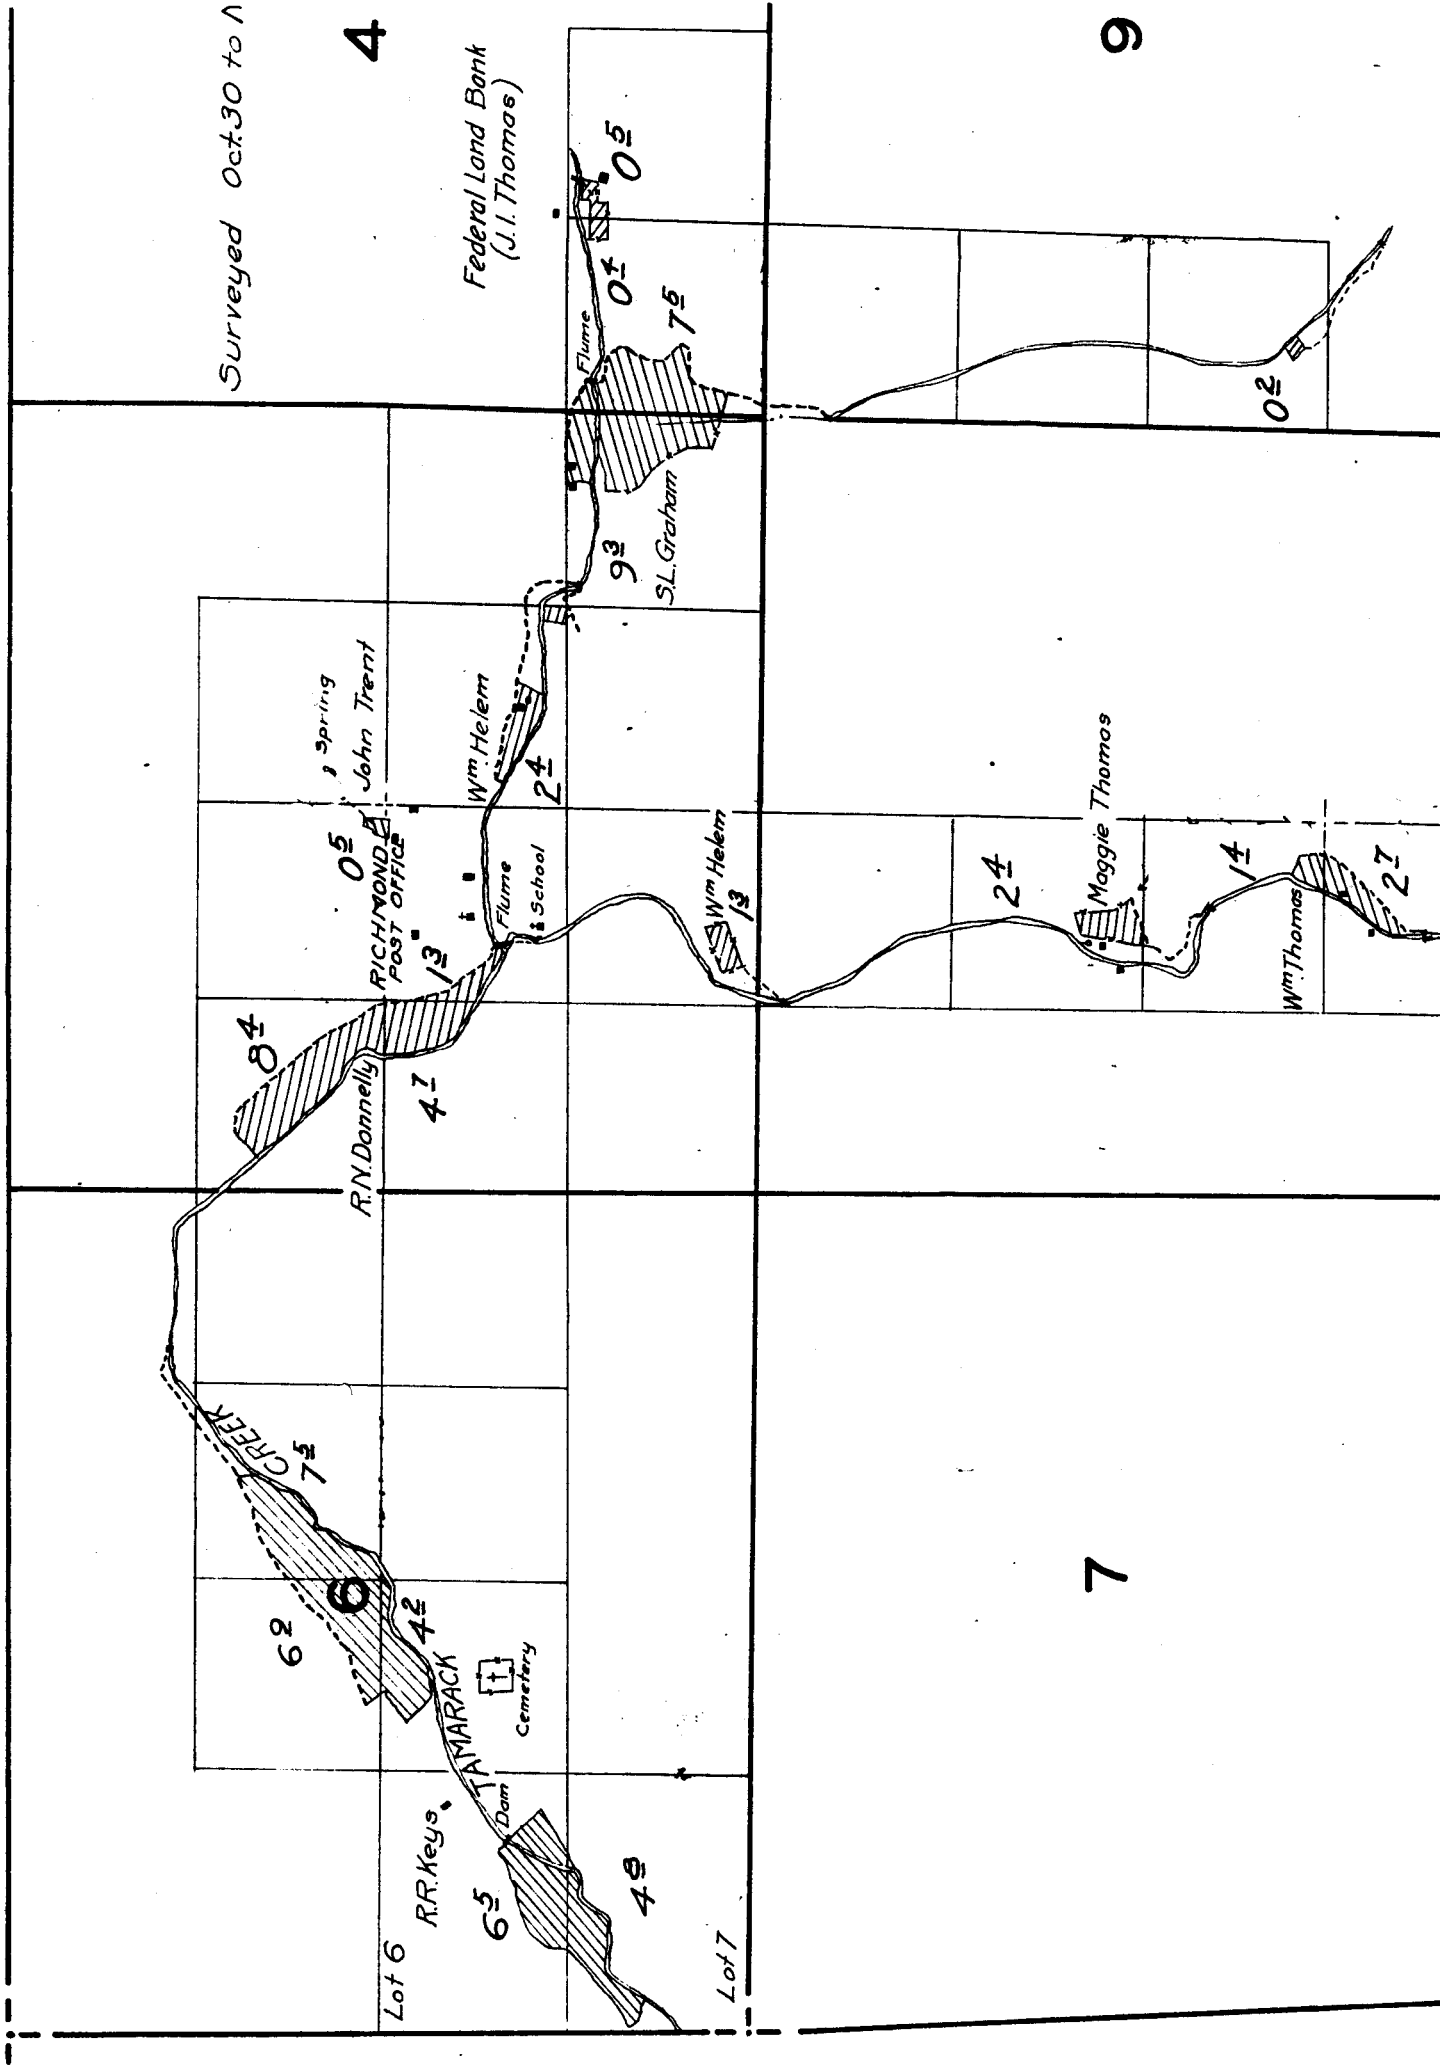

TOWNSHIP 10 S., RANGE 23 E.


urveyed Oct 30 to Nov. 3, 1925.

4

3

Federal Land Bank
(J.I. Thomas)

Note: Location of ditch & creek
sketched in field.

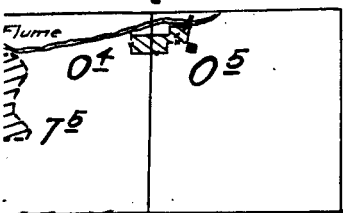

Lot 1

Lot 4



74
64

Thick

pin

9

10

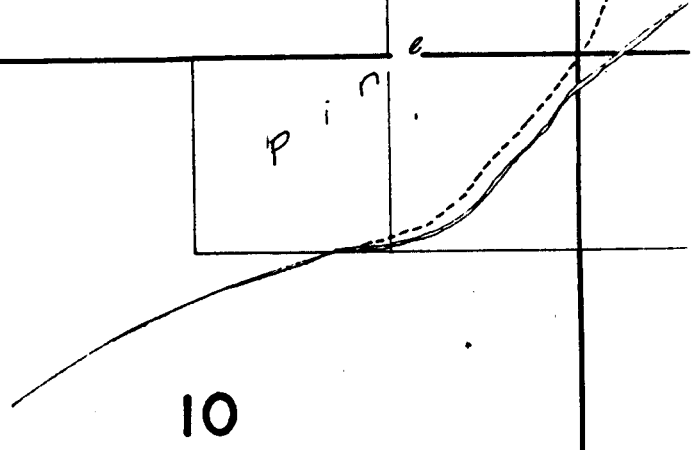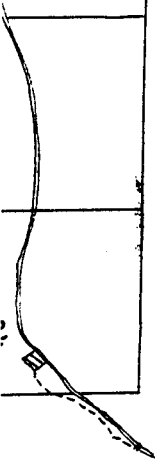

15

14

13


22

23

24

NE 23 E.

76-2-2

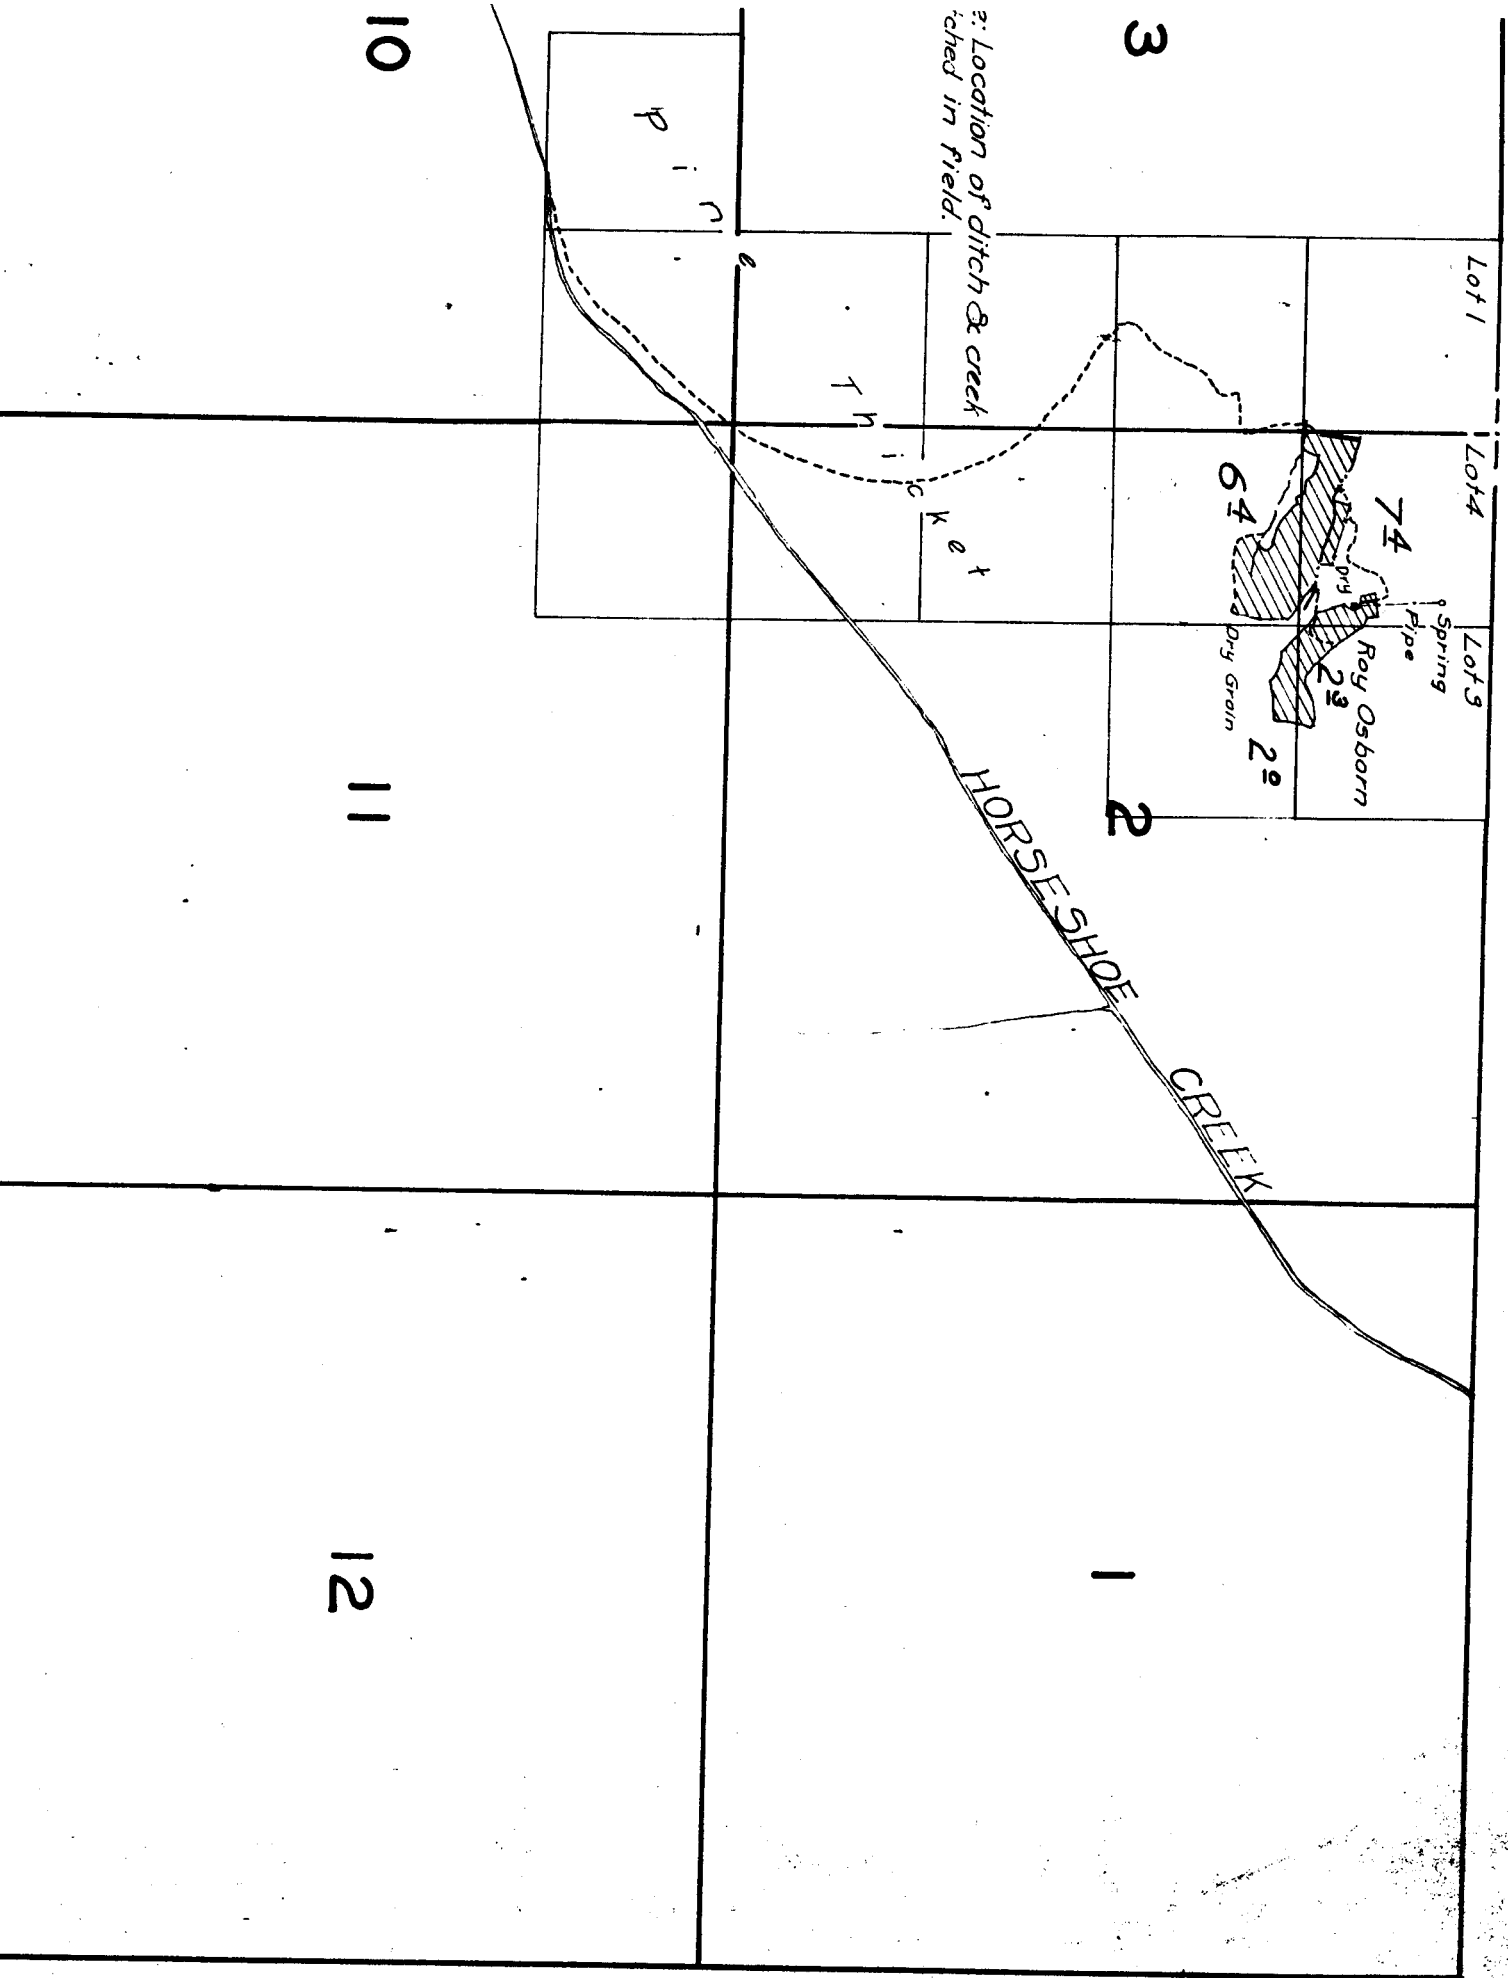

23


24

26

25

35

36

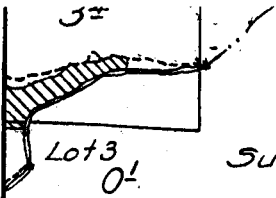


19

Surveyed Nov. 6, 1925.

20

30

29

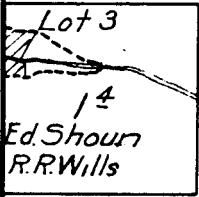

31

32

29

28

27

32

33

34

17

16

15

Note: Streams, except in the vicinity of irrigated land, sketched in approximate location.

20

21

22