



TOWNS

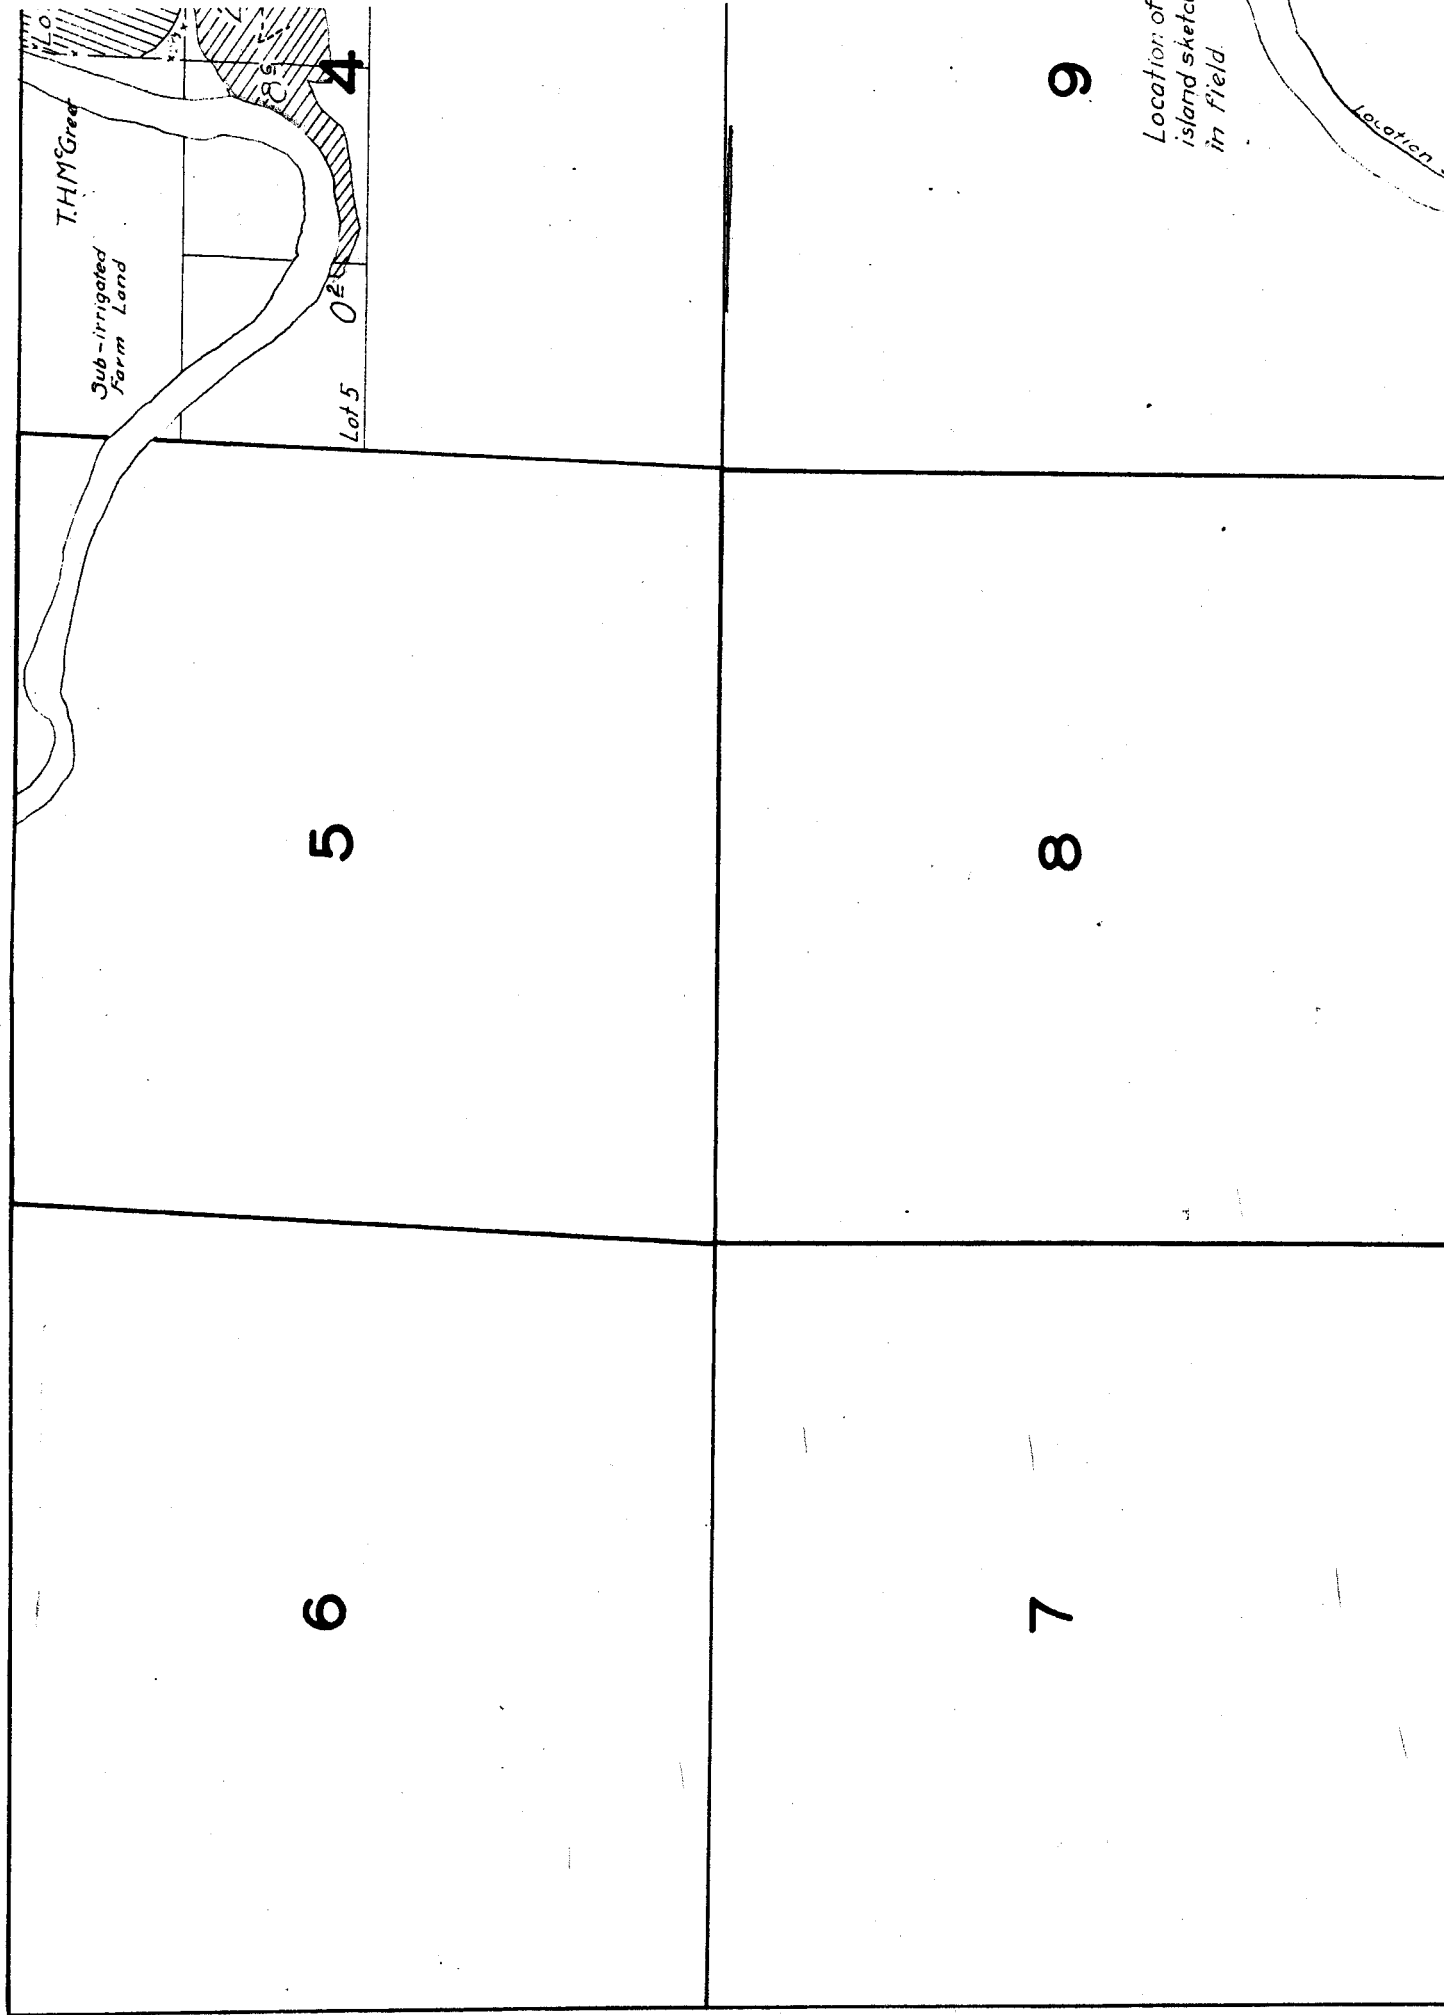

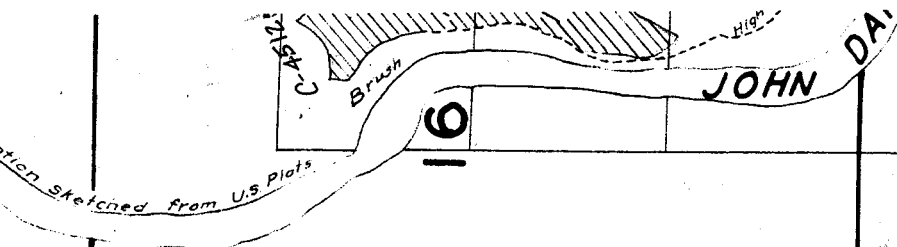

17


20

18

19

21

TOWNSHIP 8 S. RANGE 19 E.

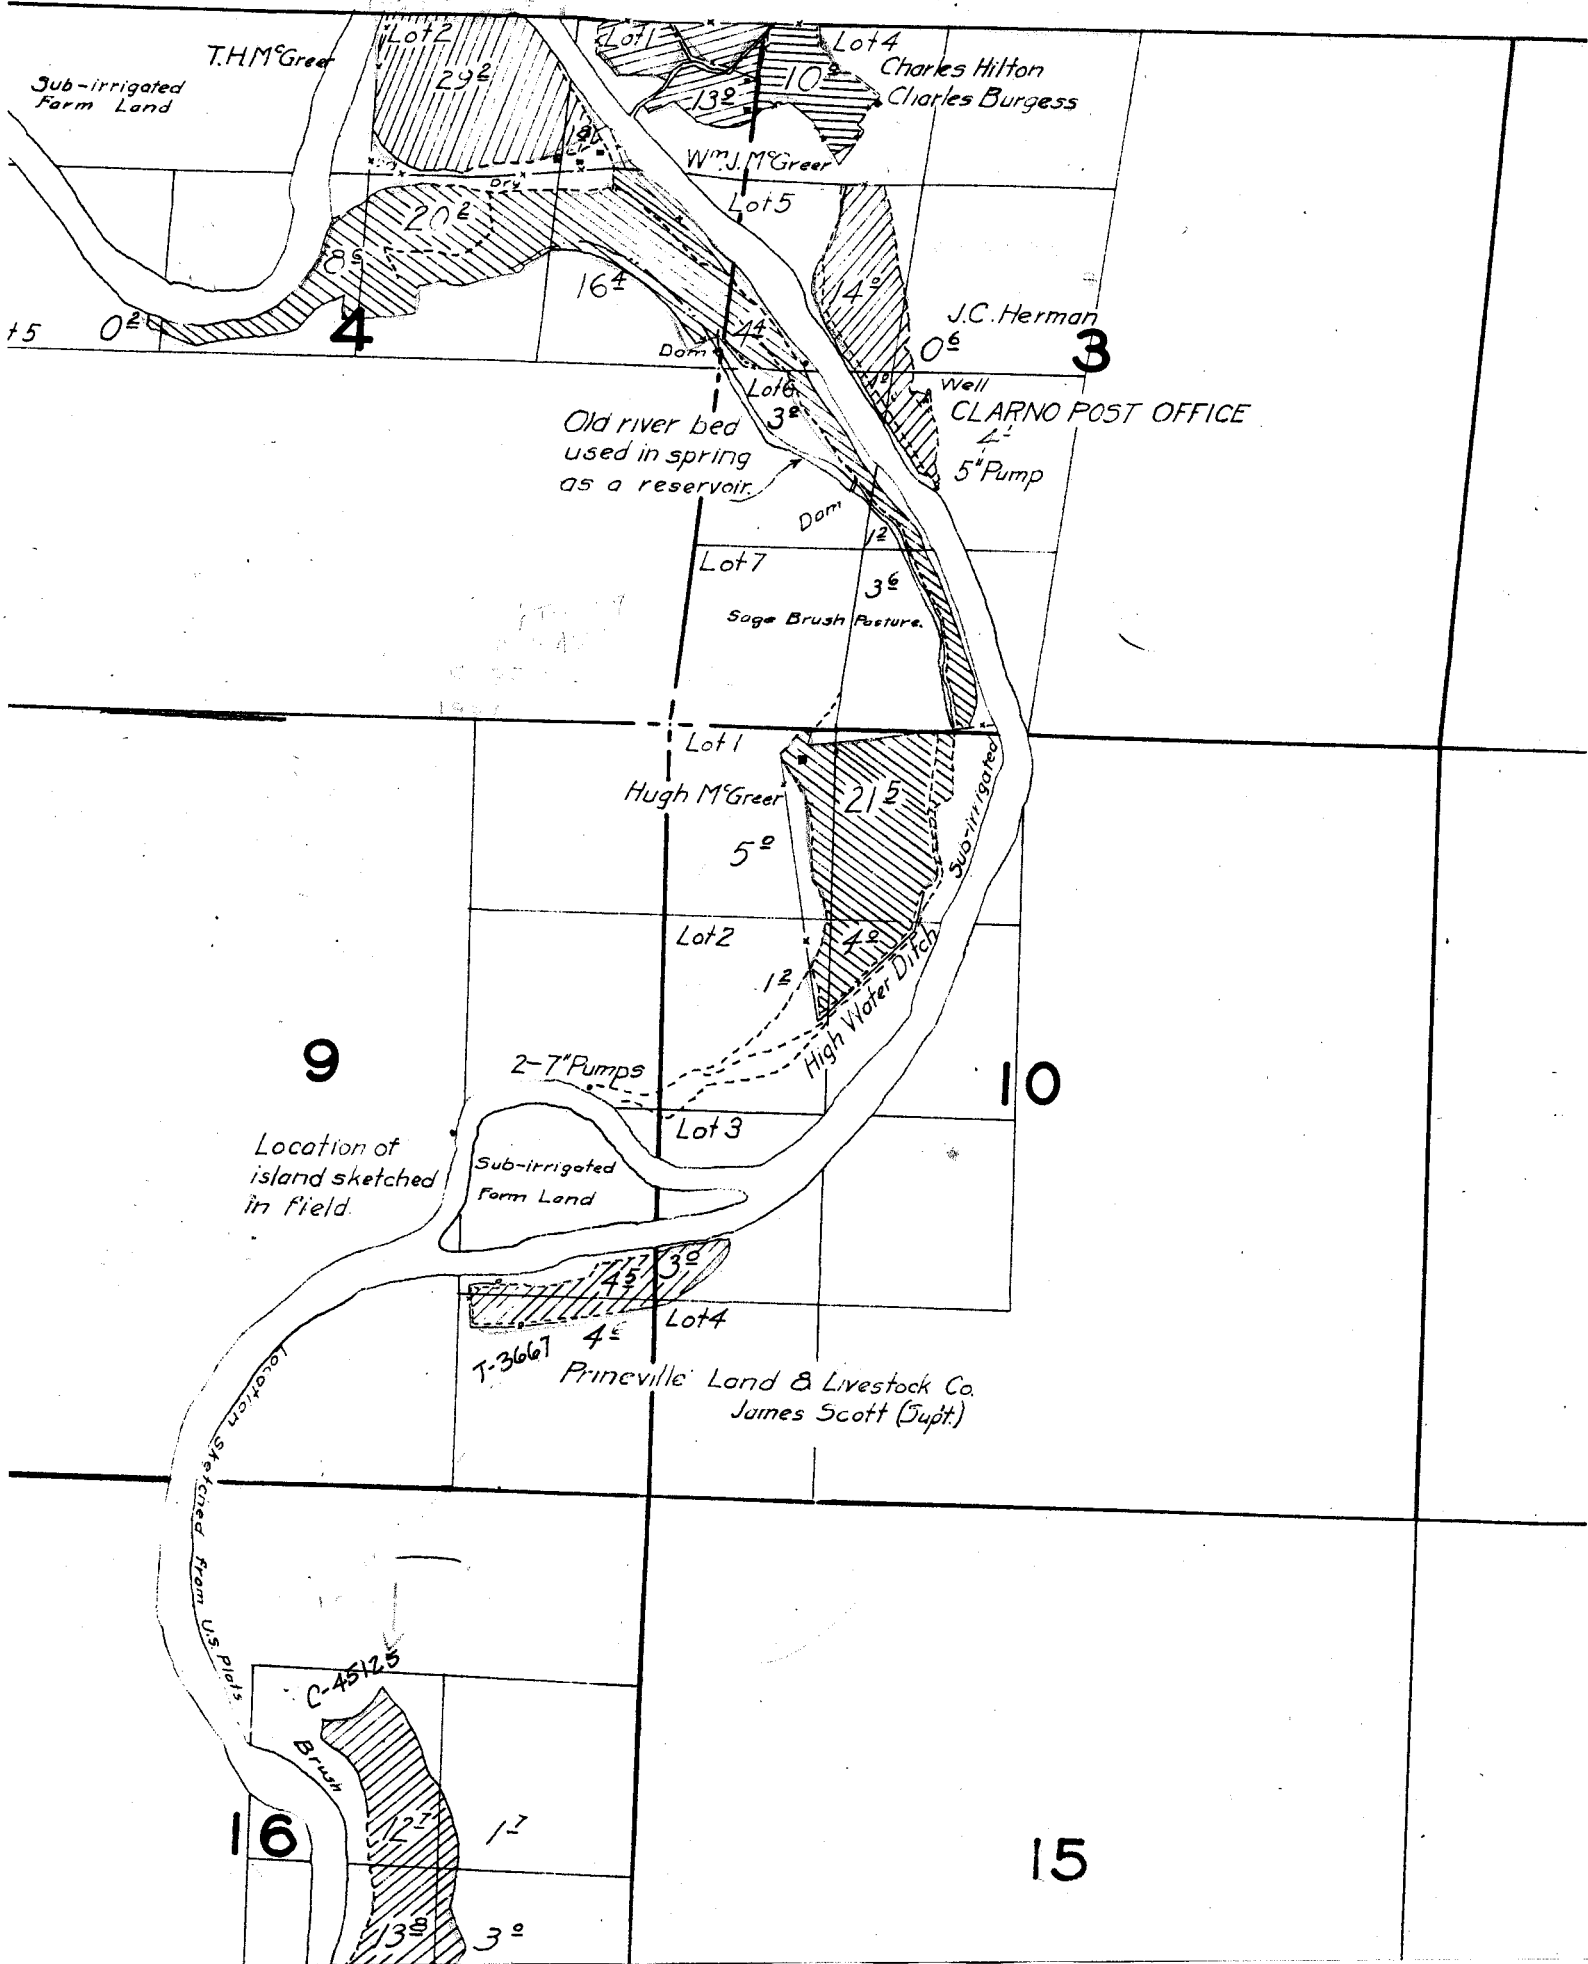

23

24

Location sketched from US Plats.

C.S. Hicks
Sub-irrigated
Farm Land

26

Rim Rock

4°

Sage

Brush

25


0°

6' Pump

35

36

Location sketched from US Plats.


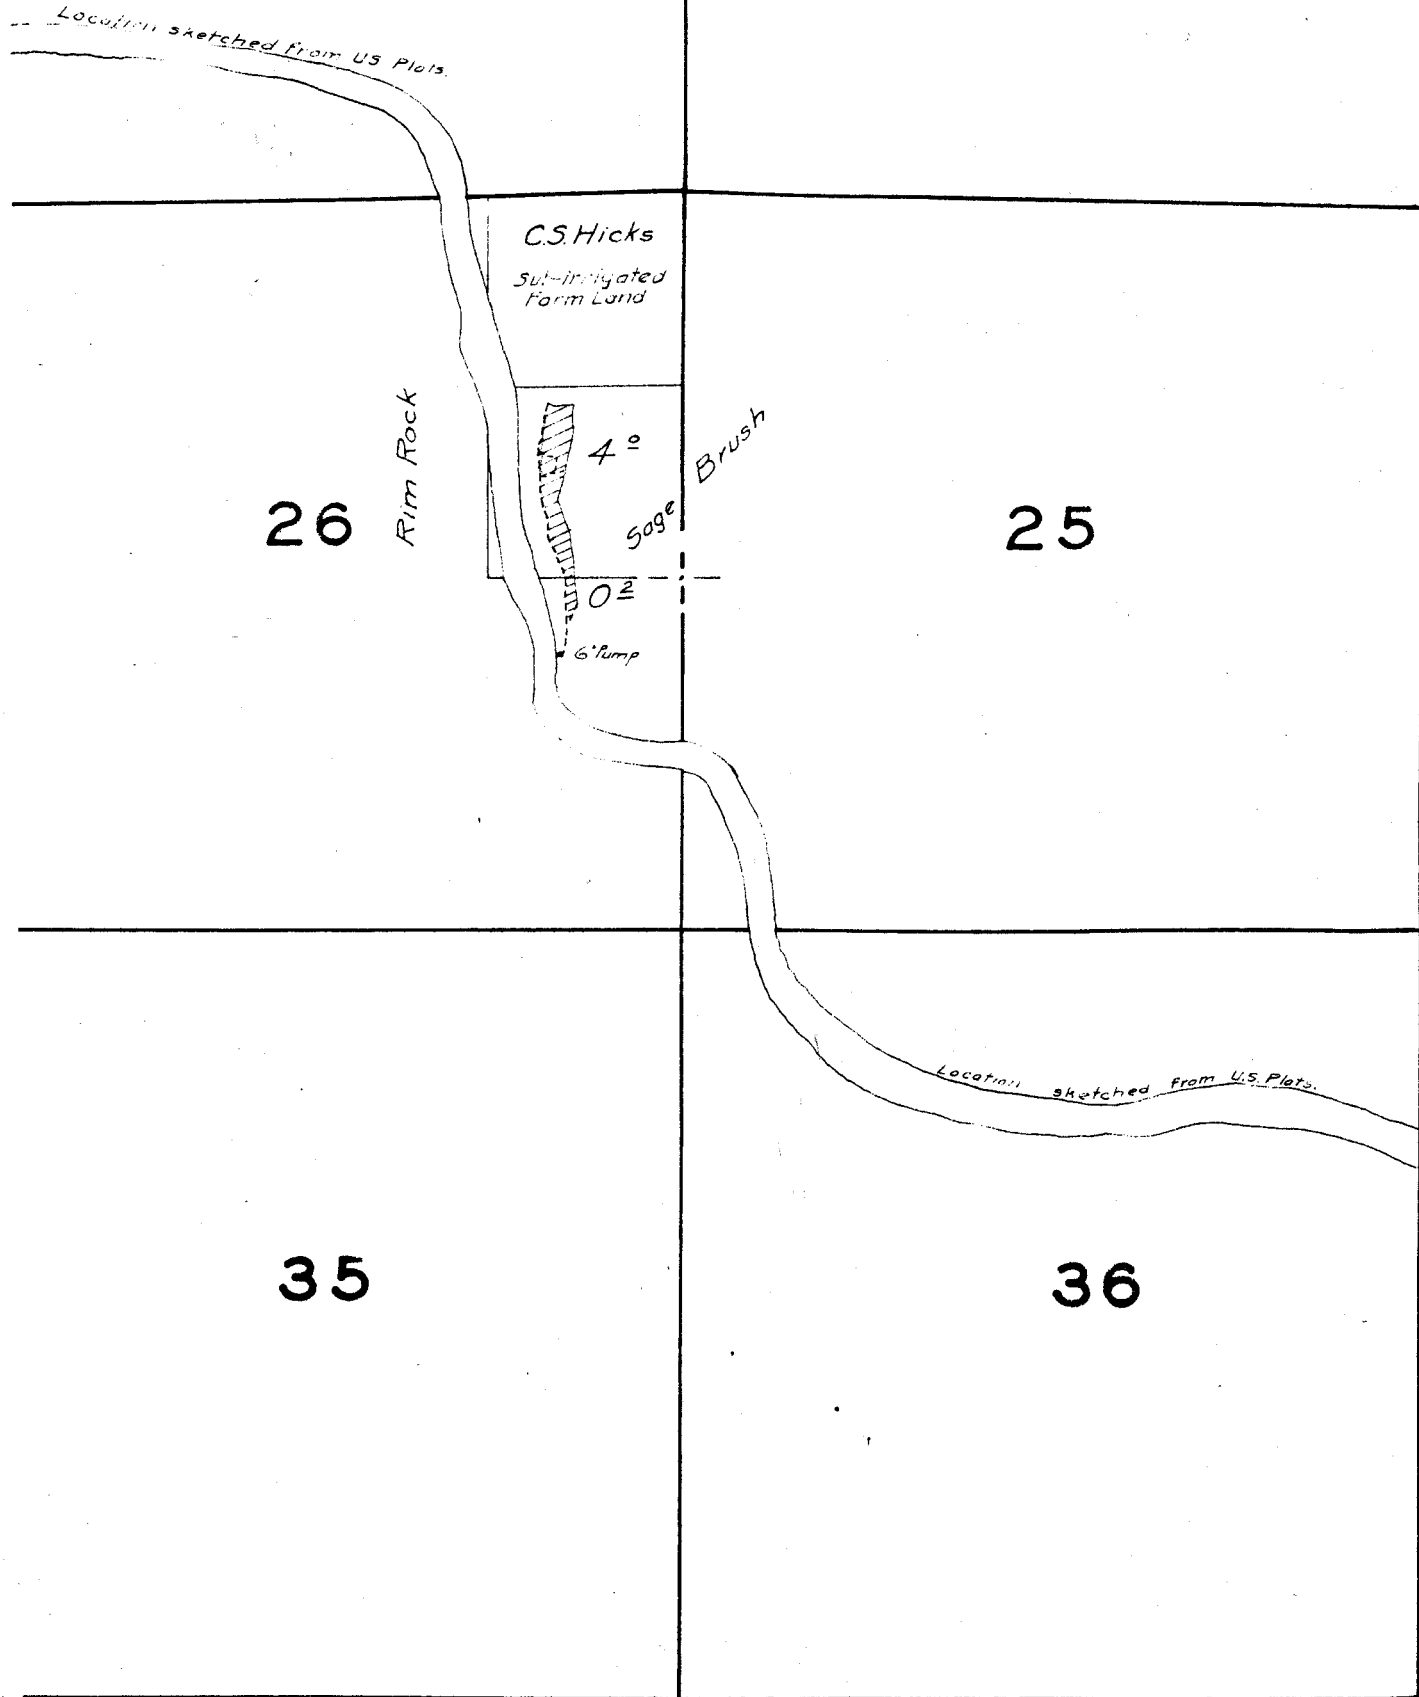


29

28

27

*509^e Pineville Land & Livestock Co
James Scott (Supt)*

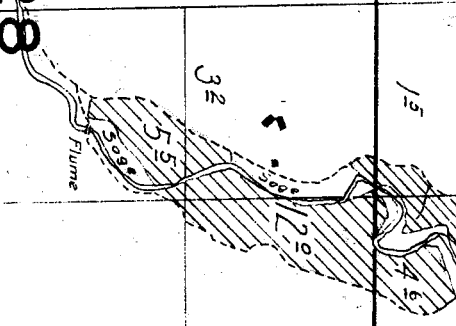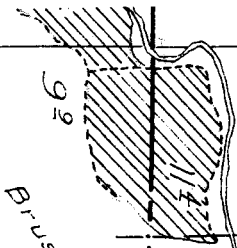

Brush
Sage
MUDDY
Rim
Rock
Junipers
and

Fume

32

33

34

17

16


15

20

21

22

Surveyed Aug. 16, 17, 18, 19, & 20, 1924

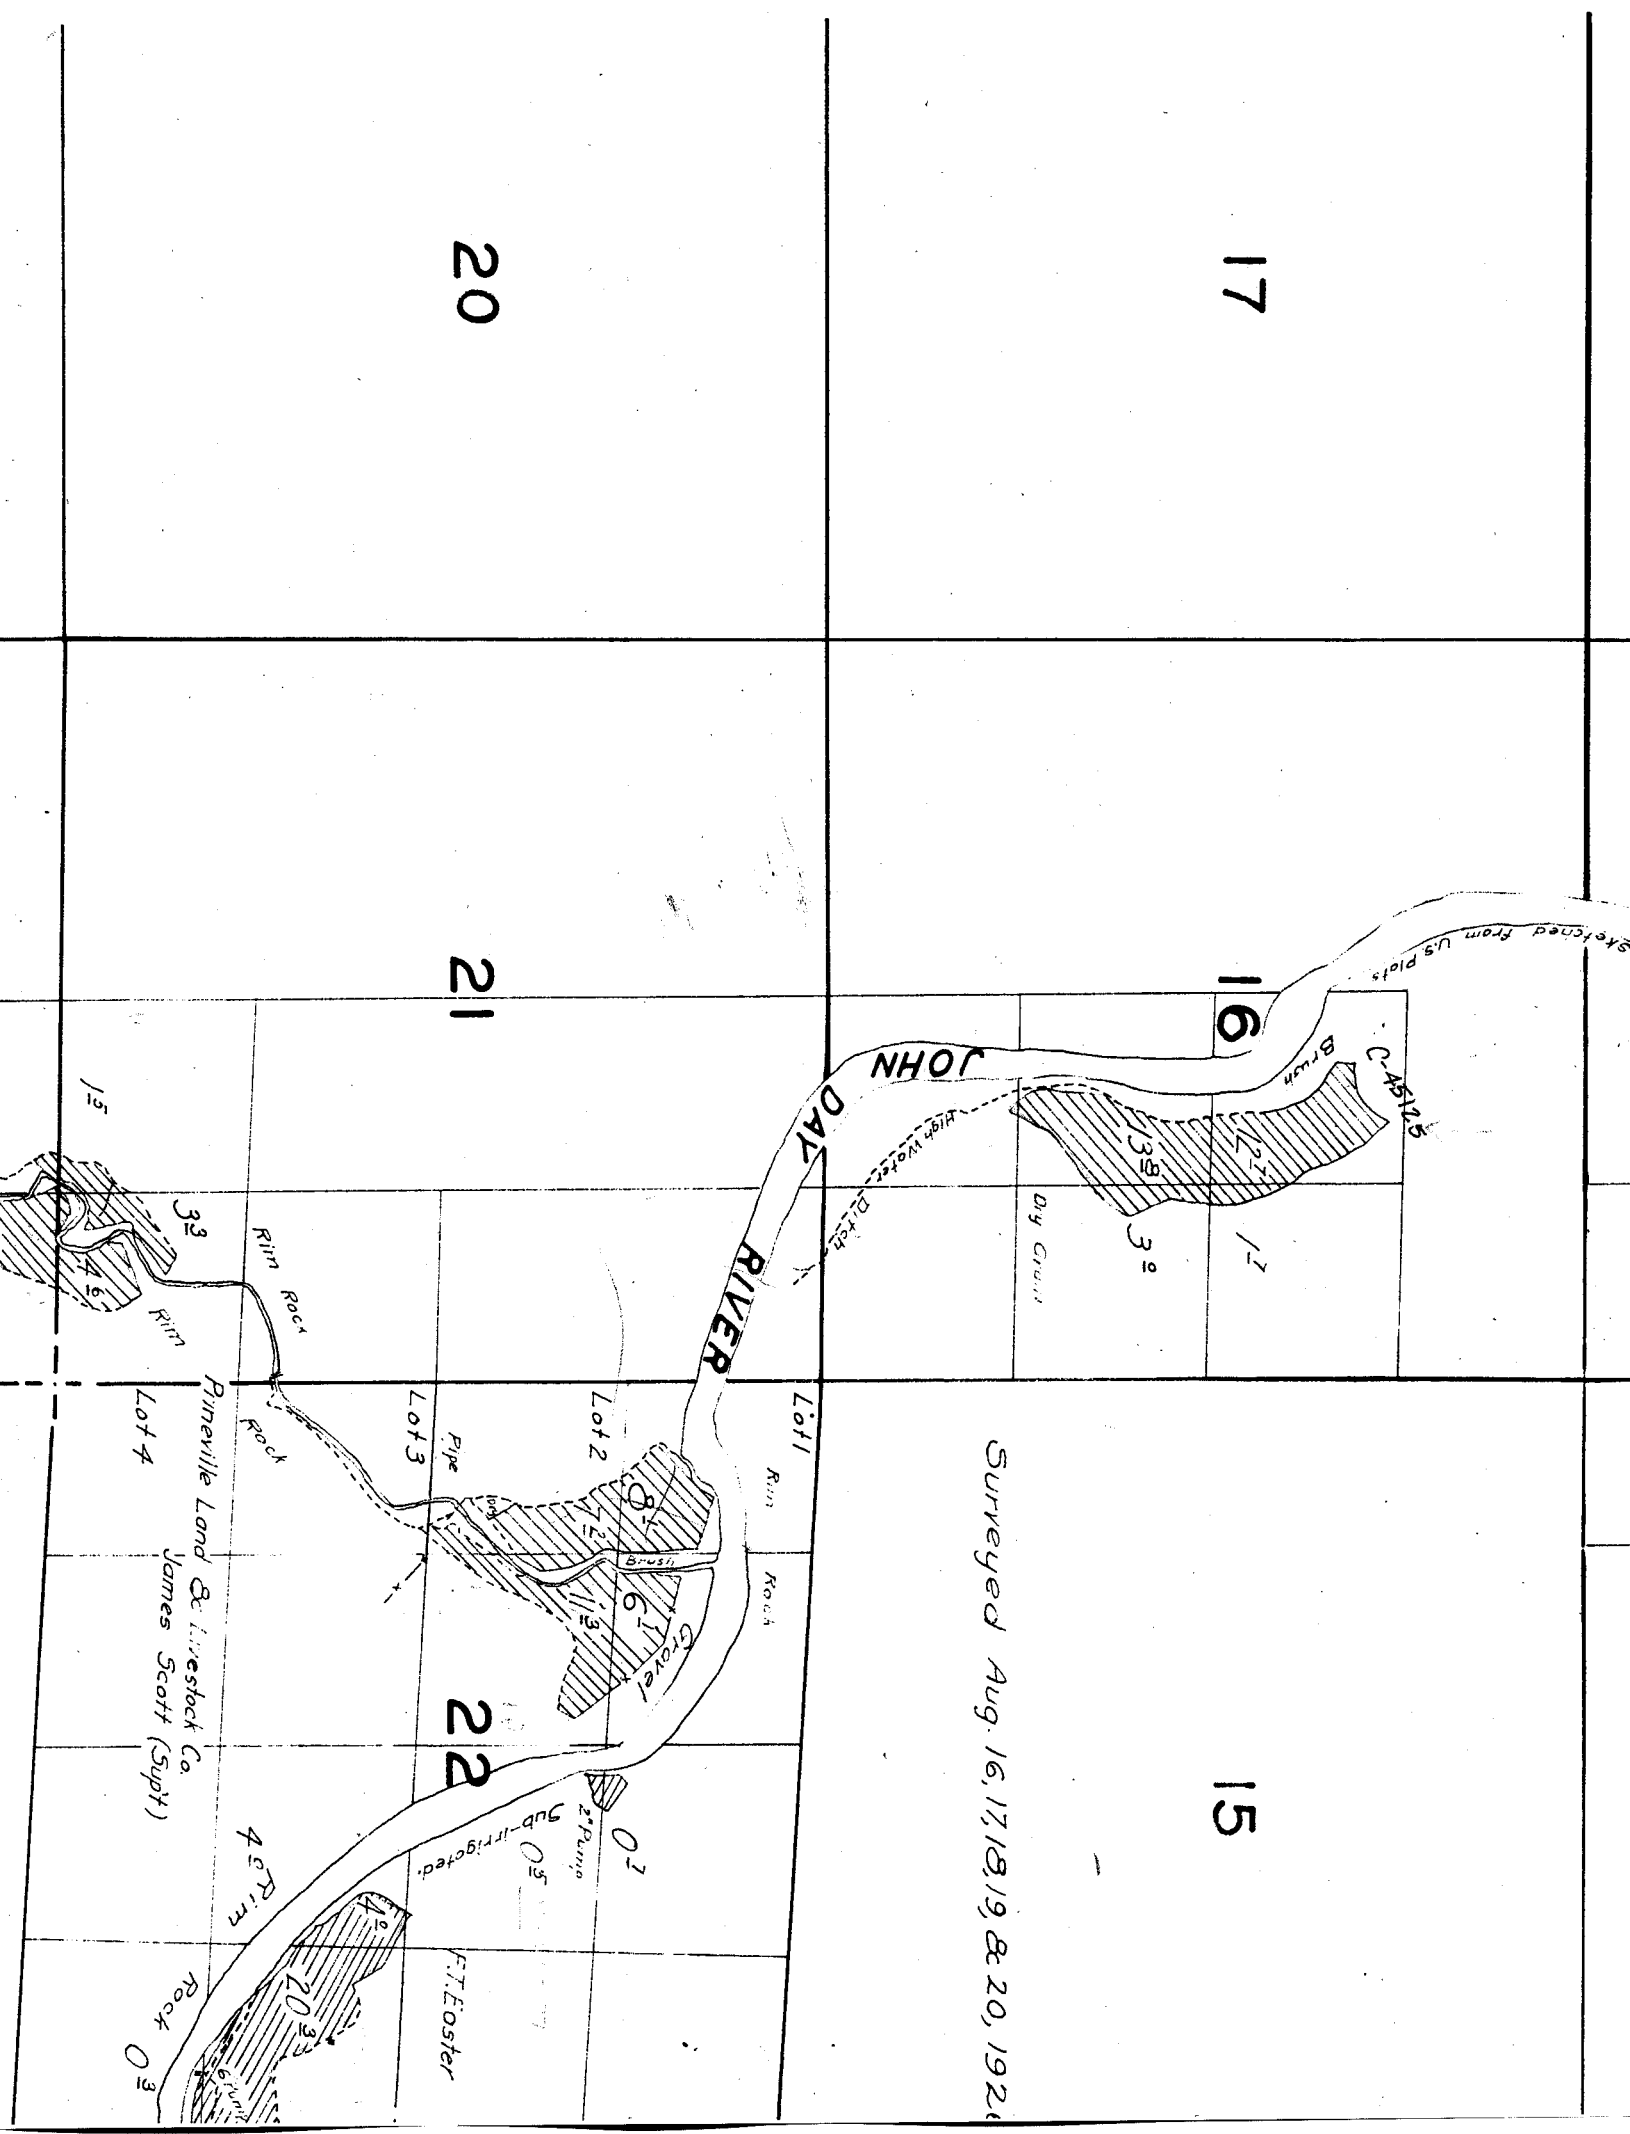

19

20

30


29

Sage Brush
MUDDY

Sage Brush
Primeville Land & Livestock
James Scott (Supt.)


31

32

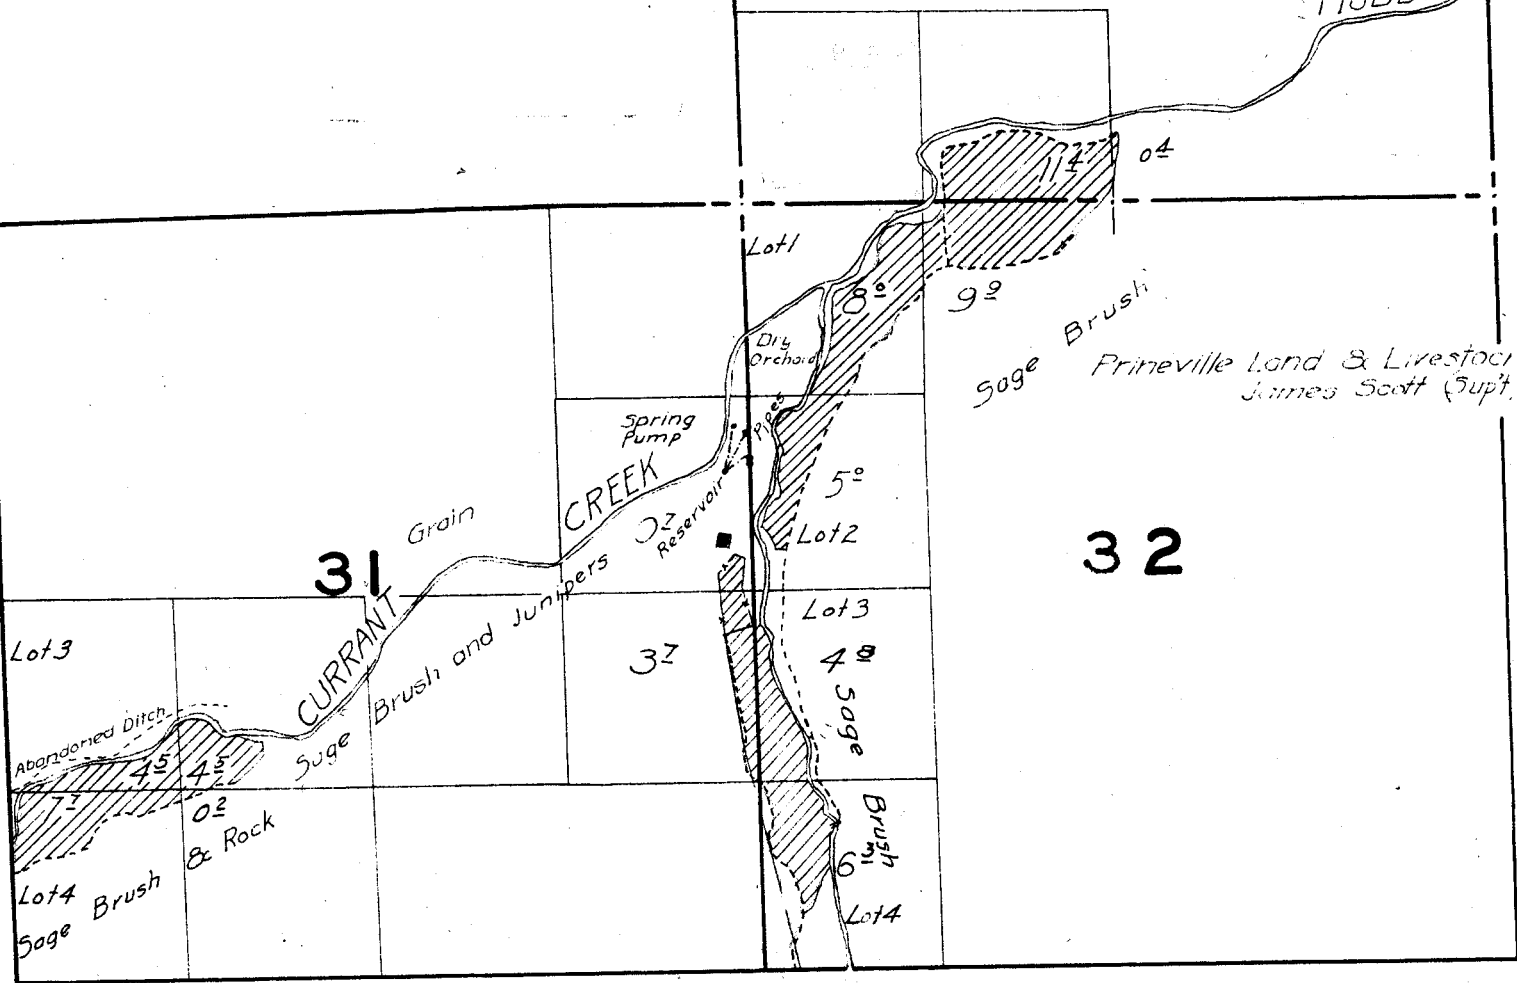

42-2-1

GE 19 E.

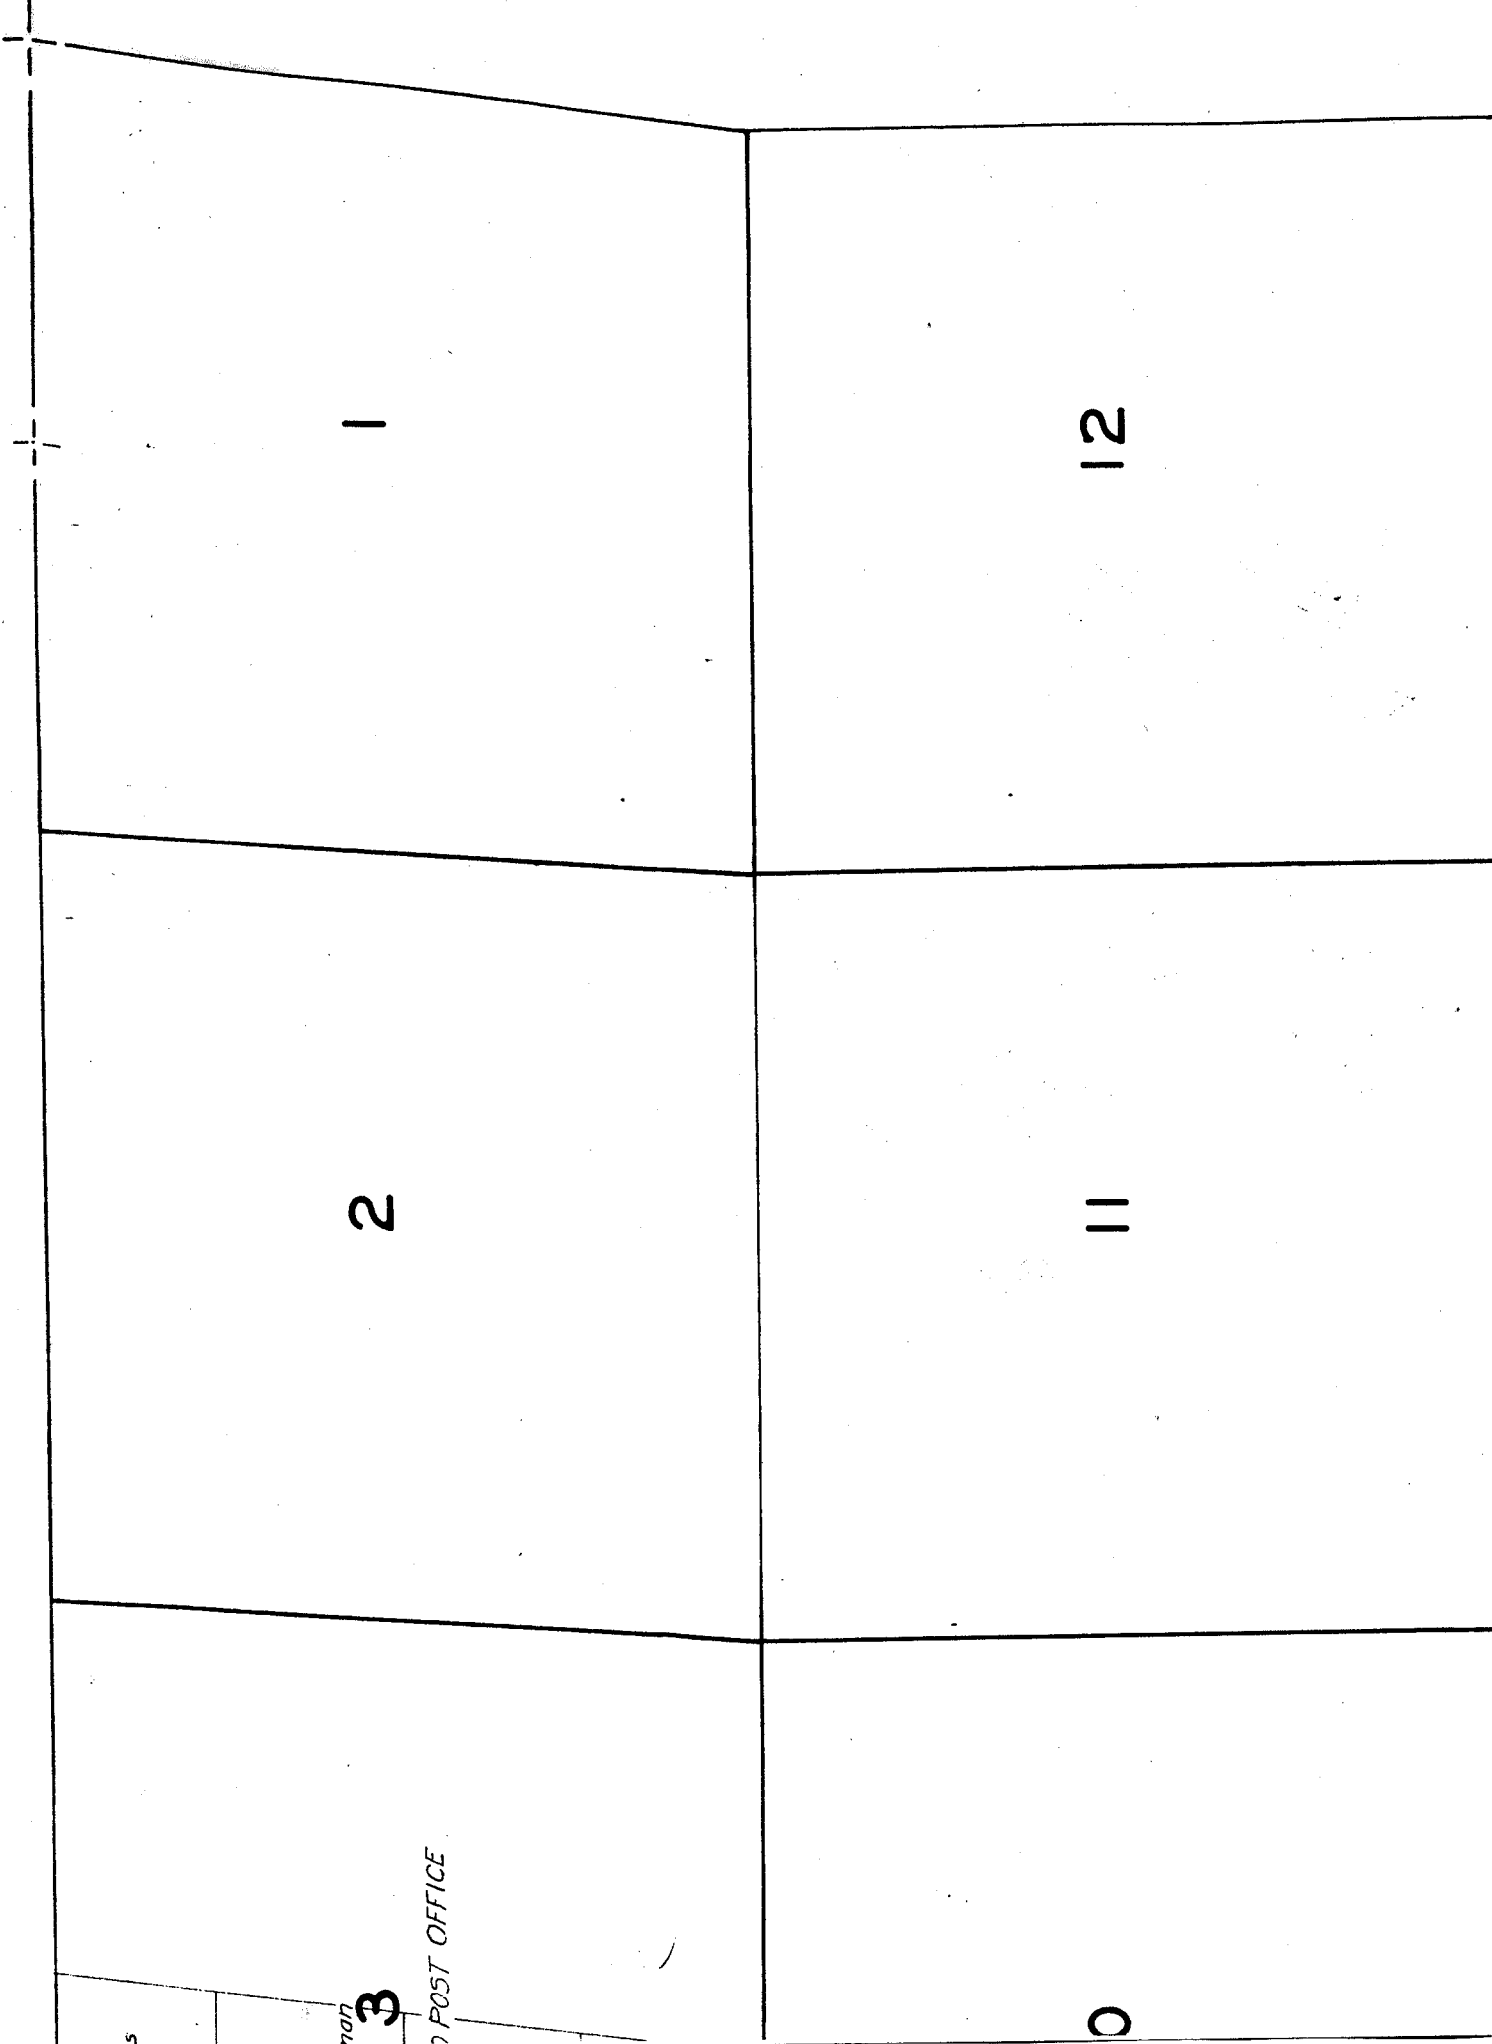

1

12

2

11

3

POST OFFICE

0

15

14

13

16, 17, 18, 19, & 20, 1926.

2

23

24

