


6

5

7

8

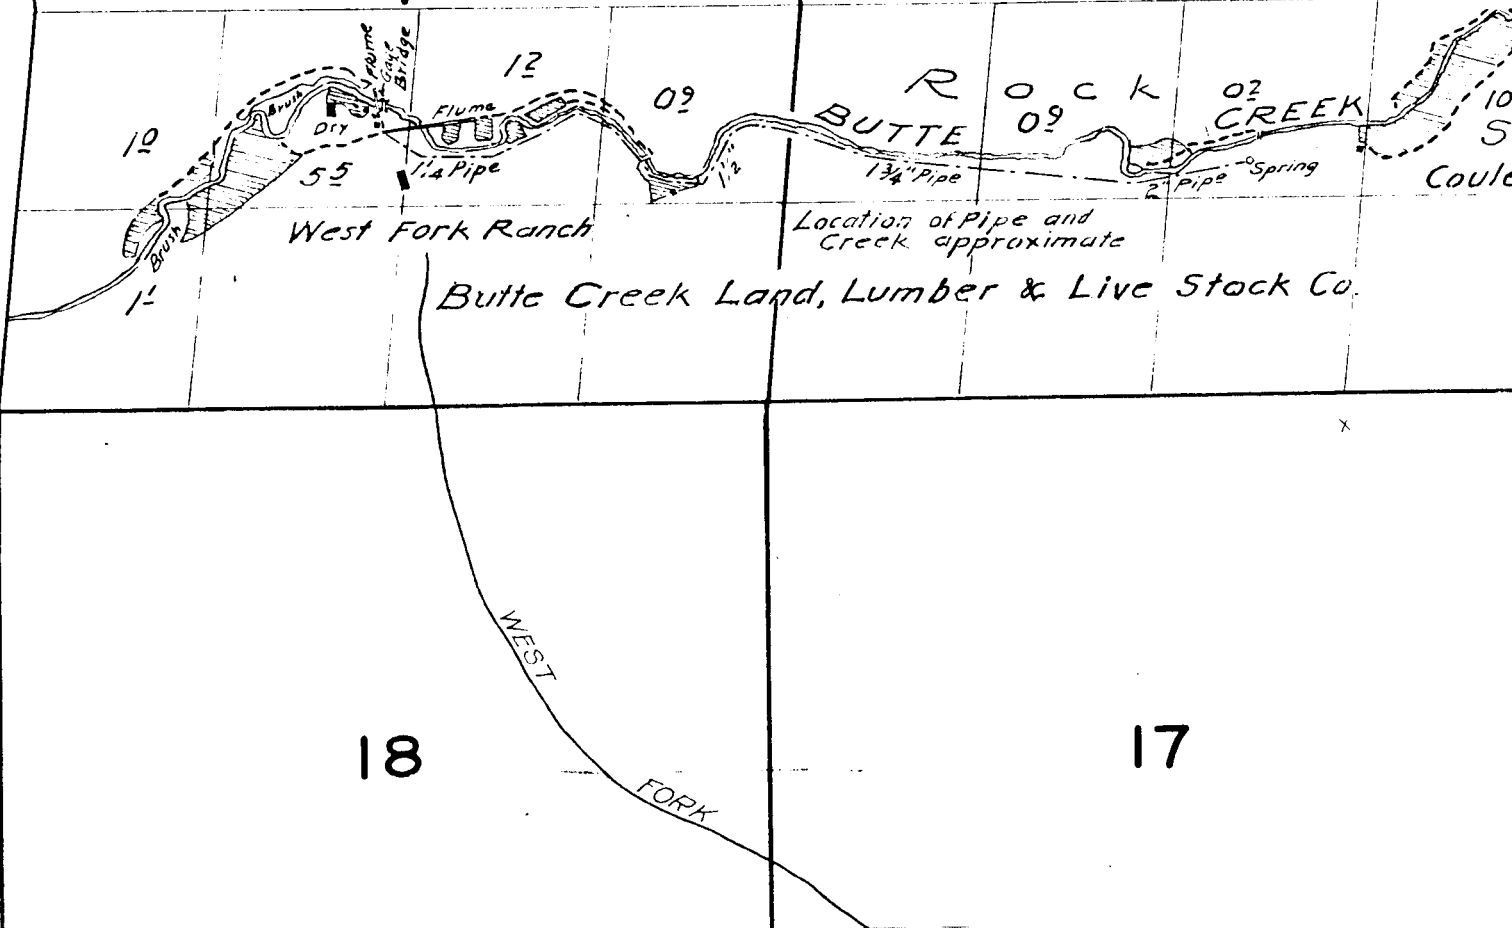

2

1

11

12

14

13

21

22

NOTE: Streams sketched in approximate location except in the vicinity of irrigated land.

28




27



33

34

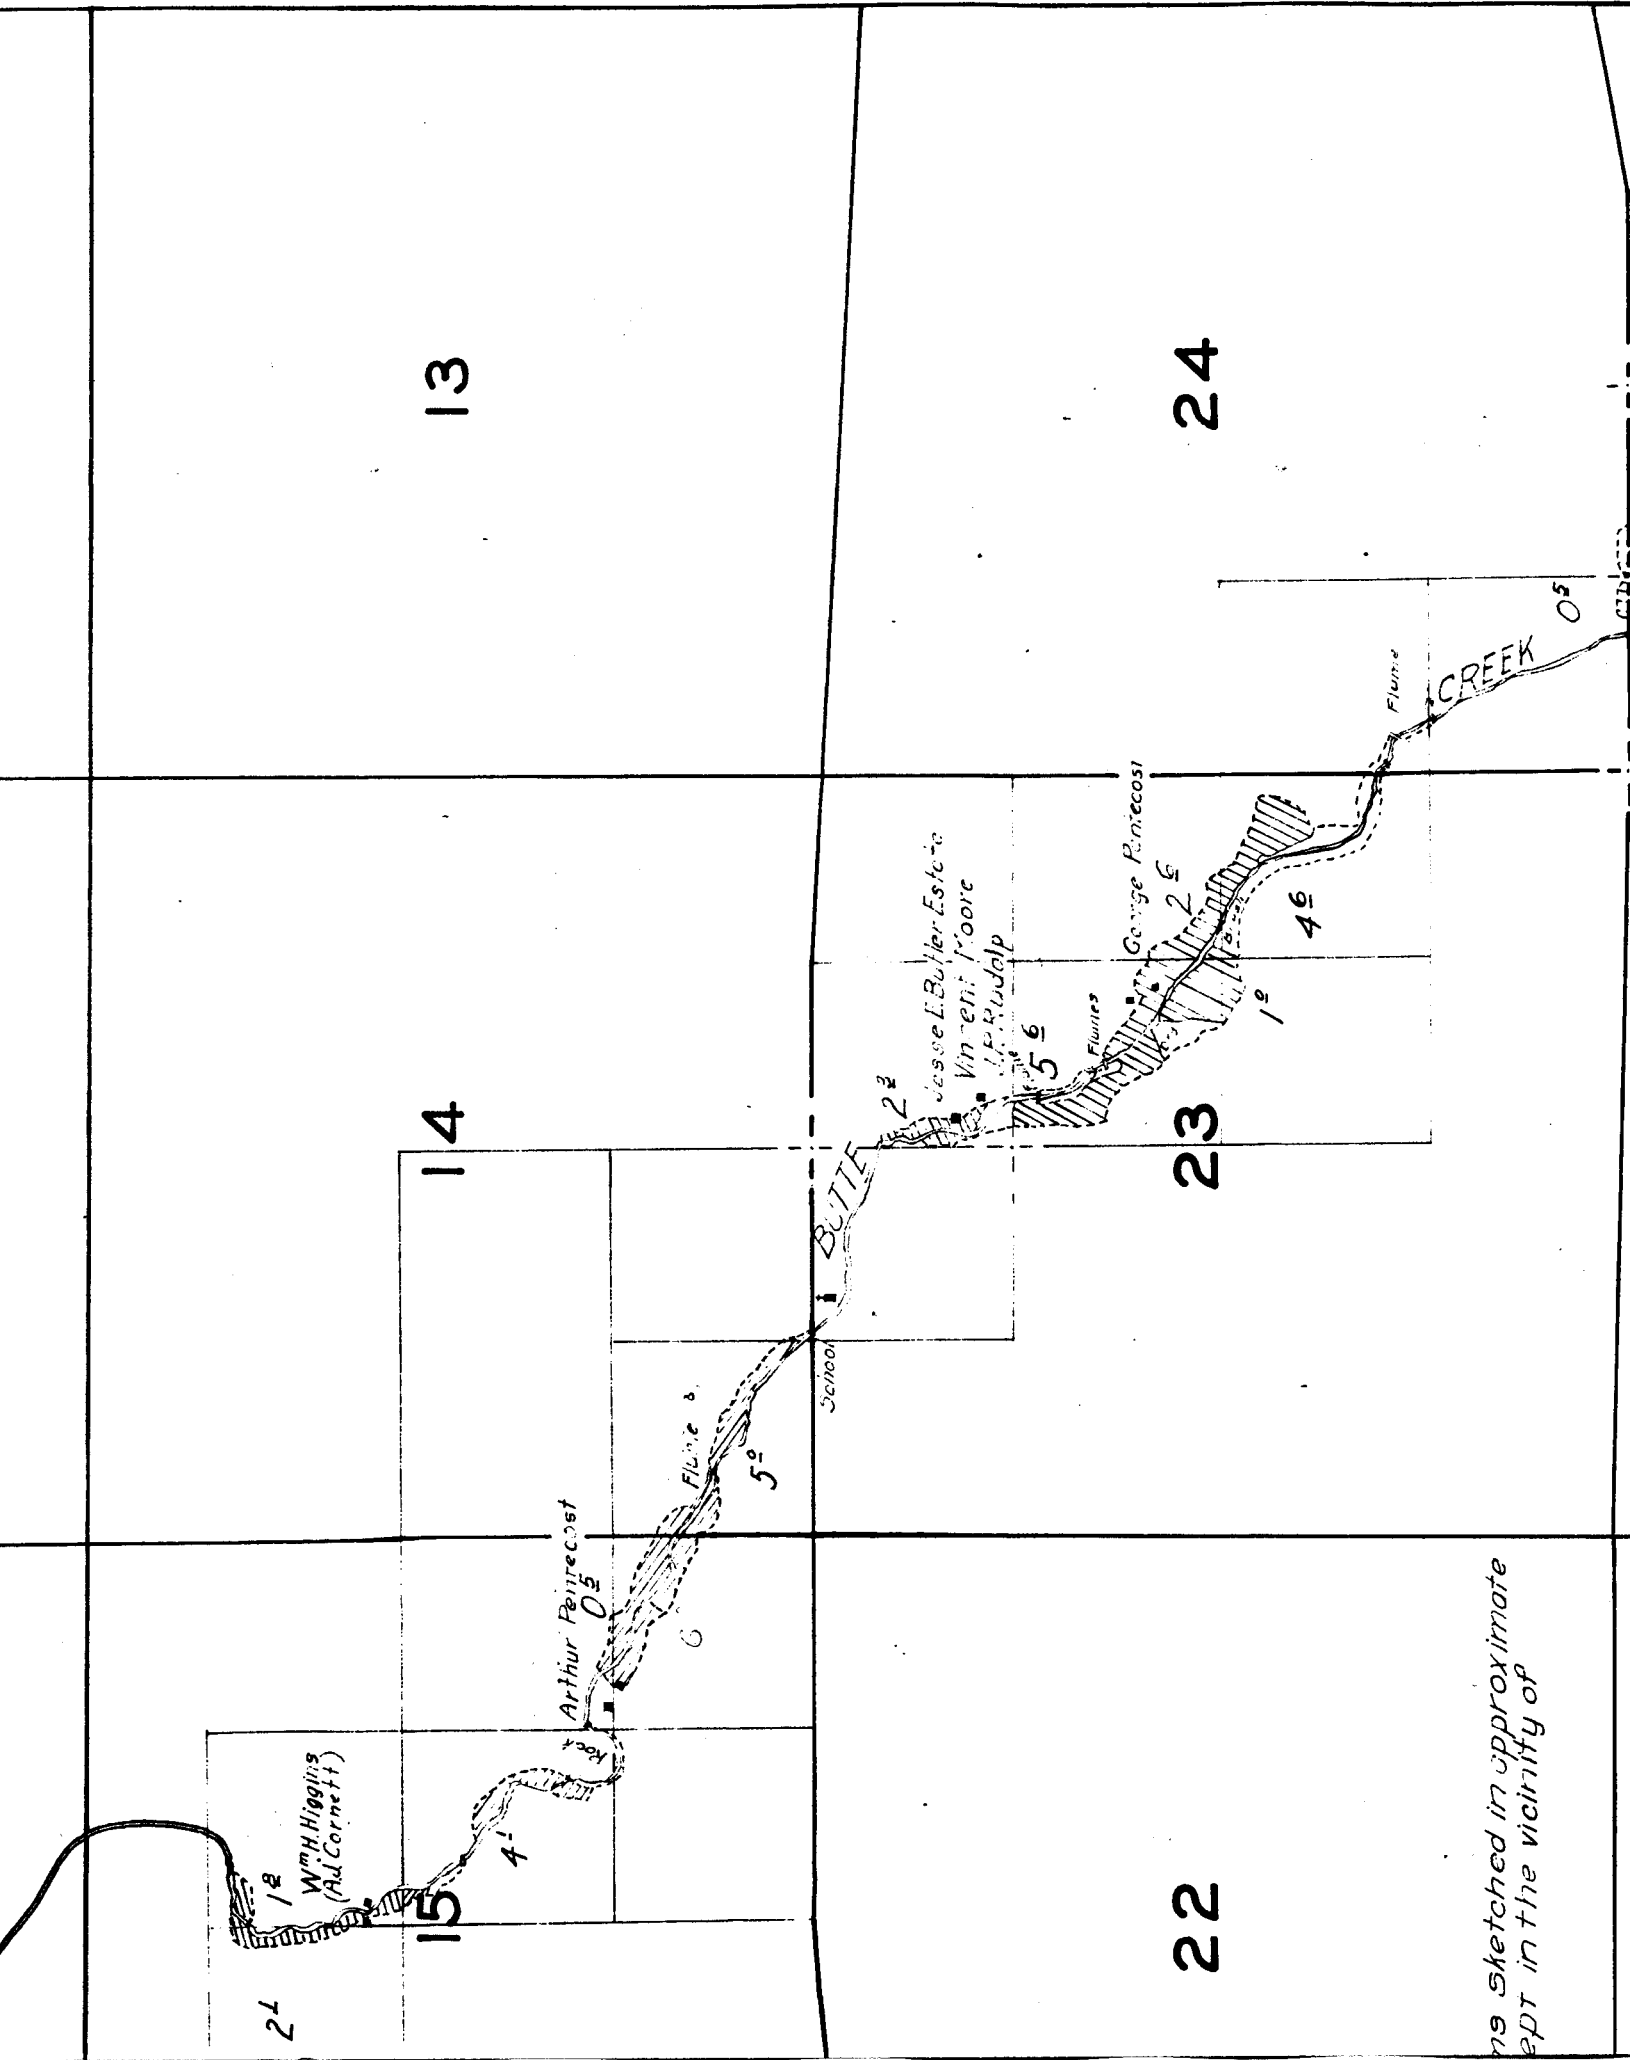

Surveyed Nov. 14 to 18, 1925.

16

21

17

20

CREEK

FORK

WEST

18

19

x

28

33


29

32

30

31


TOWNSHIP 6 S., RANGE 20 E.

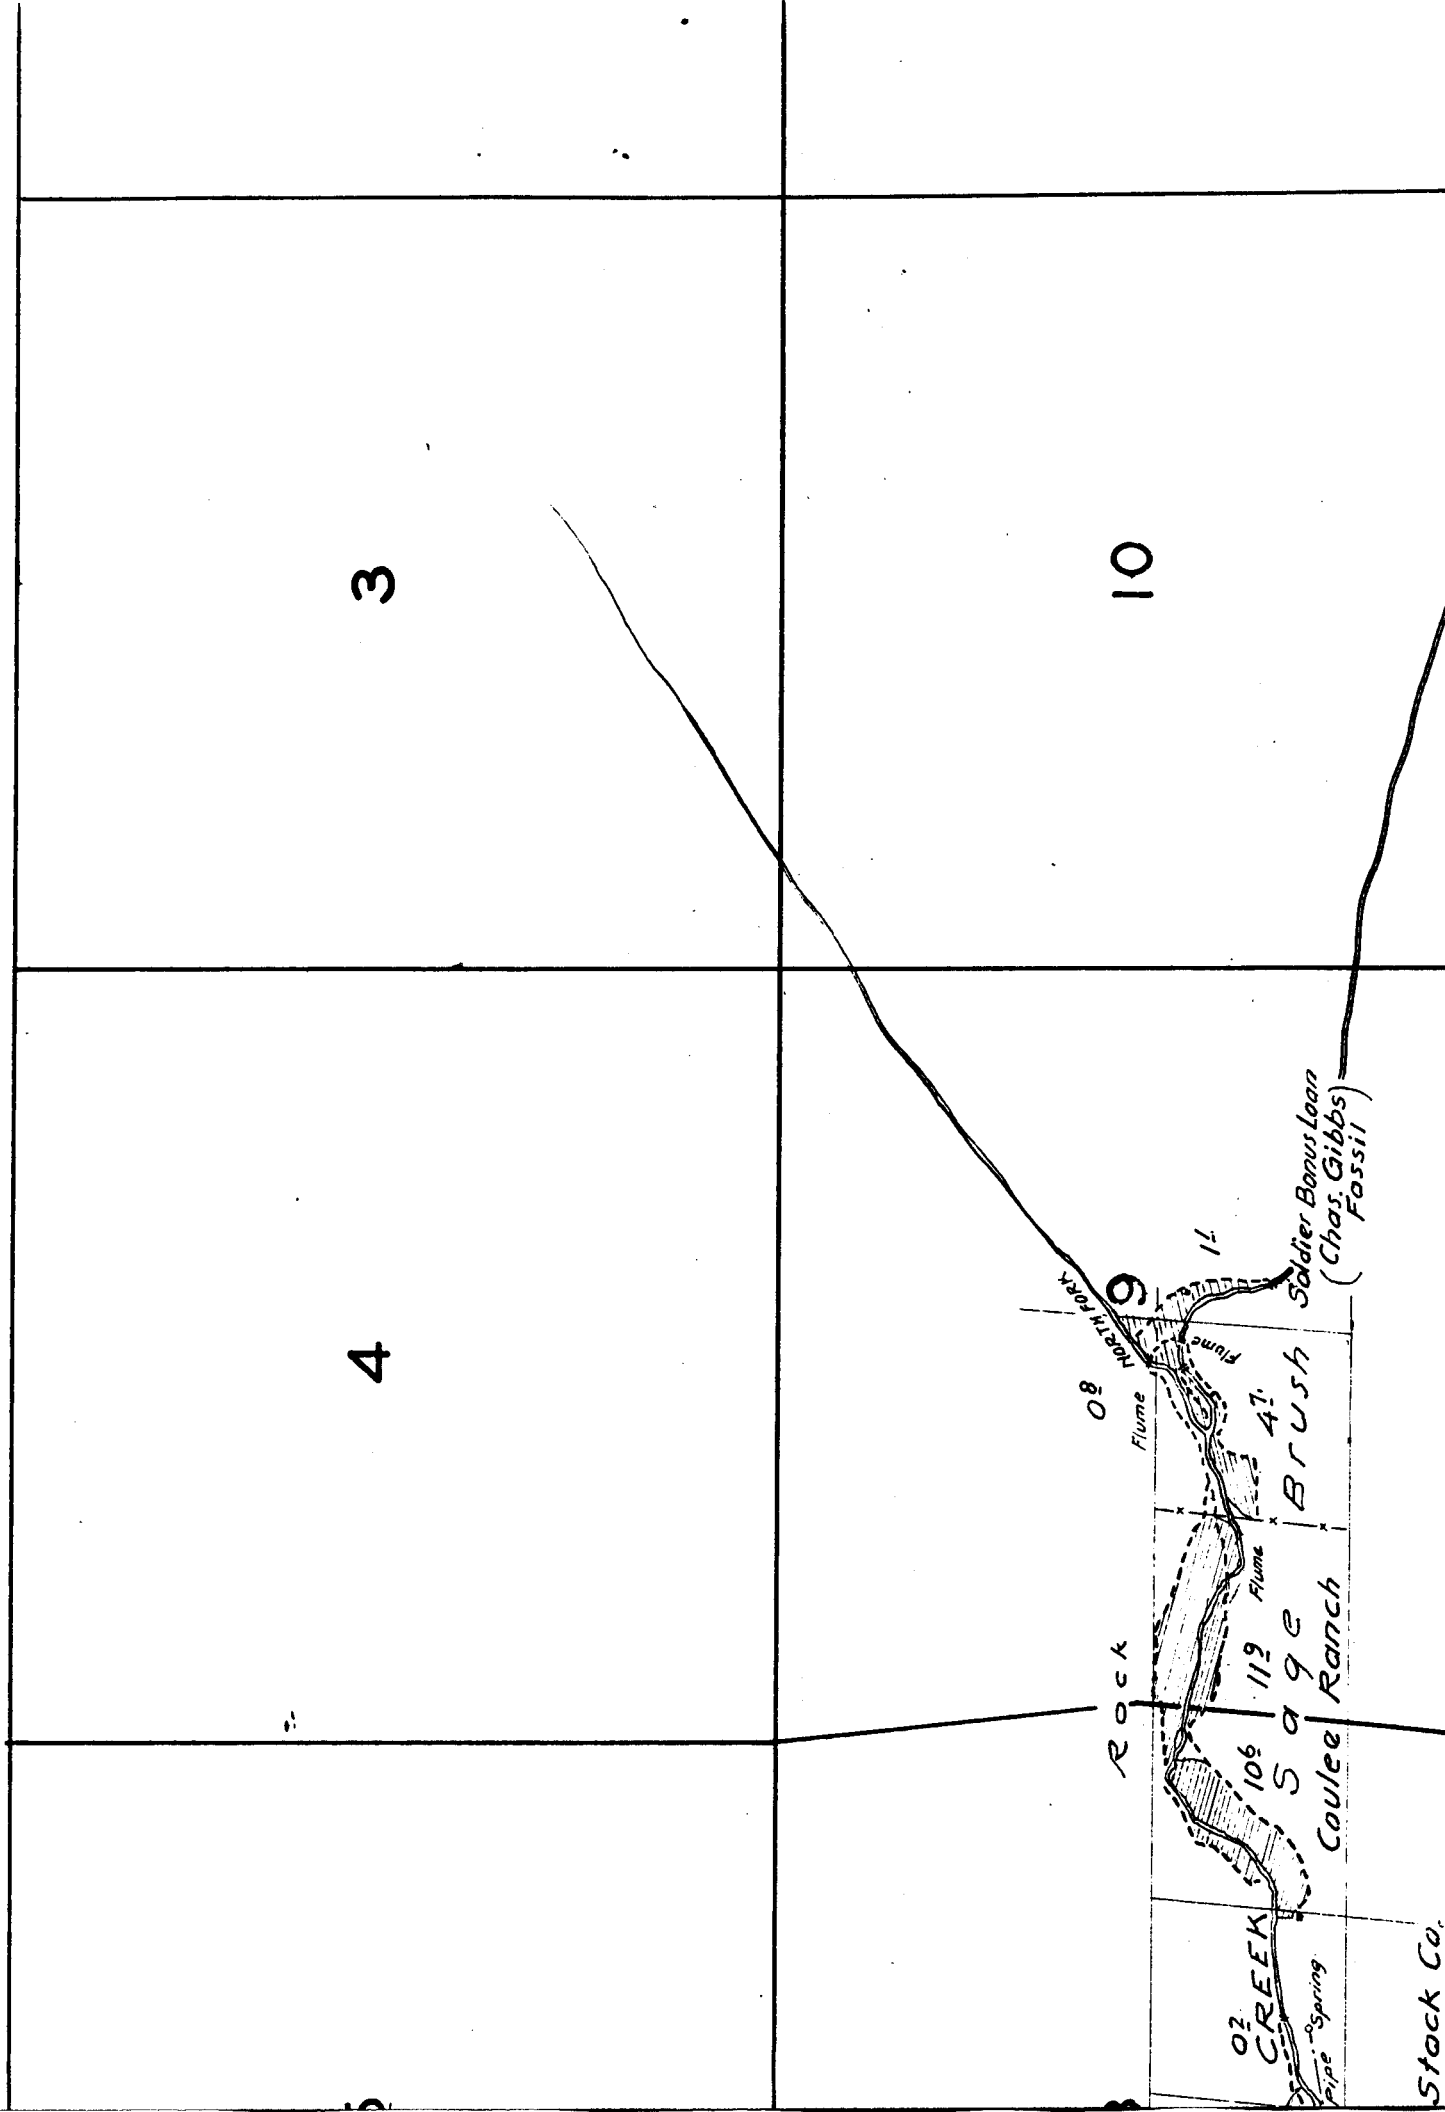

Surveyed Nov. 14 to 18, 1925.

16

21

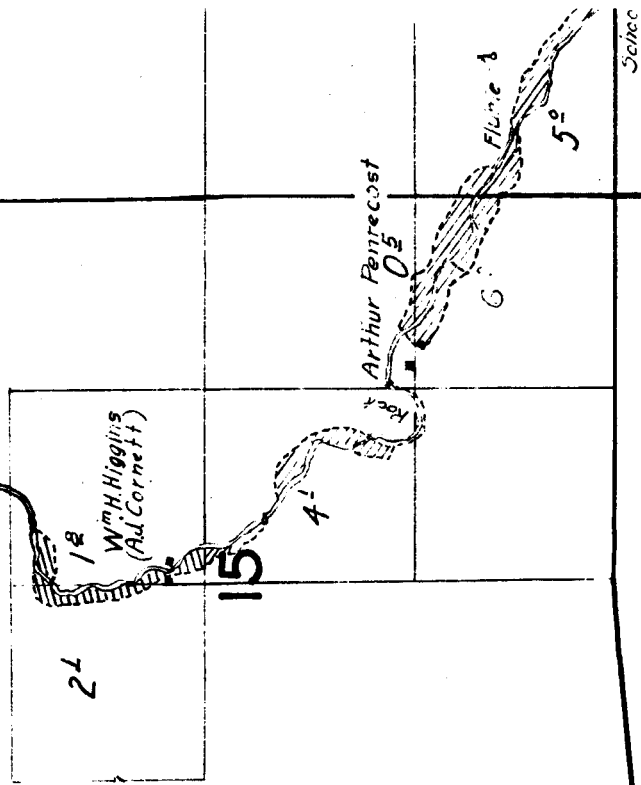

22

NOTE: Streams sketched in approximate location except in the vicinity of irrigated land.

27

26

34

35

Steiner & Carpenter Bank

12

12
Sage Brush
Sage
Cotton
Spring

36

Blunt Slap Creek

25

32

10

Mrs Margaret E. Burnica
Clt Brown

23

35