


TOWNSHIP

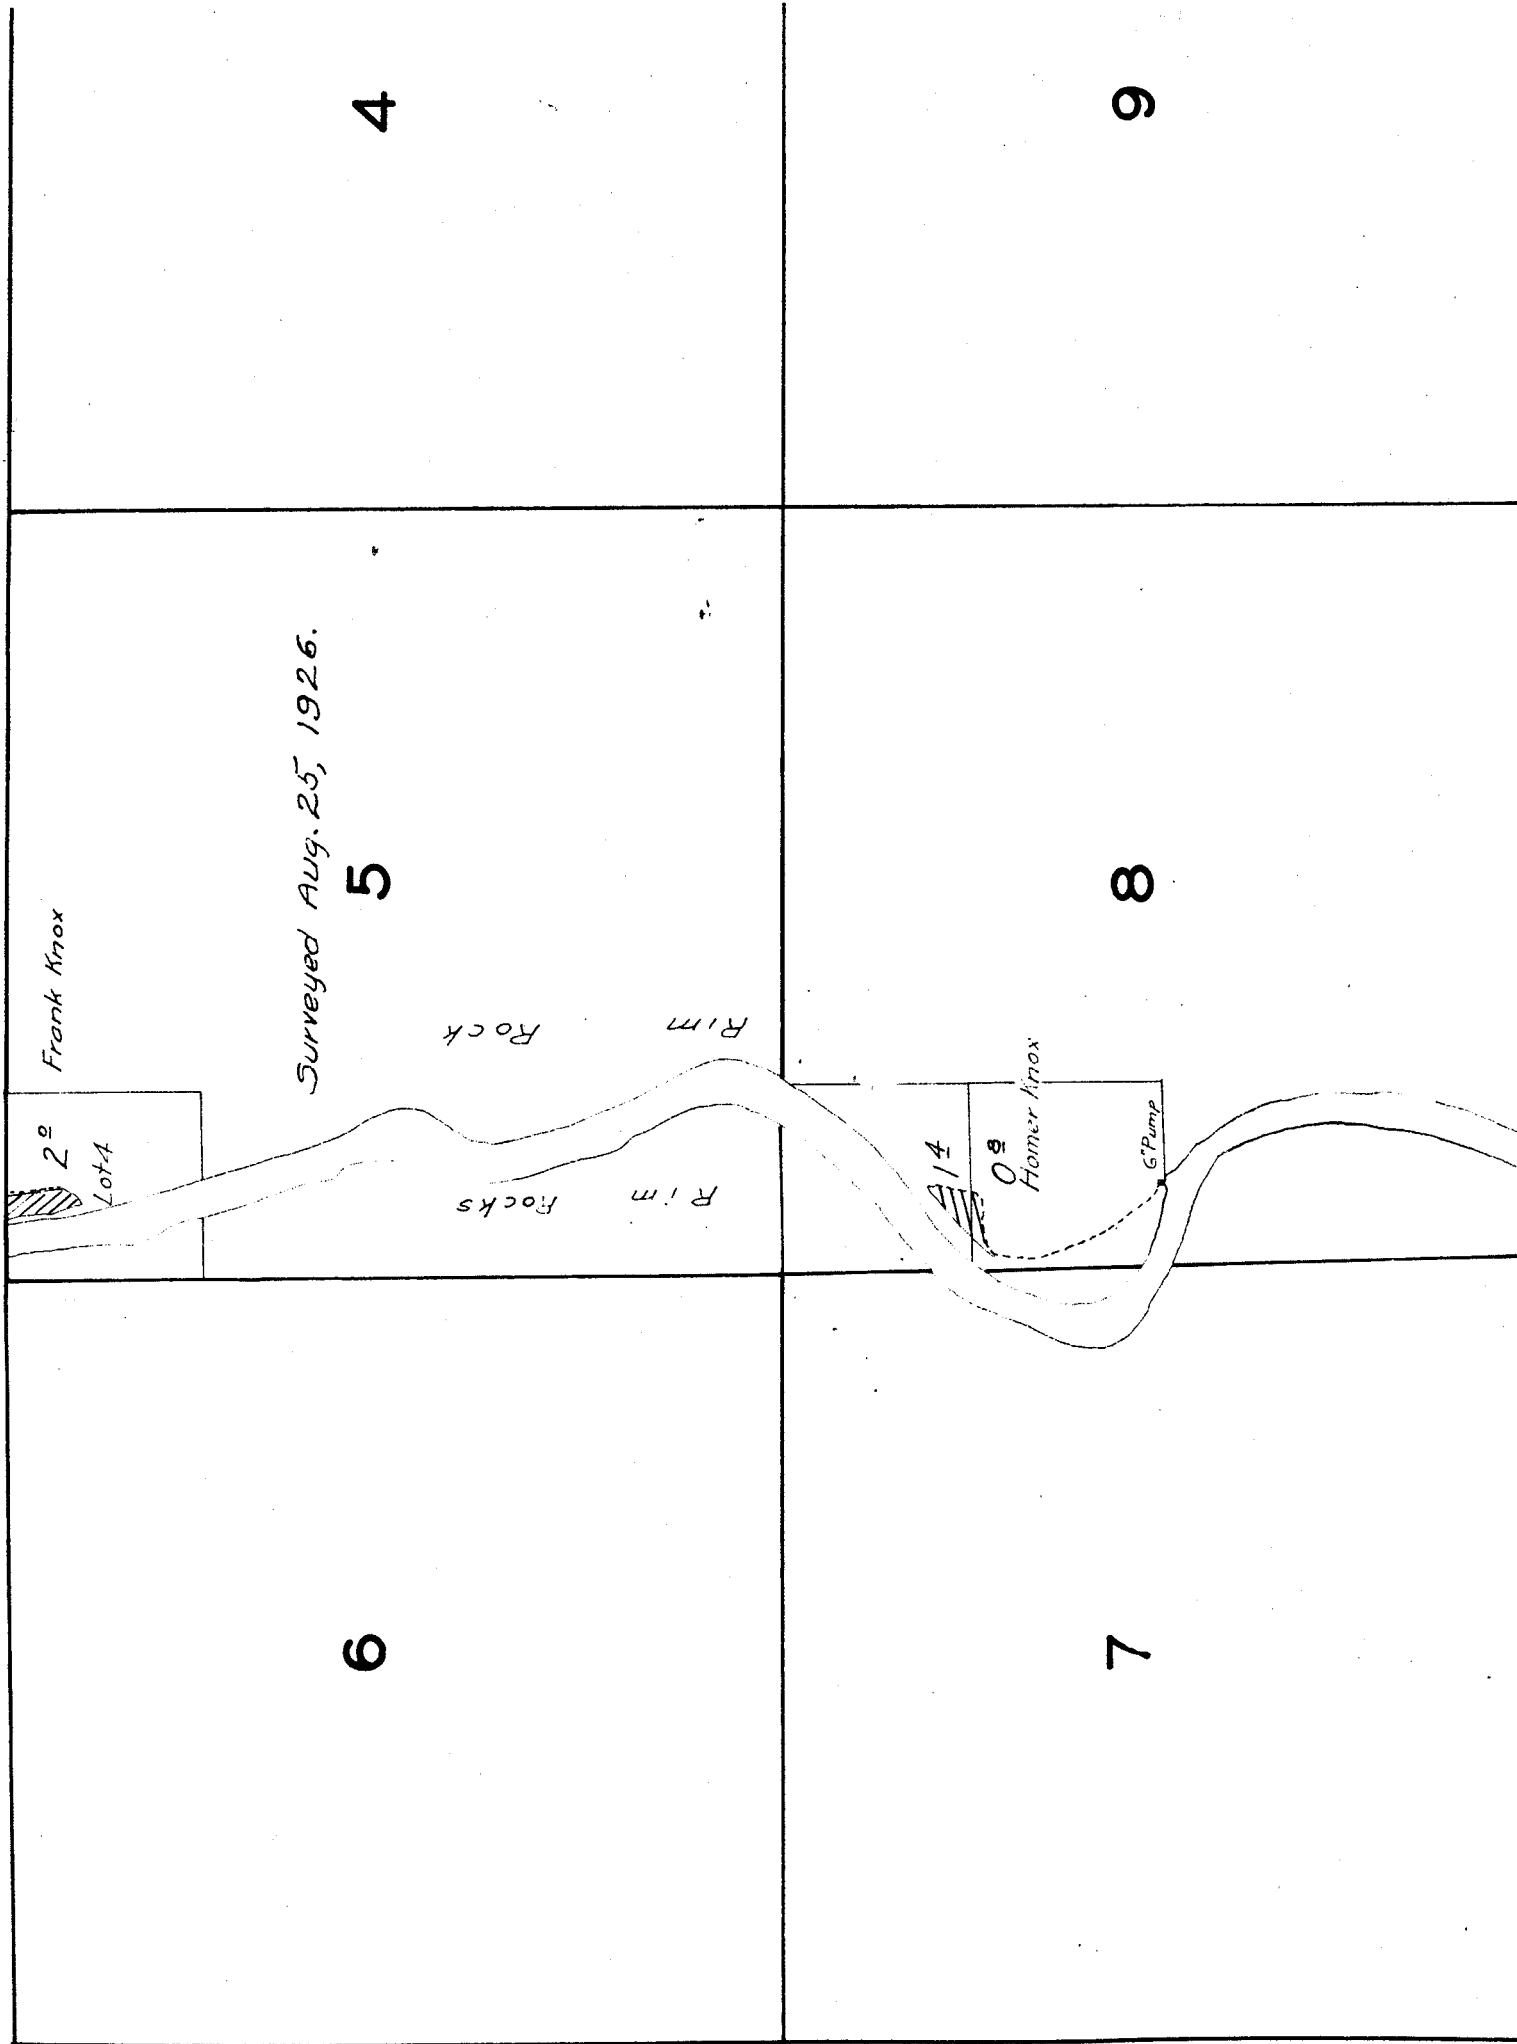

15

14

13

22

23

24

nd river, except in the  
ed land, sketched in  
ion.

3	2	1
10	11	12

on of island  
ad in field.

red Meadows

28

27

Surveyed

Surveyed Aug. 17, 1926.

33



34

Charles Chapman



igated  
and

Charles Hiltin  
(Charles Burgess)

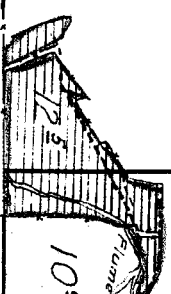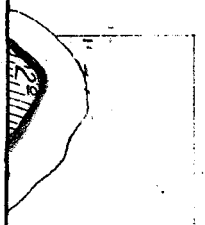

PINE

County

9

12

7

Geary  
Farm

16

15

21


22

NOTE: Streams and river, except in the vicinity of irrigated land, sketched in approximate location.

George Bowley  
Frank Lee

Mrs. Ellen Lee

AL Huntley

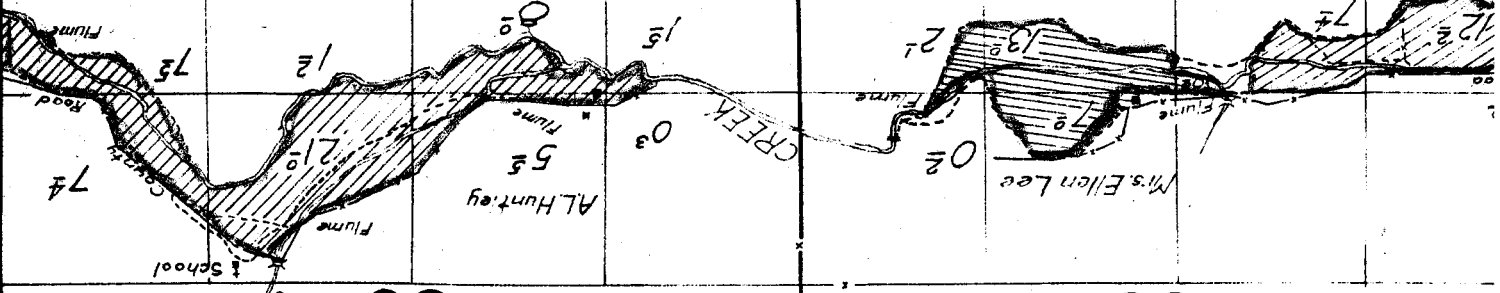

Surveyed Aug. 14, & 16, 1926.

35

36


COVE CREEK

26

25

23

24

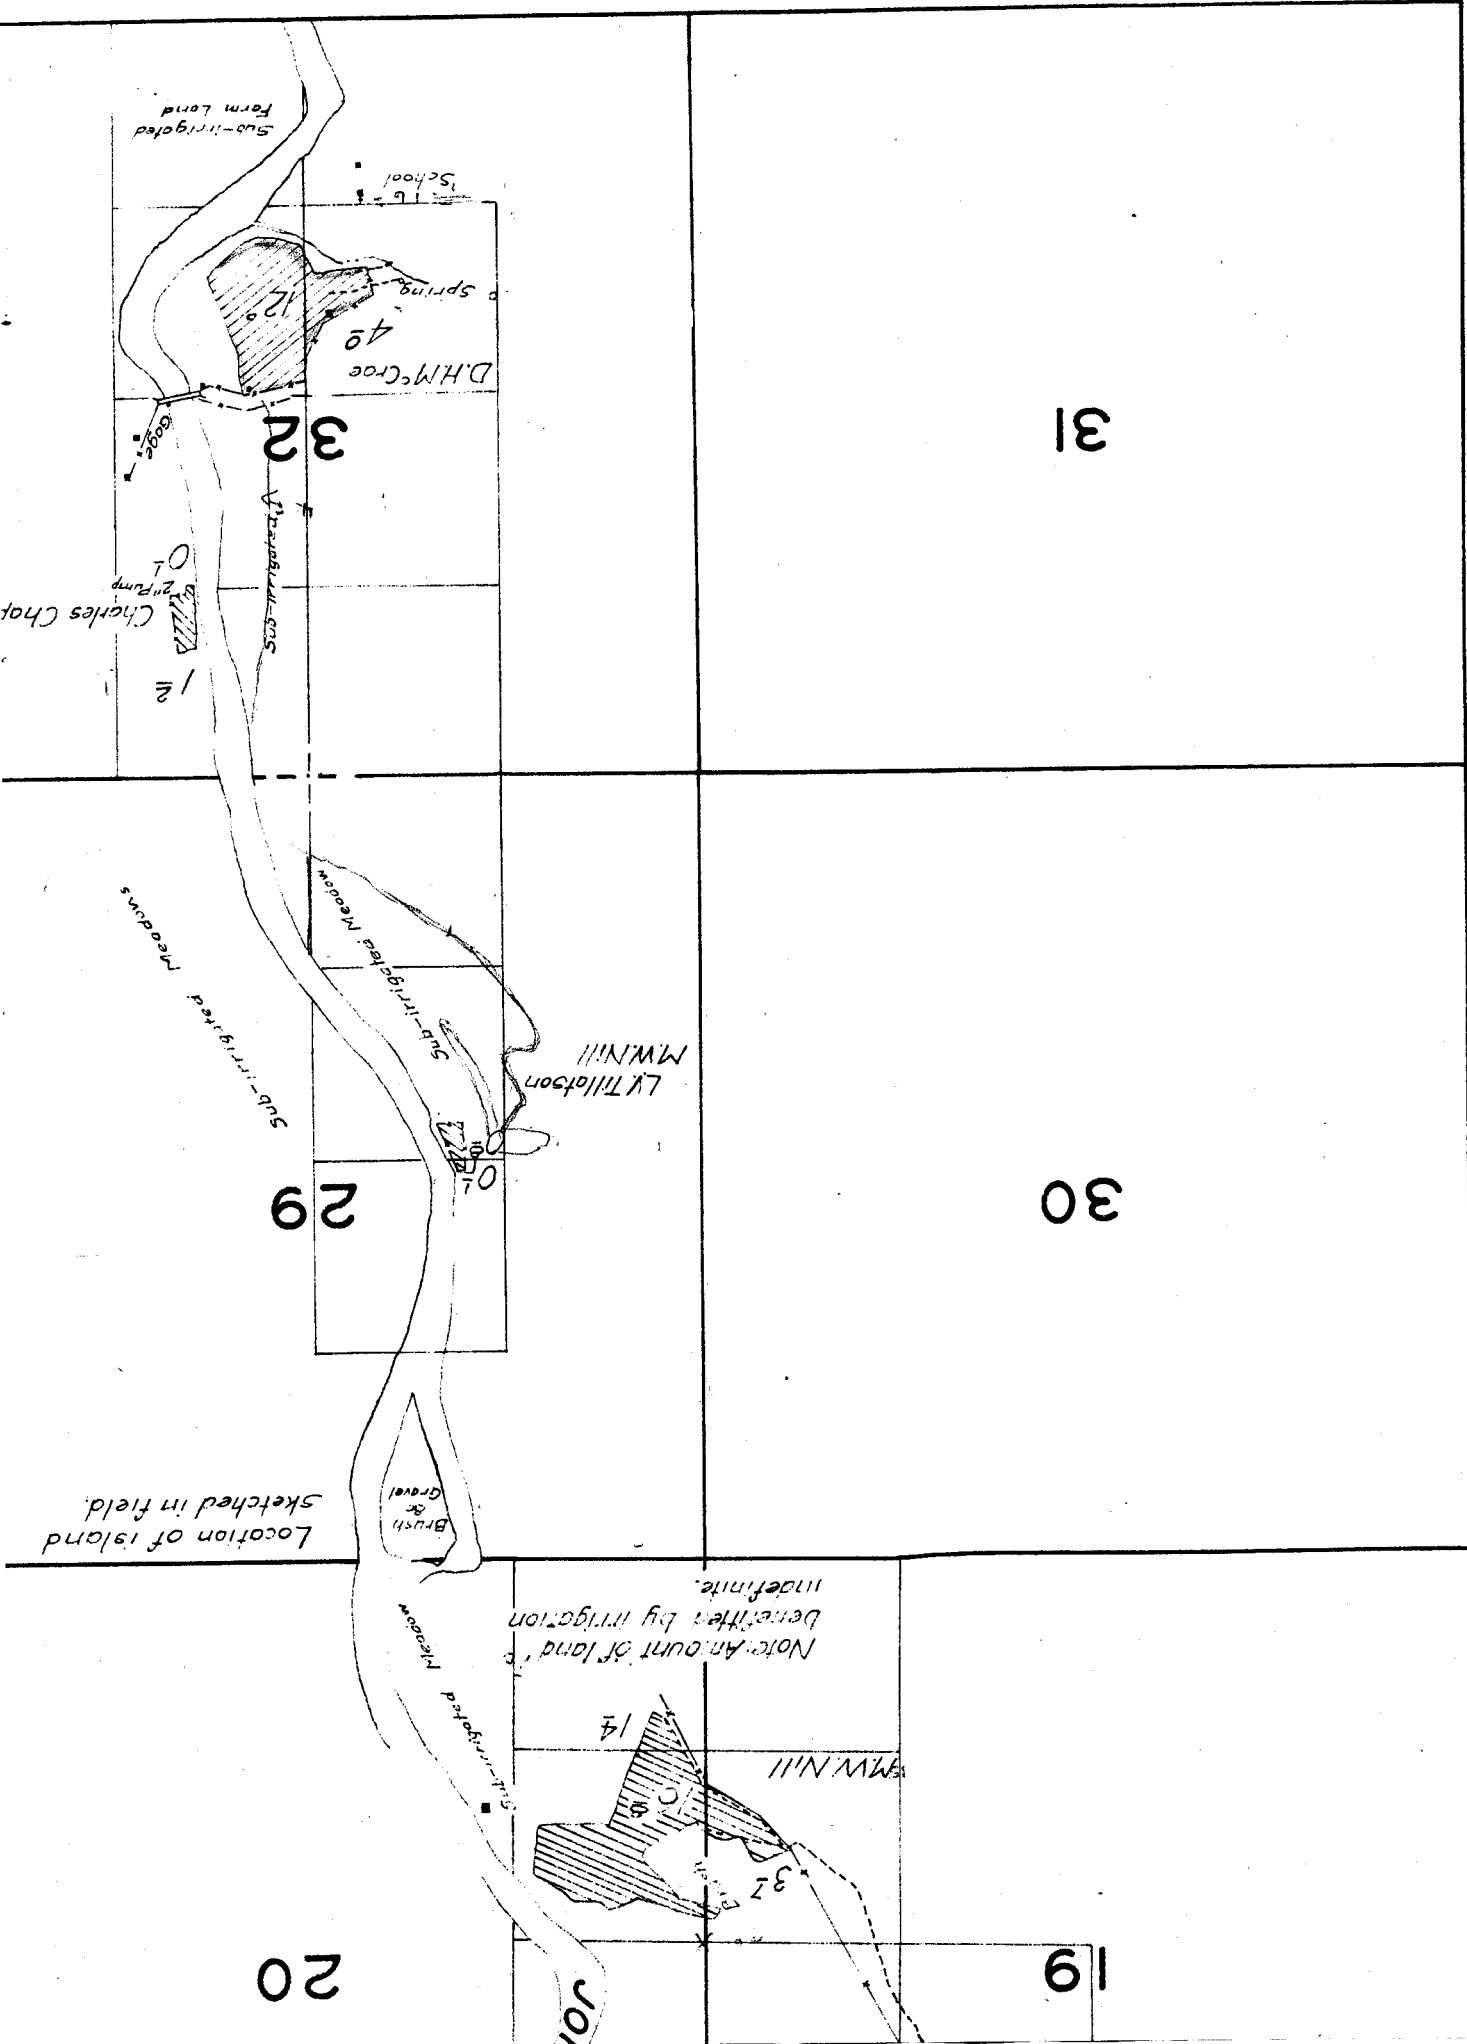

31

30

32

29

19

20

Sub-irrigated  
Farm Land

School

Spring

D.H.M. Croe

32

Sub-irrigated Meadum

O.T. Pump

Charles Chap

1/2

Sub-irrigated Meadum

L.V. Tillison  
M.W.N.III

O.T. Pond

29

Sub-irrigated Meadum

Sub-irrigated Meadum

Brush &  
Gravel

Location of island  
sketched in field.

Note: Amount of land  
benefited by irrigation  
indefinite.

M.W.N.III

1/4

32

30

TOWNSHIP 7 S., RANGE 19 E.

4


3

9

10



# TOWNSHIP 8 S., RANGE 19 E.

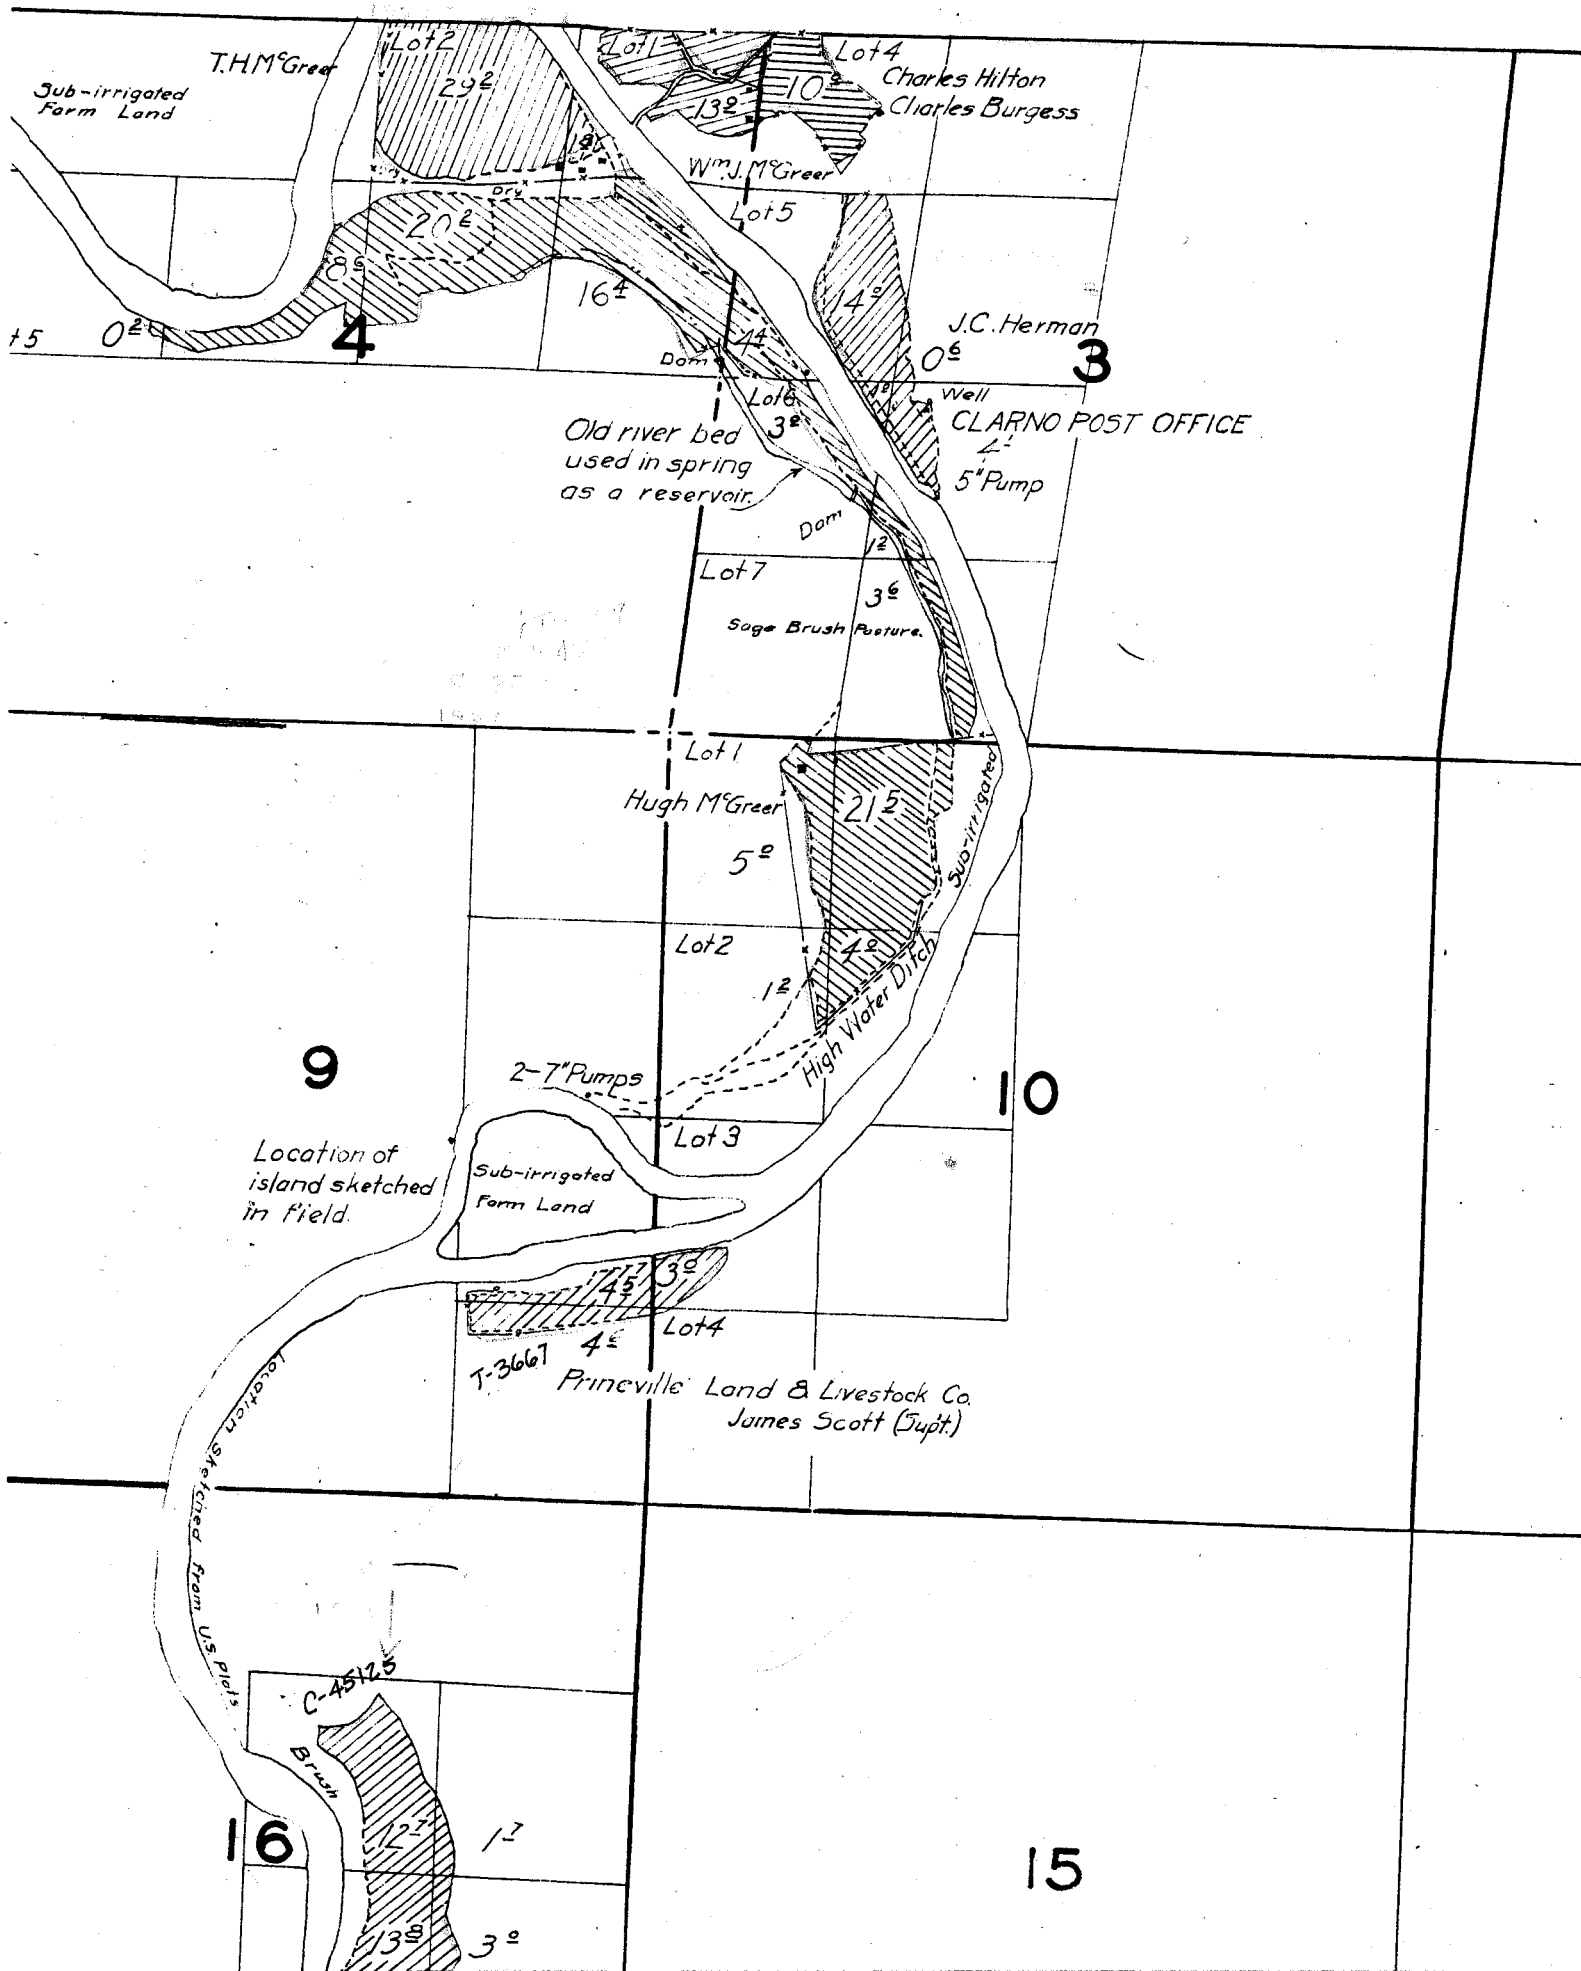

23

24

*Locatn sketched from US Plats.*

C.S. Hicks  
Sub-irrigated  
Farm Land

26

Rim Rock

4°

sage

Brush

25

0°

6'ump

35

36

*Locatn sketched from U.S. Plats.*

*Handwritten scribble*


19

20

30

29

Sage Brush  
MUDDY

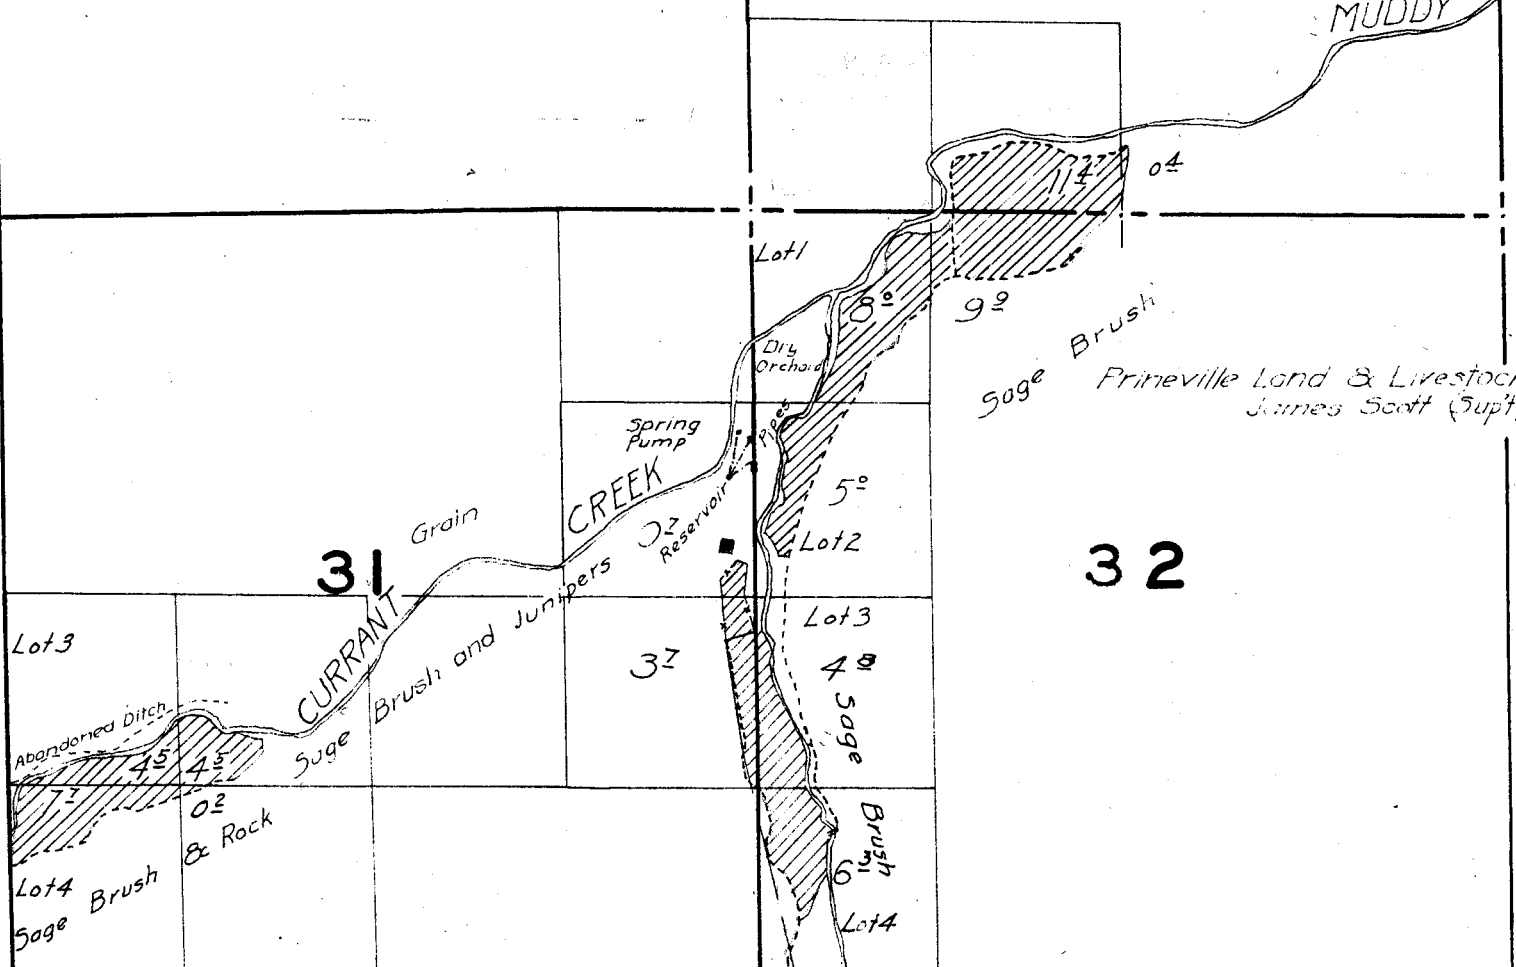

32

29

28

27

32

33

34

509<sup>e</sup> Primeville Land & Livestock Co  
James Scott (Supt)

Brush


Sage Brush  
MUDDY

and Junipers  
Rim Rock  
CREEK

32  
33  
34  
Flume

92

04

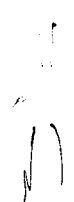

17

16

15

20

21

22

sketched from U.S. plots

CARLIS

Brush

12.1

3.2

Dry Ground

JOHN DAZ

High Water

Bl. Rd.

RIVER

Lot 1

Rim

Rock

Lot 2

8

7.2

6

1.3

Grovel

Lot 3

Pipe

4.8

4.8

Rim

Rock

3.2

Mink

Lot 4

Prineville Land & Livestock Co.  
James Scott (Supt)

4.8 Rim

Rock

0.3

0.1

Pump

Sub-irrigated.

0.5

FT. Foster

Surveyed Aug. 16, 17, 18, 19, & 20, 1921

16, 17, 18, 19, & 20, 1926.

15


14

13

2

23

24

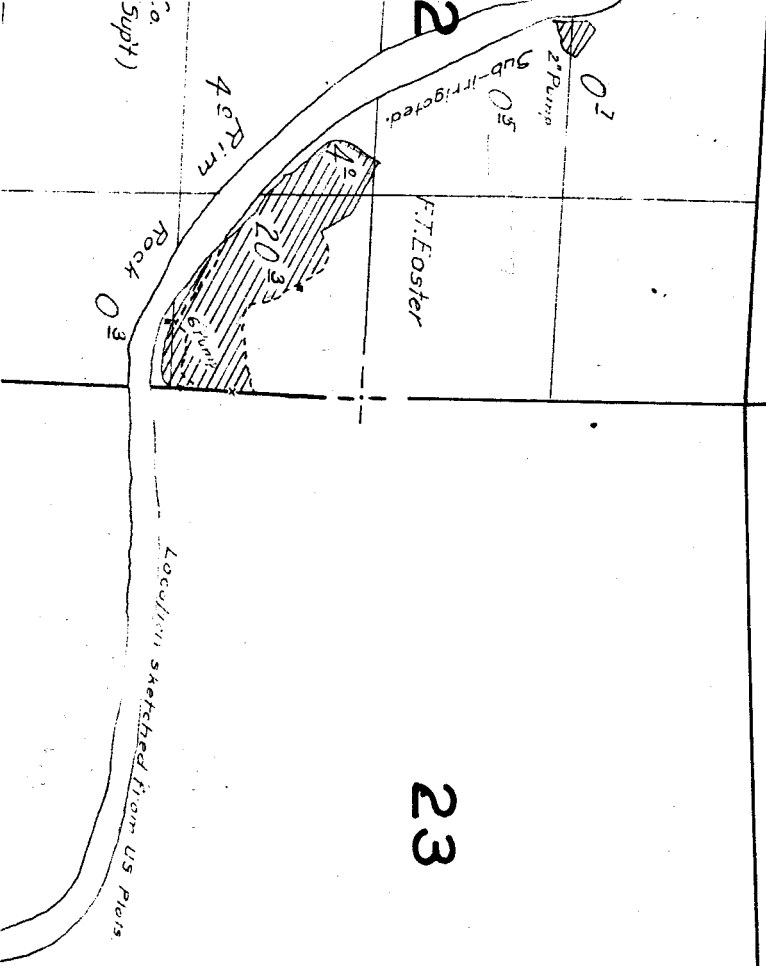

3E 19 E.

4C-2-1

5

7d17

3

POST OFFICE

2


1

0

11

12

# TOWNS

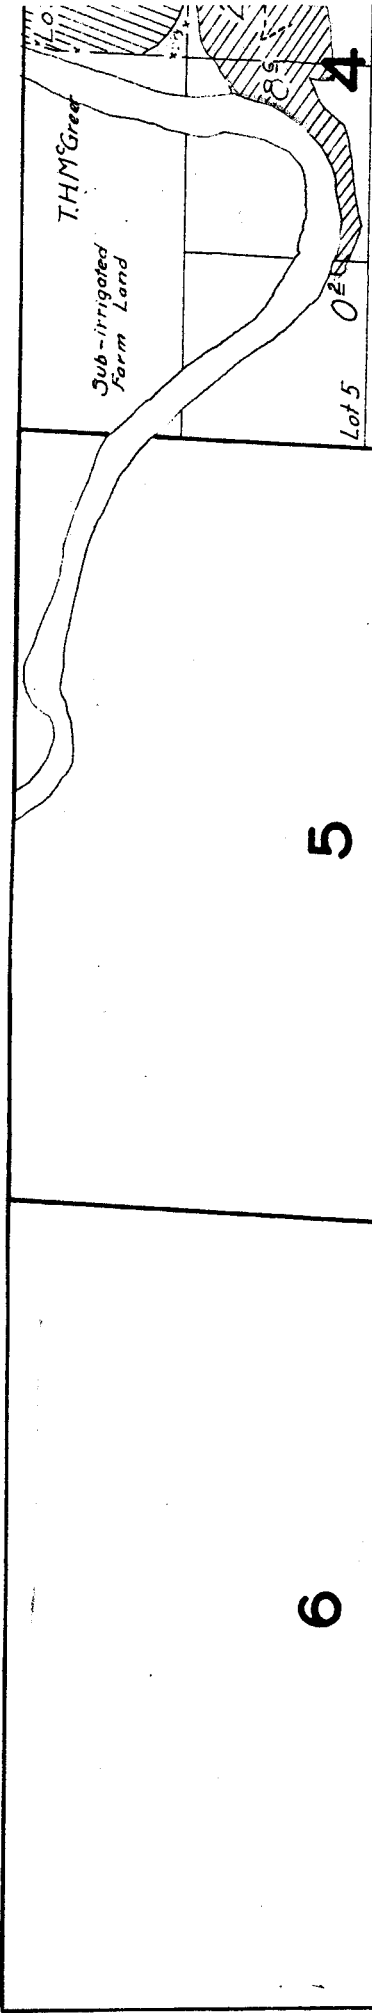

5

6

8


7

9

Location of  
island sketa  
in field

Location



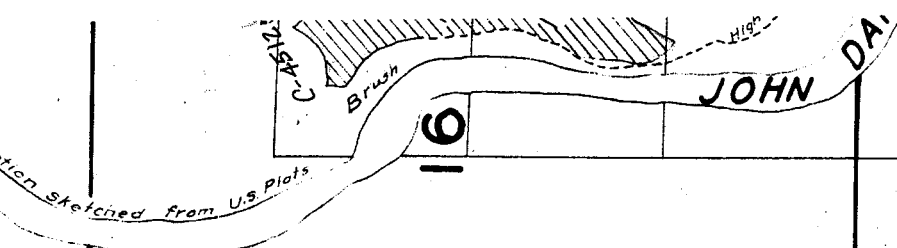

Map sketched from U.S. Plots

16

21

17

20

18

19

16

21

17

20

18

19

Ownership - ?


The pumps used to irrigate this land have been moved and their location when in use is unknown.

WILLOW BRANCH

Spring

Sub-irrigated Meadow

Note: Amount of land benefited by irrigation indefinite.

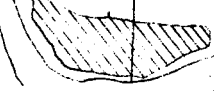

65

56

42

RIVER

02

R. Campbell 62

SORE-FOOT CREEK

DAV

JOHN

32

P. & M. N. III

14

Surveyed Aug. 17 & 21, 1926.

