


15

J.E. Moidment

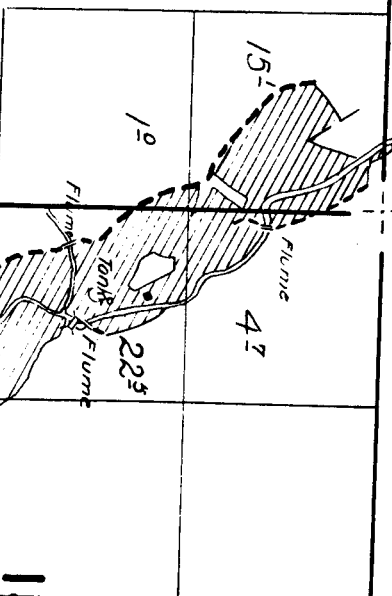

14

13

May 28, 1925

22

23

24

27

26


25

*Note: Streams except in the vicinity of
irrigated land are sketched in the
approximate location*

34

35

36

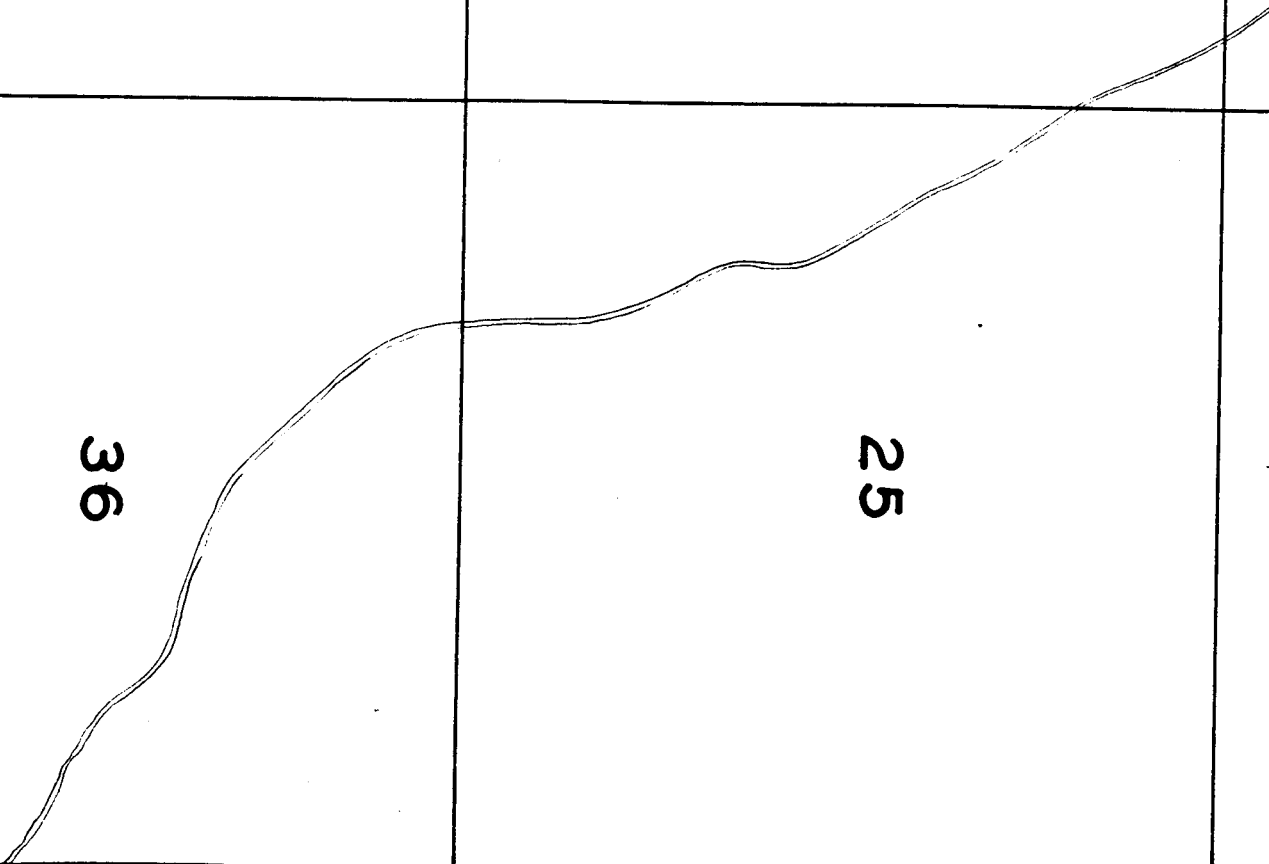

21


22

28

27

33

34

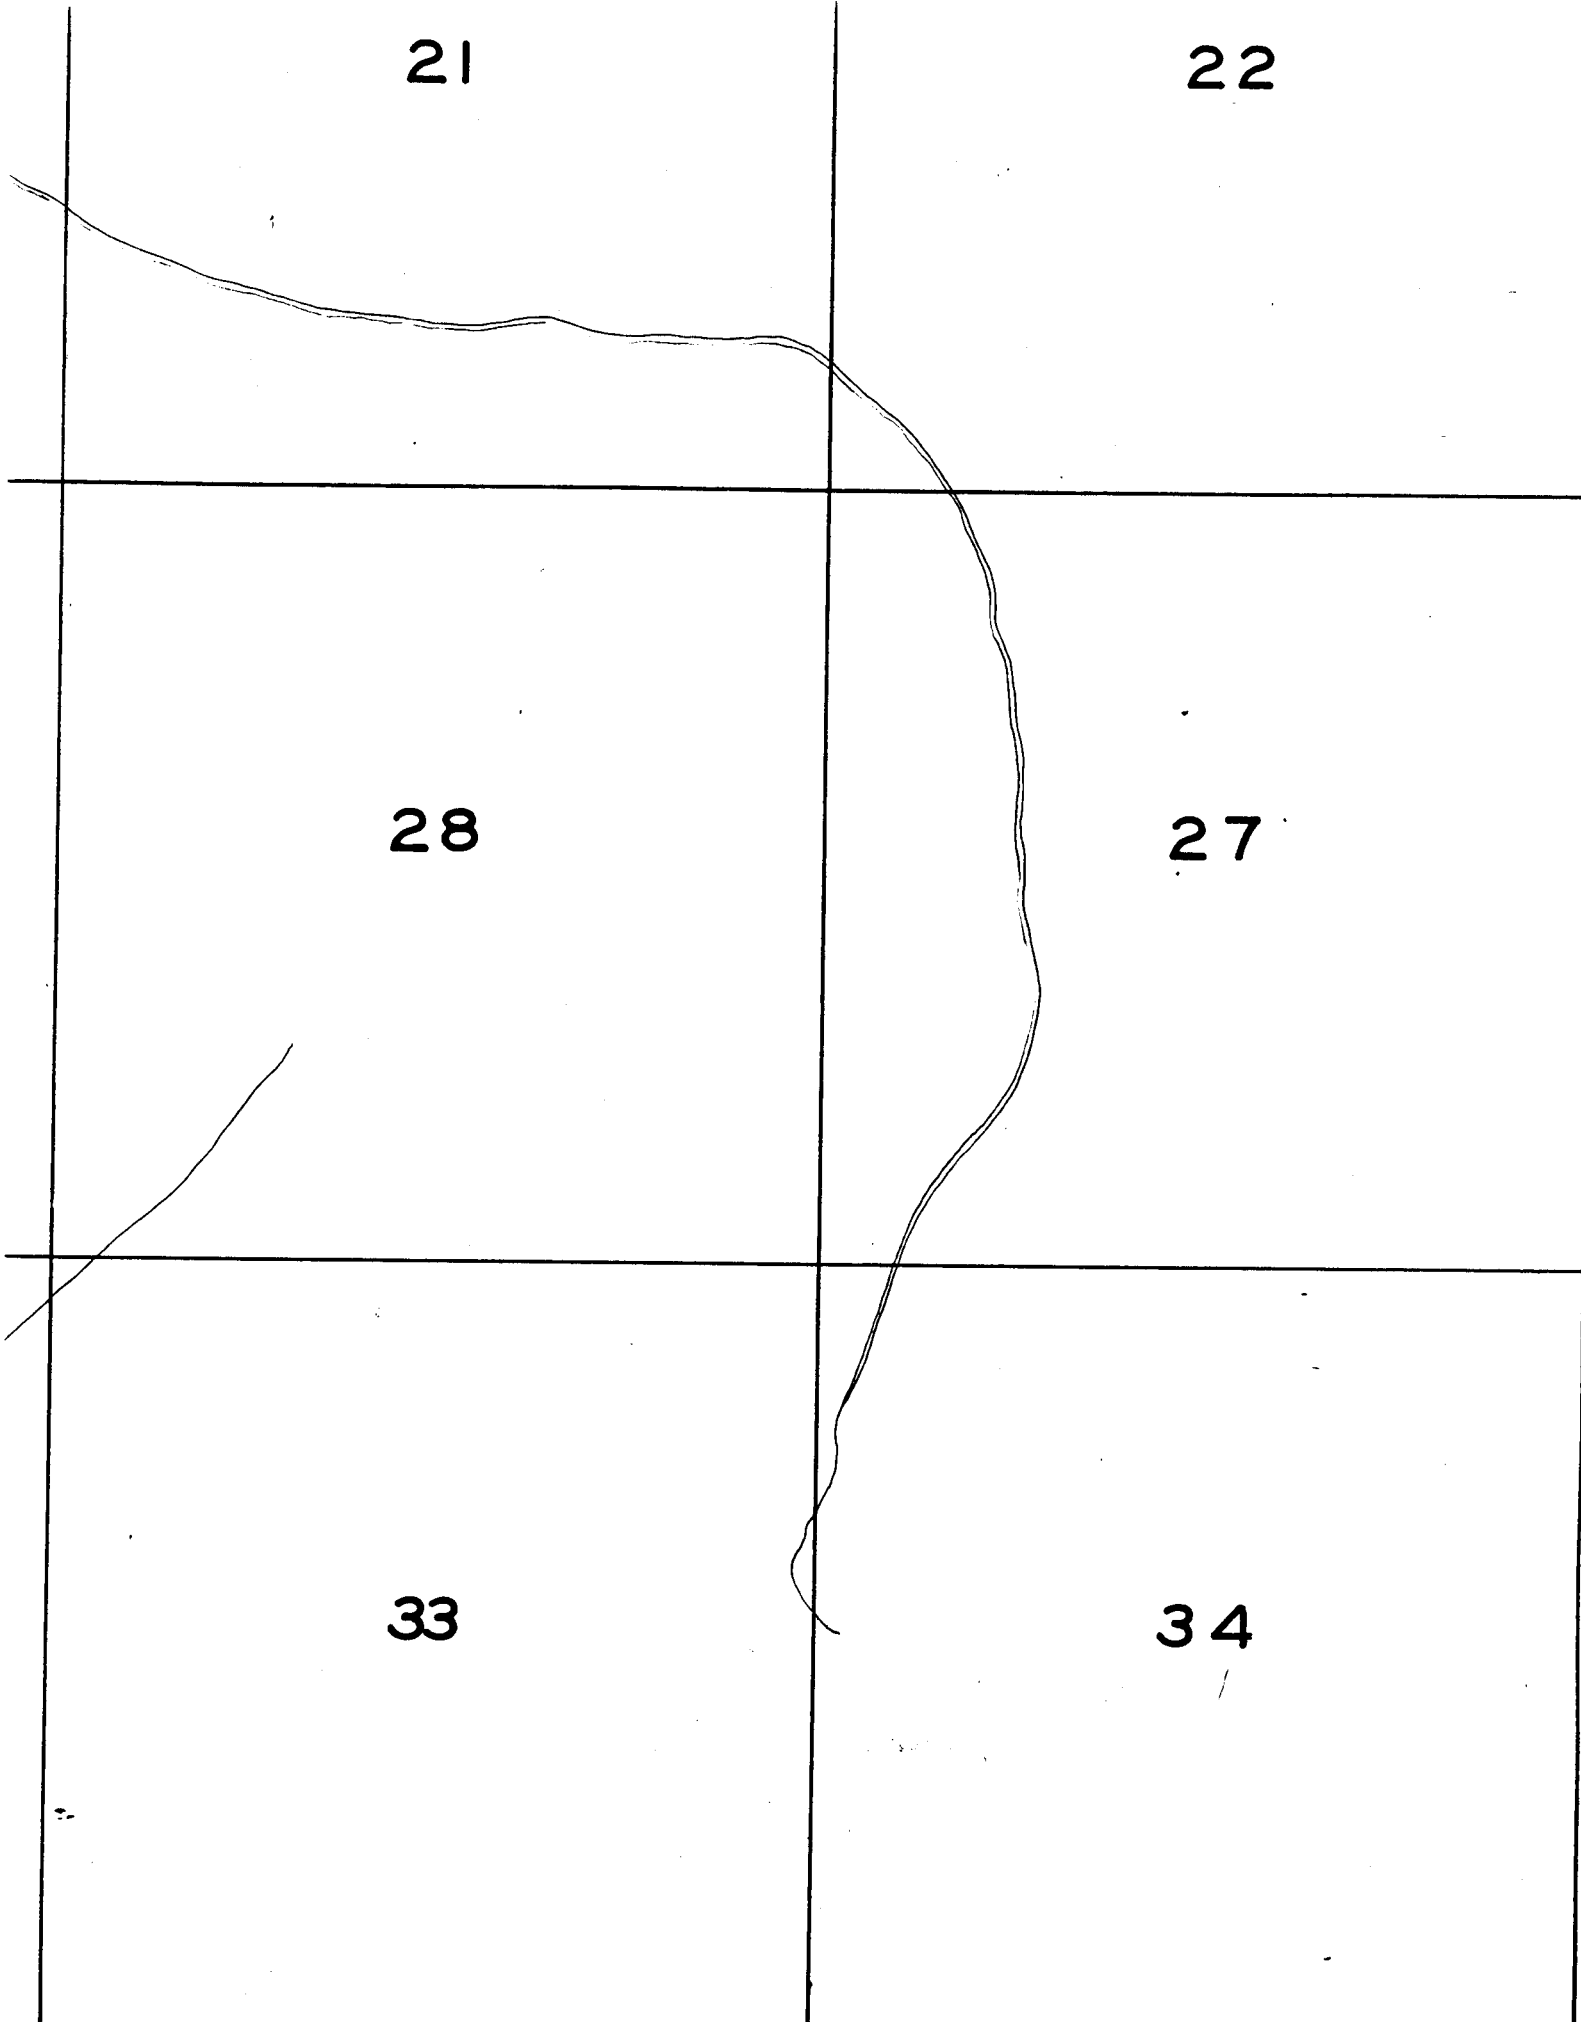

6

5

7

8

18

17

2


1

11


12


14

13

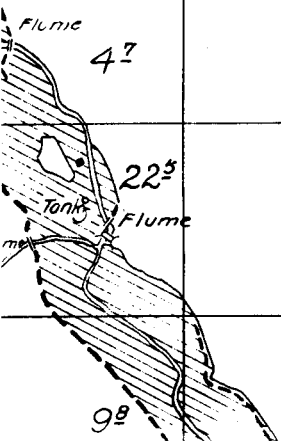

TOWNSHIP 5 S., RANGE 23 E.

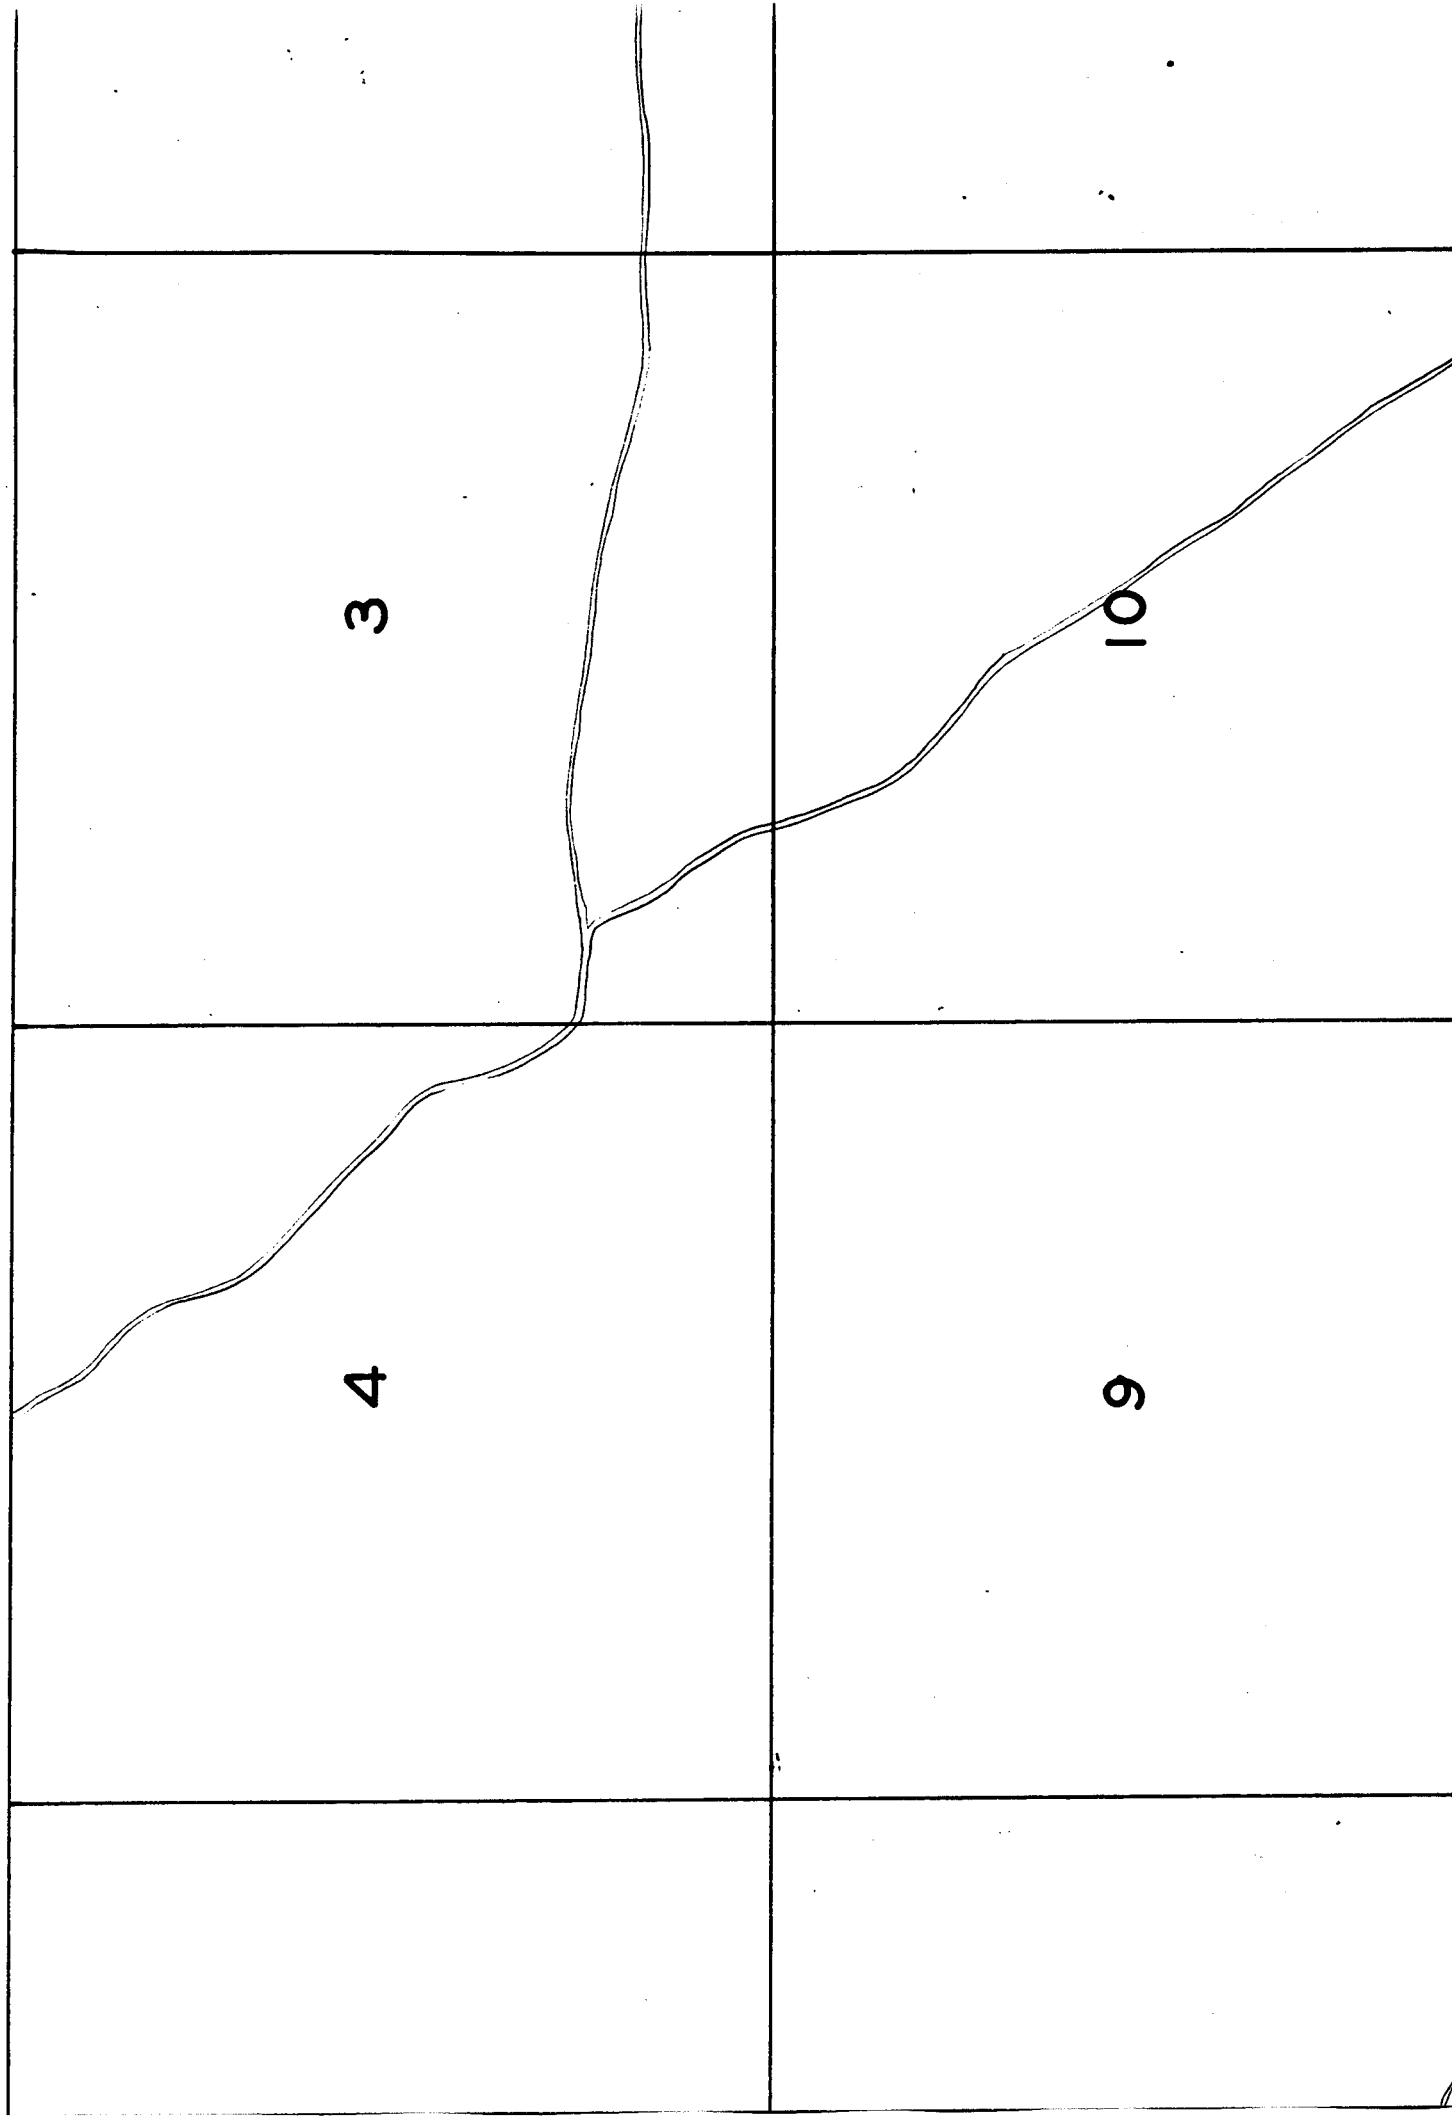

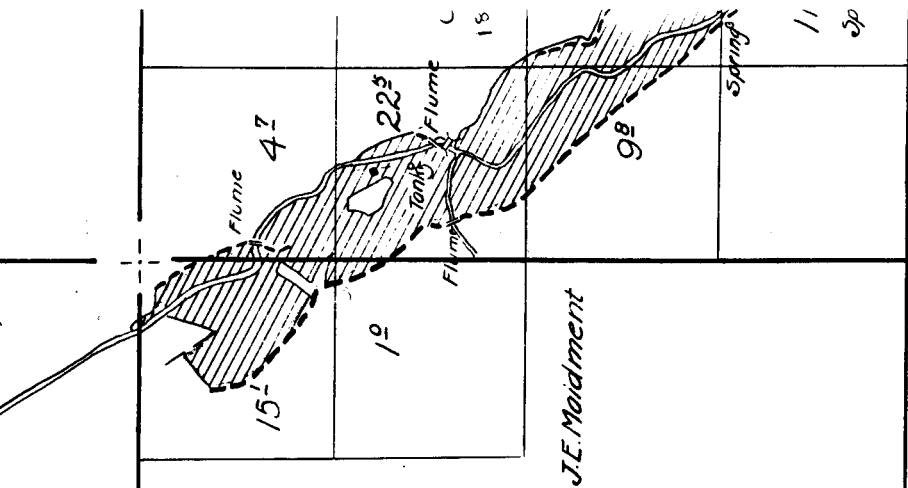

Sp

Surveyed May 28, 1925

22

21

30


29

28

31

32

33

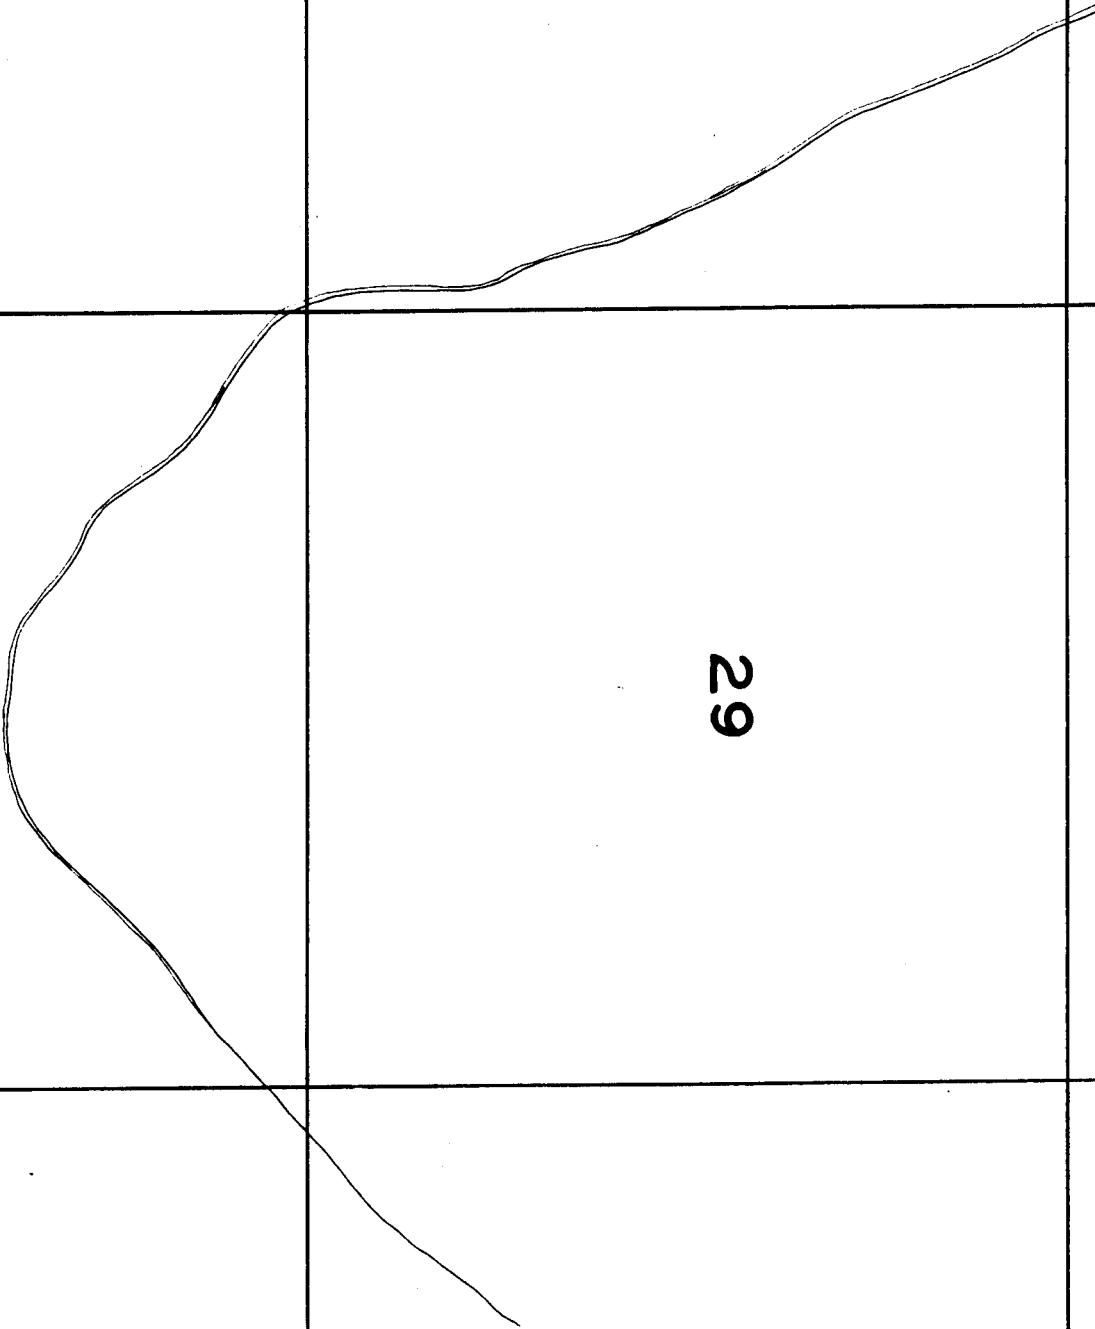

18

17

16

19

20

21

