


NOTE: Streams and vicinity of irrigated approximate location.

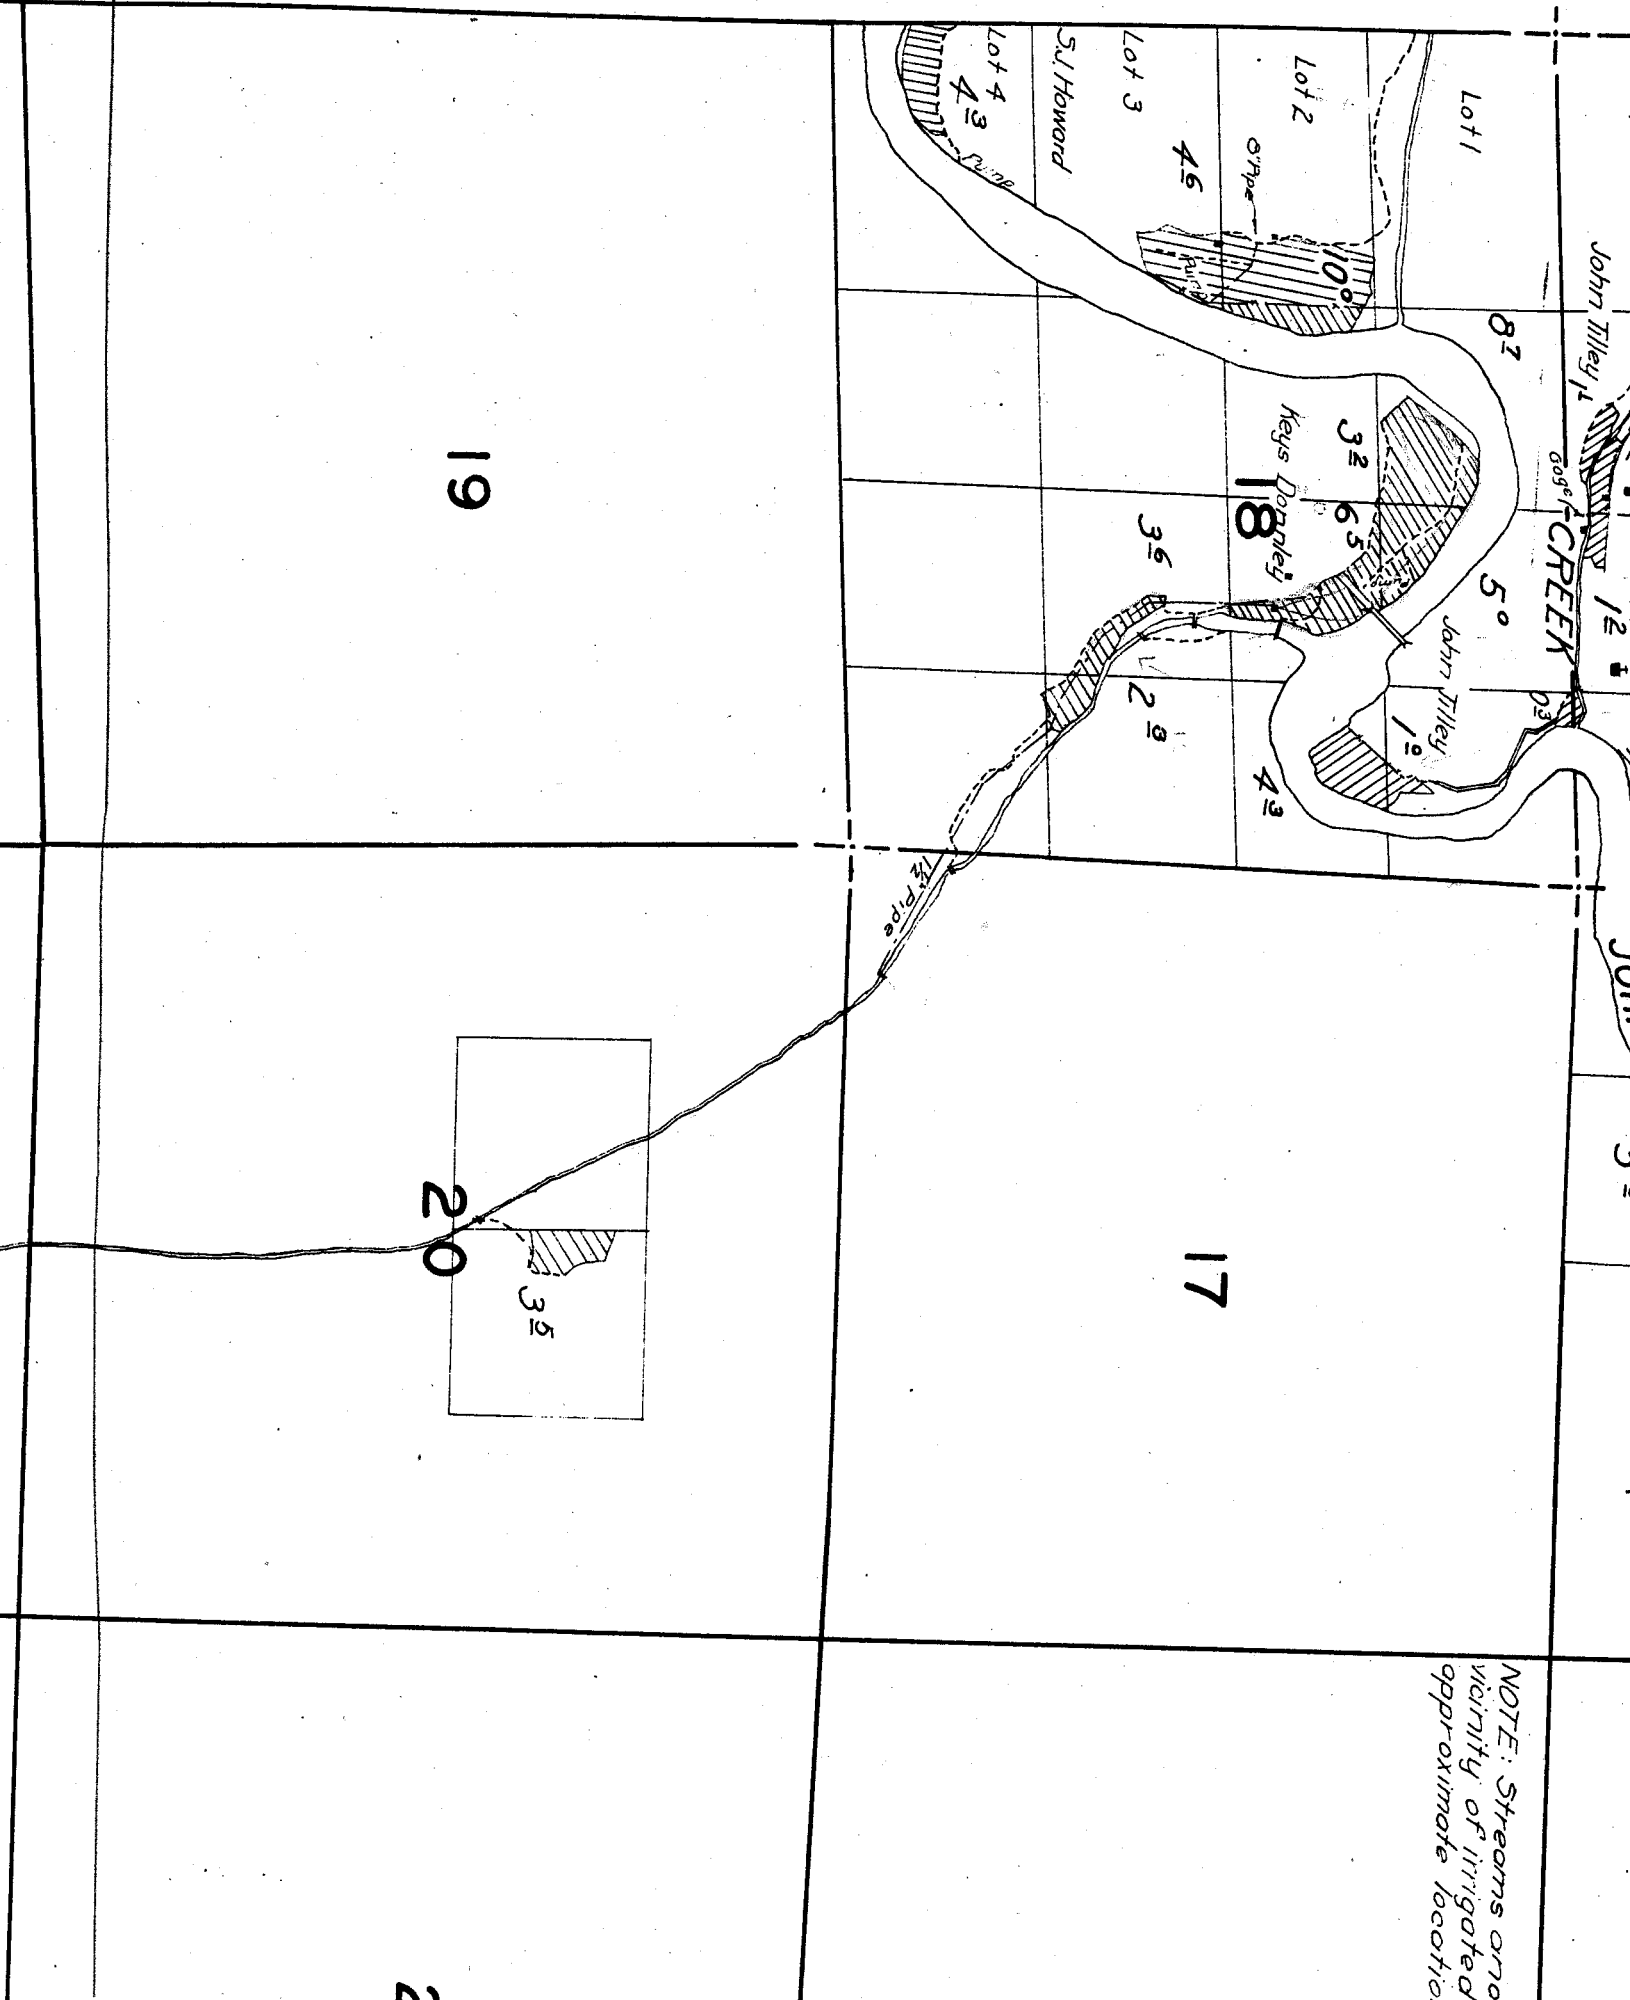

30


29

2

31

32

33

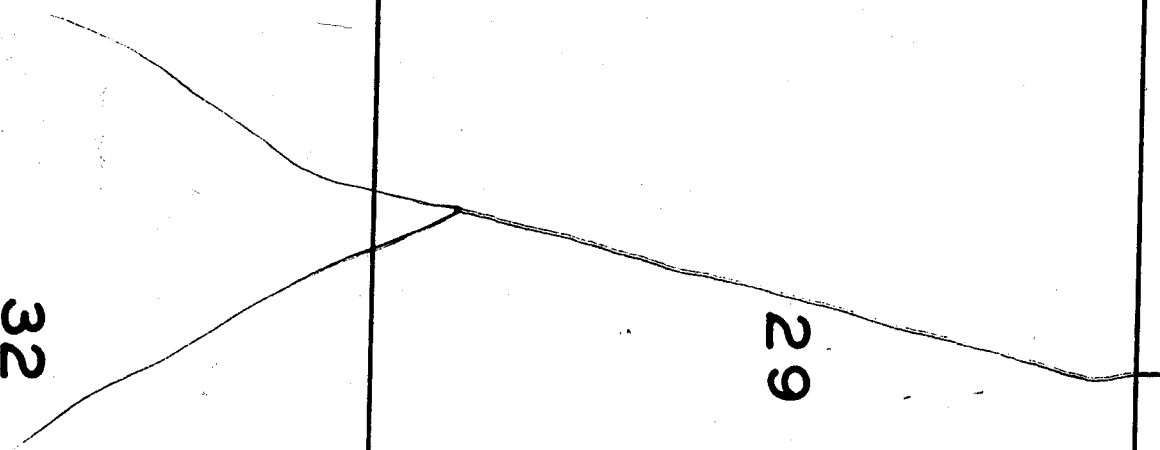

HORSESHOE
13 CREEK

14

15

24

23

22


32

62



2

1

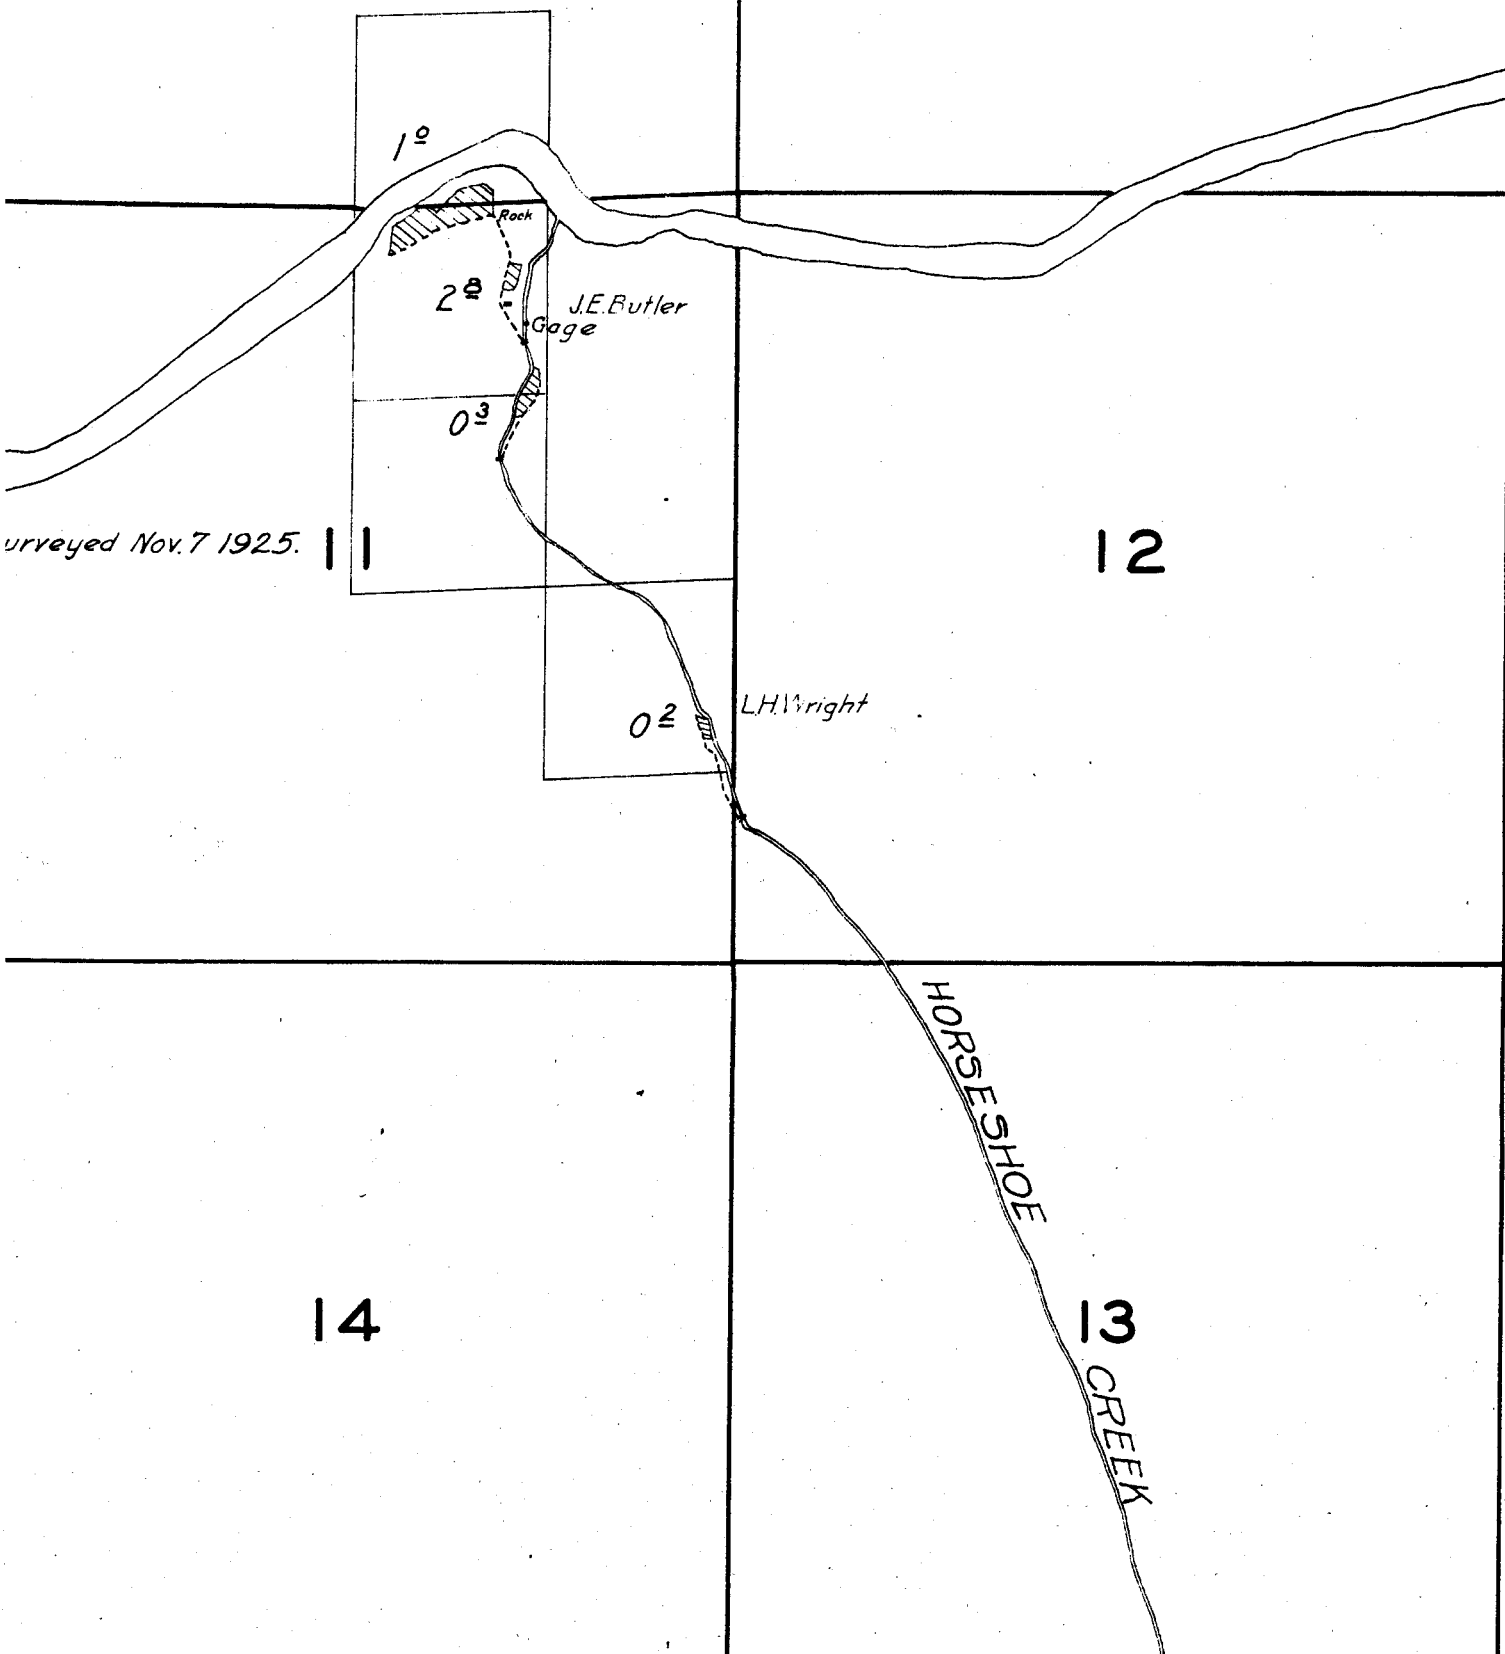

urveyed Nov. 7 1925.

11

12

02

L.H. Wright

14

13

CREEK

21

22

28

27

33

34

6

5

Surveyed Oct. 26, 22, 23, 1925.

7

8

Lot 1

Lot 2

Lot 3

Lot 4

M.J. Campbell

SERVICE CREEK
POST OFFICE

John Tilley

Ross Thomas

JOHN

5³

809° CREEK

Lot 1

Lot 2

Lot 3

S.J. Howard

Lot 4

Keys Donnelly

18

John Tilley

4⁶

3²

3⁶

1²

4³

2³

17

SERVICE

DAY

1 1/2 Pipe

NOTE: Streams and river except in the vicinity of irrigated land, sketch in approximate location.

7

16

15

35

21

22

TOWNSHIP 9 S., RANGE 23 E.

