

2

1

11

12

14

13

21

22


28

27

*Streams, except in the vicinity of
irrigated land are sketched in the
approximate location.*

33

34

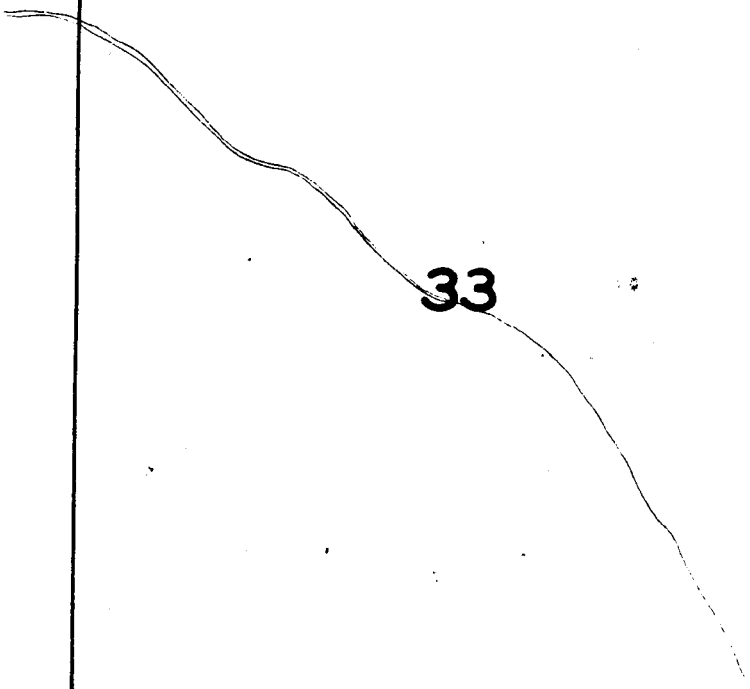

6

7

18

Lot 3.

Lot 2.

Lot 1.

0°

JOHNSON CREEK

Dale Stevens

5

15

6°

36°

1°

20°

Dam

J.B. and Roy Huddles

8

LONEROCK CREEK

Spring


Lot 4.

1°

Lot 1.
2°

Dam

17

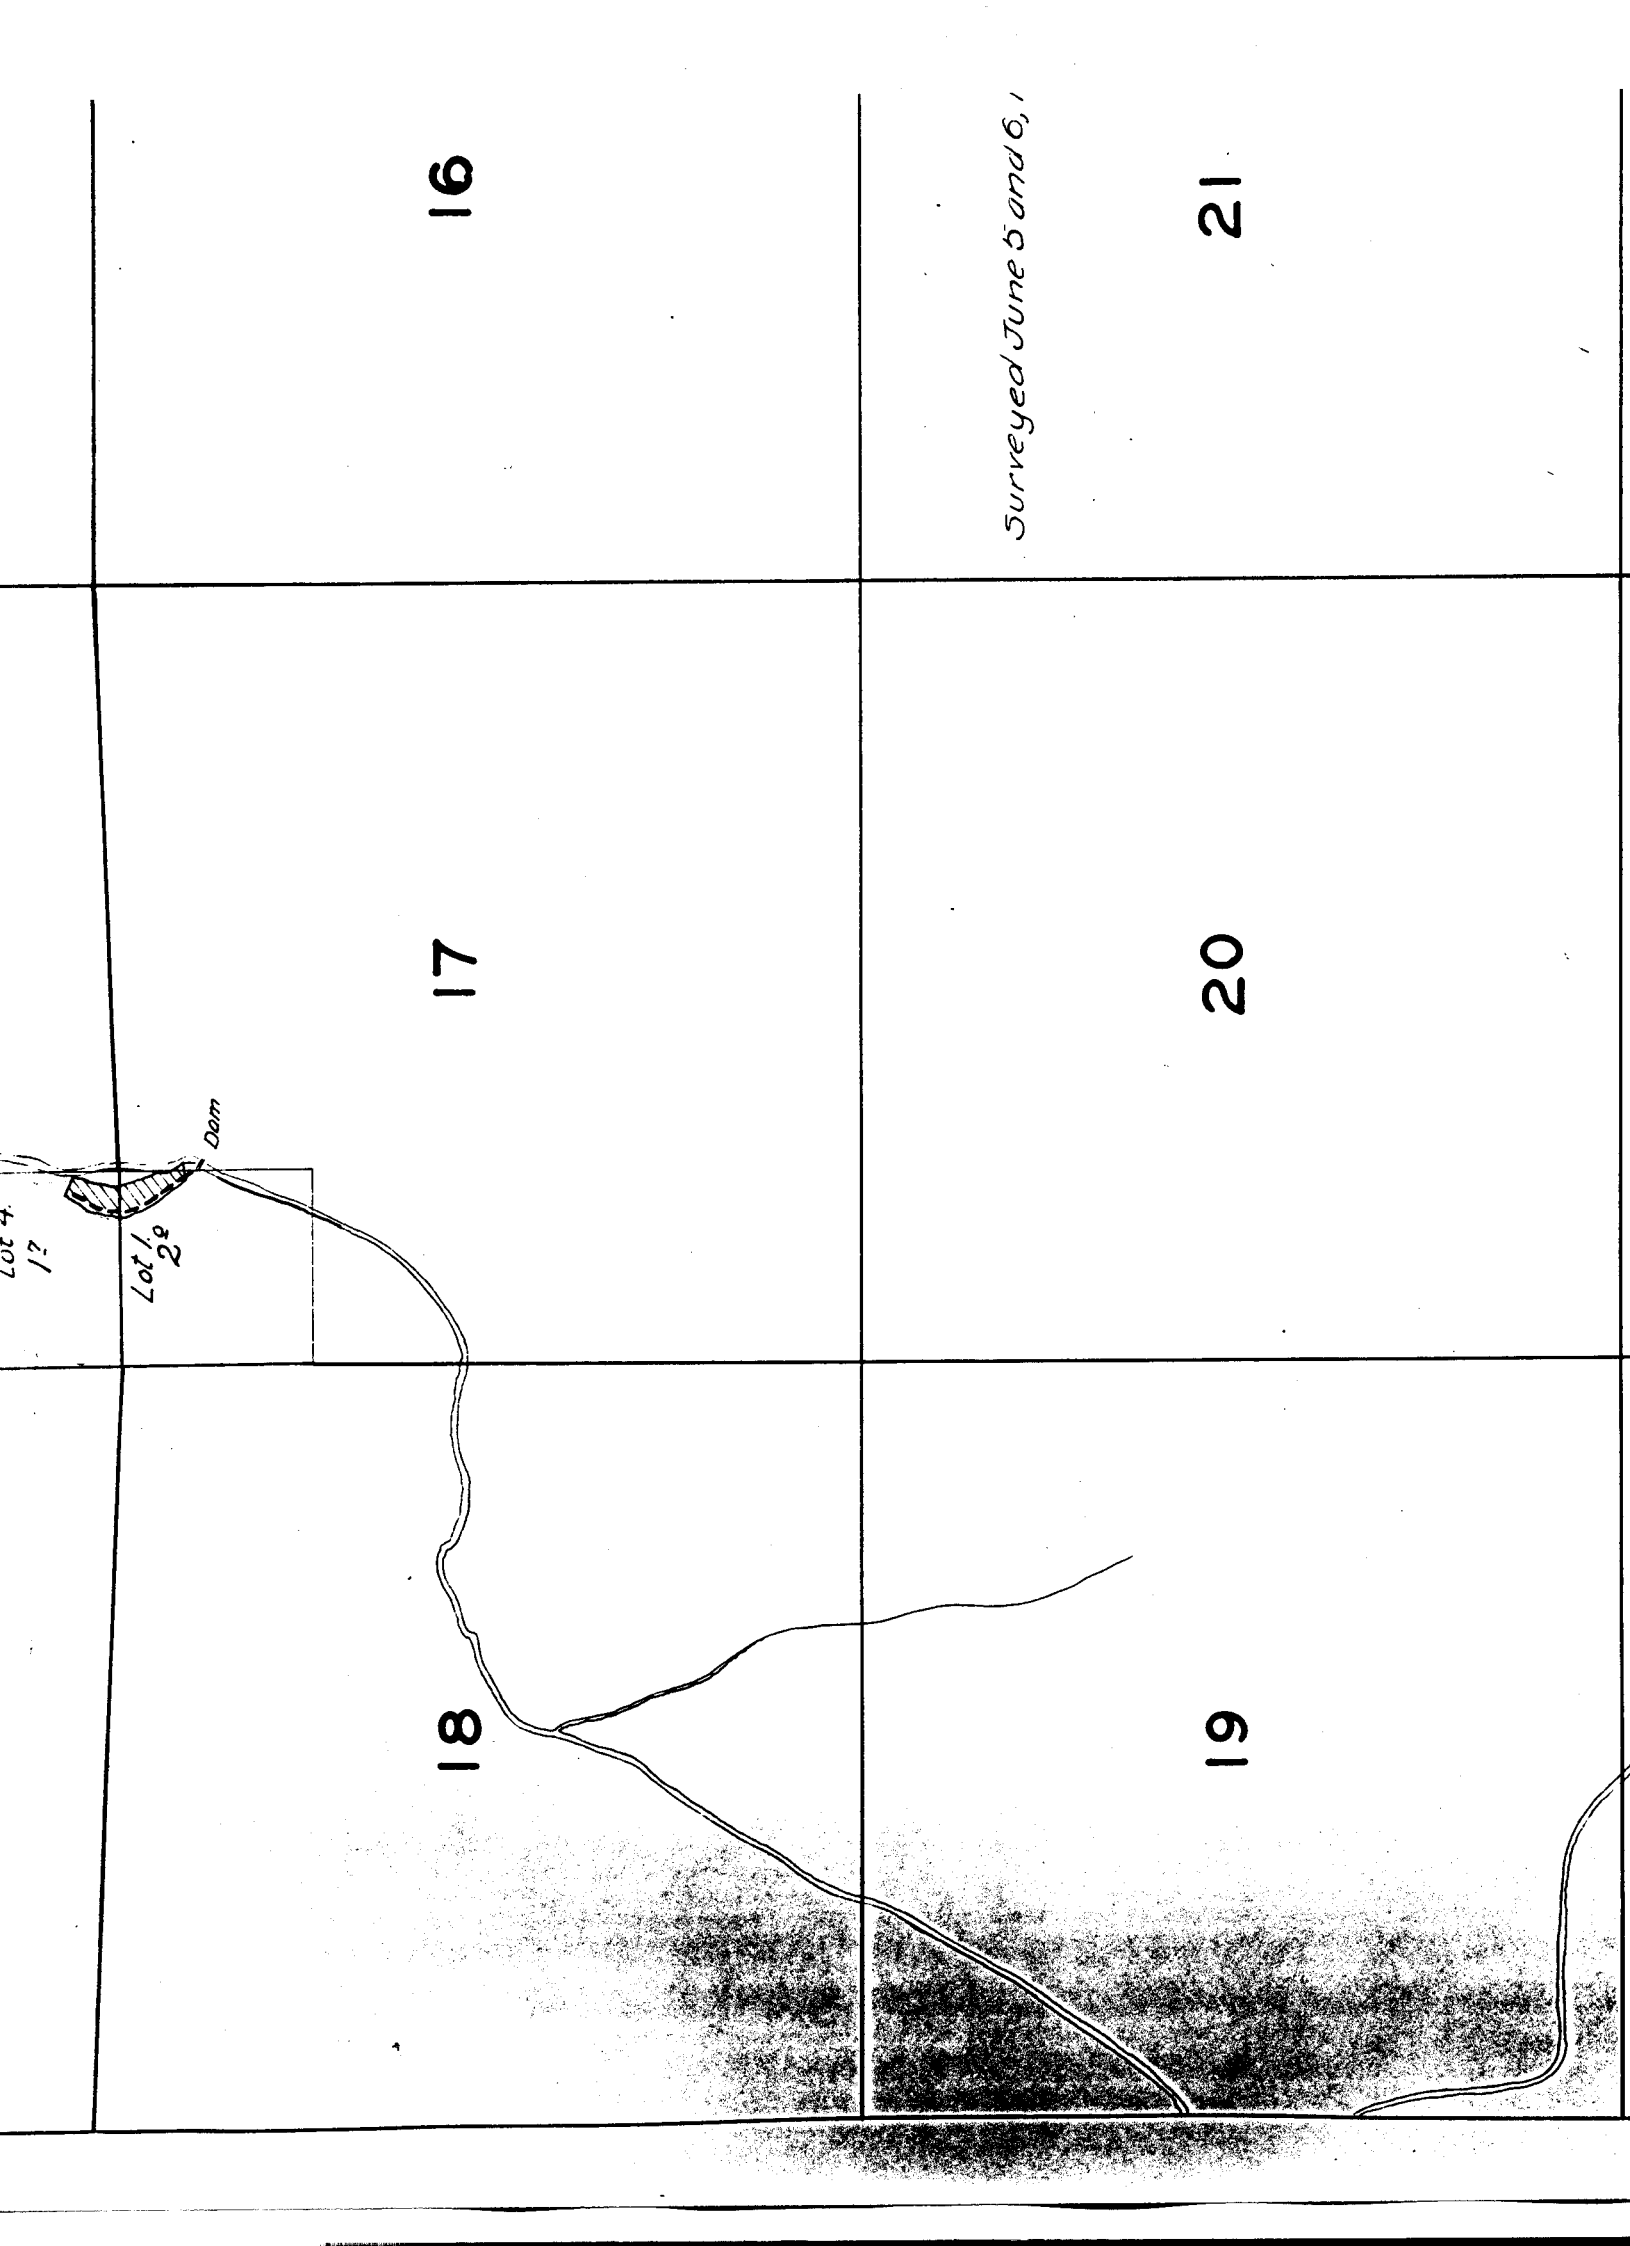

16

Surveyed June 5 and 6, 1

21

17

20

18

19

Lot 4
1?

Lot 1
2

Dam

28


29

30

33

32

31

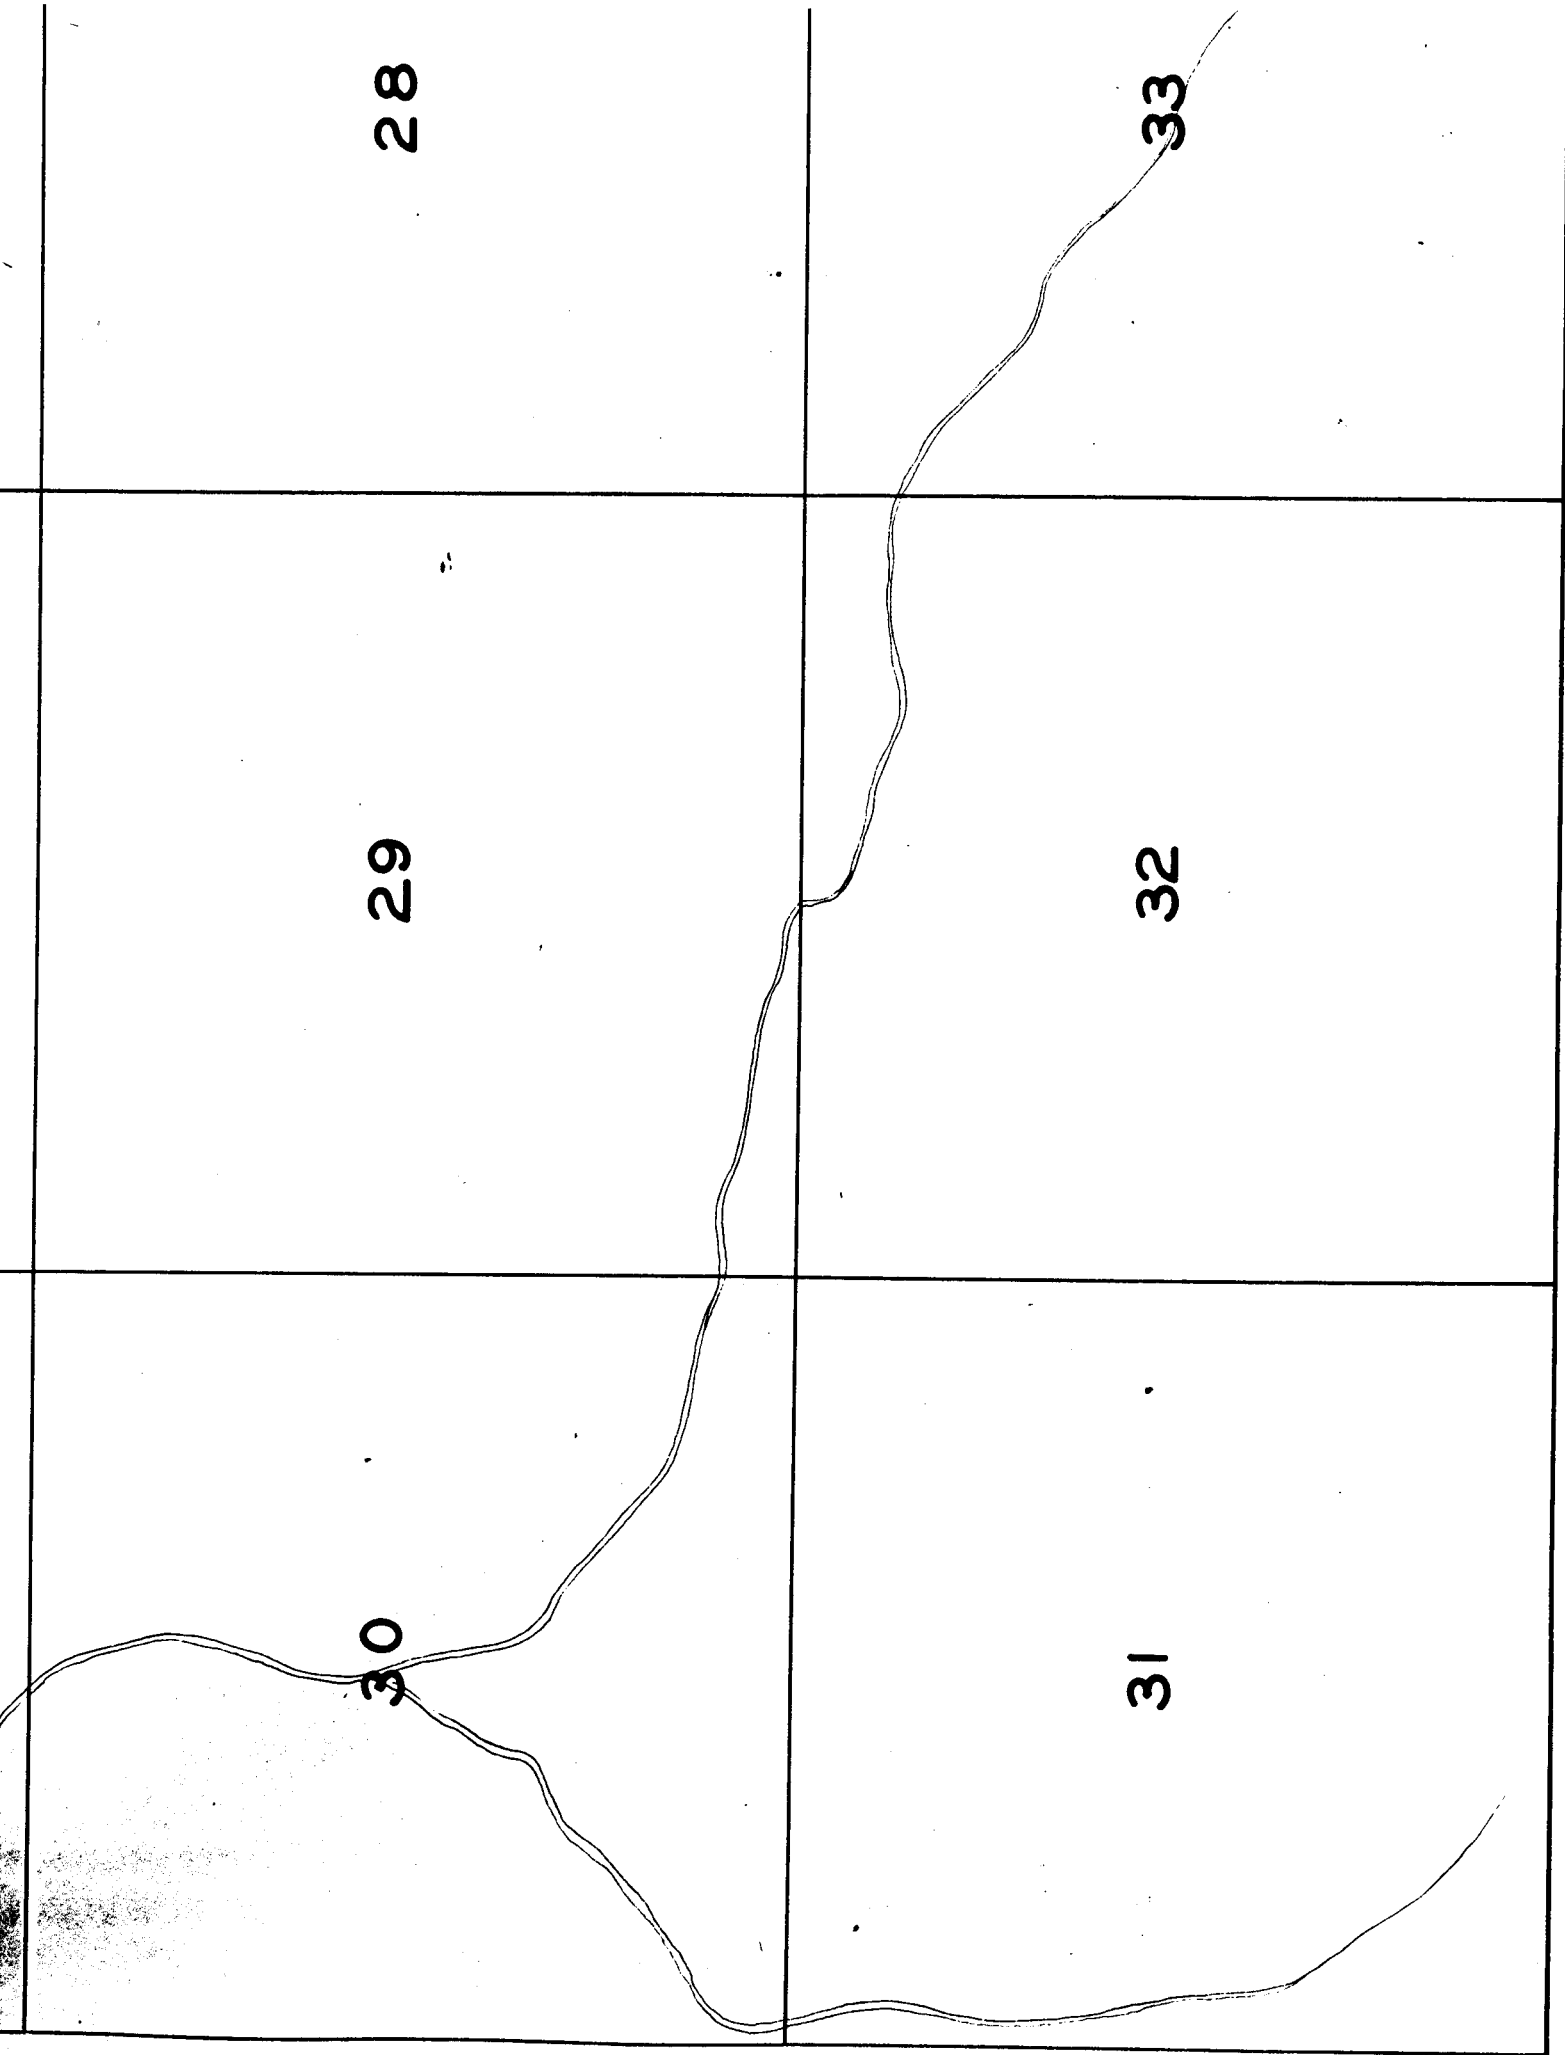

13


24

14

23

15

22

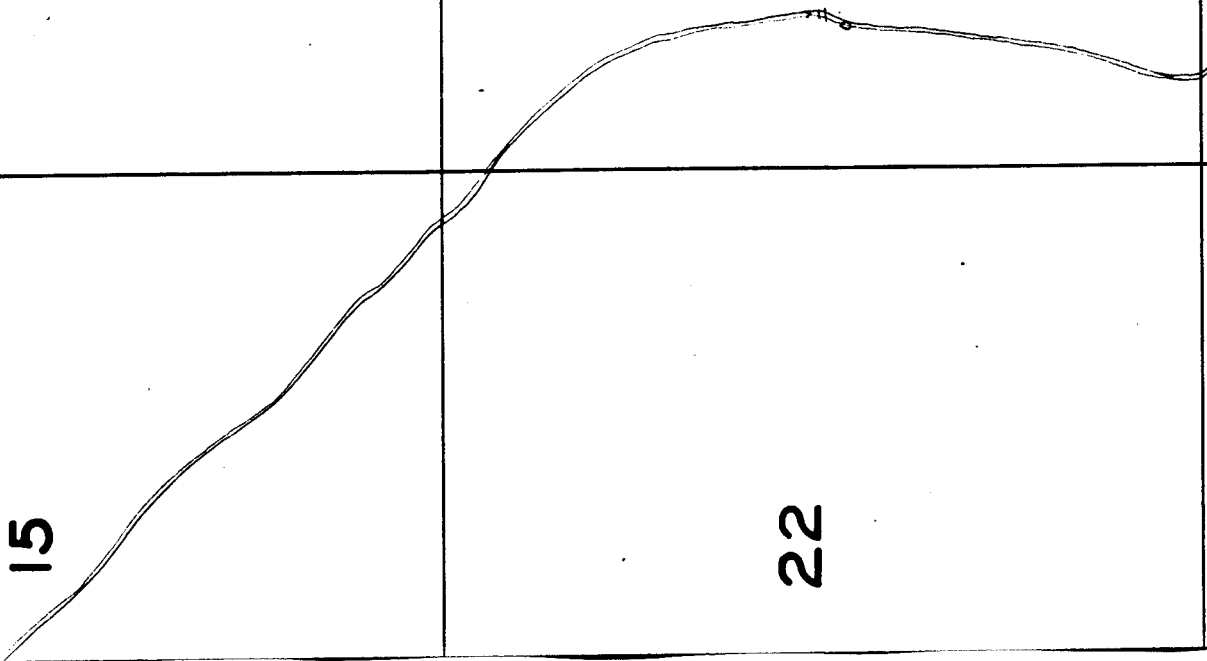

27

not in the vicinity of
are sketched in the
location.

26

25

34

35

36

17

16


15

Surveyed June 5 and 6, 1925.

20

21

22

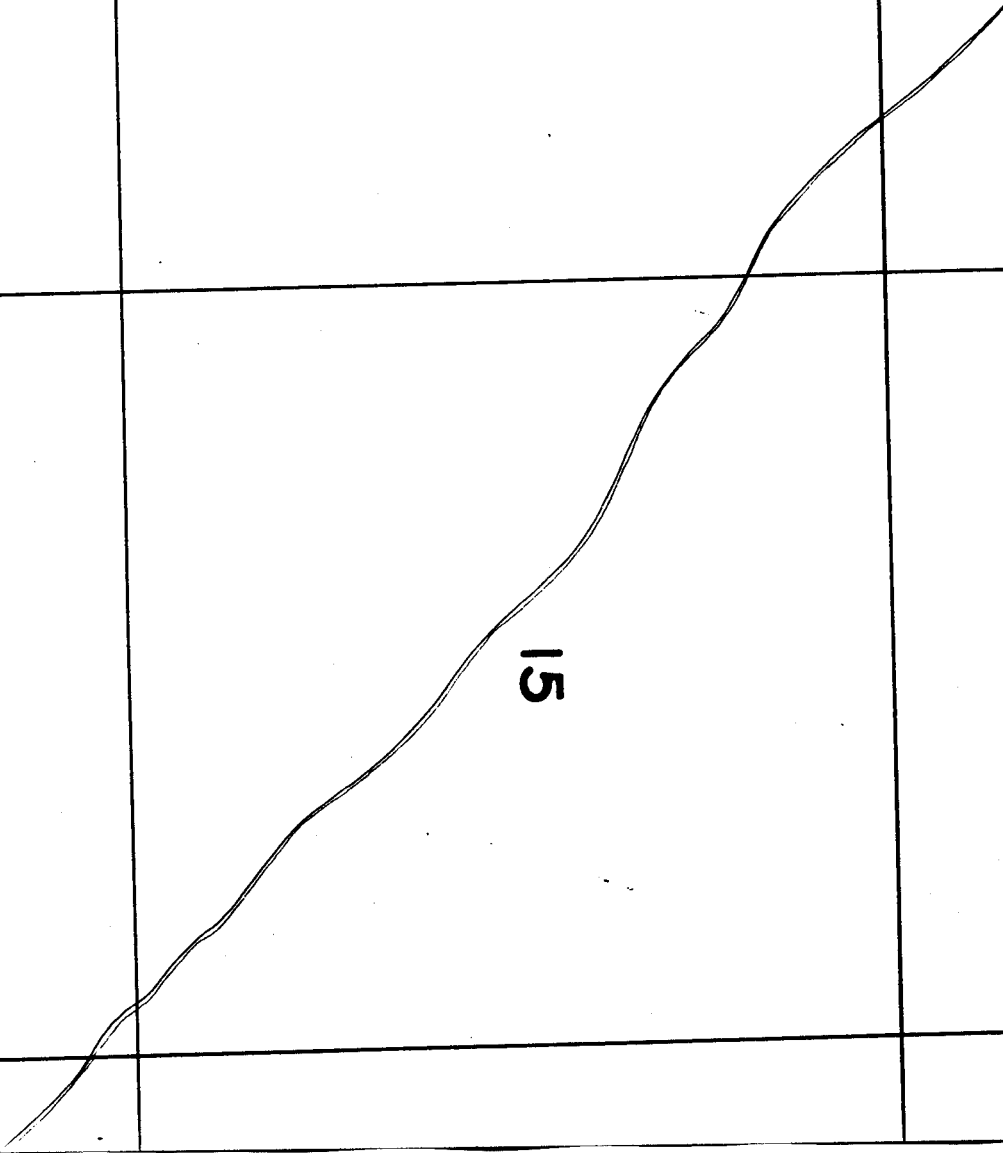

TOWNSHIP 6 S., RANGE 24 E.

