


TOWNSHIP 8 S., RANGE. 21 E.

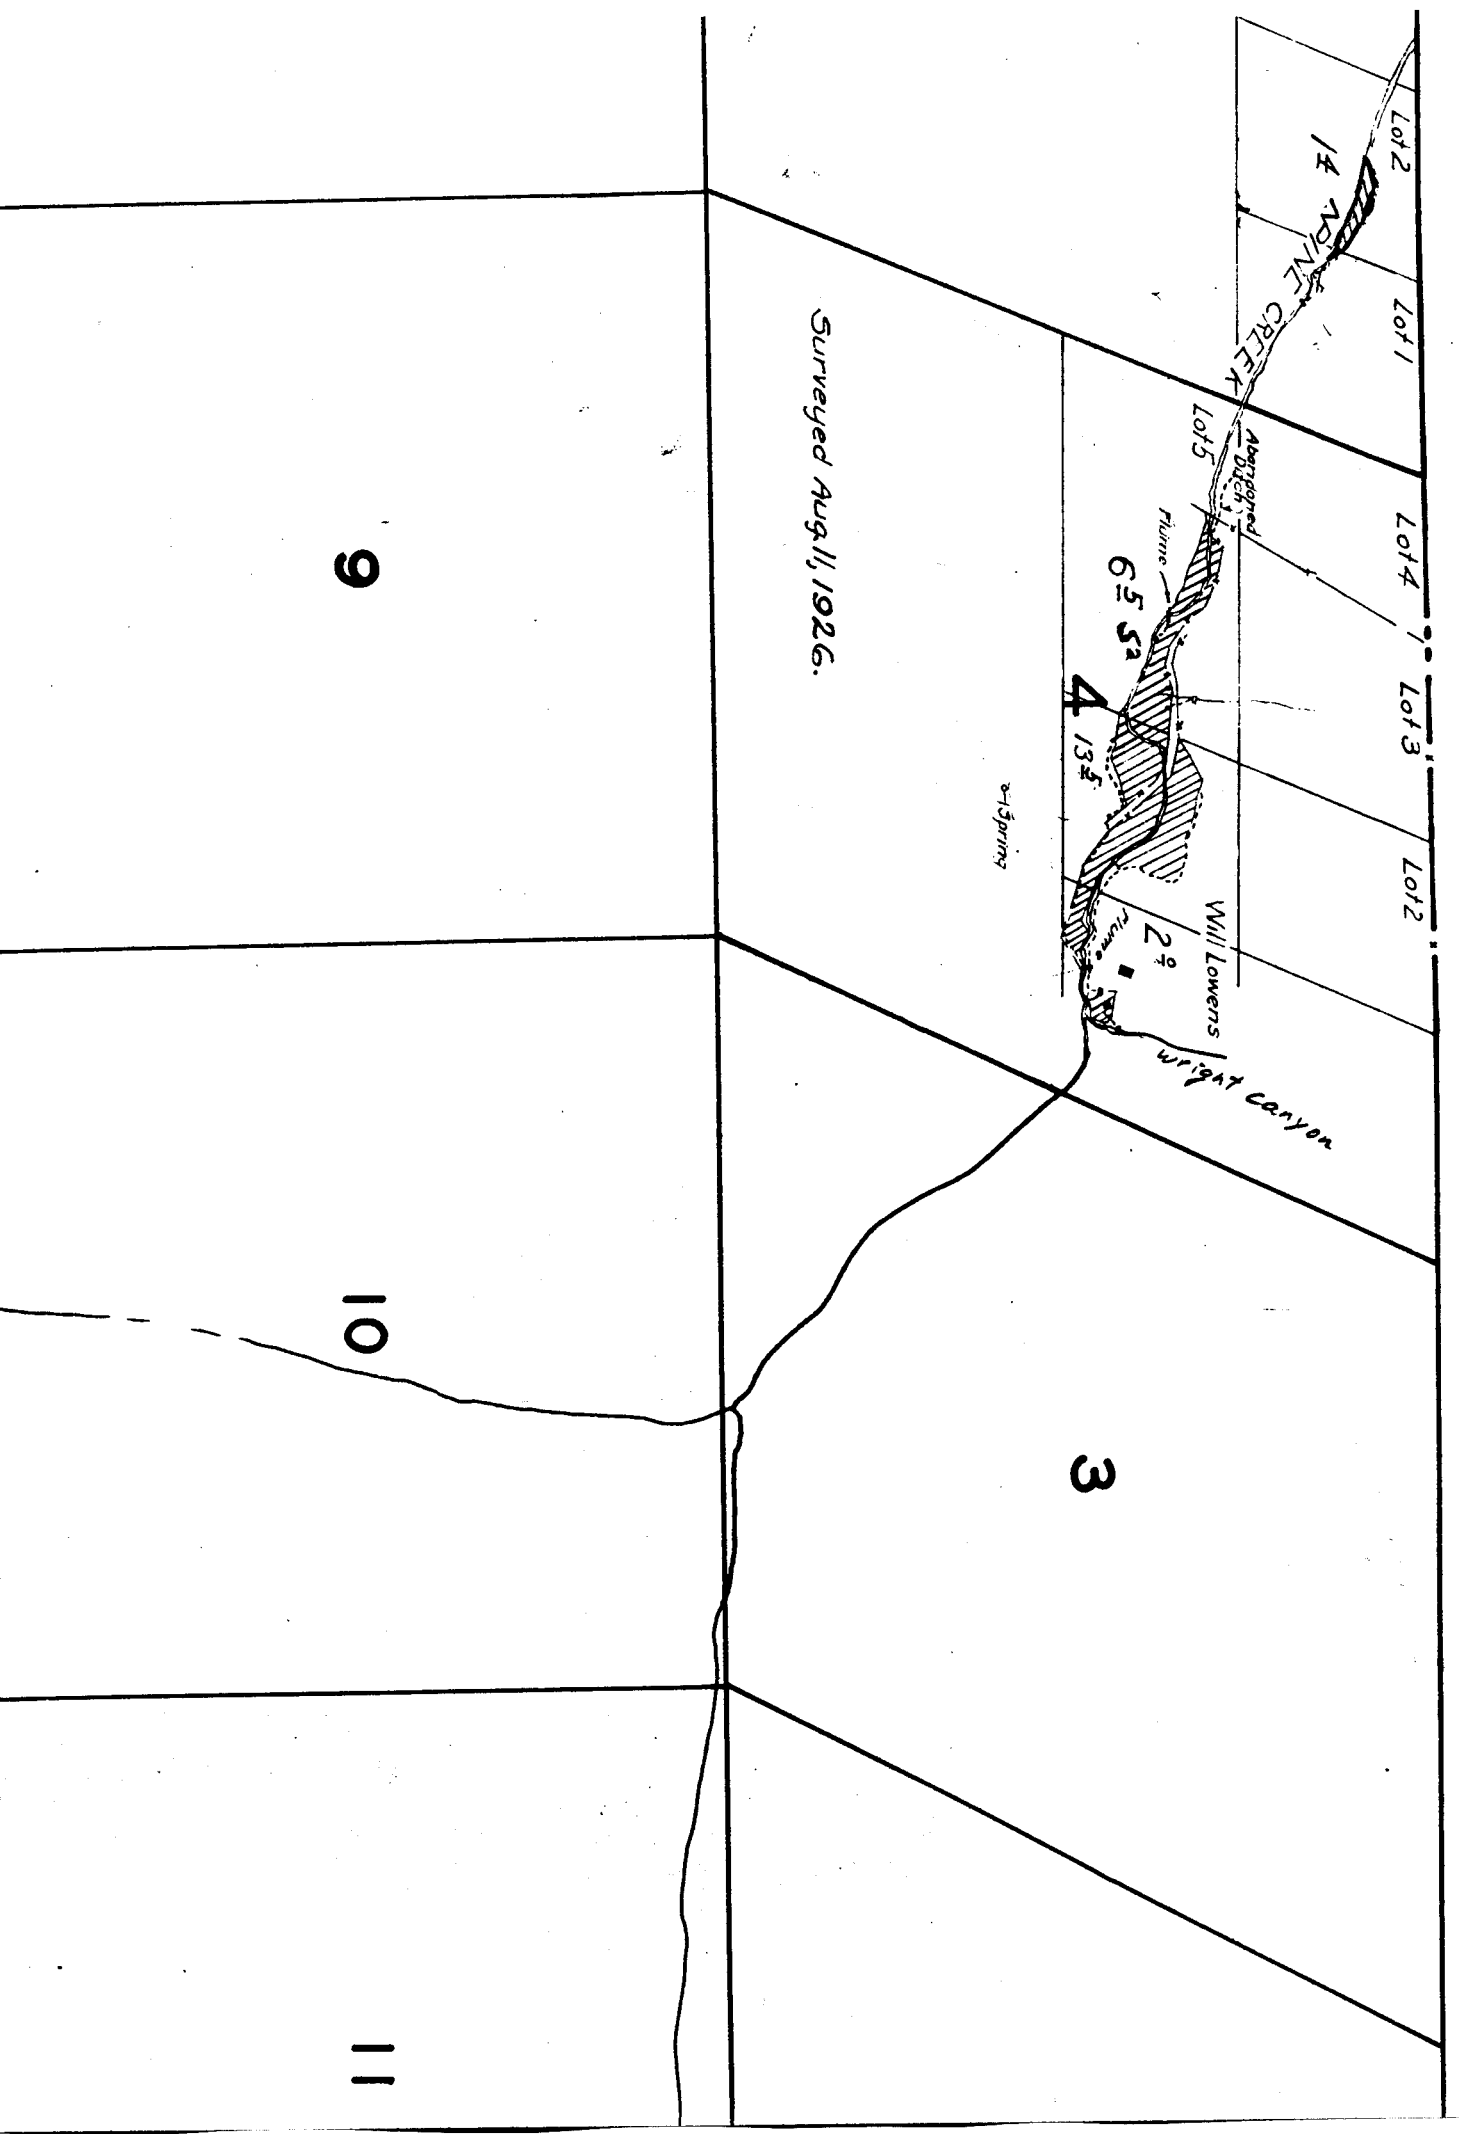

16

15

14

21

22

23

Surveyed Sept. 5, 19

16

21

17

20

18

19

28	29	30
33	32	31

27

26

25

Note: Streams, except in the vicinity of irrigated lands, are sketched in approximate location.

34

35

36

ROWE

15

14

13

22

23

24

Surveyed Sept. 5, 1926

Spring



Spring

Chas. Palmer
Palmer Bros.

Lot 4

Tom Huntington

7⁰


6⁰

2⁴

4³

CREEK

Point

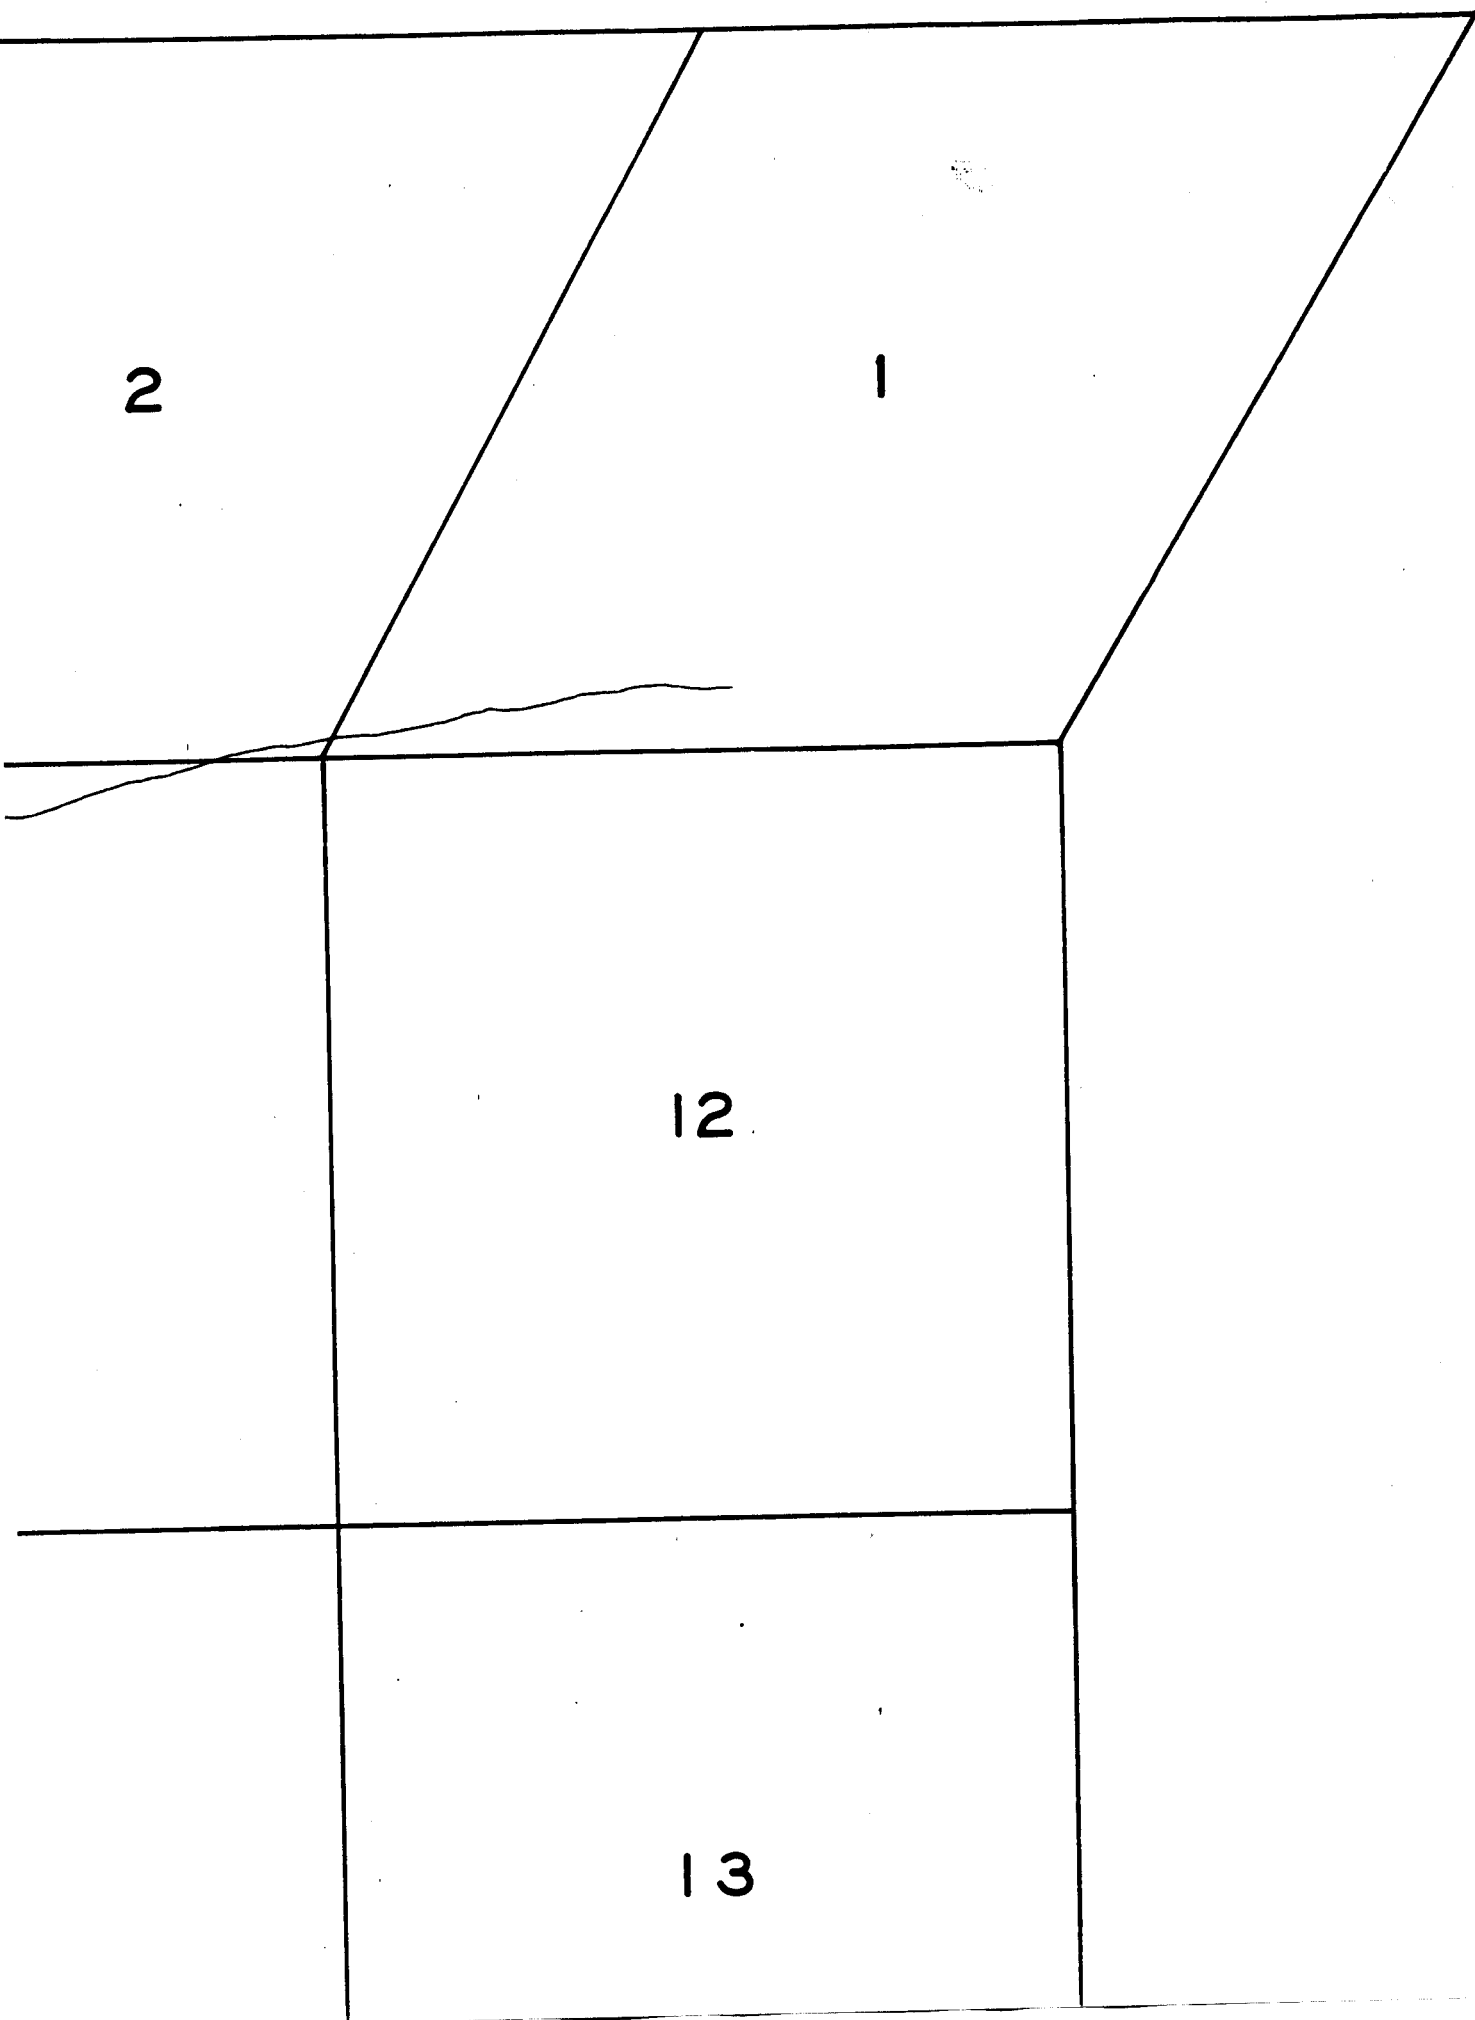

21

22

28

27

33

34

A.S. Conlee

Lot 2

14

6

5

*Note: Section line bearings
and distances taken from
U.S. Township Plats.*

7

8

18

17