

21

22

4°

3°

Spring

L.H. Donovan

113
CREEK

12

175

4°

HAYSTACK

Bob Wright

J.F. Asher

28

Spring

172

Surveyed Sept. 19 to 23, 1926

Steiner

27

5°

C.W. Walls

16

33

A.E. Cress

12

34

139

40°

Now C-35285

27°

07

12°

218

Pump

33

Pri Jenkins

2

1


11

12

14

13

TOWNSHIP 8 S., RANGE 25 E.

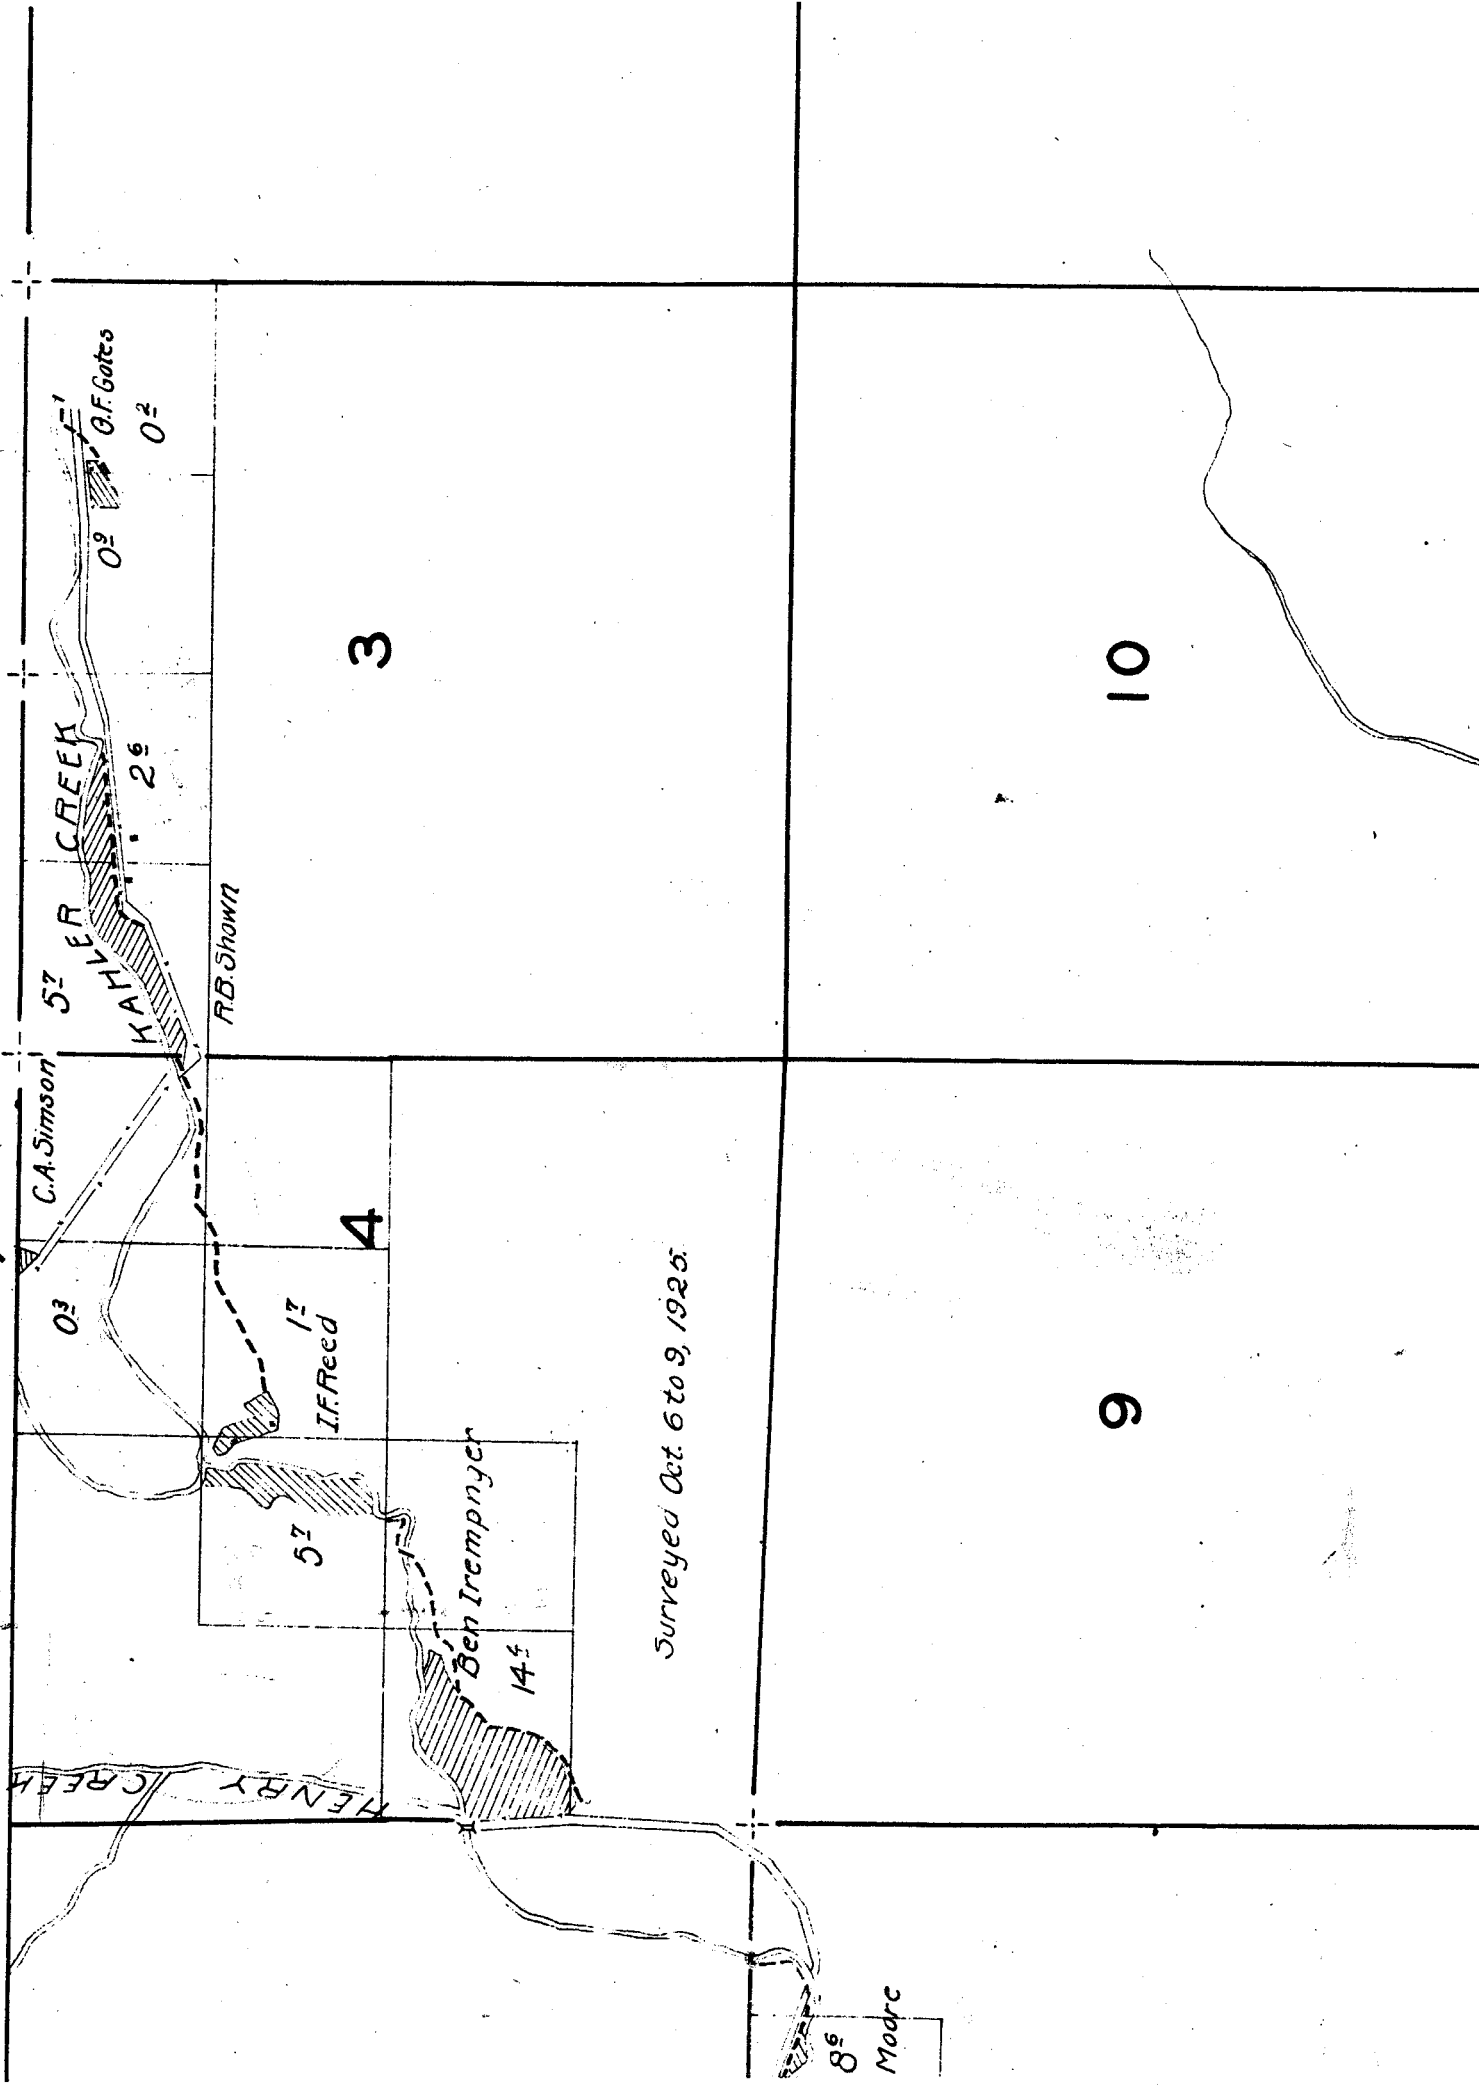

15

22

16

21

L.H. Donovan

Spring

35

75

40

12

112

13, except
nd, 13
ation.

6

5

7

13

03

8

page 8^s

E.R. Moore

07

4^o

A.S. Borges

18

17

30

29

28

Surveyed 56

HAYSTACK

Bob Wing 54

J. Fisher

Spring

L.L. Steiwer

24

15

28

C.W. Walls

15

32

33

1000

L.L. Steiwer

Can Wagner

Surveyed Sept. 29, 1925

31

First National Bank

London

03

34

20

28

263

12

40° Now C-27°


218

07

33

Spring


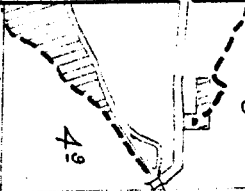

A.S. Borges

4⁹

18

17


16

19

20

21

Note: Location of streams and roads, except in the vicinity of irrigated land, is sketched in approximate location.

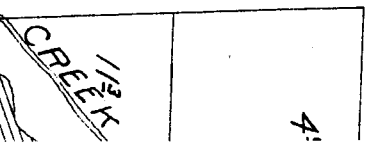

4¹

11/2
CREEK

Surveyed Sept. 29, 1925.

Palm Cr.

27

26

25

34

35

36

15

14

13

22

23

24

IVERB CREEK

02

62

RI Carner

17

05

