

NOTE: Streams sketched in approximate location except in the vicinity of irrigated land.


28

27

Surveyed Nov. 12, 14, 20, & 21, 1925.

FOSSIL 33

34

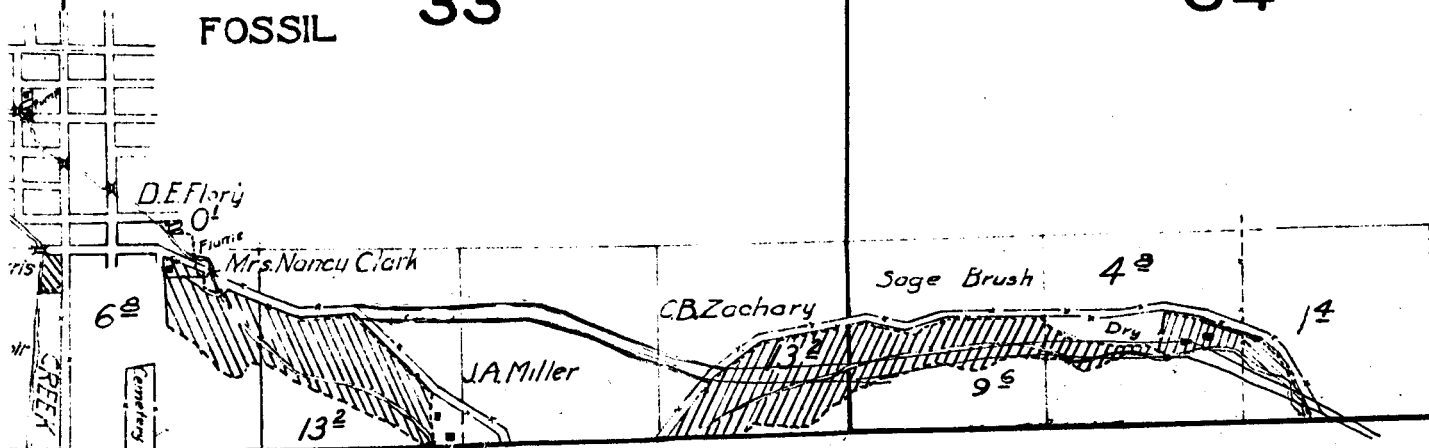

TOWNSHIP 6 S., RANGE 21 E.

4

3

9

10

15

16

22

Thomas Hoover

Spring

21

CREEK

HOOVER

29

135

61

O.C. Veatch

12

24

Brush

Spring

Rock

Wm

NOTE: Streams sketched in approximate location except in the vicinity of irrigated land.

18

17

7

8

6

5

18

17

16

19

20

21

CREEK

HOOVER

O.C. Veatch

19

24

Brush


Spring

Rim

Way


28

Surveyed Nov. 12, 14, 2

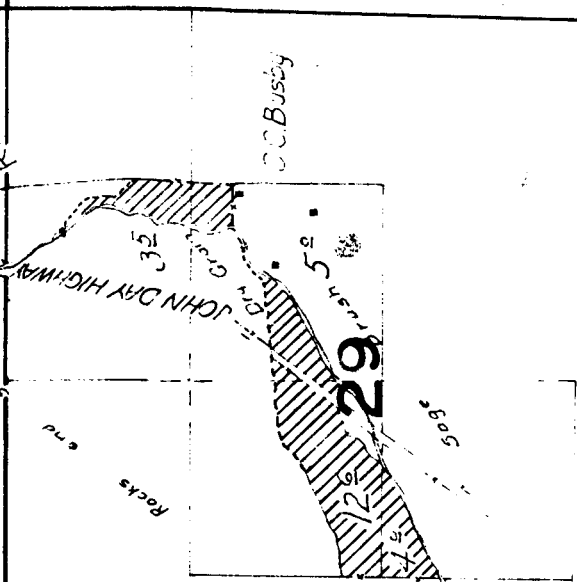

29


30

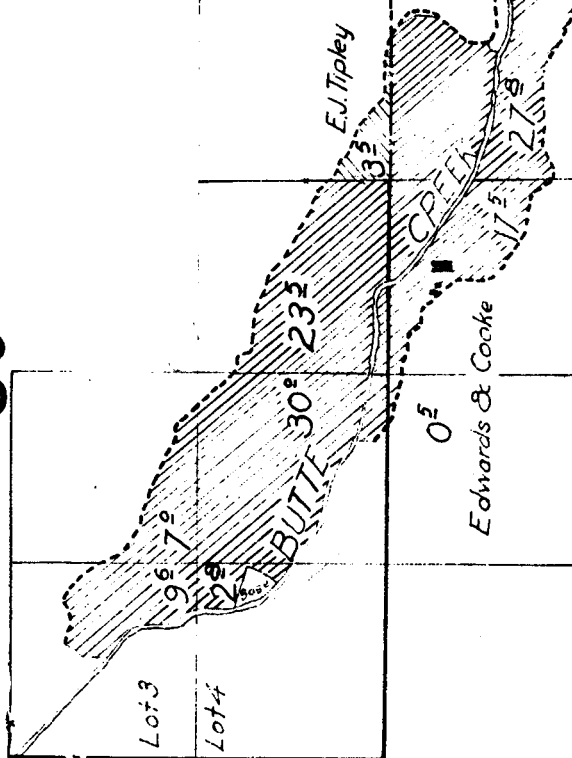

33

FOSSIL

31

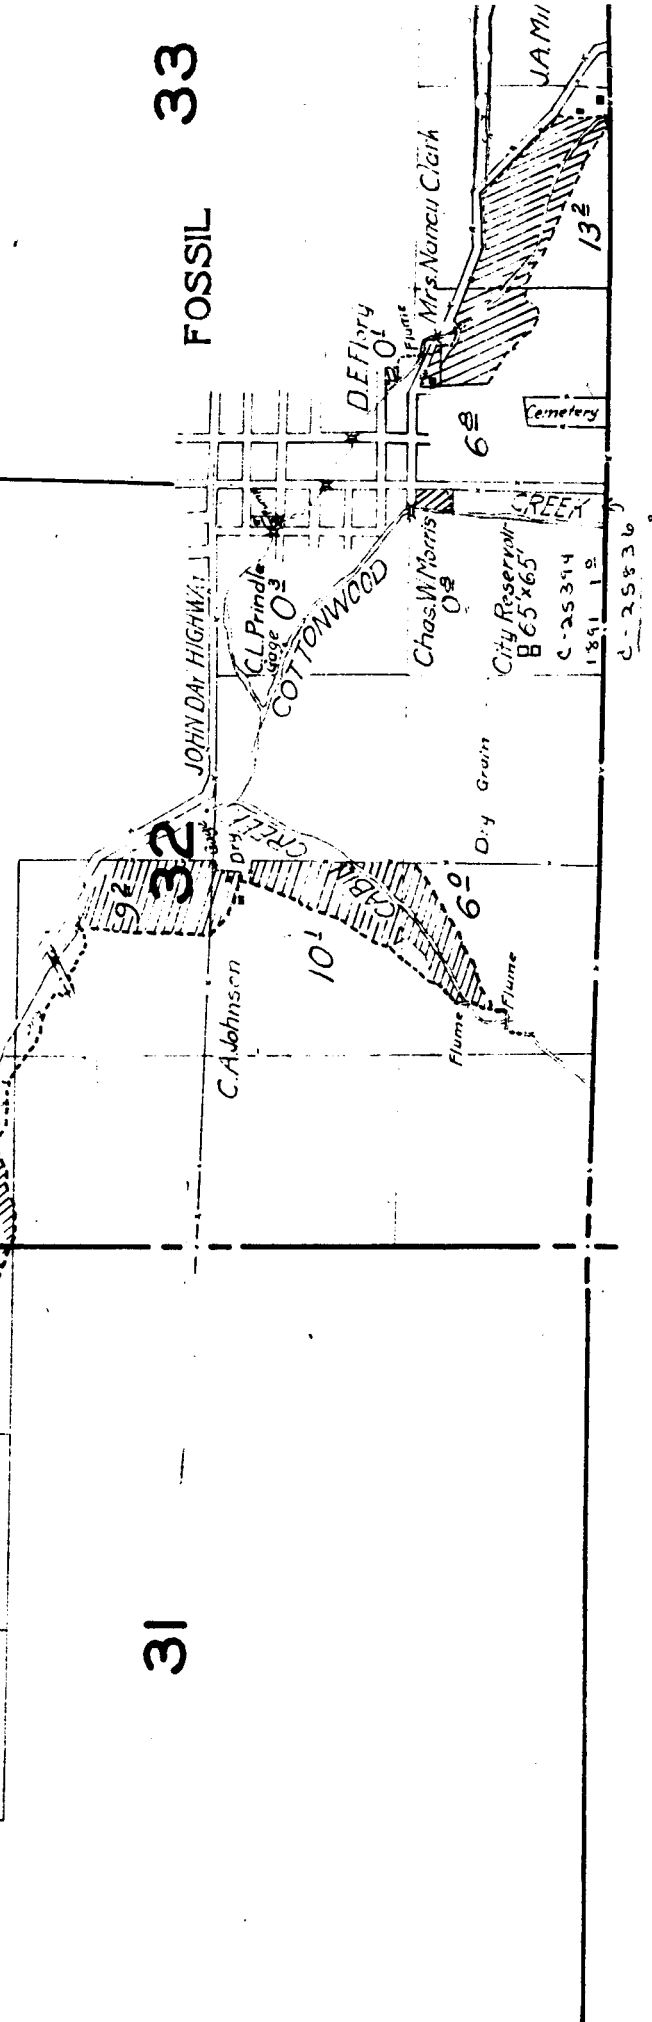

2

1

11

12

14

13

27


26

25

34

35

36

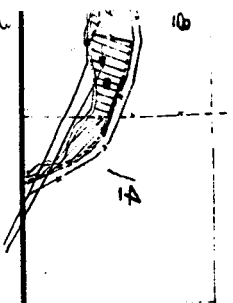

15

14

13

22

23

24

sketched in approximate
of in the vicinity of

