


TOWNSHIP

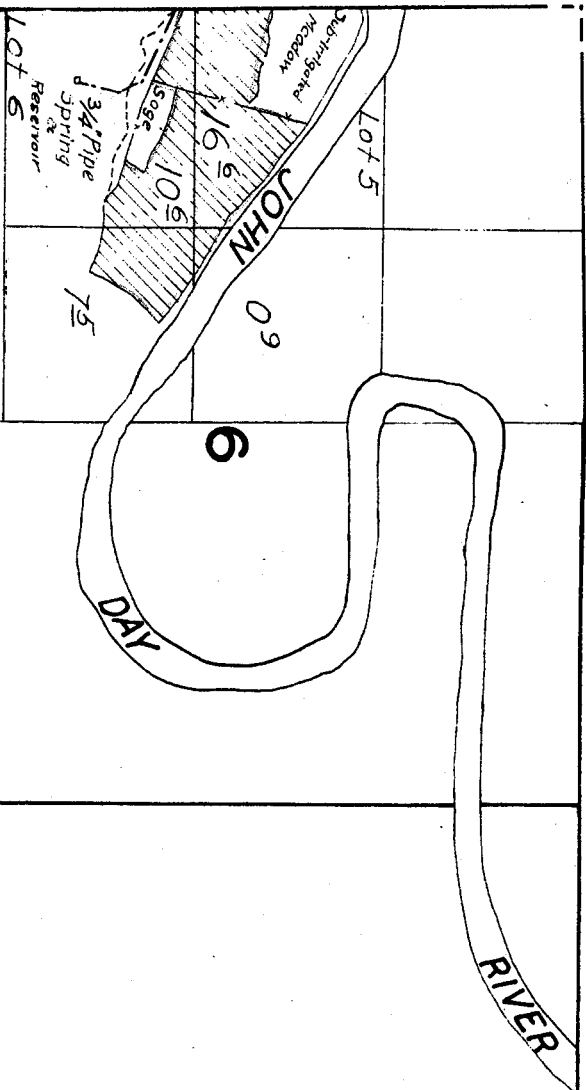

Surveyed Aug. 30, 1926

7

8

9

18

17


16

19

20

21

Charlie Shown

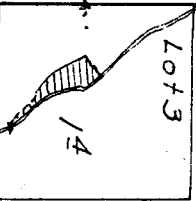


61


Note: Streams and river
vicinity of irrigated lands
approximate location.

NGE 22 E.

75-2-2

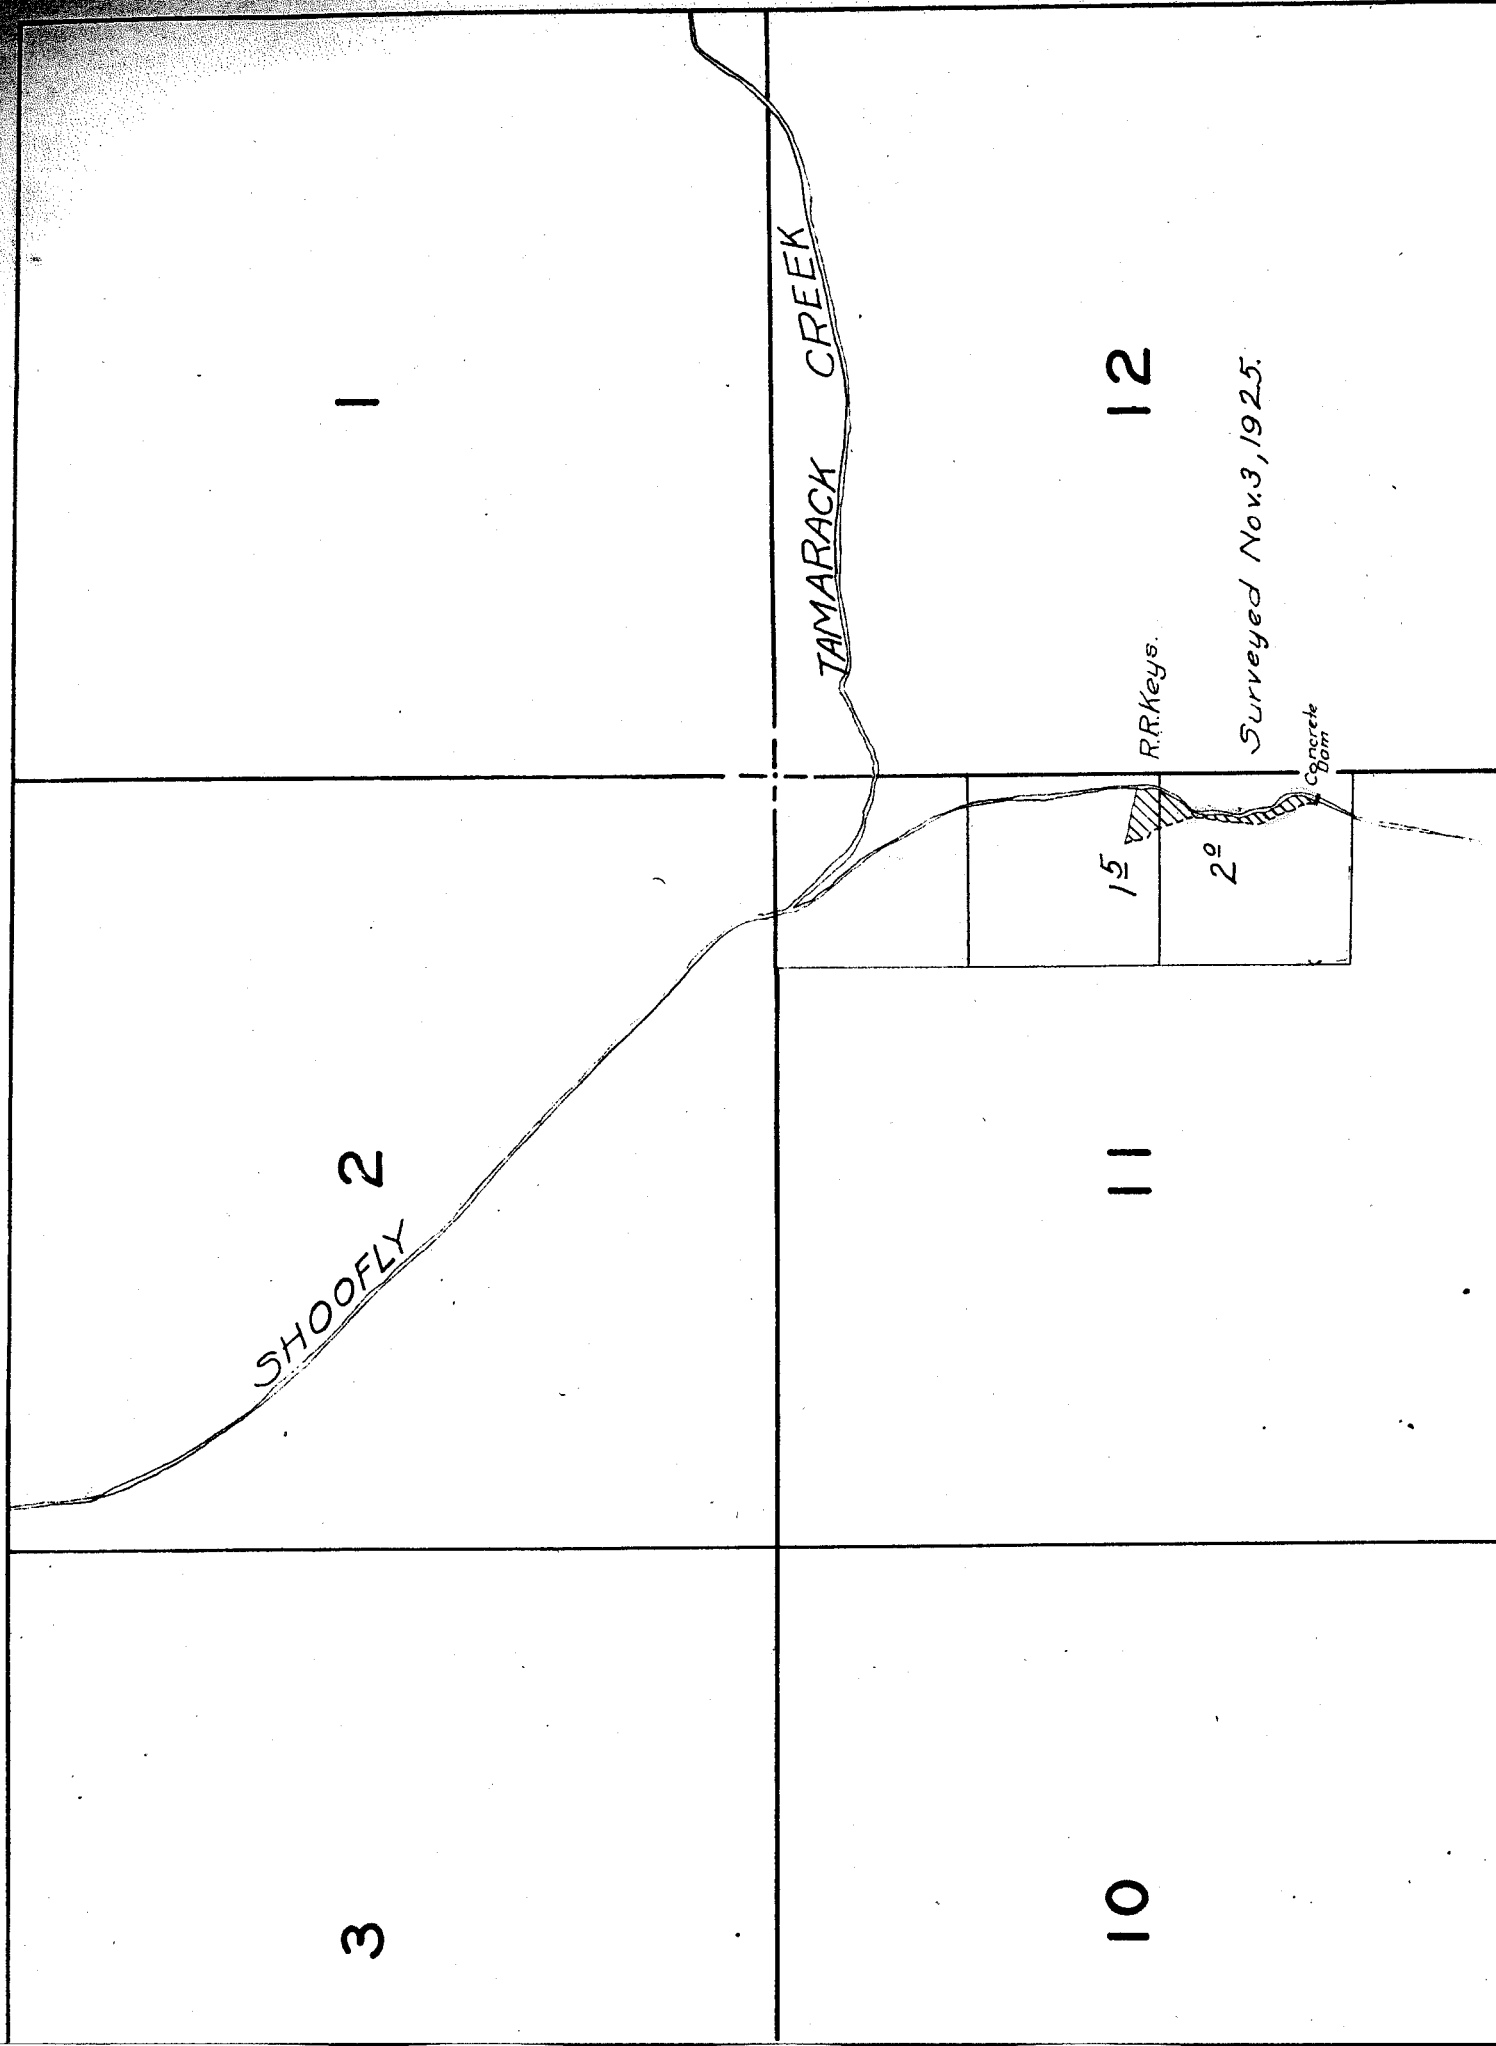

Surveyed Oct. 24, 1925.

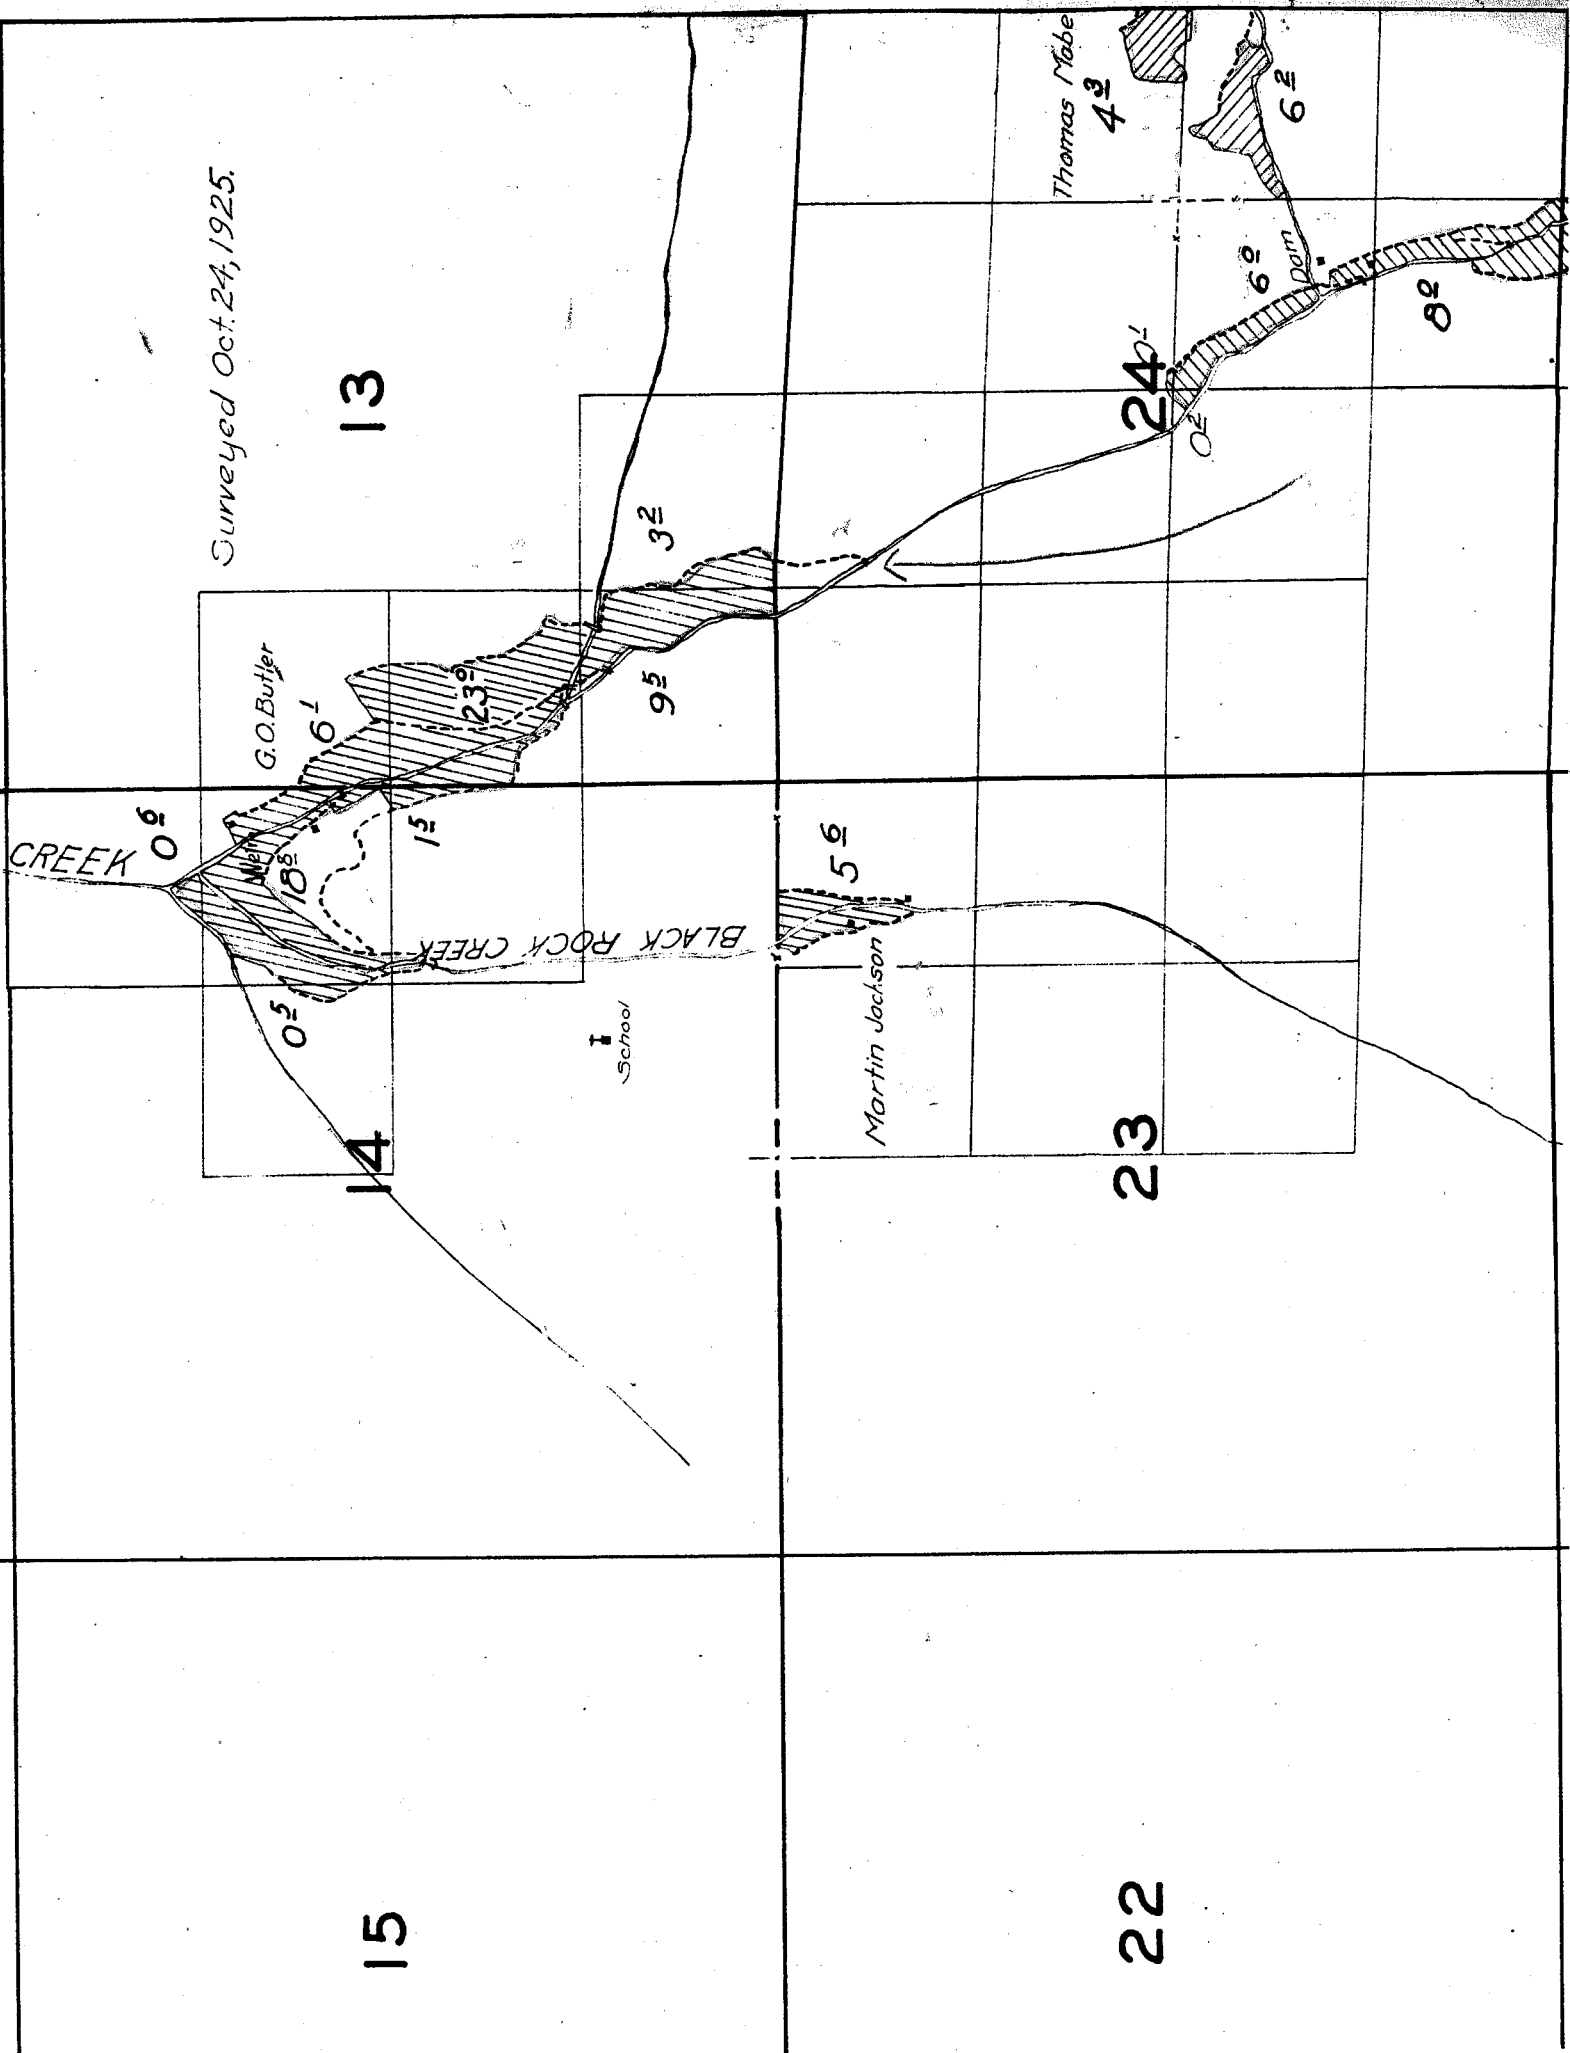

17

16

15

20

21

22

*Note: Streams and river, except in
vicinity of irrigated land, sketched in
approximate location.*

9

28

27

51


2

33

34

30

62

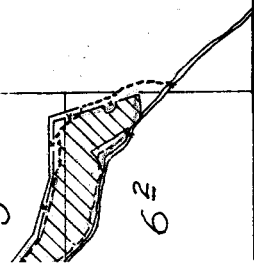

OWNSHIP 10 S., RANGE 22 E.

4


3

9

10


16

15

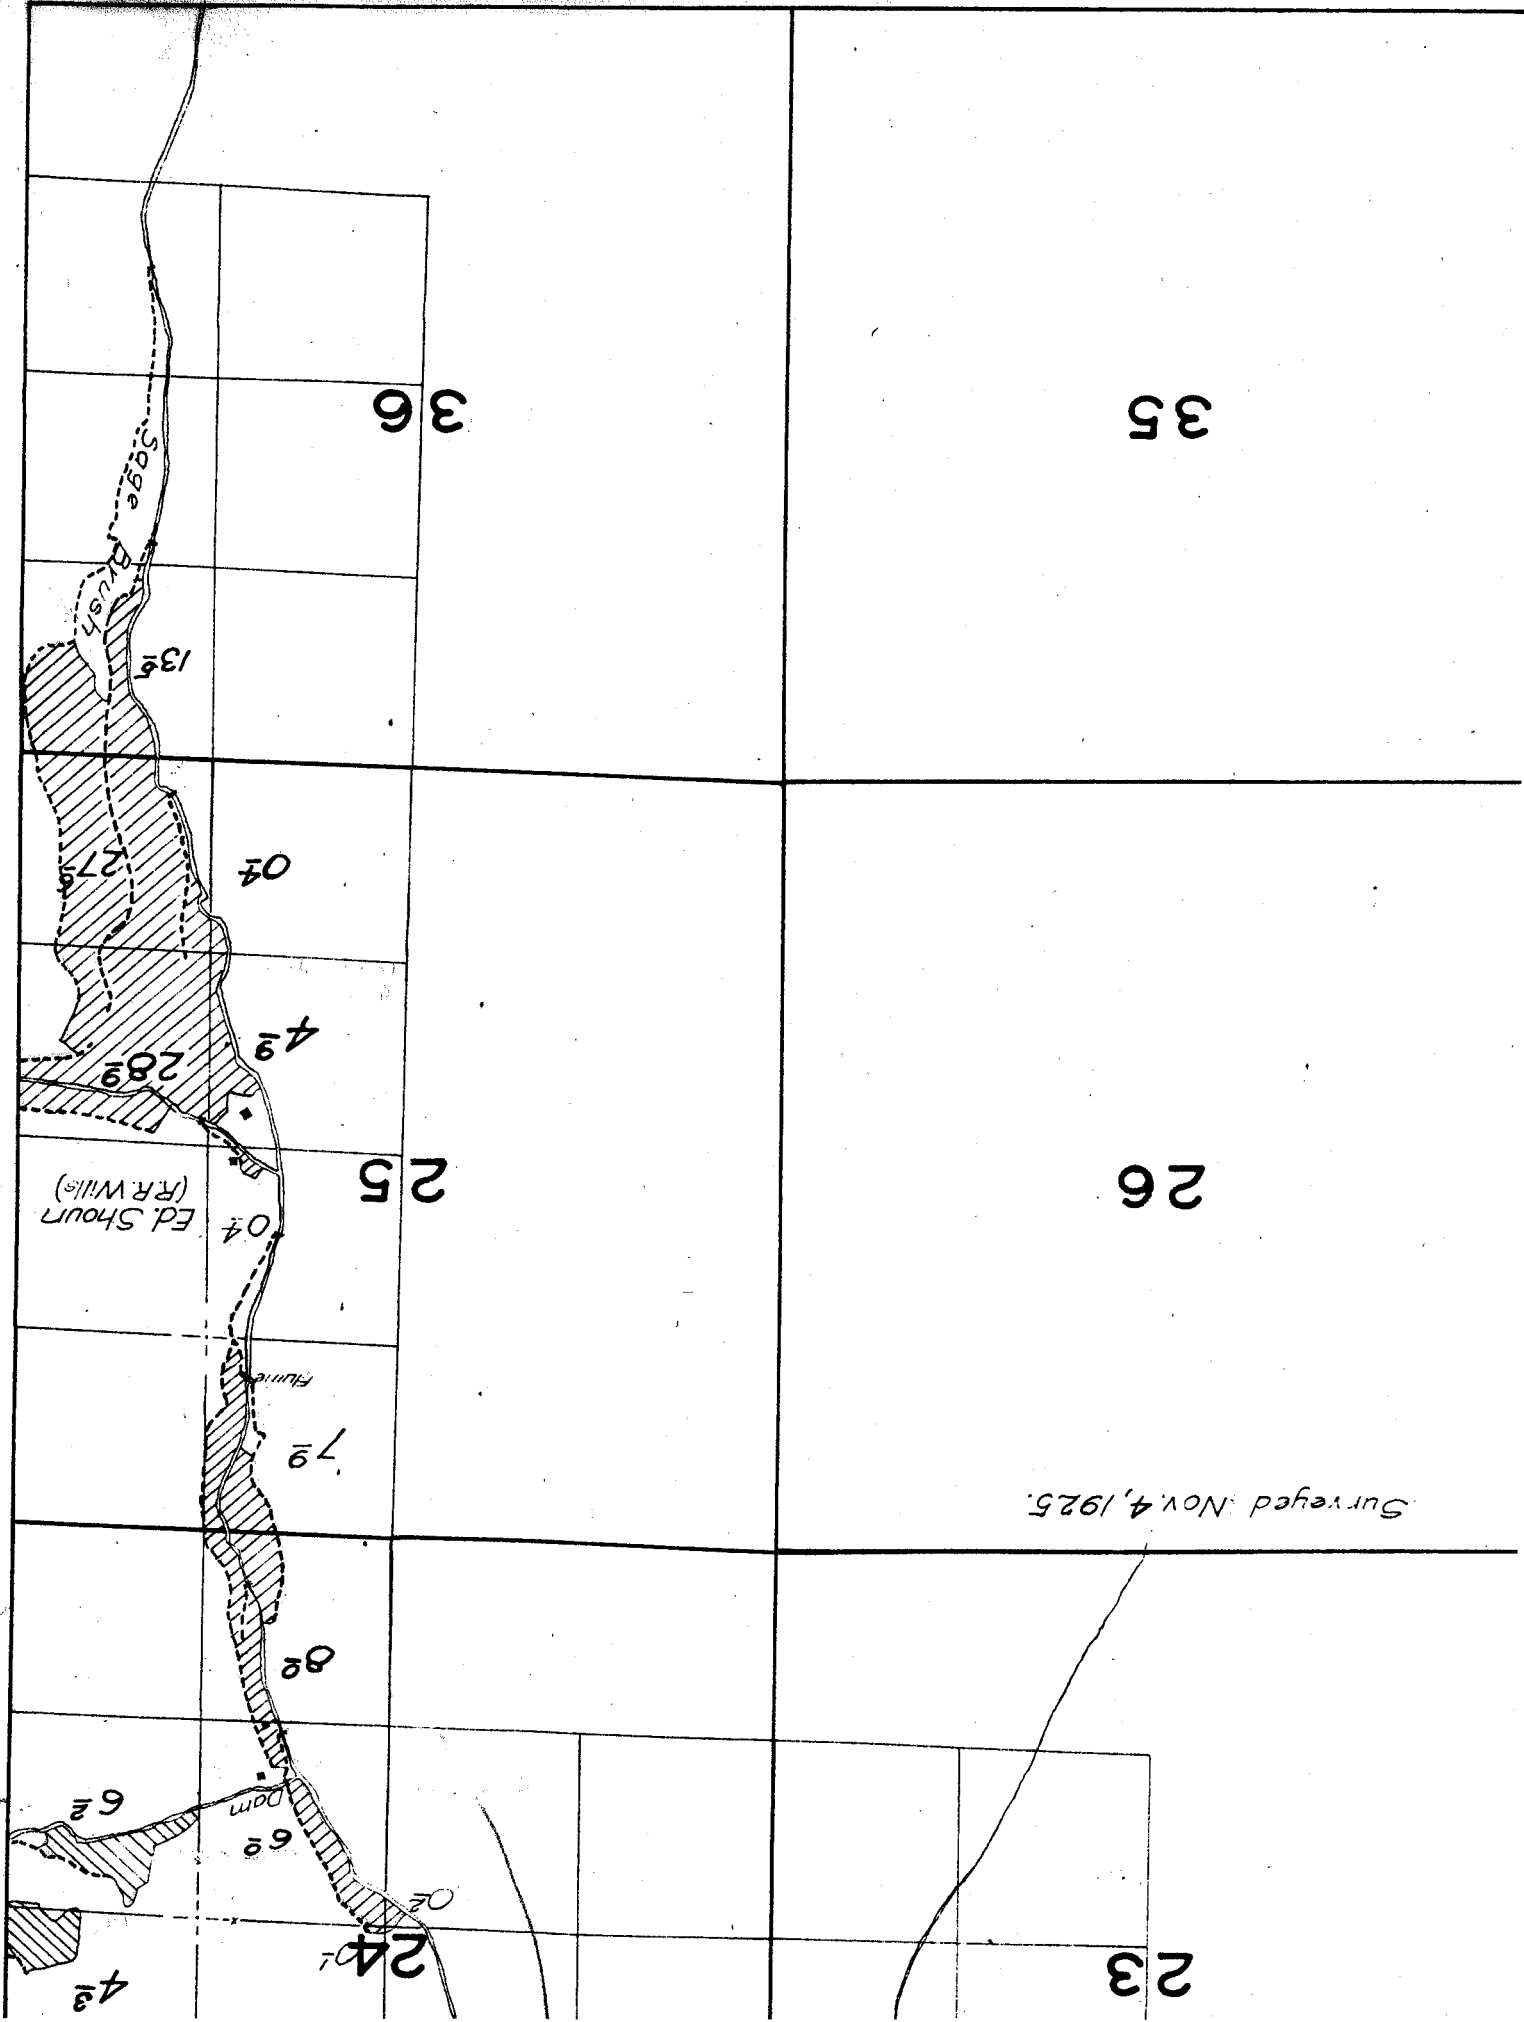

19

20

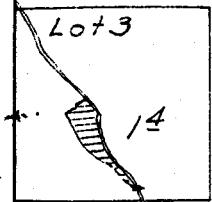

Charlie Shown


GIRDS
Rim
Rim

ROCKS
30
ROCKS

CREEK

29

Surveyed Sept. 4, 1926.

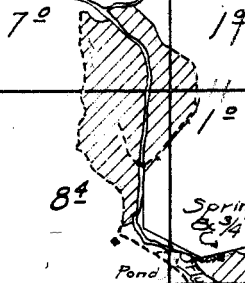

Spring
2 3/4 Acres

Winlock Hendricks

31

10²

32

6²

7⁴

3²

6²