


2

1

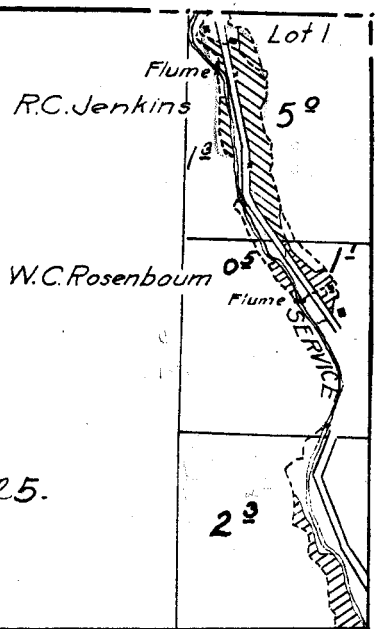

Survey Oct. 26, 1925.


11

12

Surveyed Oct. 23, 1925.

14

13

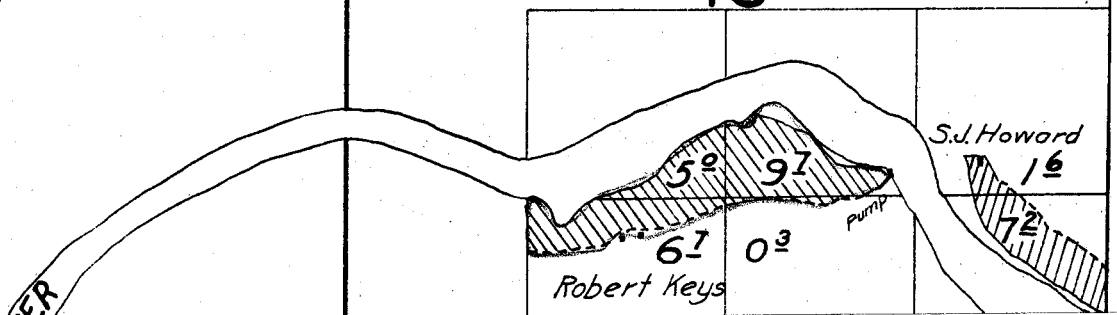


16

15

21


22

*Drawn from map of
application No. 7752*

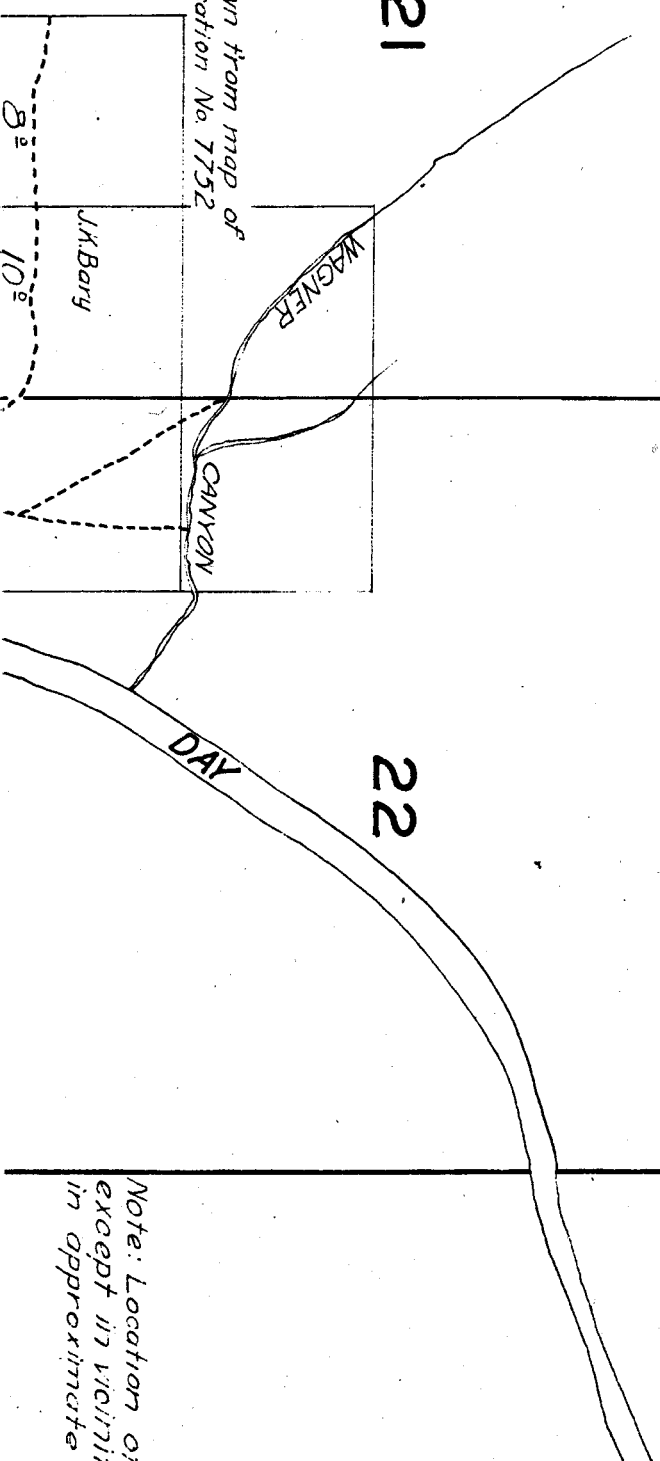

*Note: Location of
except in vicinity
in approximate*

TOWNSHIP 9 S., RANGE 22 E.

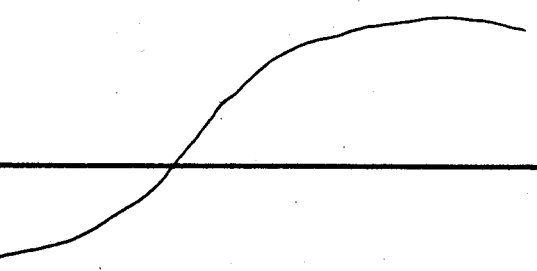	4	3	
9		10	

18

17


16

19

20

21

Drawn the
application

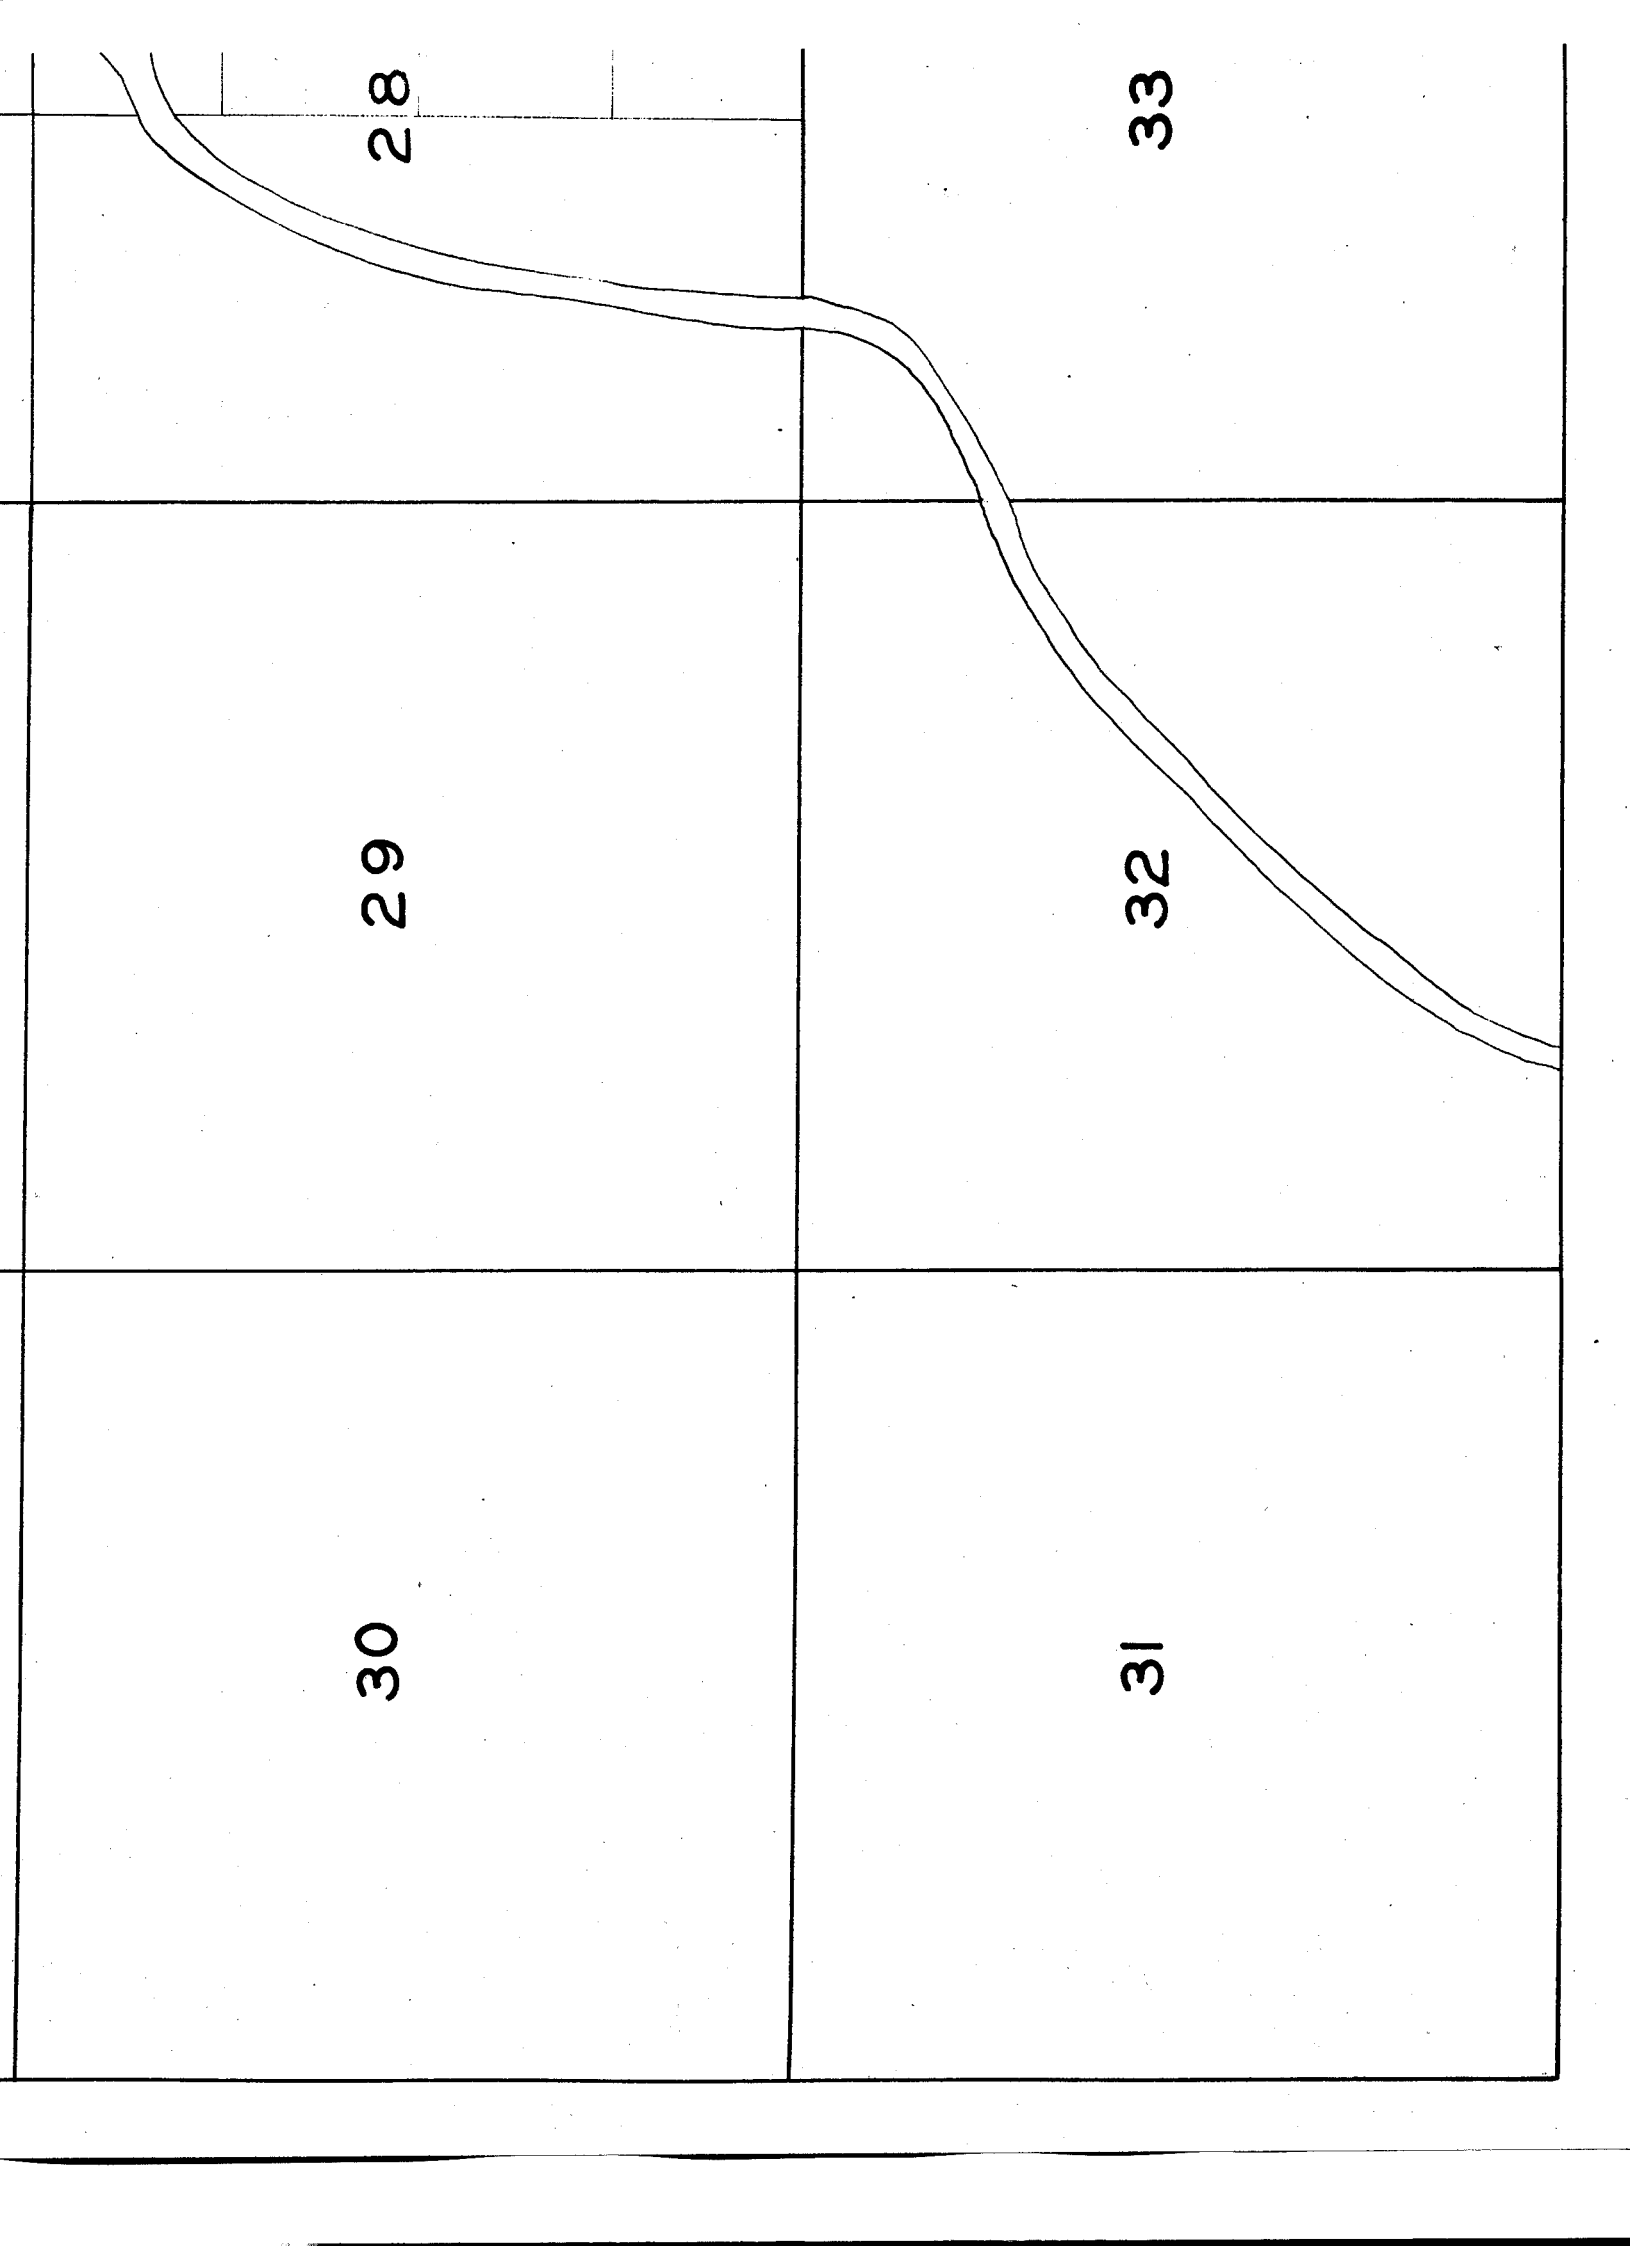

Surveyed Oct 23, 1925.

15

14

13

S. Howard
16

52 97

67 03

Robert Keys

Shund

72

RIVER

22

23

24

DAY

Note: Location of streams and river, except in vicinity of irrigated land, sketched in approximate location.

Nov. 5, 1925.

27

26

25

CREEK

34

35

36

21

22

Drawn from map of
application No. 7752

J.K. Bary

8°

10°

JOHN

9°

5°

R.R. Keys

(Jim Humphrey)

0°

Surveyed Nov. 5, 1925.

28

27

SHOO FLY

CREEK

33

34

6

5

7

8

18

17