



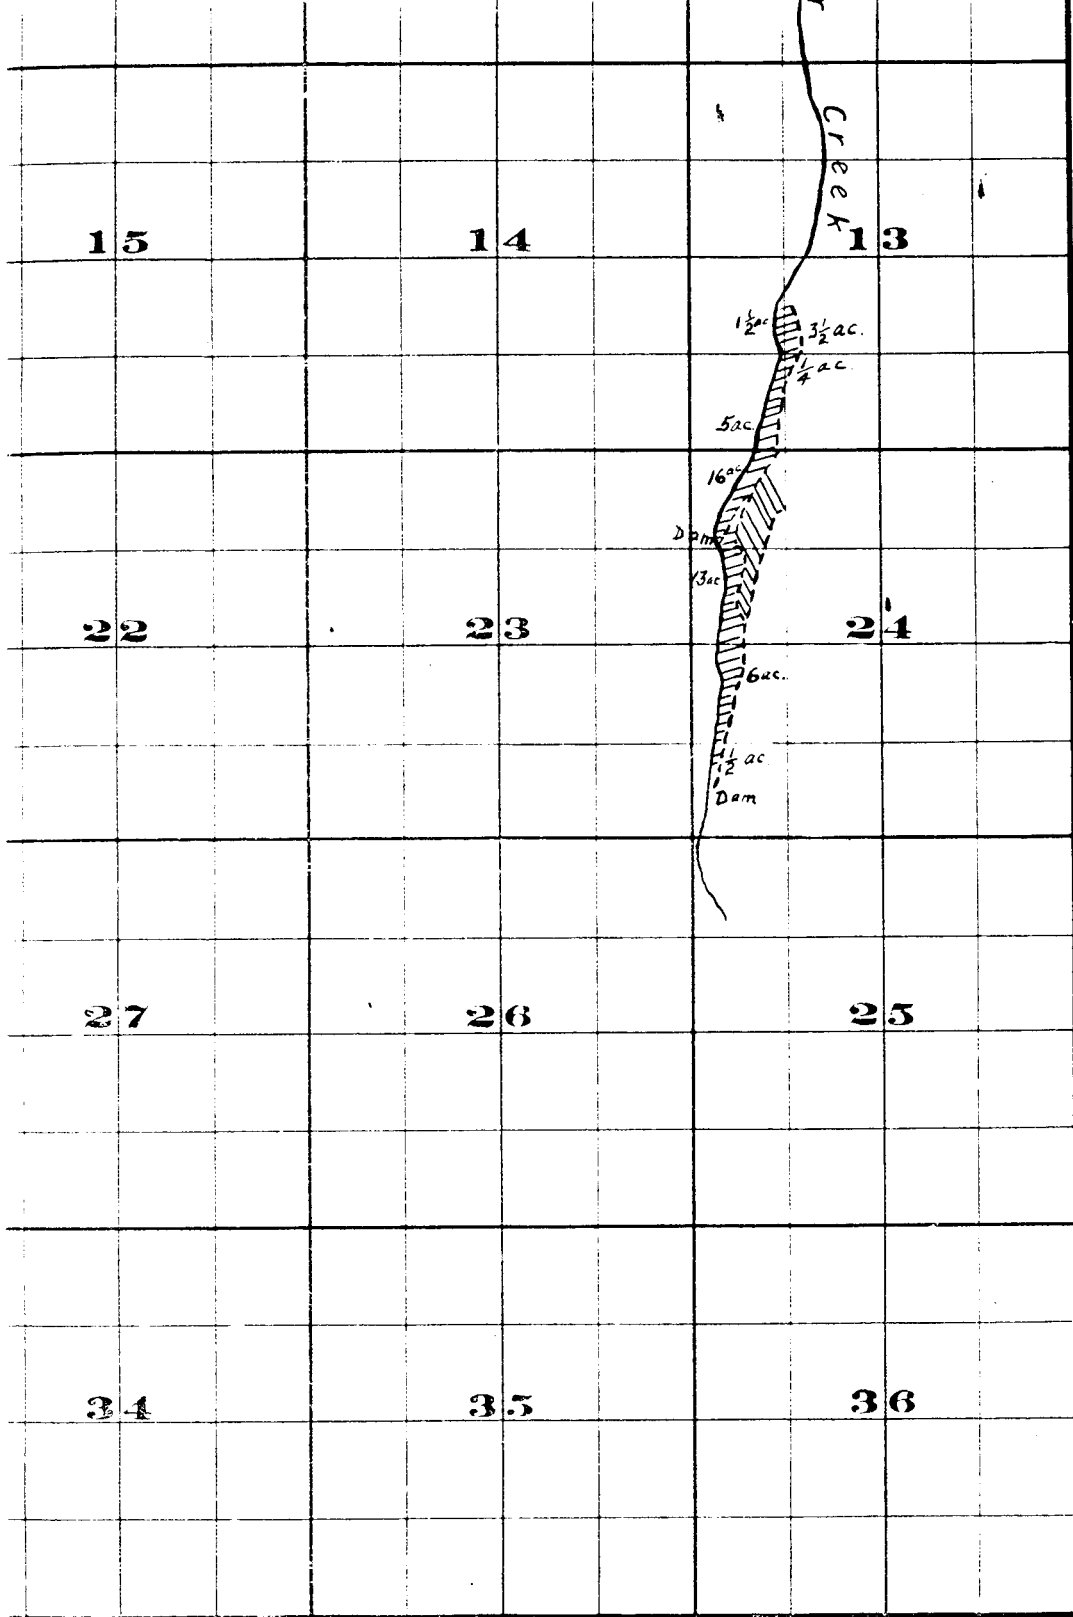

FROM OFFICE OF THE STATE ENGINEER, SALEM, OREGON
Willow Creek Adjudication

35.27 E.

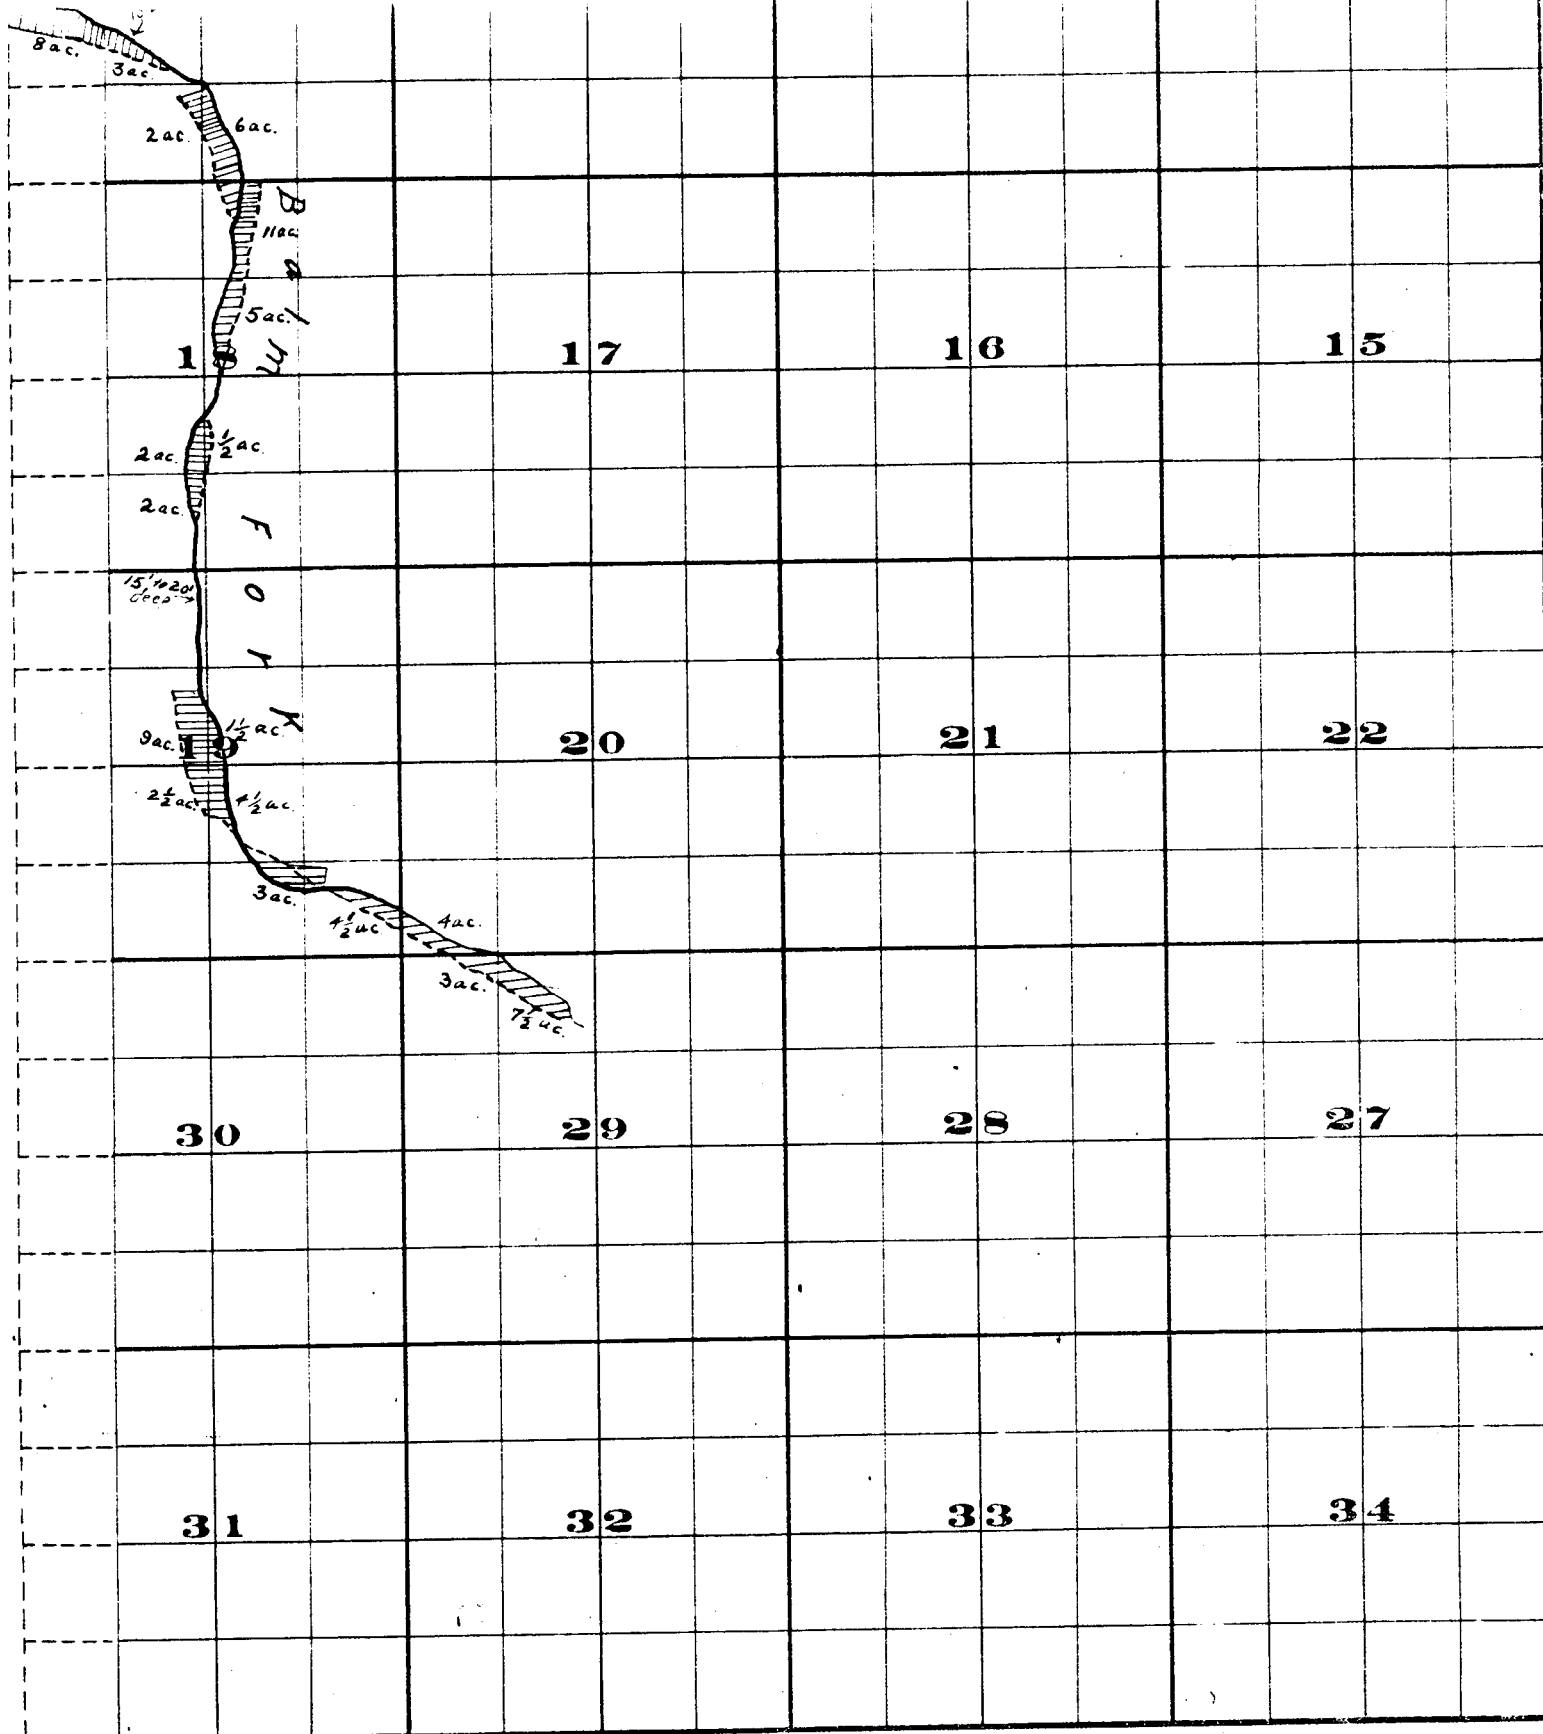

THE S.A. BRISTOL CO. PRINTERS & BOOKBINDERS CHICAGO, ILL.


Surveyed by H.K. Donnelly July 1909

Surveyed by R.D. Cooper July 1909

John H. Lewis - State Engineer

Examined, July 14, 1909.

Township 35

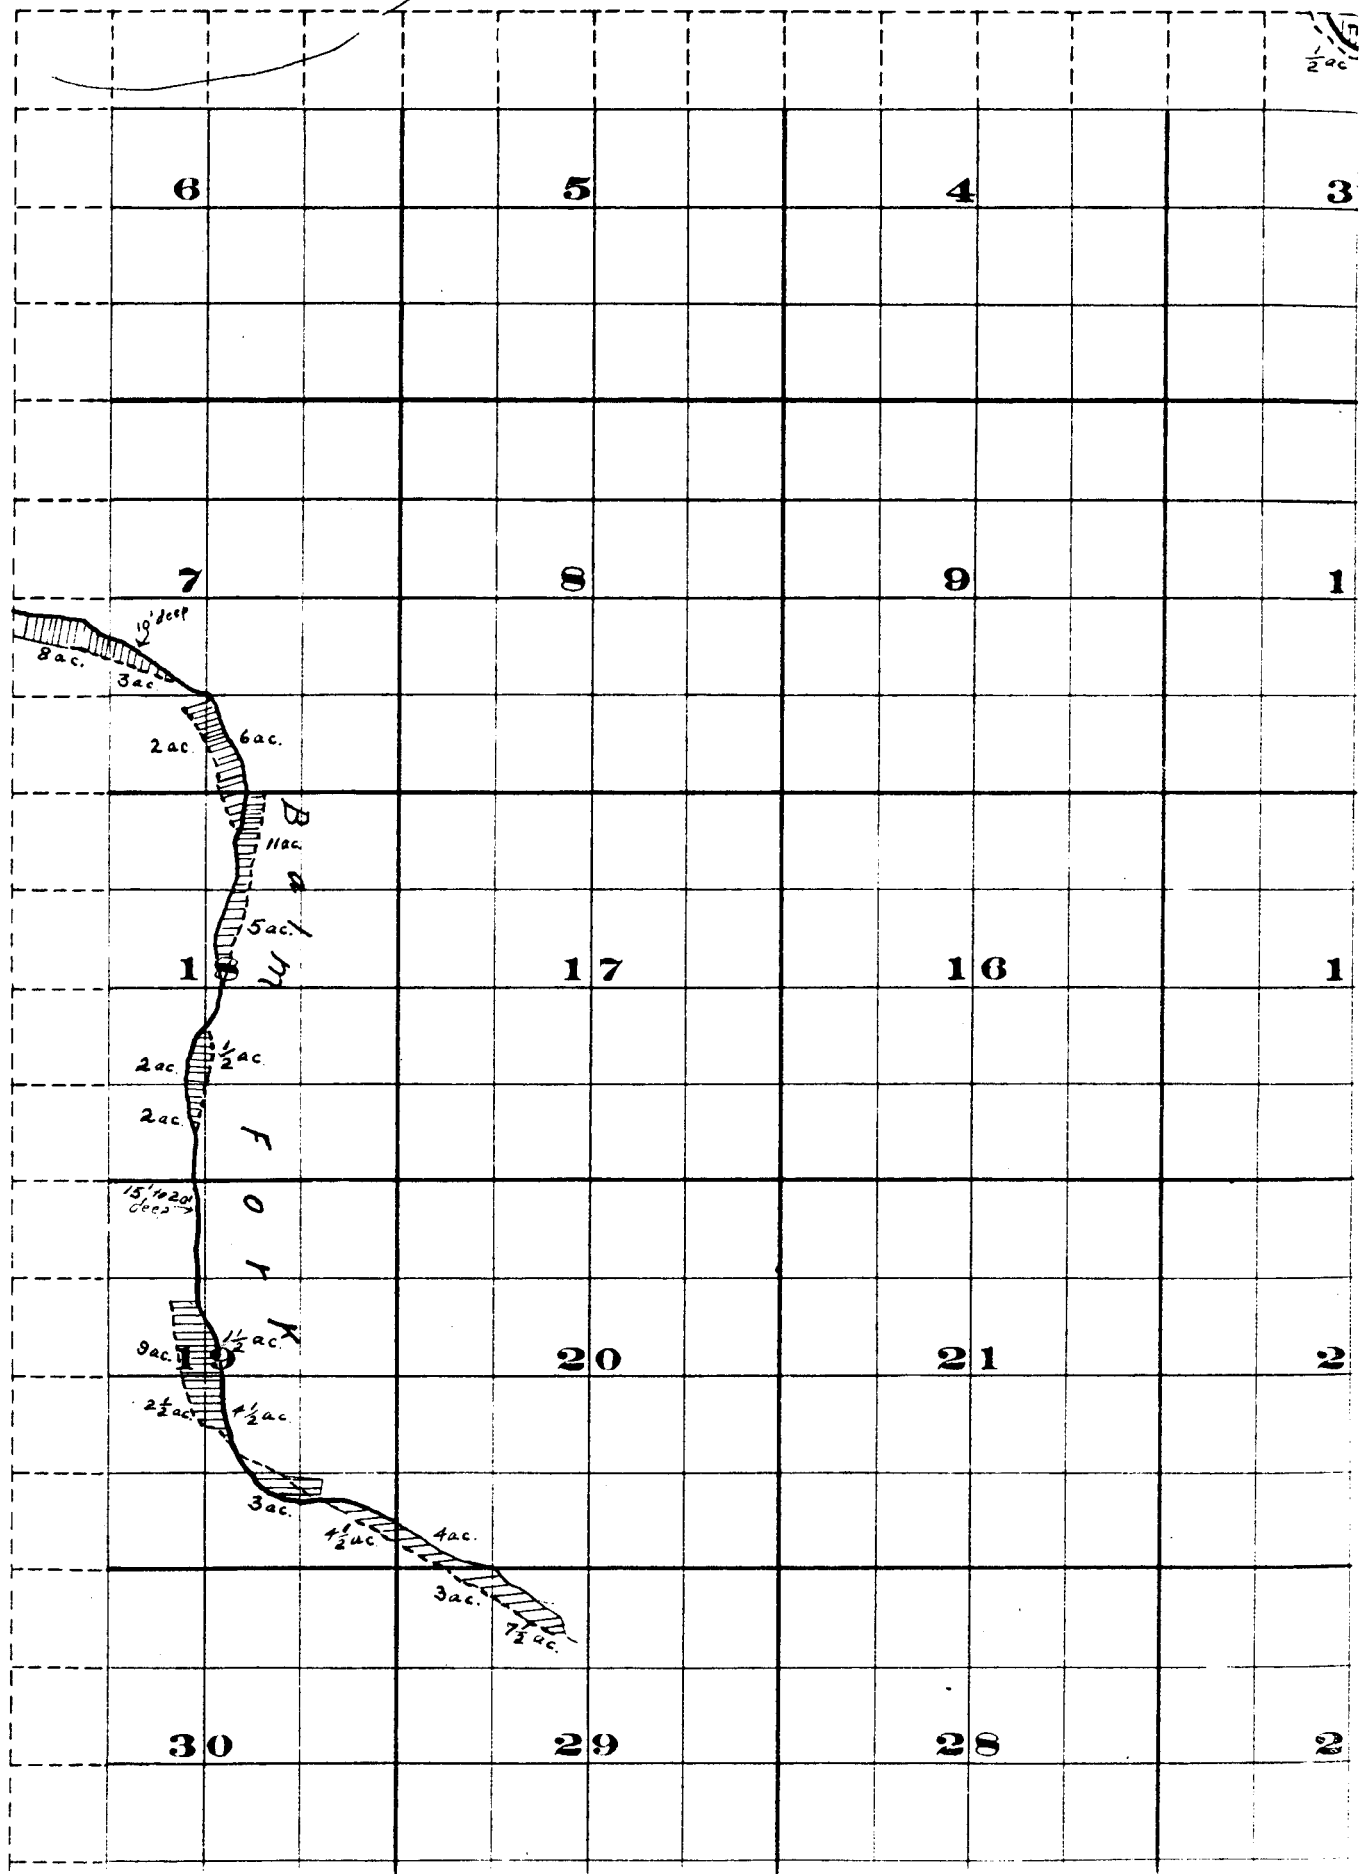

,

