

17

16

15

Note: Streams, except in the vicinity of irrigated land, sketched in approximate location.

20

21

22

29


28

27

32

33

34

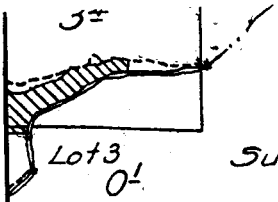


19

Surveyed Nov. 6, 1925.

20

30

29

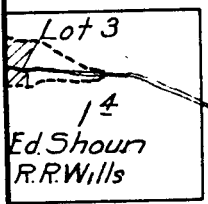

31

32

23

24

26

25

35

36

15

14

13

22

23

24

TOWNSHIP 10 S., RANGE 23 E.


urveyed Oct. 30 to Nov. 3, 1925.

4

3

Federal Land Bank
(J.I. Thomas)

Note: Location of ditch & creek
sketched in field.

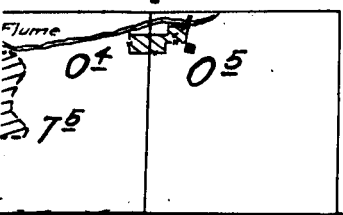

Lot 1

Lot 4

74



64

Thick

Pine

9

10

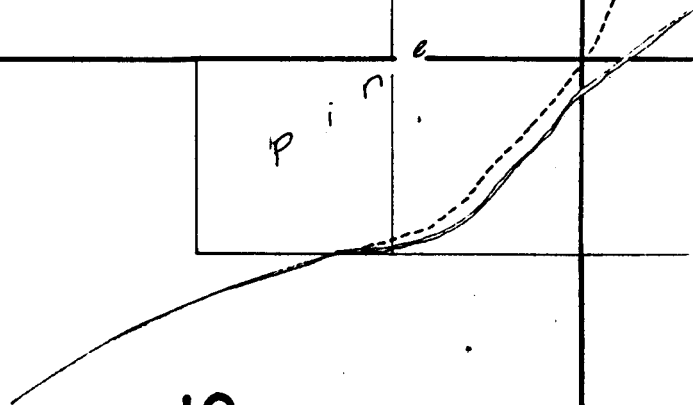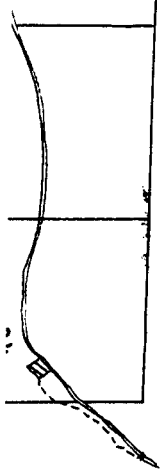


TOWNSH

Surveyed Oct. 30 to 1

4

Federal Land Bank
(J.I. Thomas)

9

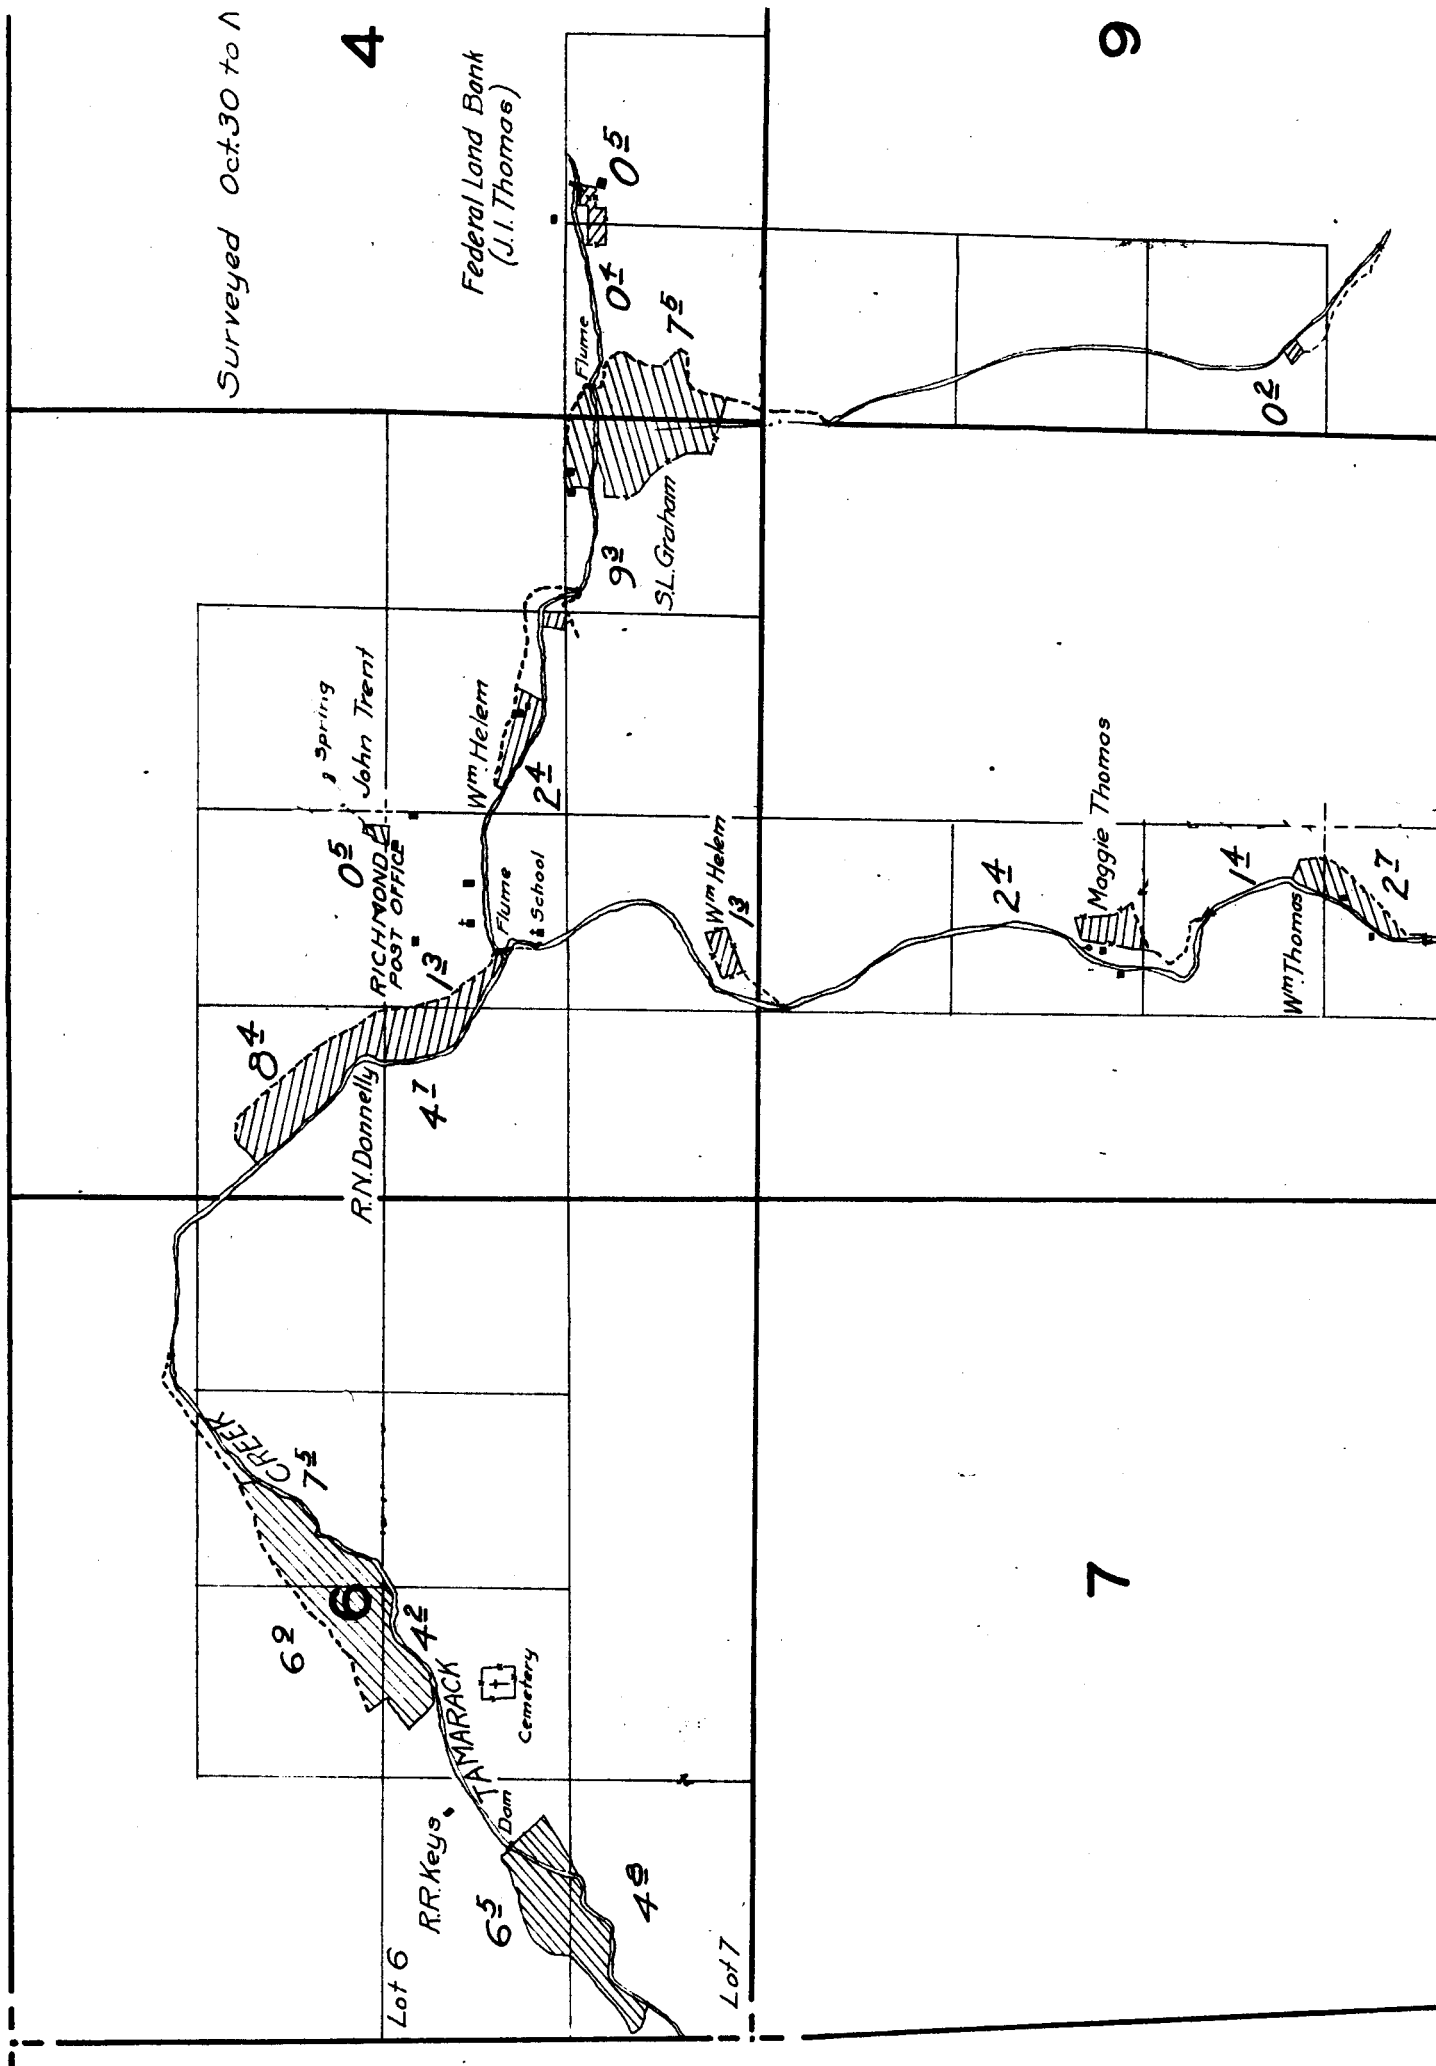

7

