

6

5


7

8


18

17

22

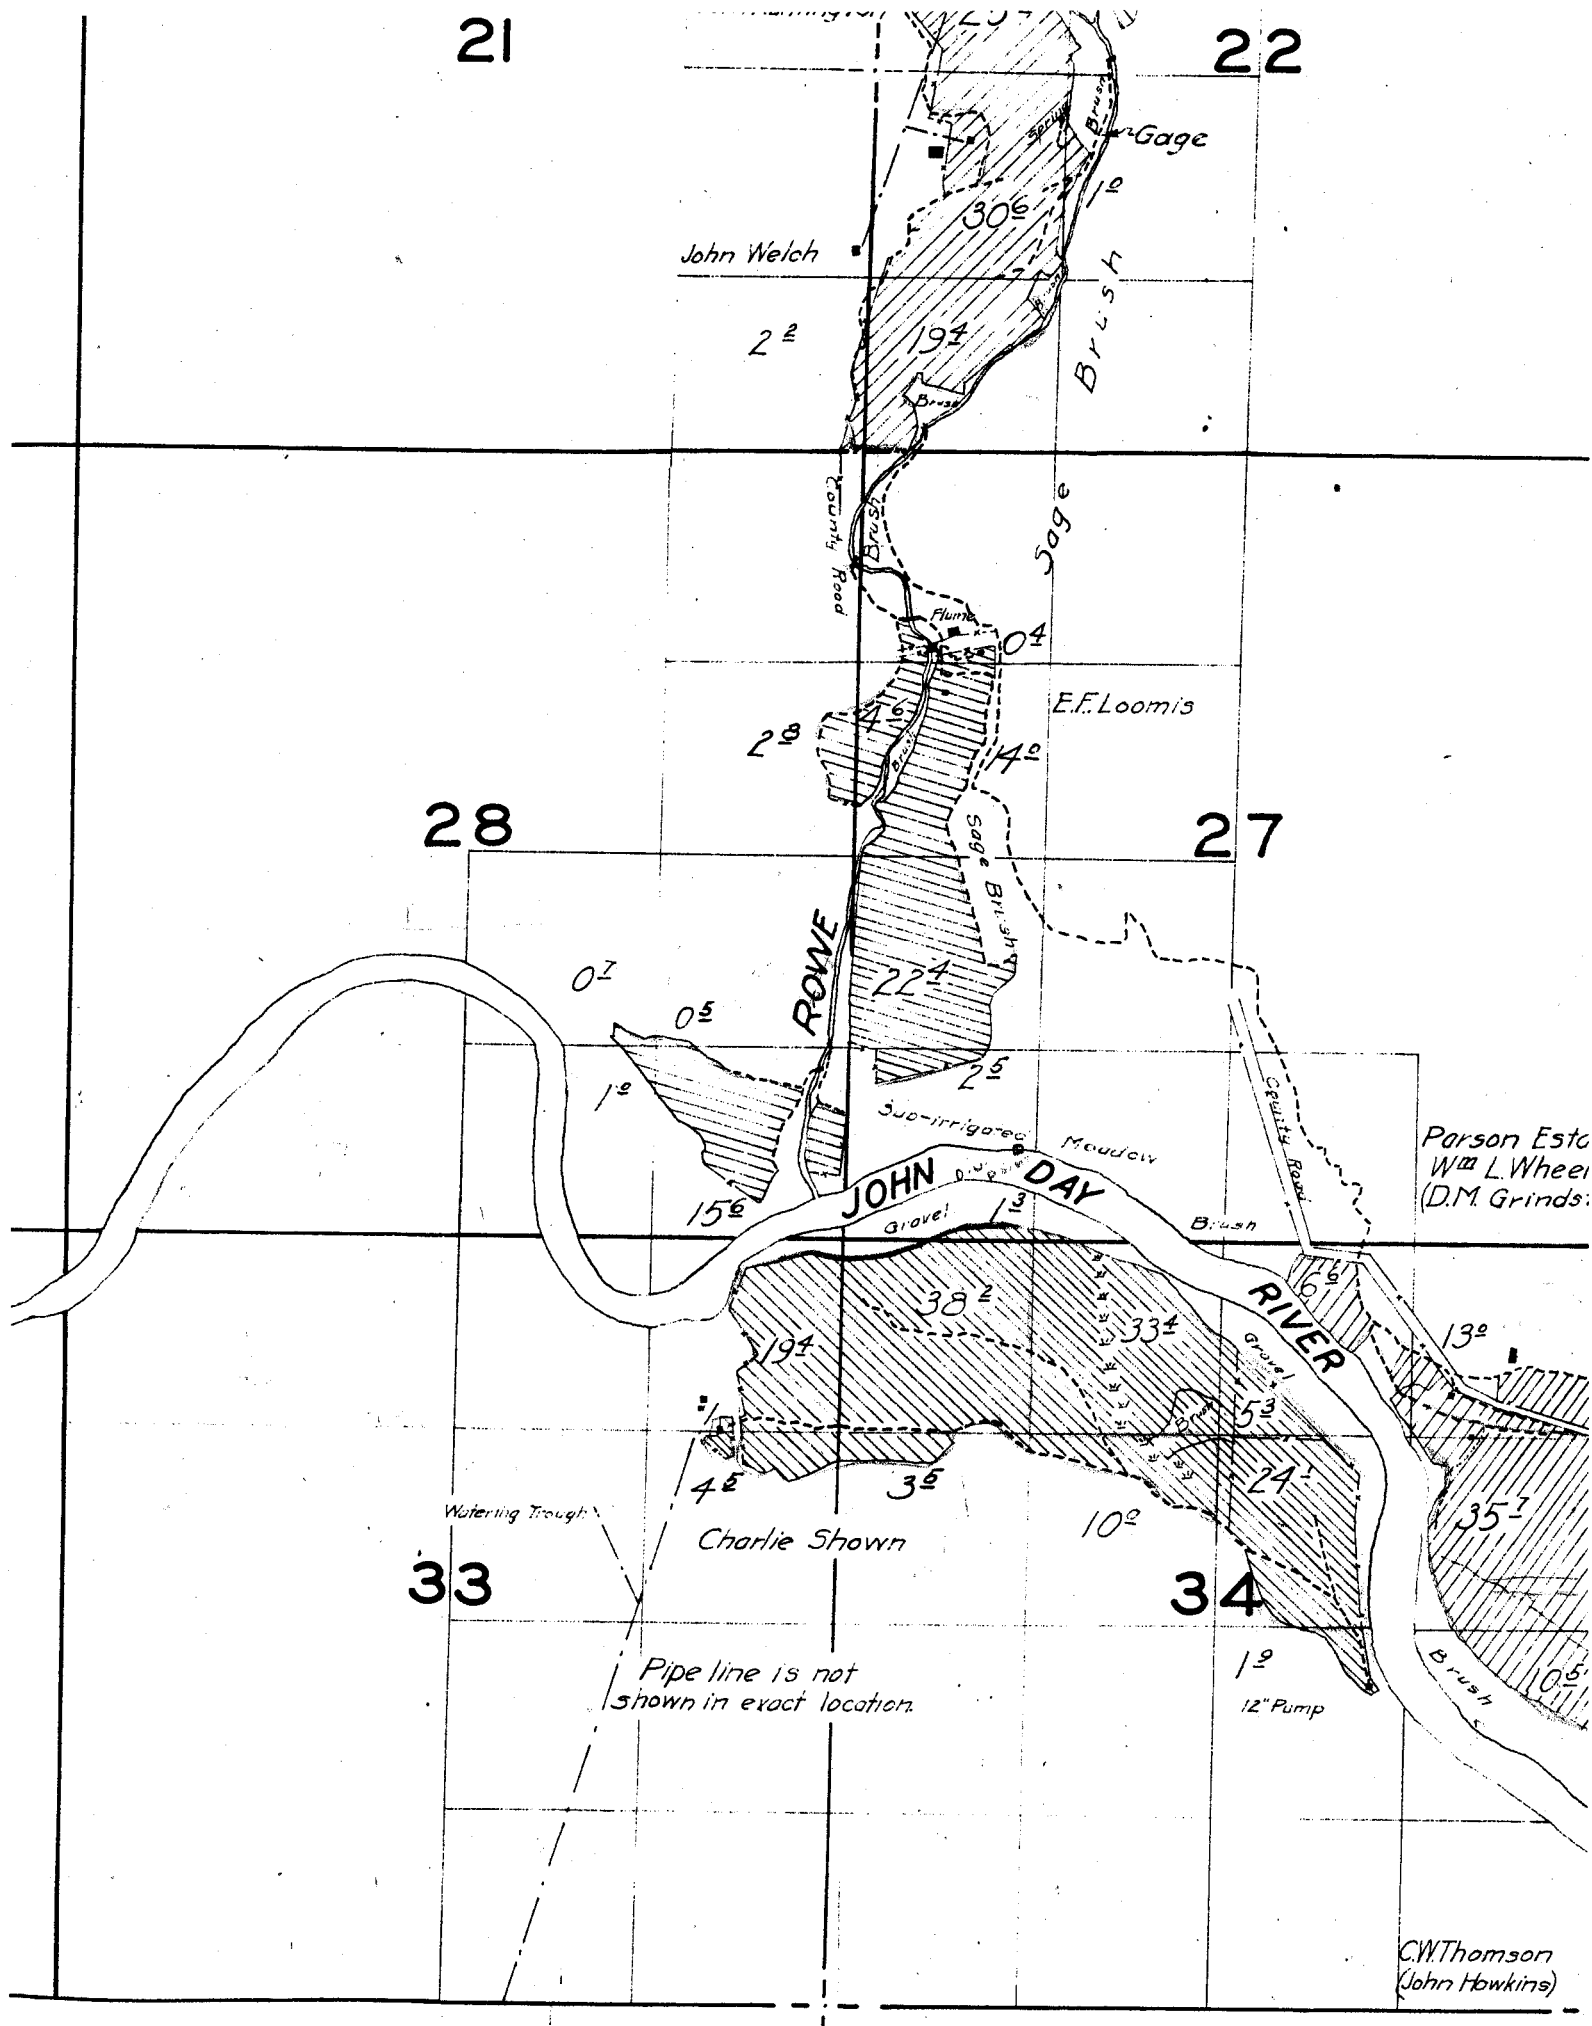

56-2-2

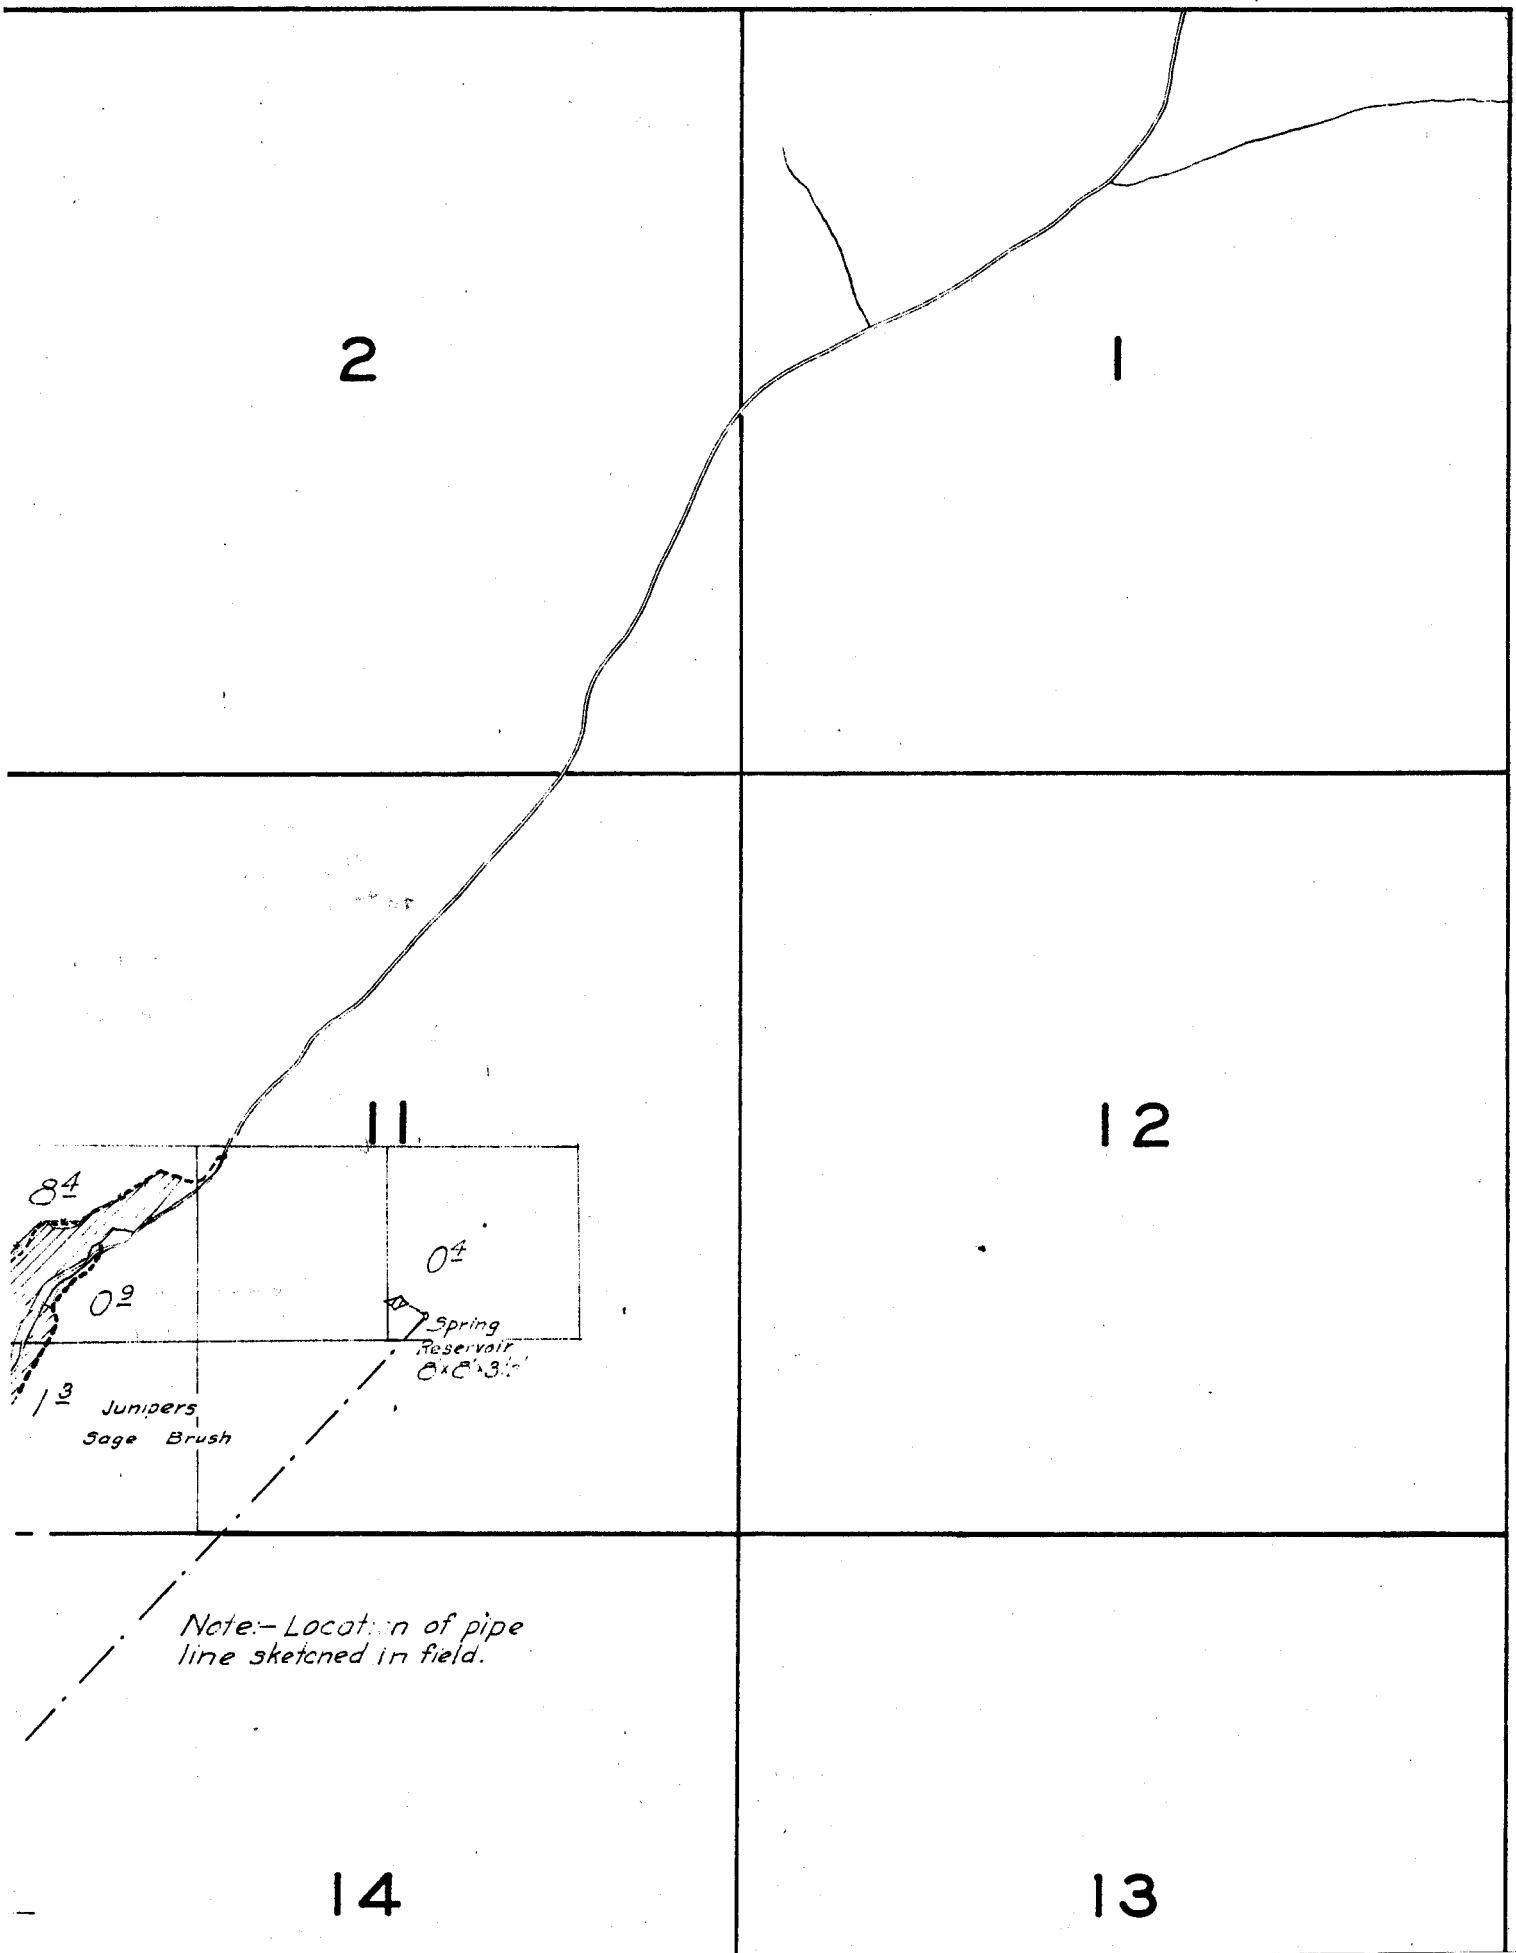


# TOWNSHIP 9 S., RANGE 21 E.


4

3

9

10

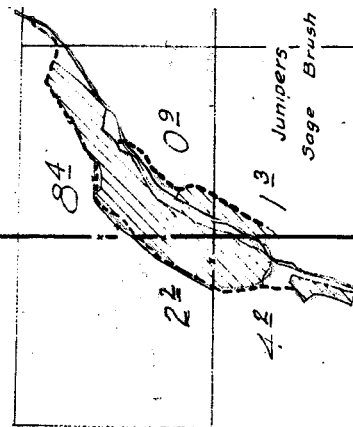

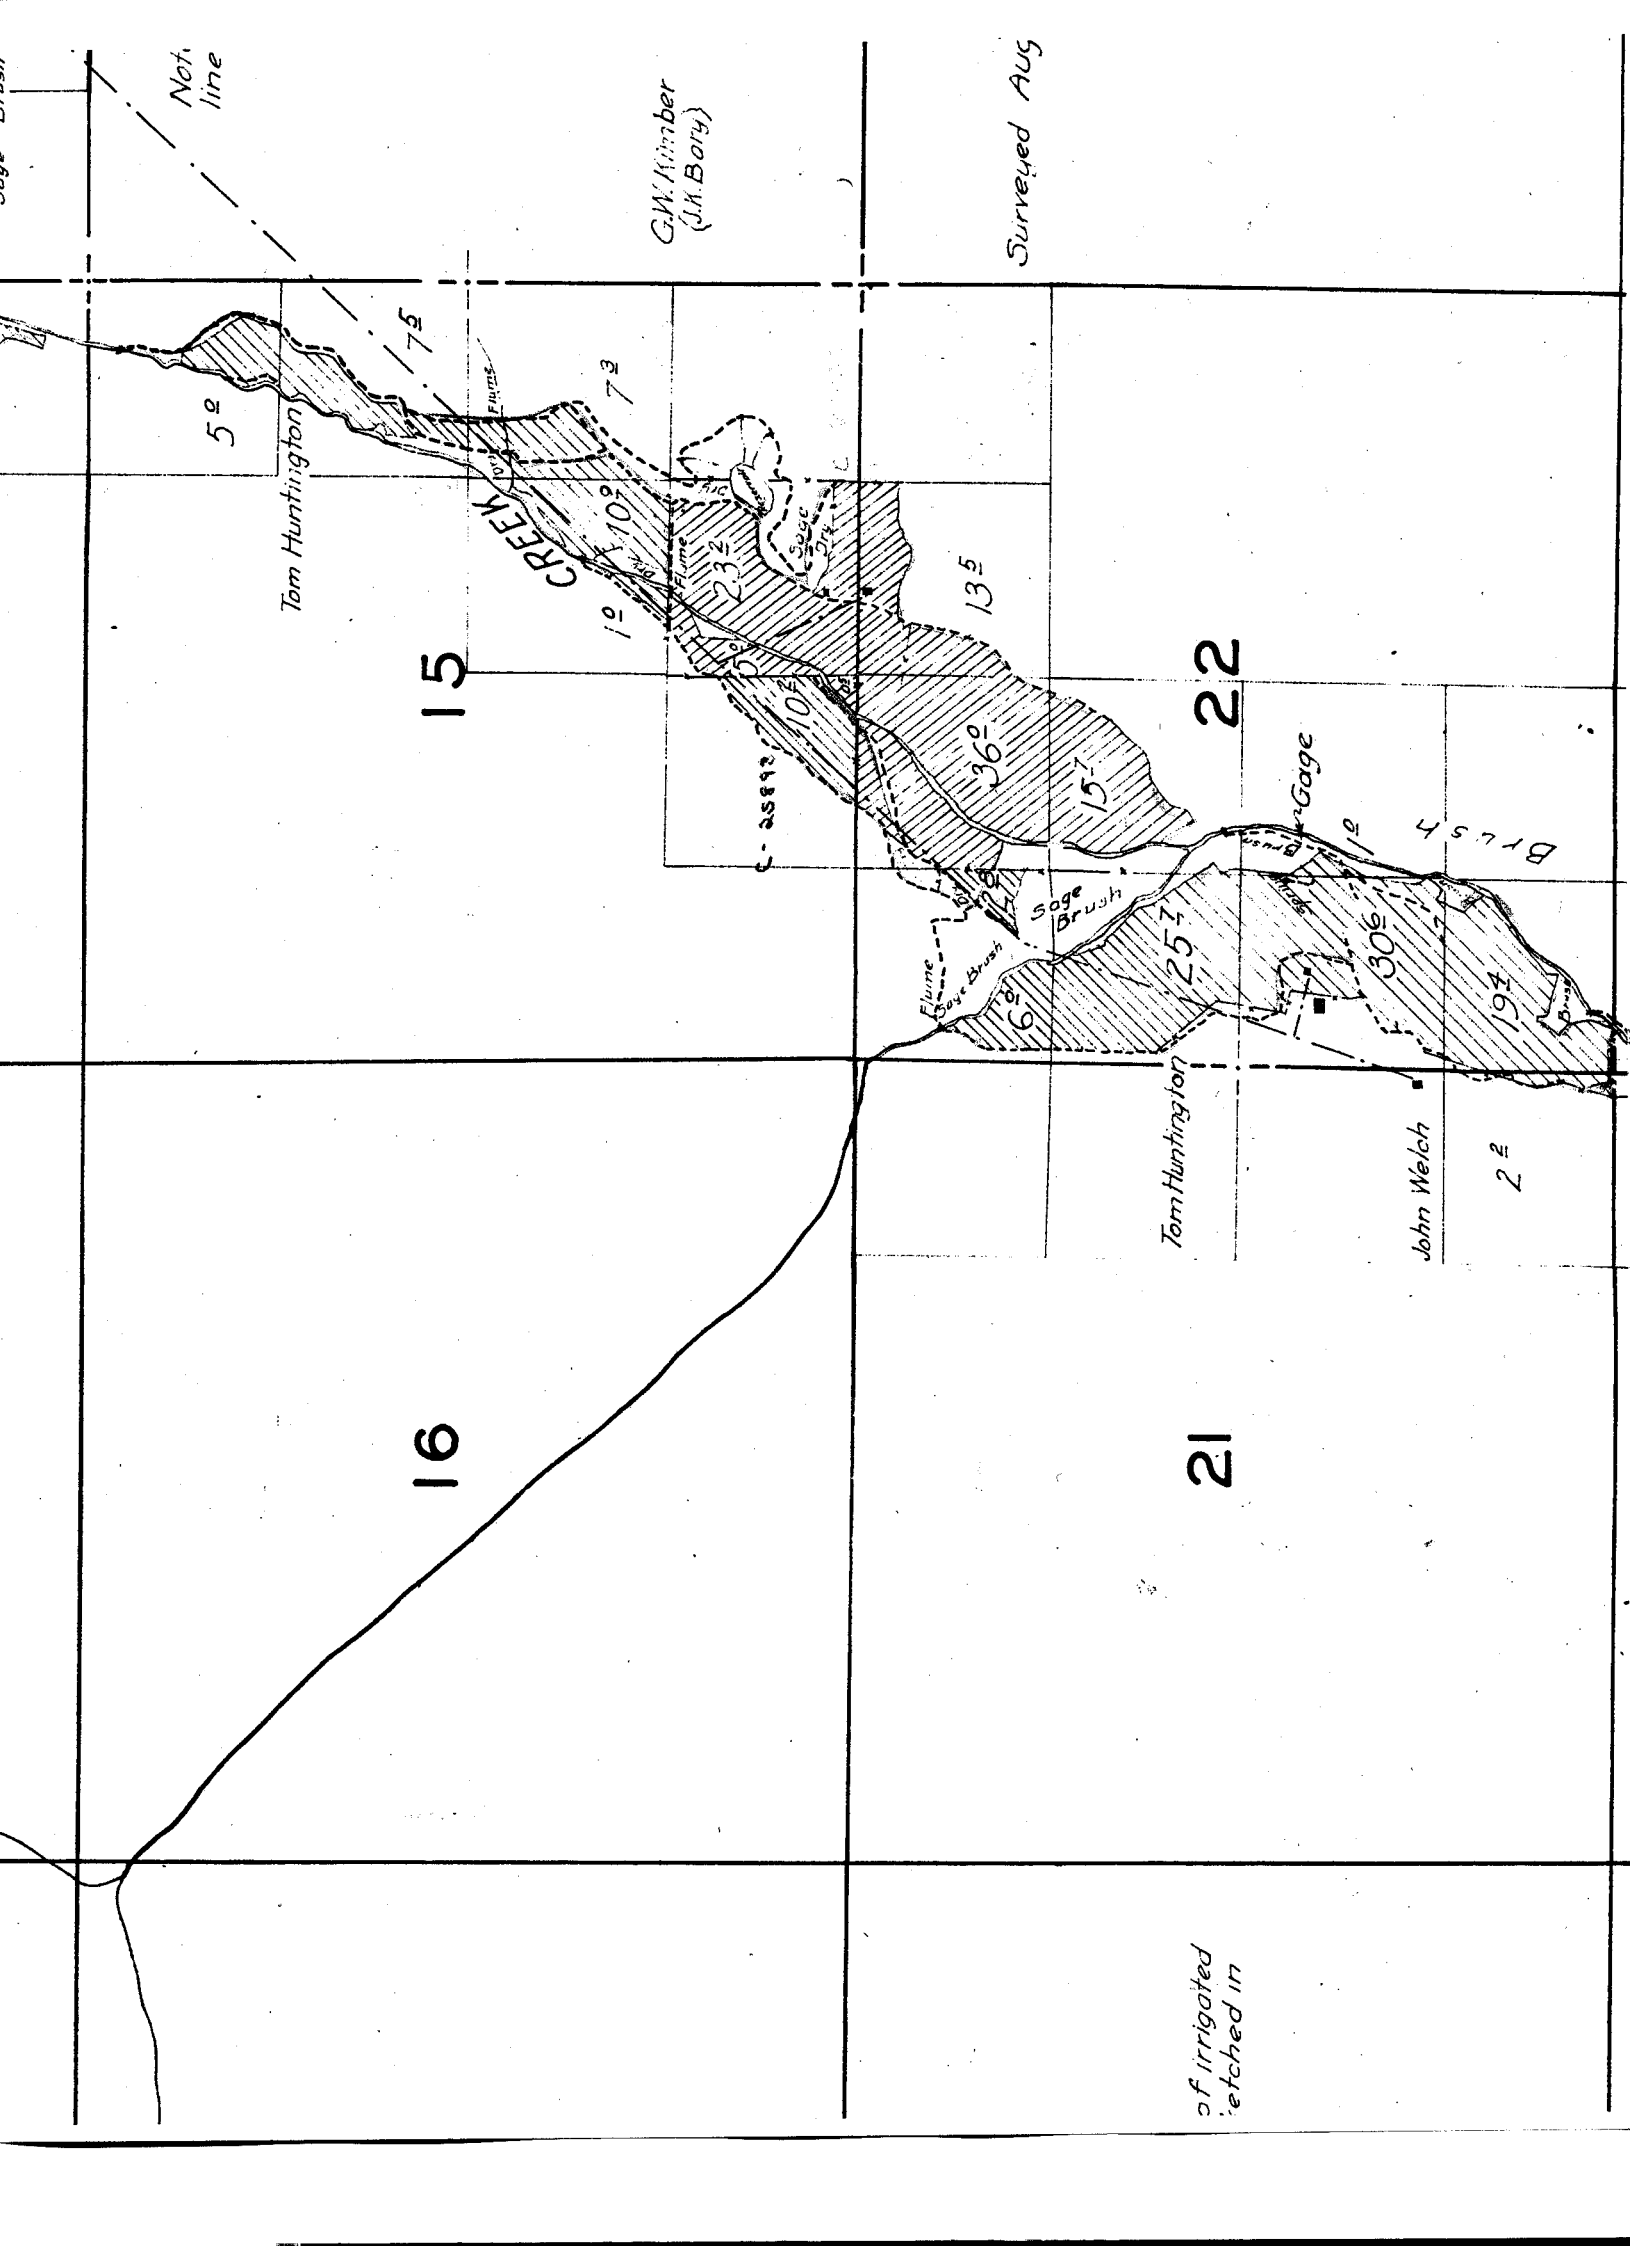

Not  
line

C.W. Kimber  
(J.H. Bory)

Surveyed Aug

Tom Huntington

CREEK

15

22

16

21

Tom Huntington

John Welch

Gage

Brush

Sage  
Brush

Sage  
Brush

2<sup>2</sup>

5<sup>2</sup>

7<sup>5</sup>

7<sup>3</sup>

10<sup>2</sup>

10<sup>2</sup>

23<sup>2</sup>

13<sup>5</sup>

36<sup>2</sup>

15<sup>1</sup>

25<sup>1</sup>

30<sup>5</sup>

19<sup>1</sup>

of irrigated  
etched in

30

29

28

31

32

33

Watering



18

17

16

19

*Note: Except in the vicinity of irrigated  
lands streams and river are sketched in  
approximate locations.*

21

27

26

25

Parson Estate  
Wm L Wheeler  
(DM Grindstaff)

Pipe line is not  
shown in exact location

Spring  
Reservoir  

36


34

35

12 Pump

CNThomson  
(John Hawkins)

JAMES  
CANYON

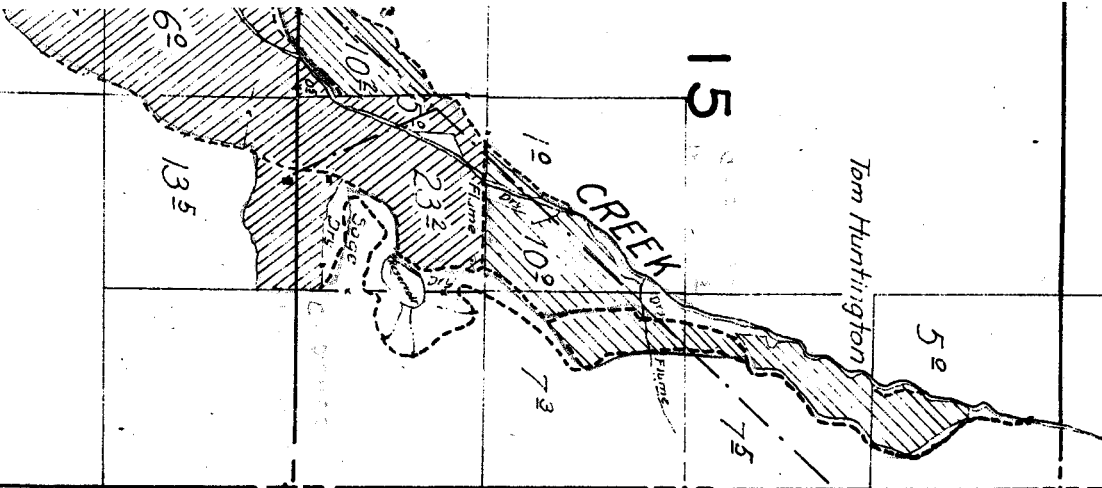

Note - Location of pipe line sketched in field.

G.W. Timber  
(J.M. Bony)

Surveyed Aug. 30, & 31, & Sept. 1, & 2, 1926.