


TOWNSHIP 8 S., RANGE. 21 E.

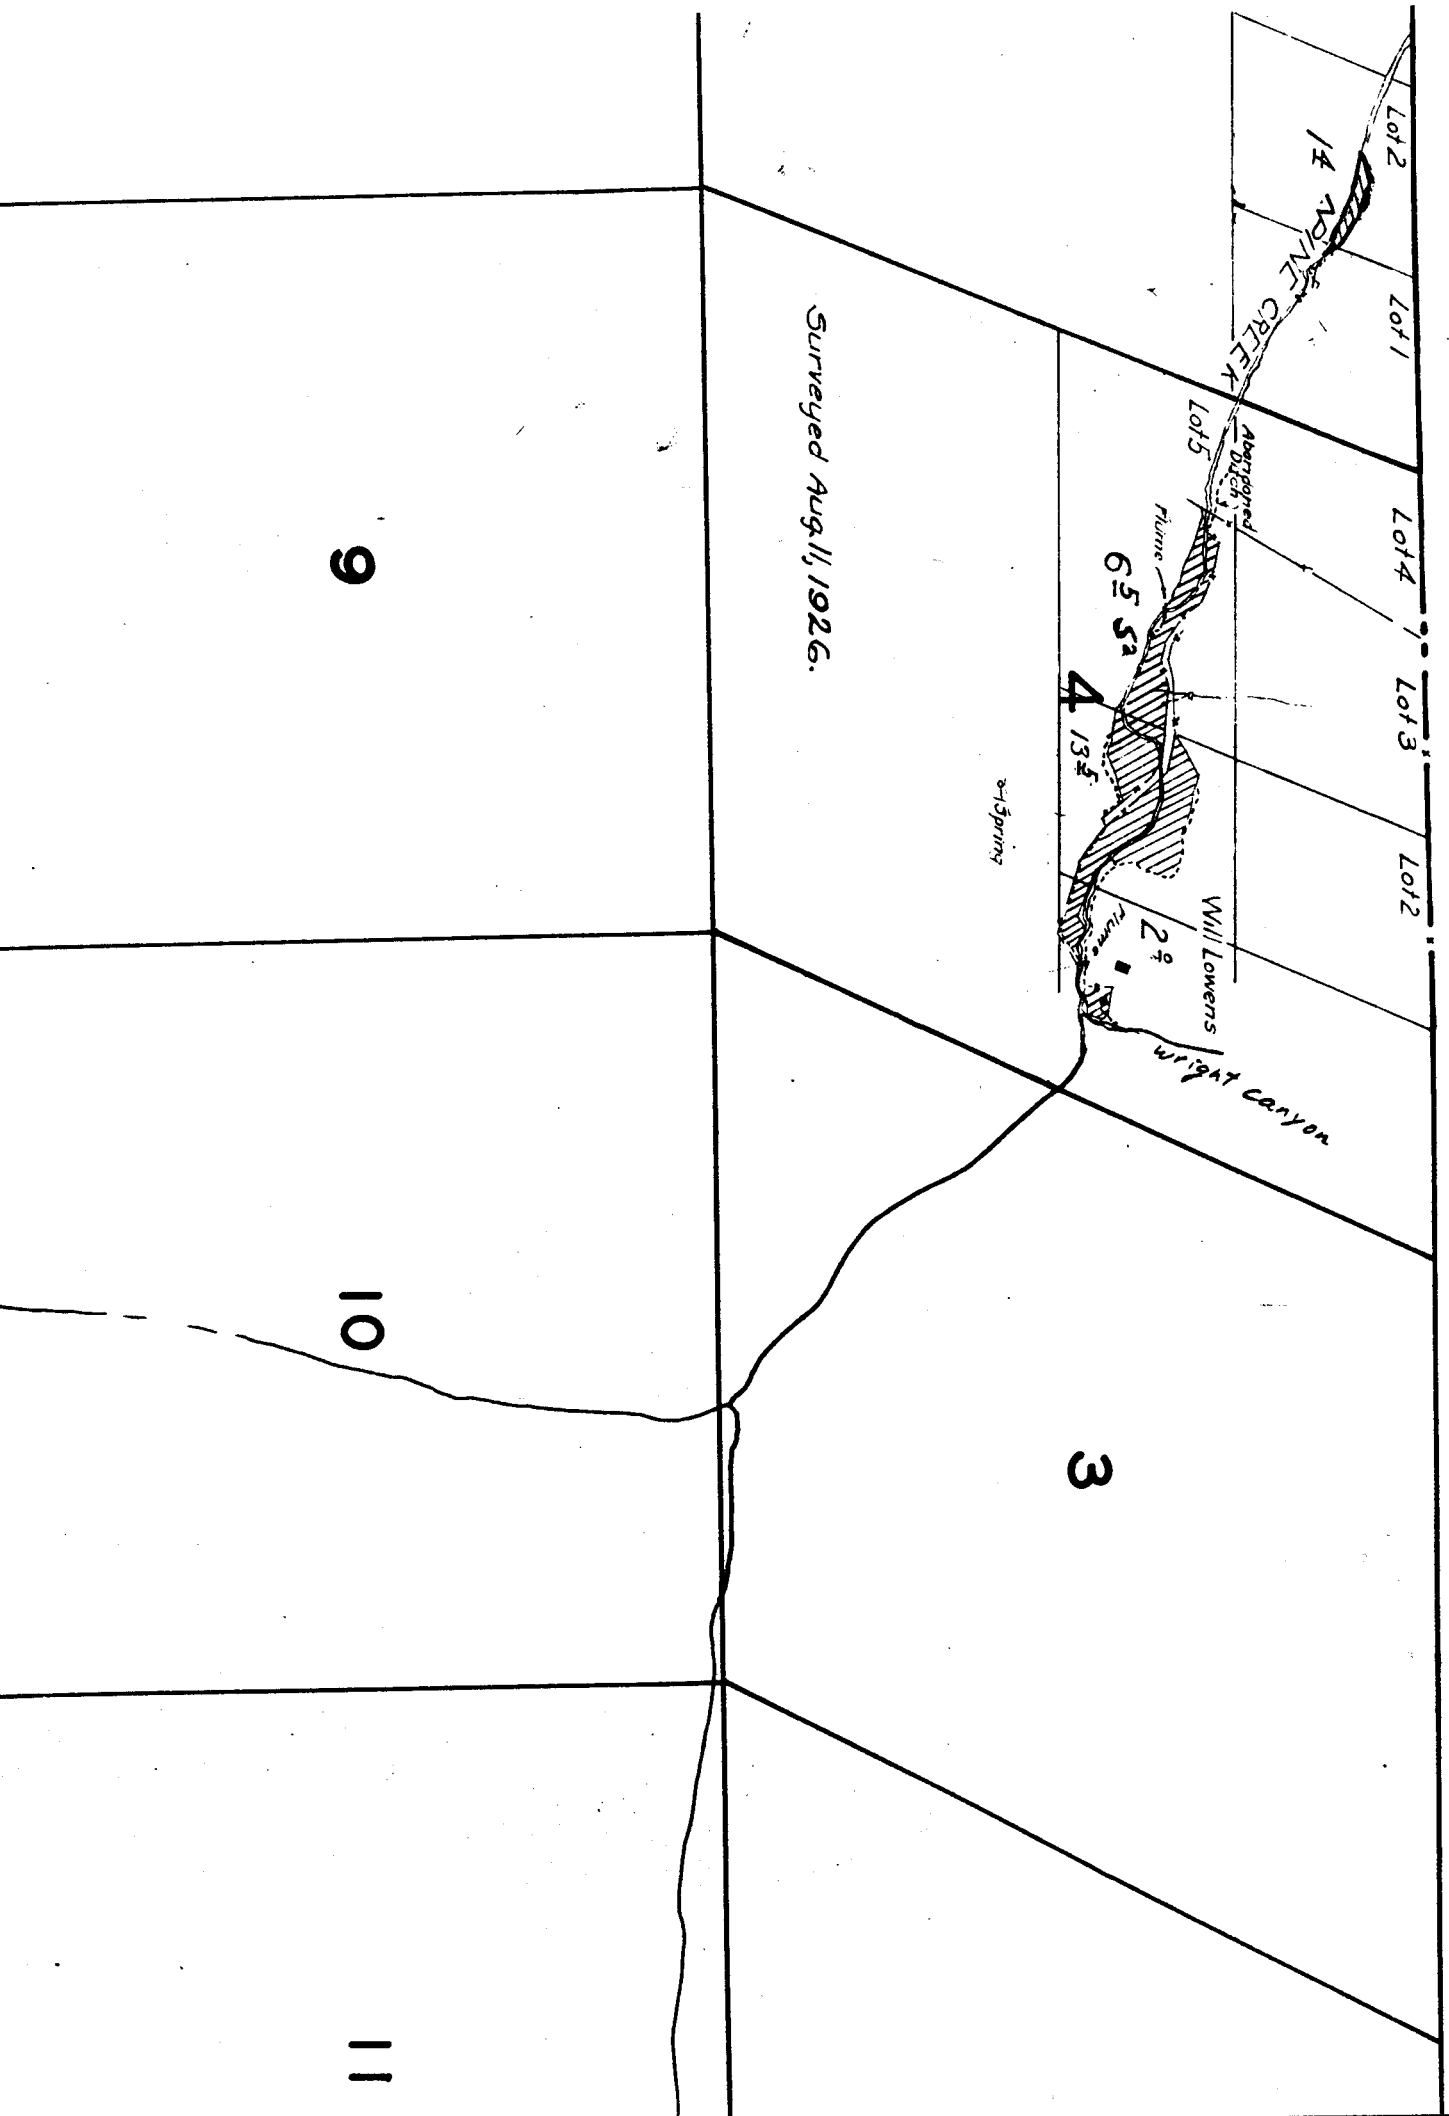

16

15

14

21

22

23

16

21

17

20

18

19

30

29

28

31

32

33

27

26

25

Note: Streams except in the vicinity of irrigated lands, are sketched in approximate location.

34

35

36

ROWE

15

14

13

22

23

24

Surveyed Sept. 5, 1926

Tom Huntington

Pump

6'

2'


4'

Spring
0.2
Spring

Chas. Palmer
Palmer Bros.

Lot 4

CREEK

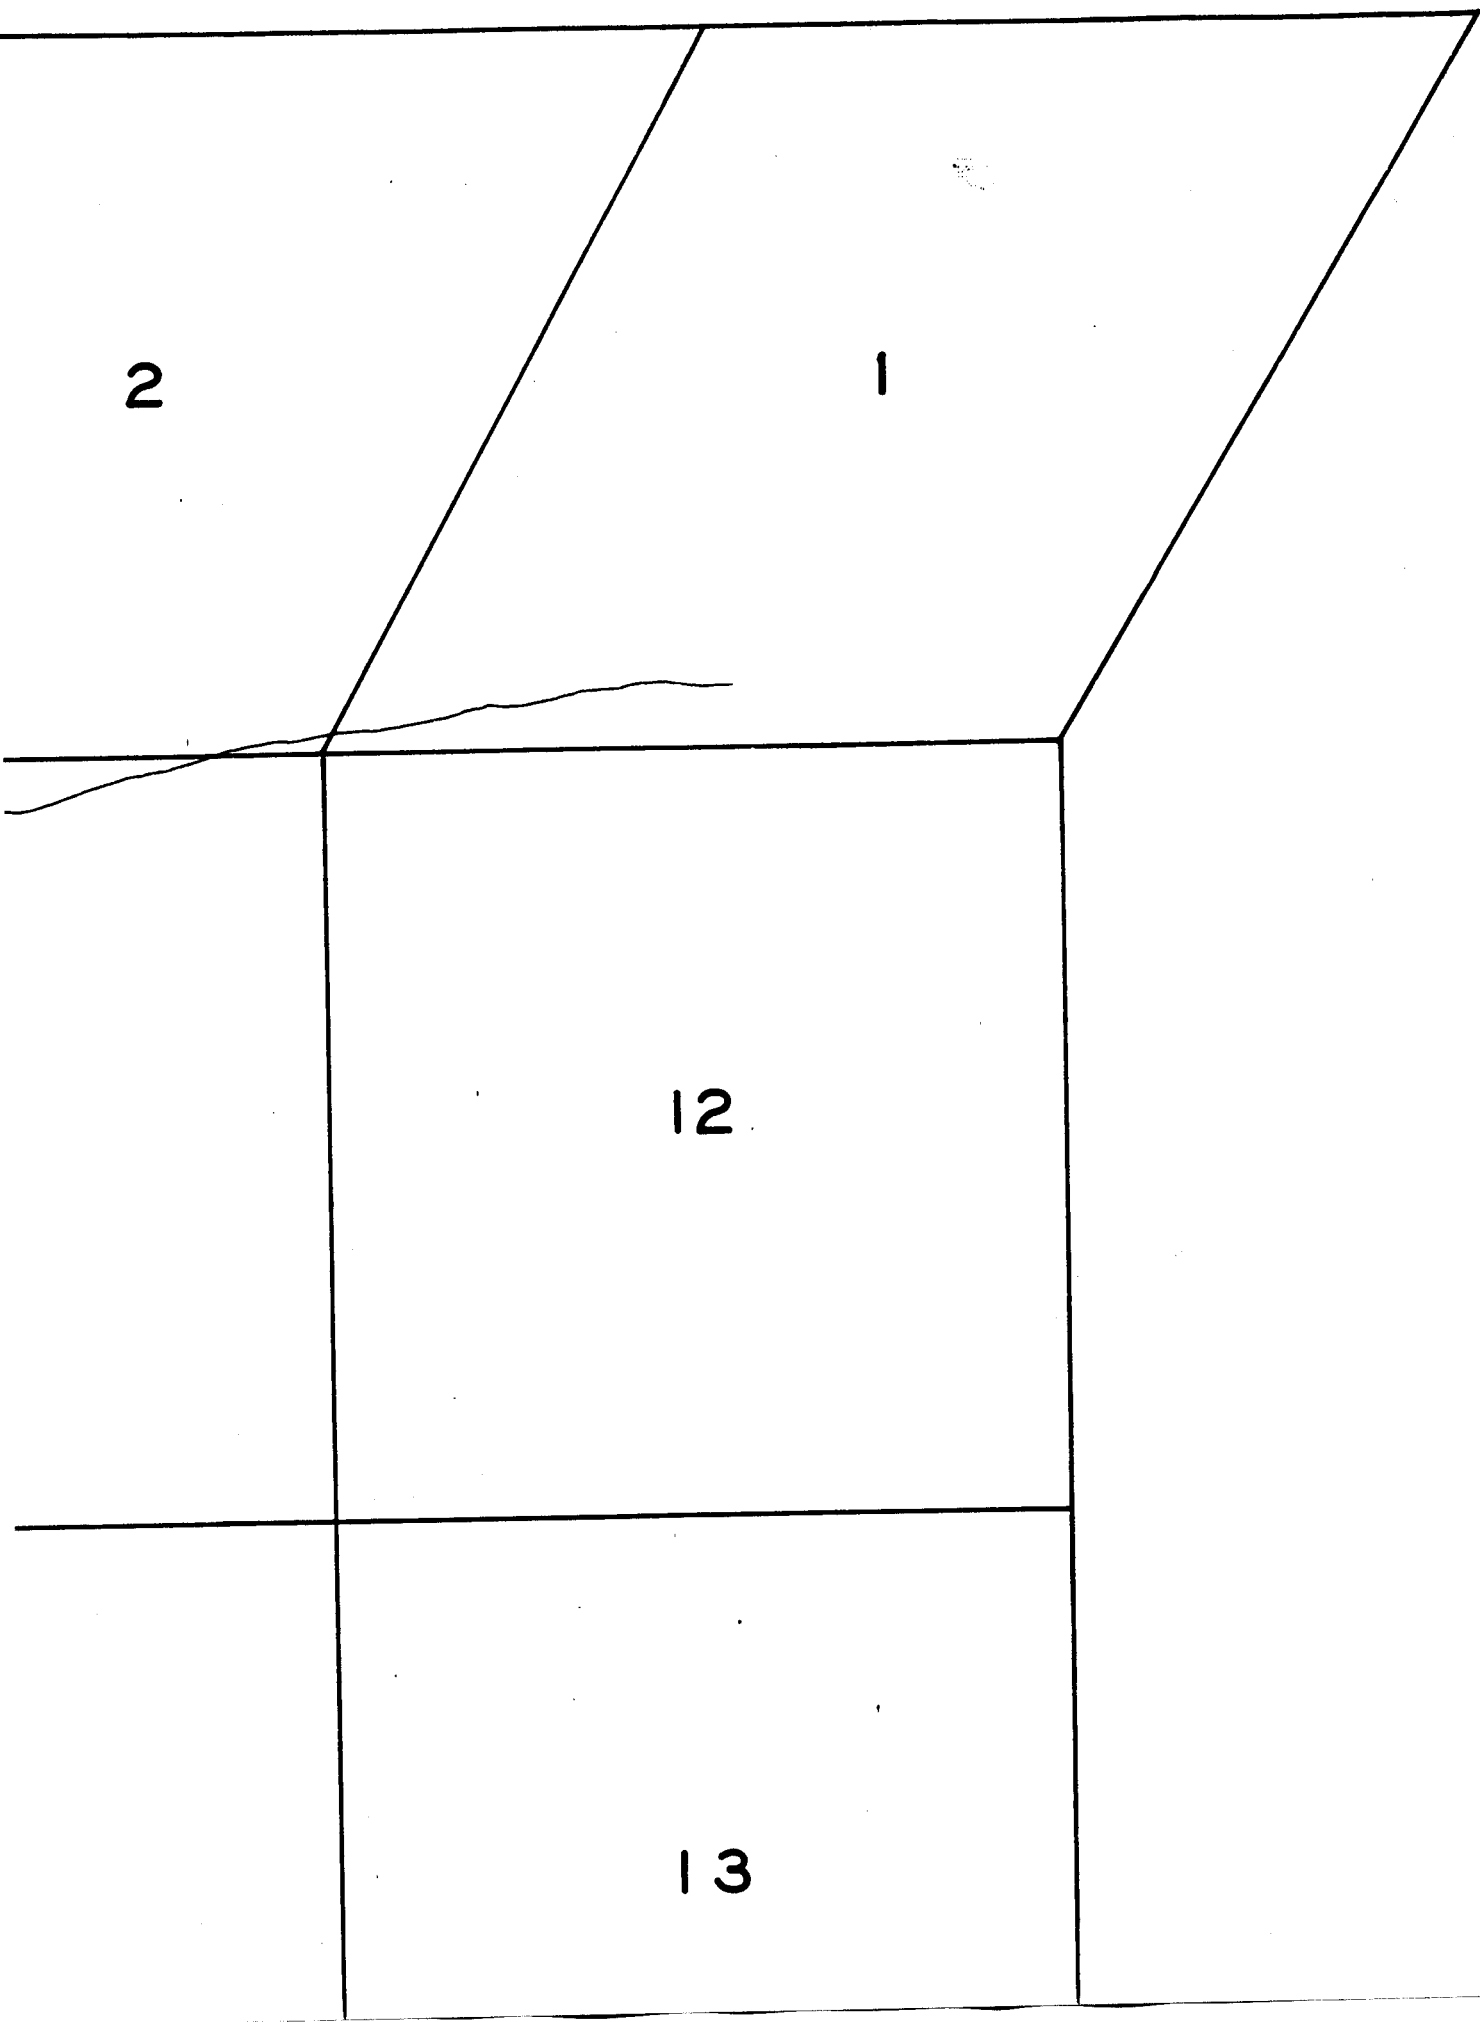

21

22

28

27

33

34

N.
irr
loc

A.S. Conlee

Lot 2

14

6

5

*Note: Section line bearings
and distances taken from
U.S. Township Plots.*

7

8

18

17