

35

36

26

25

23

24

18

17

16

*Note: Streams, except
irrigated land, sketched
location.*

04

Thomas Mabe

Lot 2

34

19

20

21

Lot 3
01


Surveyed Nov. 6, 1925.

TOWNSHIP

Surveyed Oct 30 to Nov 1

4

Federal Land Bank
(U.I. Thomas)

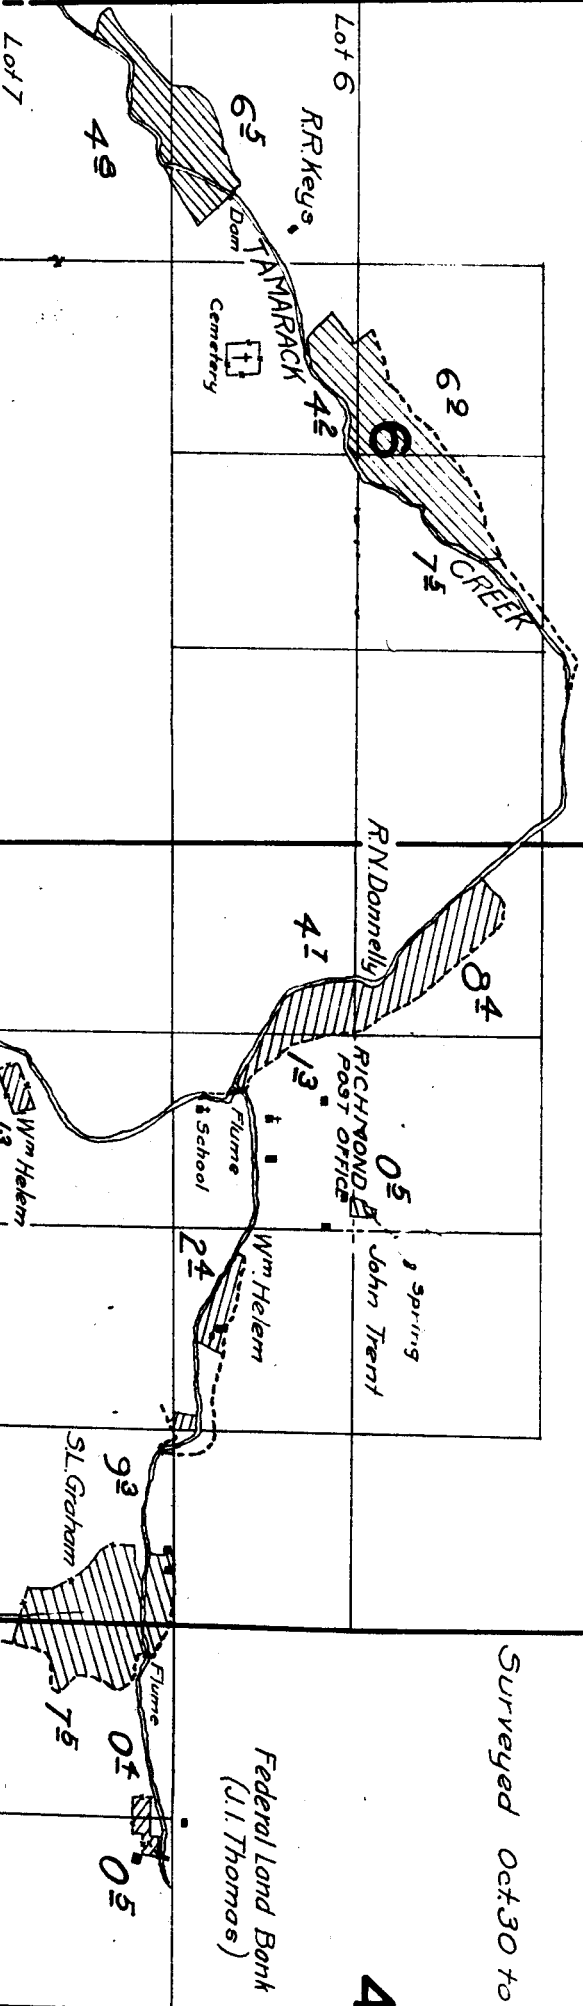

7

9

TOWNSHIP 10 S., RANGE 23 E.

urveyed Oct. 30 to Nov. 3, 1925.

4

Federal Land Bank
(J. I. Thomas)

75
07
05

10

9

3


Note: Location of ditch & creek
sketched in field.

64

74

Lot 14

Lot 1

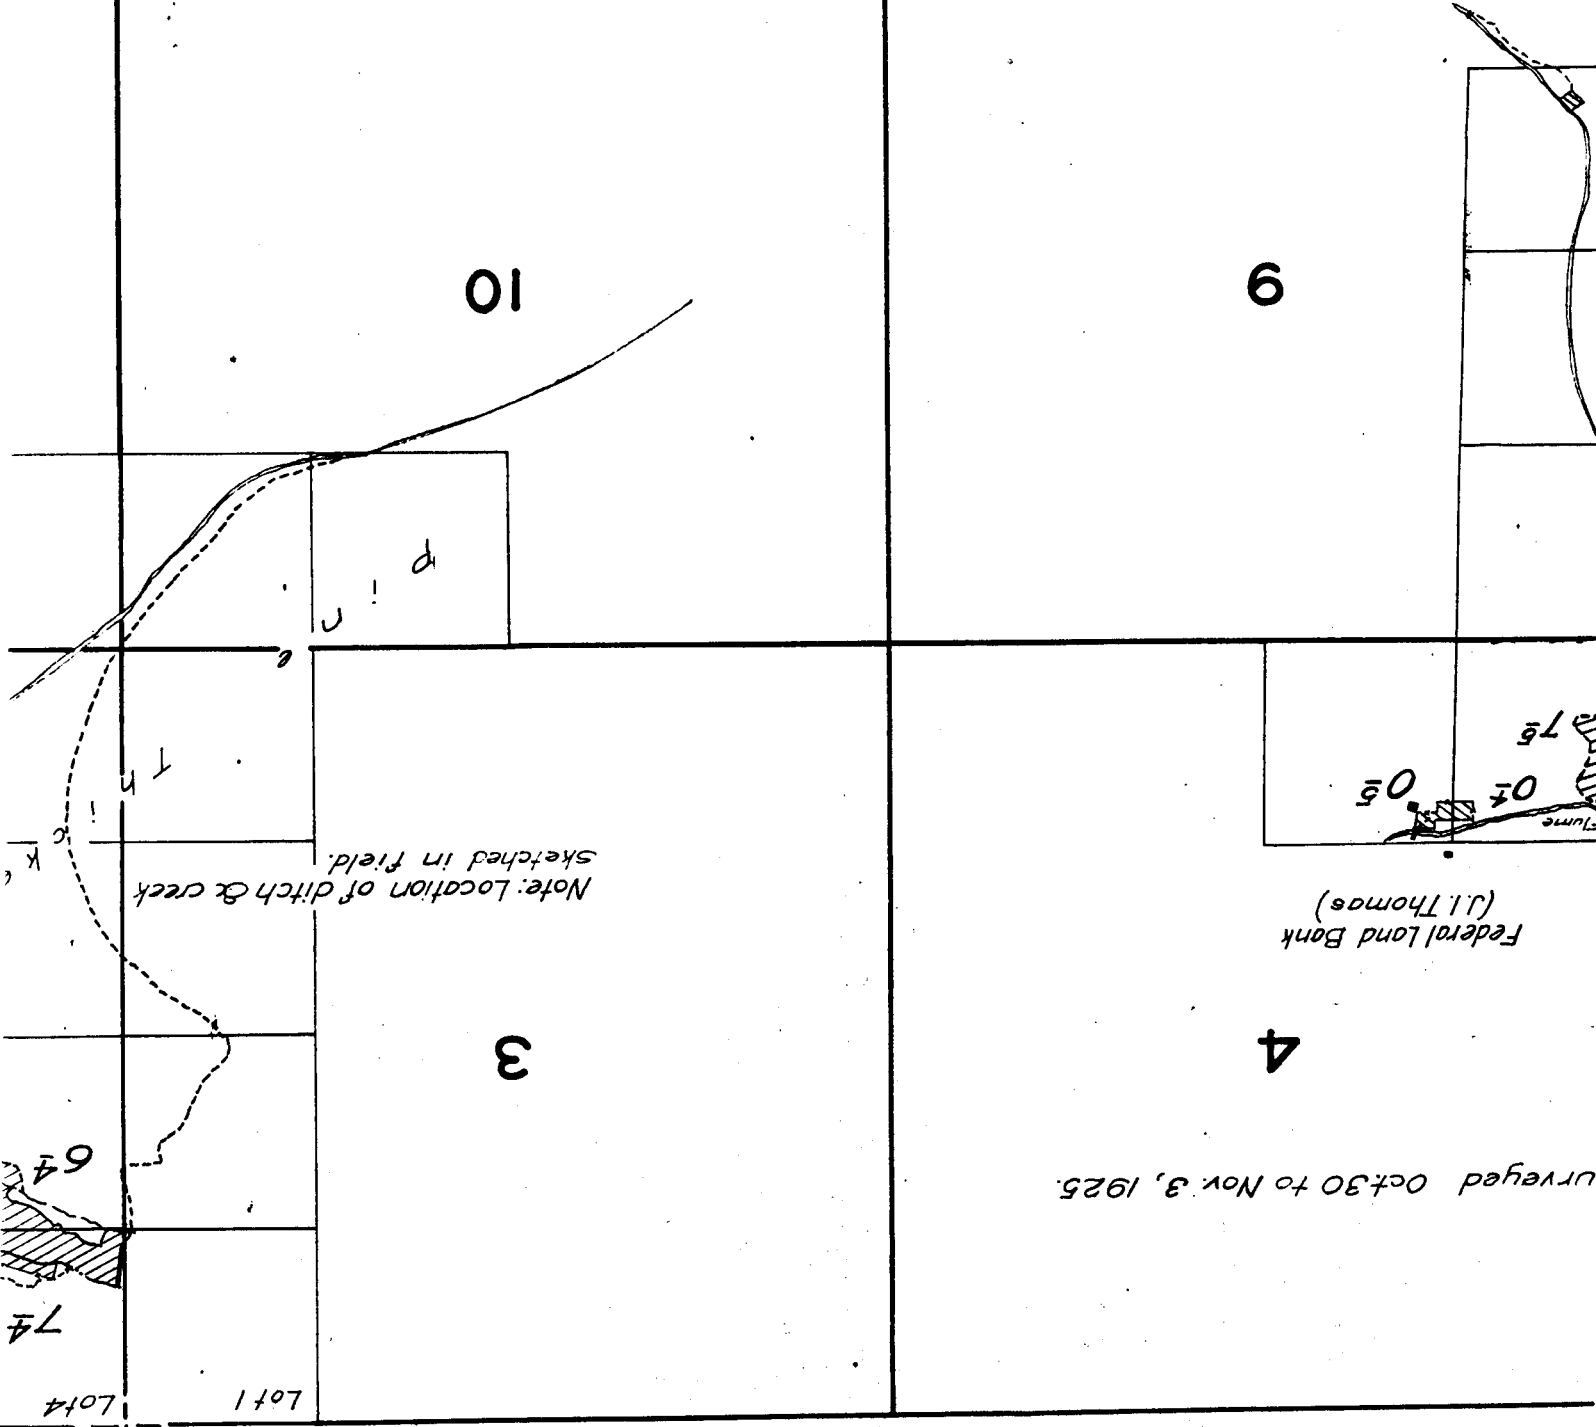

15

14

13


22

23

24

JE 23 E.

76-2-2

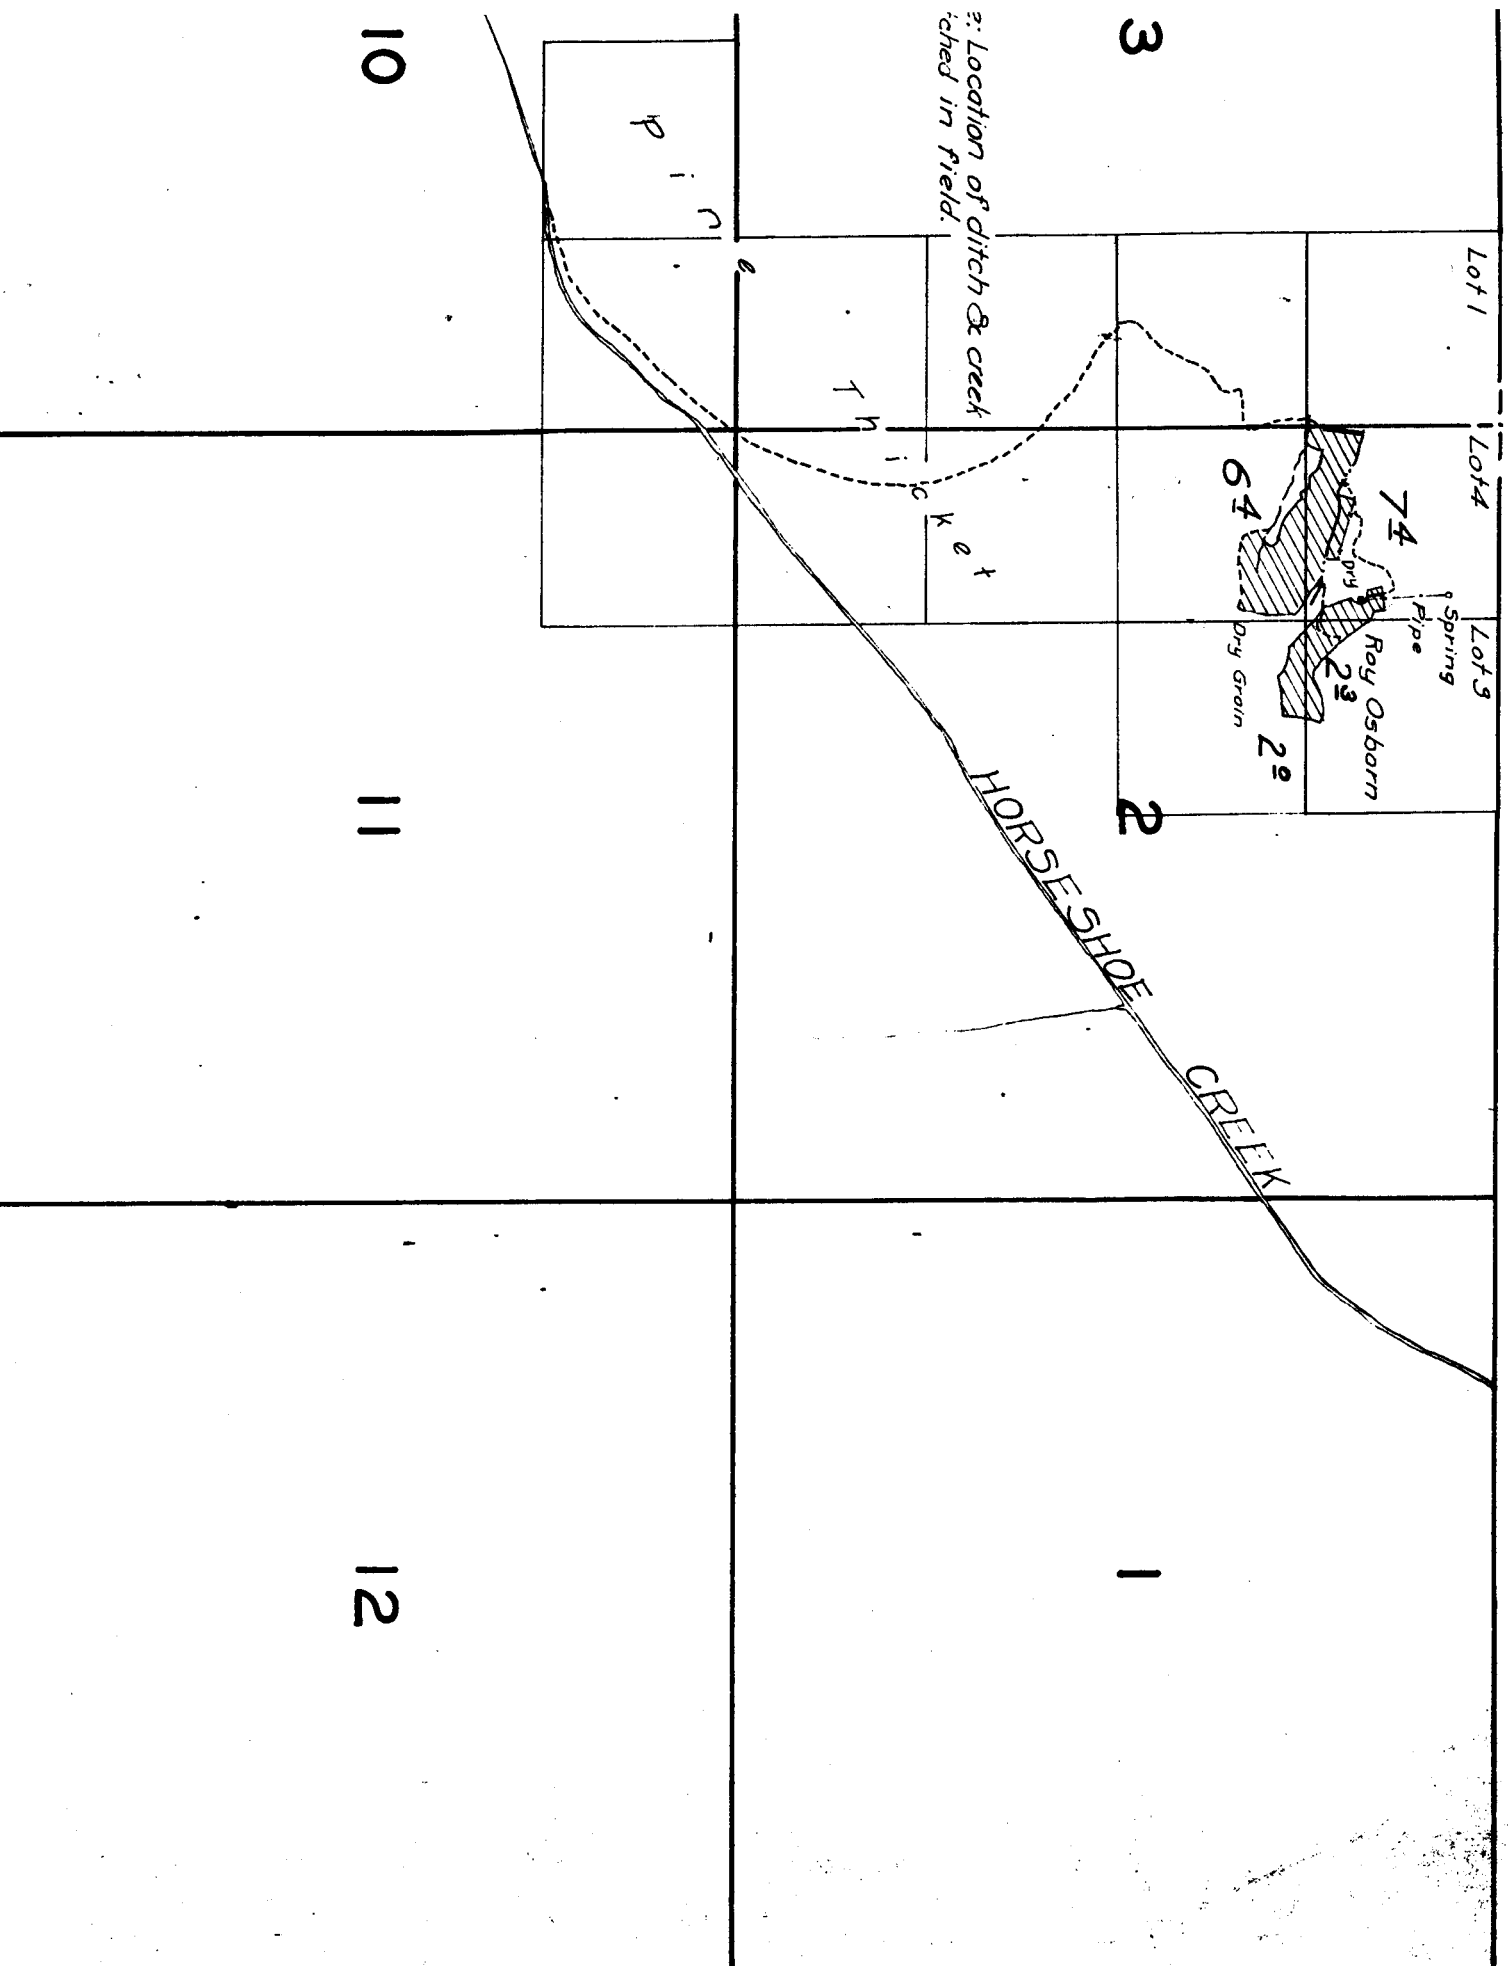

32


31

29


30

20

19

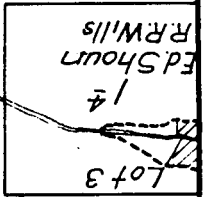

Surveyed Nov. 6, 1925

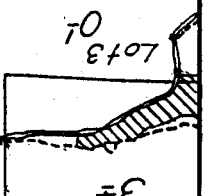

29

28

27

32

33

34

17

16

15

*Note: Streams, except in the vicinity of
irrigated land, sketched in approximate
location.*

20

21

22

9

28


27

15

2

33

34

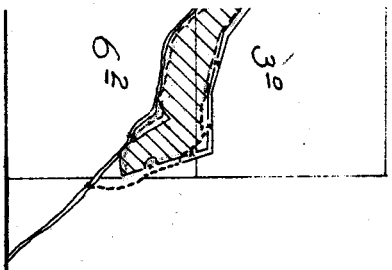

17

16

15

20

21

22

Note: Streams and river, except in vicinity of irrigated land, sketched in approximate location

18


17

16

19

20


21

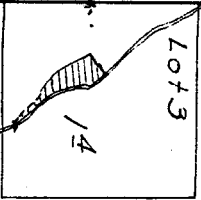

Charlie Shown

Note: Streams and river
vicinity of irrigated lands
approximate locations

TOWNSHIP

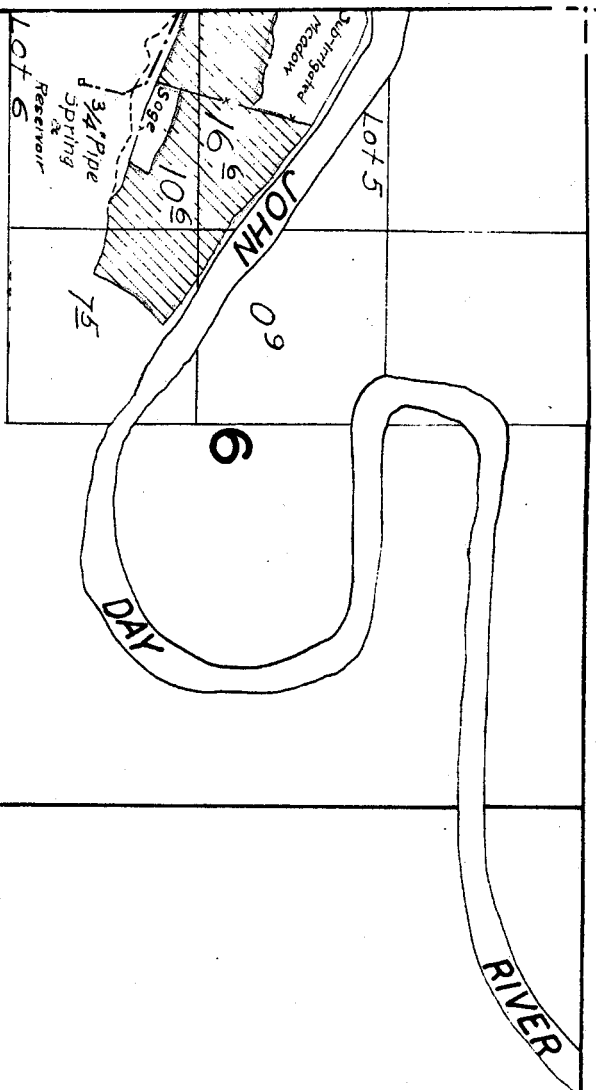

Surveyed Aug. 30, 1926

7

8

9

15

22

14

23

13

24

Surveyed Oct. 24, 1925.

BLACK ROCK CREEK

CREEK

School

Martin Jackson

G.O. Butler

Thomas Mabe

Dein

5 6

9 5

3 2

6 1

12 3 9

1 5

0 5


18 8

4 2

6 2


6 2

8 2

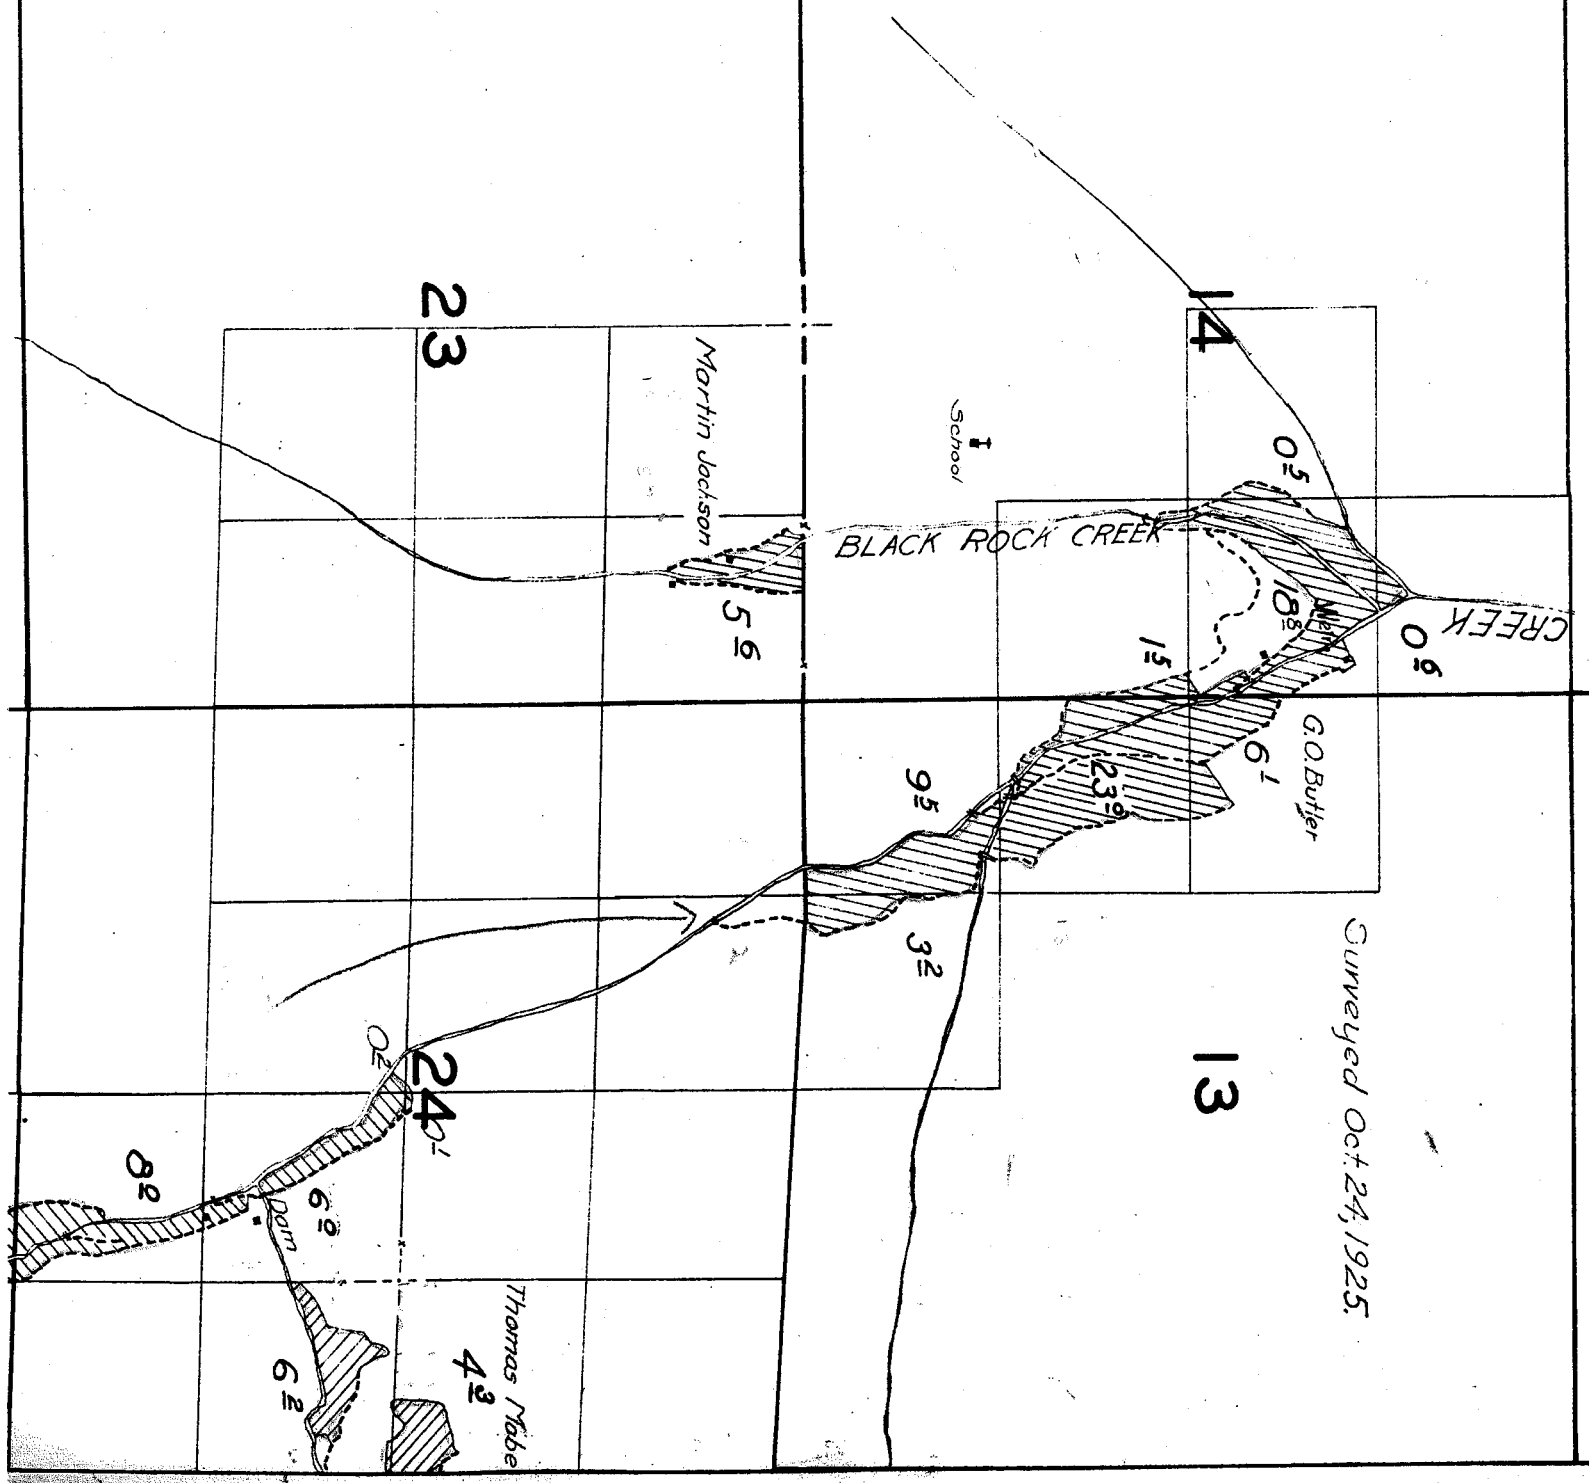

NGE 22 E.

75-2-2

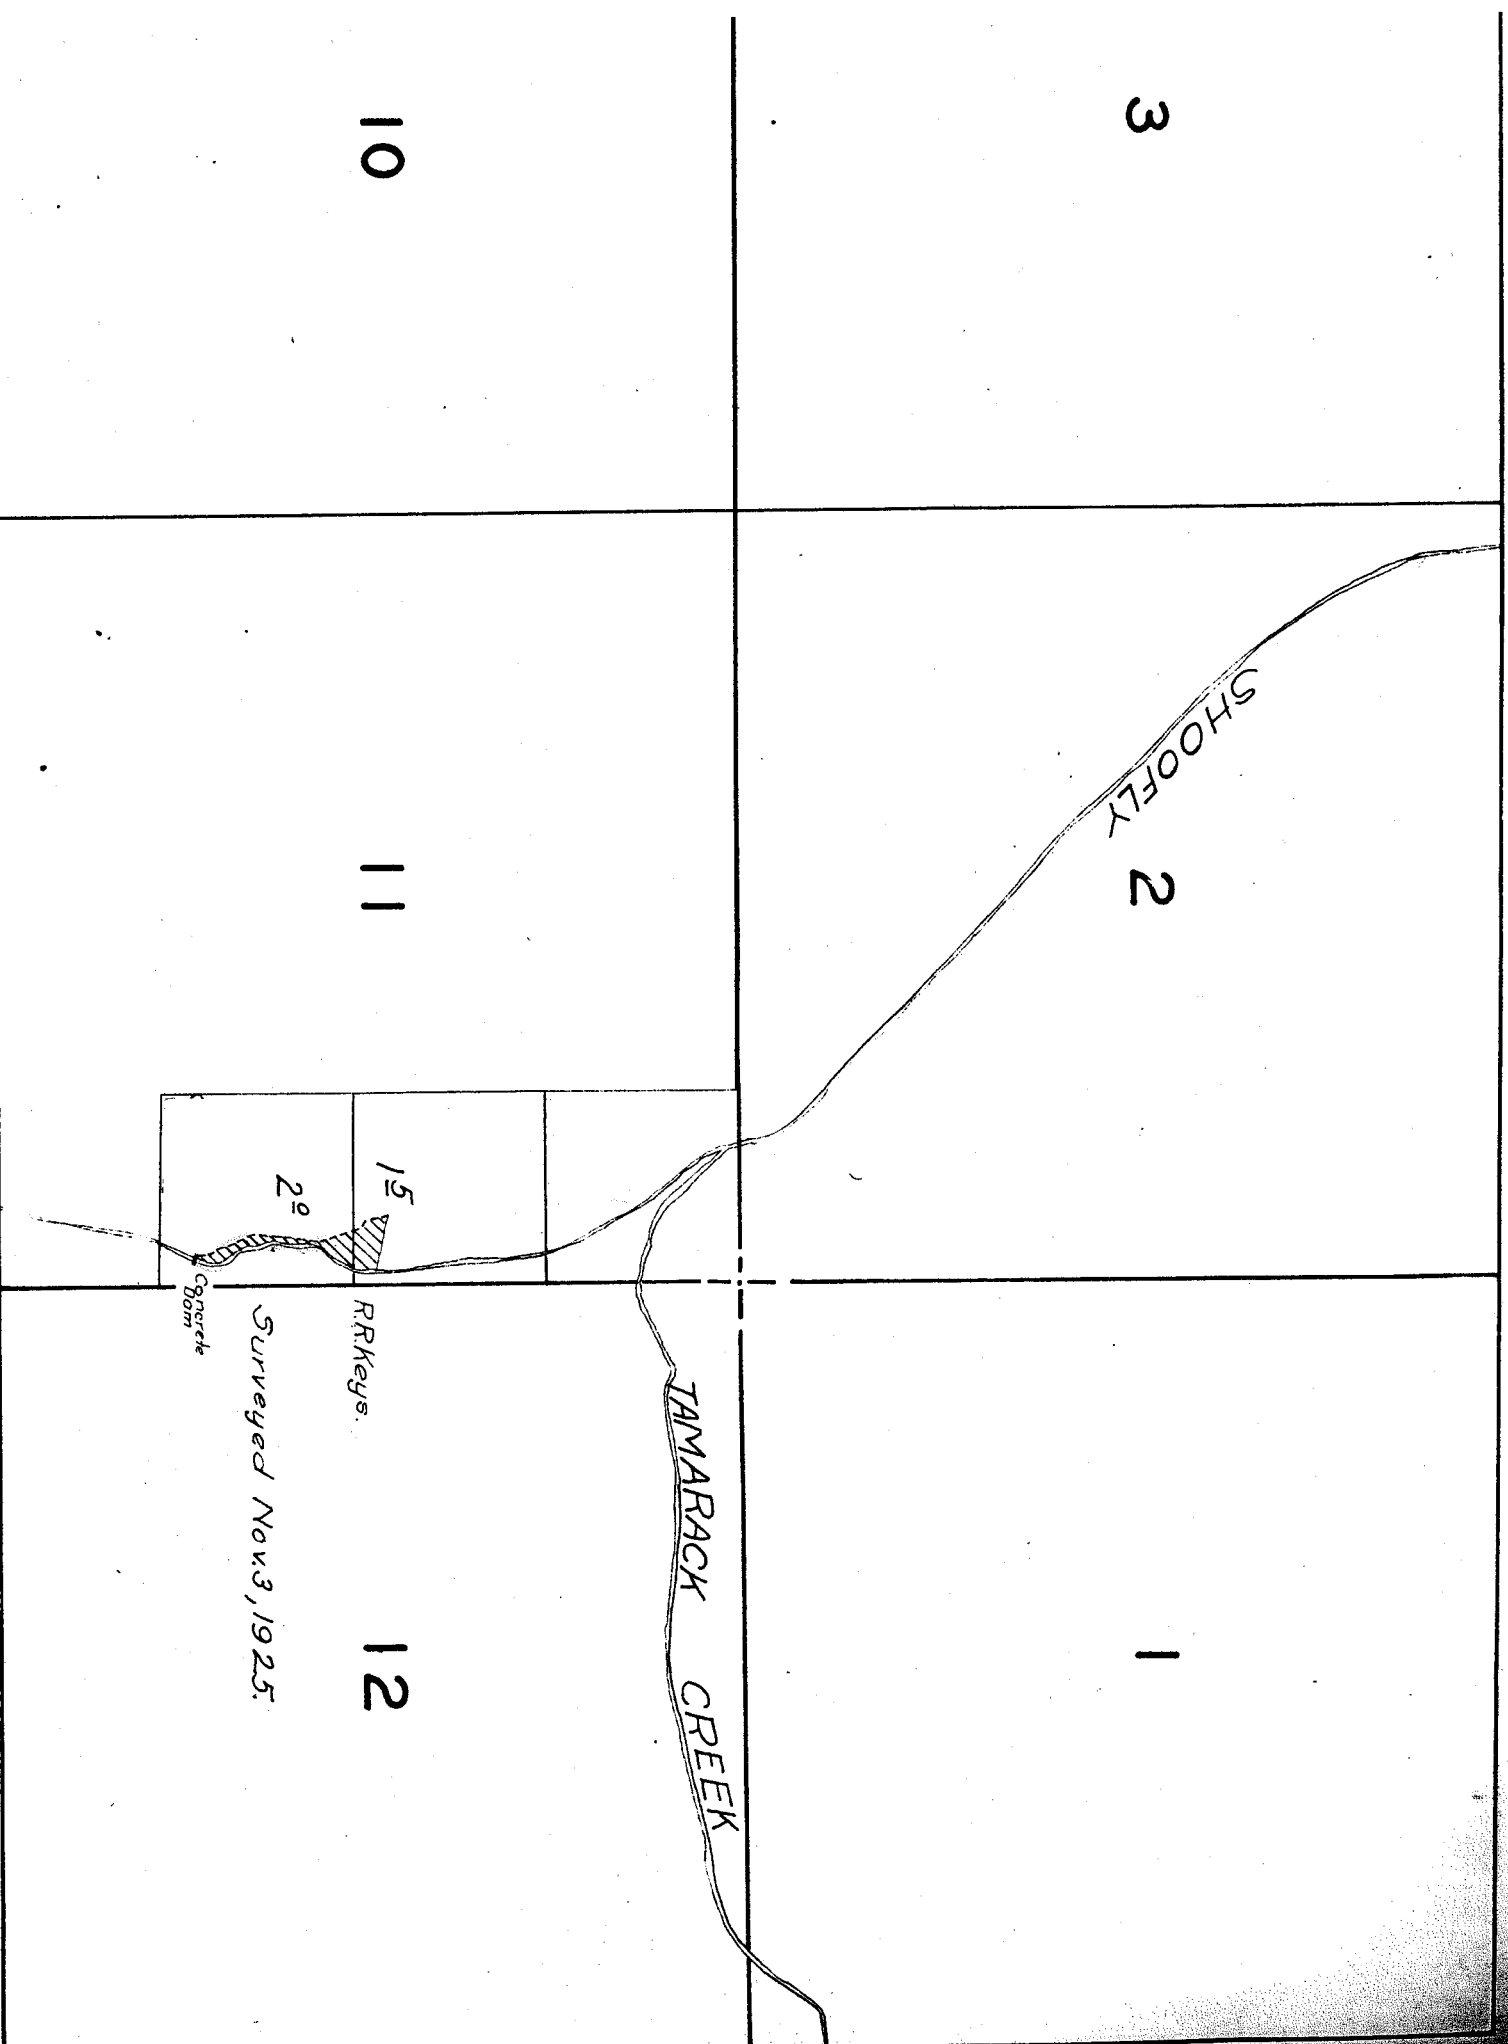

OWNSHIP 10 S., RANGE 22 E.

4

3

9

10

16

15

23

24

4³

02

6²

Dam

6²

8²

7²

Flume

04

Ed. Shoun
(R.R. Willis)

25

4²

28²

04

27²

13⁵

Sage Brush

26


35

36

Surveyed Nov. 4, 1925.

19

20

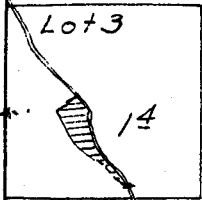


Charlie Shown

GIRDS
Rim
Rim
Rocks
30
Rocks
CREEK

29

Surveyed Sept. 4, 1926.

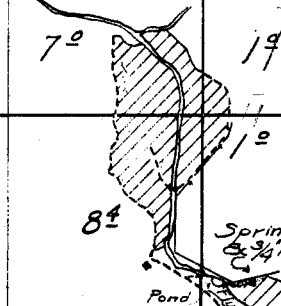

Spring
3 3/4 ft. from

Winlock Hendricks

Pond

31

10^o

32

7¹

3^o

6²