

19

20

30


29

31

32

NGE 19 E.

3-2-1

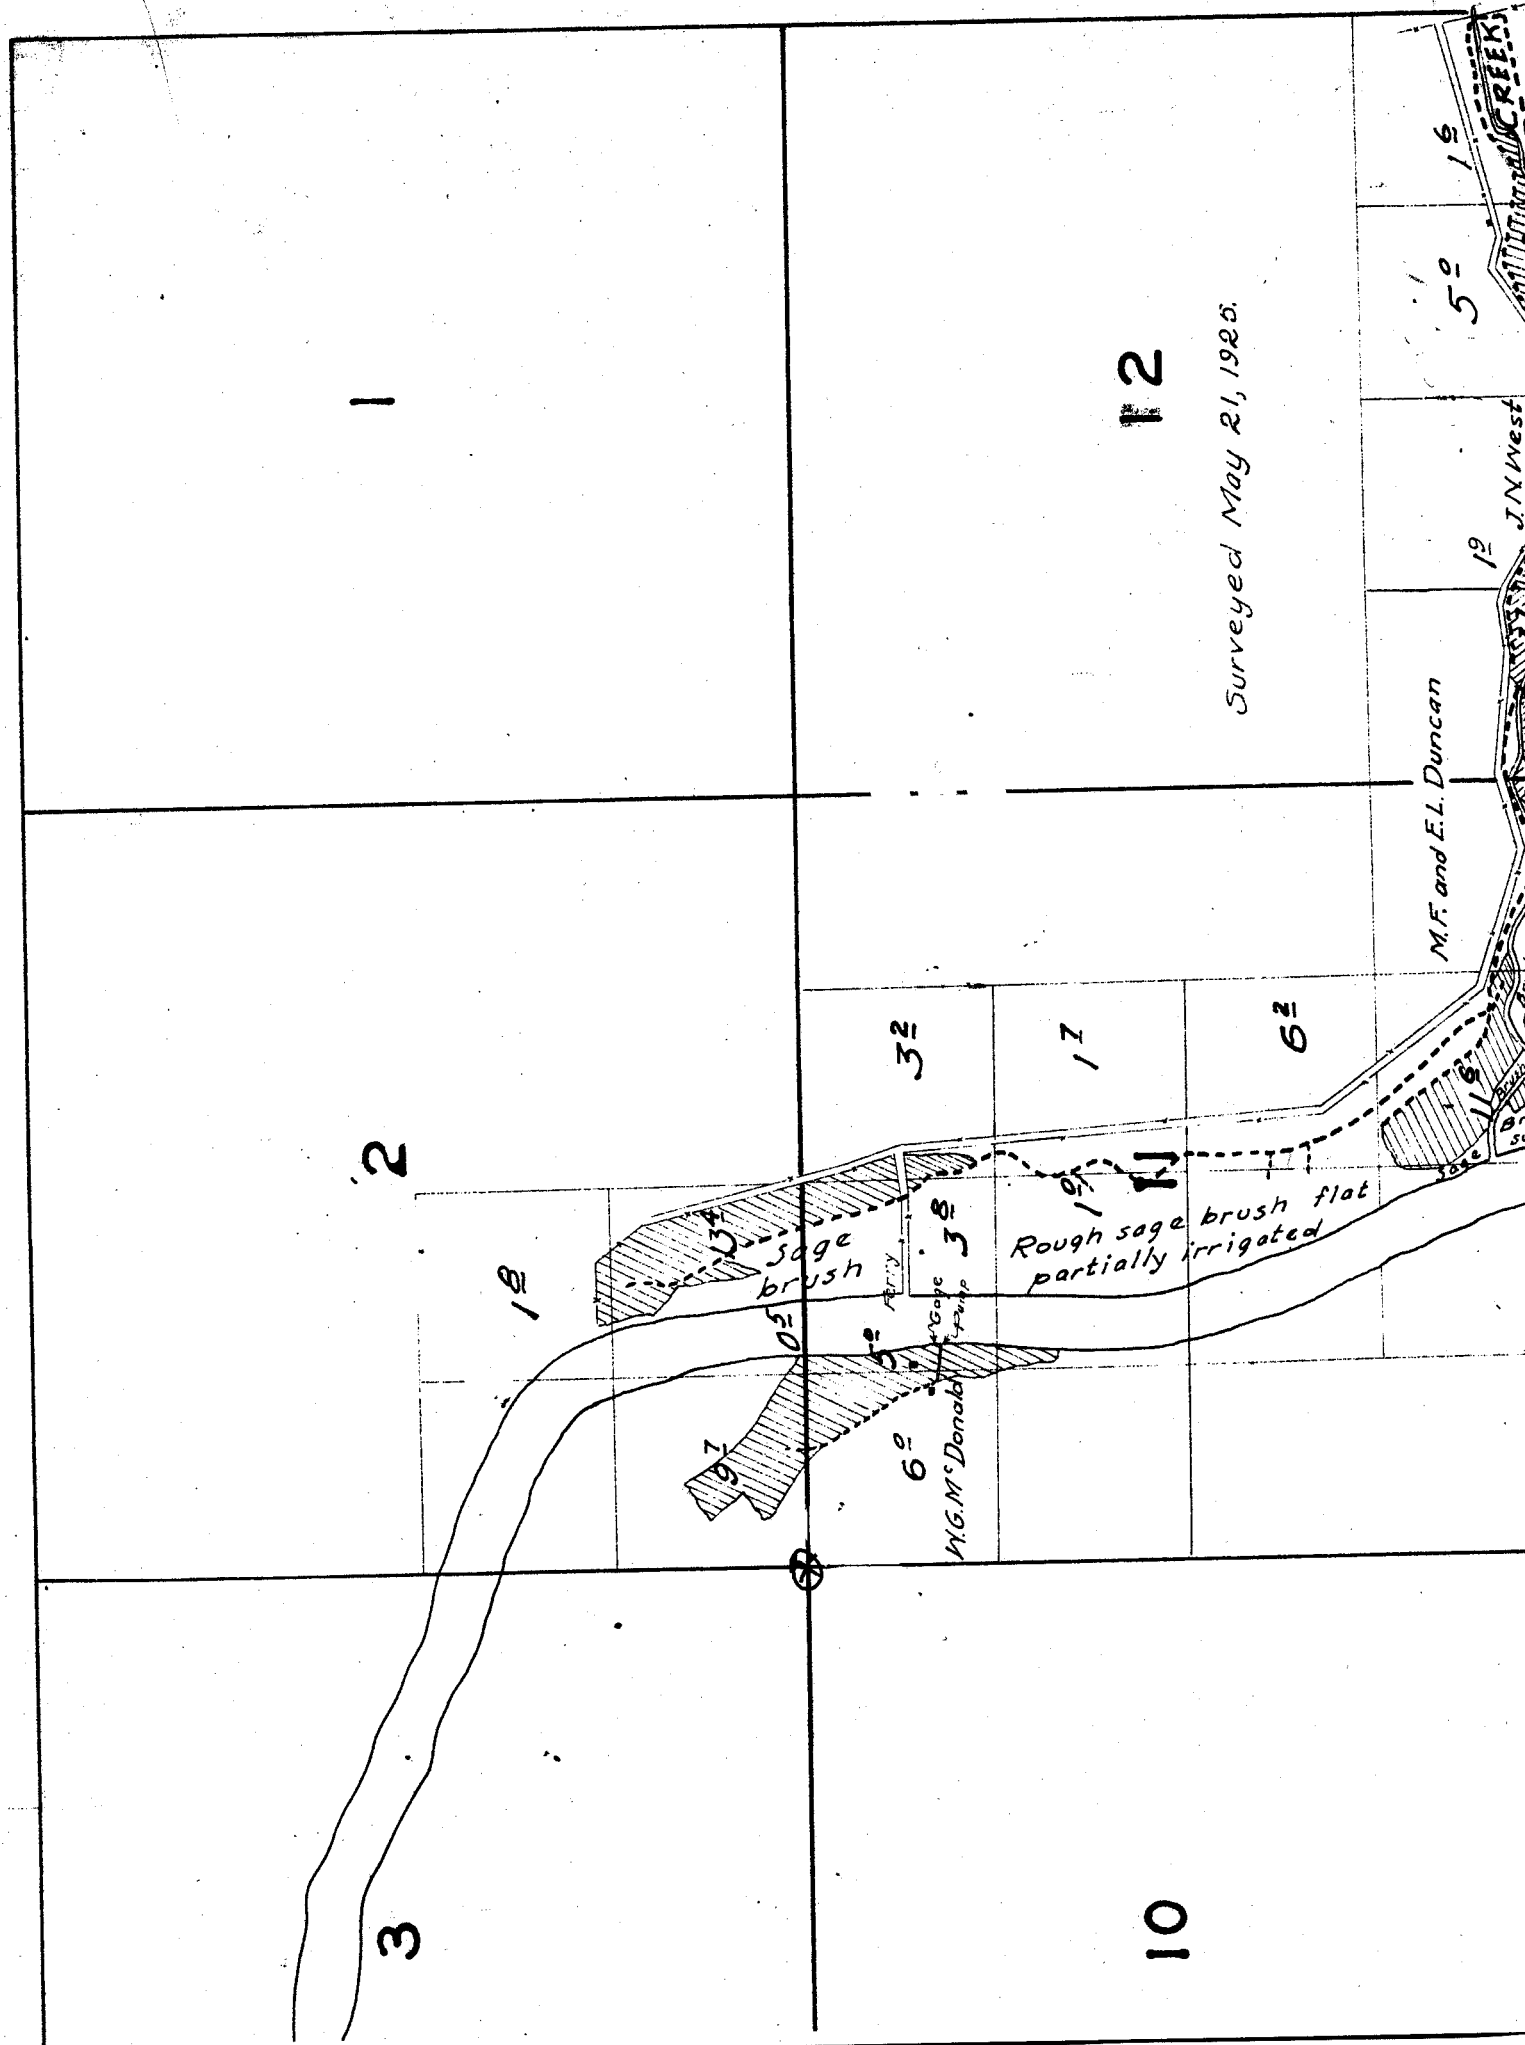

23

24


12

JOHN DAY RIVER

partly filled with dirt

Pump

14

14

69

25

76

34

Pump

Dam
Wind Mill & Pump

26

35

36

Surveyed May 14, 1925.

JOHN DAY RIVER

16
115
116
Sage

Thos. Brady

Wind Rock

Flame

Flame

Flame

TOWNSHIP

6

5

4

7

8

9

		18	17
			16
		19	20
			21

28

27

33

34

16

15

*Note:
Streams and roads, except in the
vicinity of irrigated land, are
sketched in approximate location*

21

22


TOWNSHIP 1 N., RANGE 19 E.

4

3

9

10

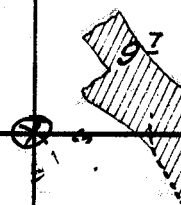

6°

H.G.M. Don.