

15

14


13

16, 17, 18, 19, & 20, 1926.

2


23

24

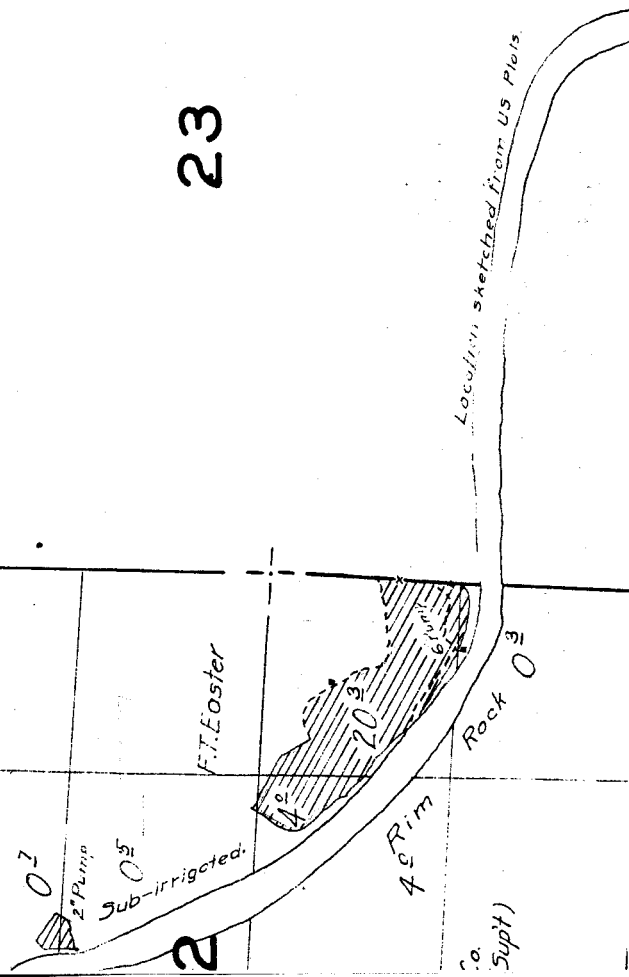

SE 19 E.

42-2-1

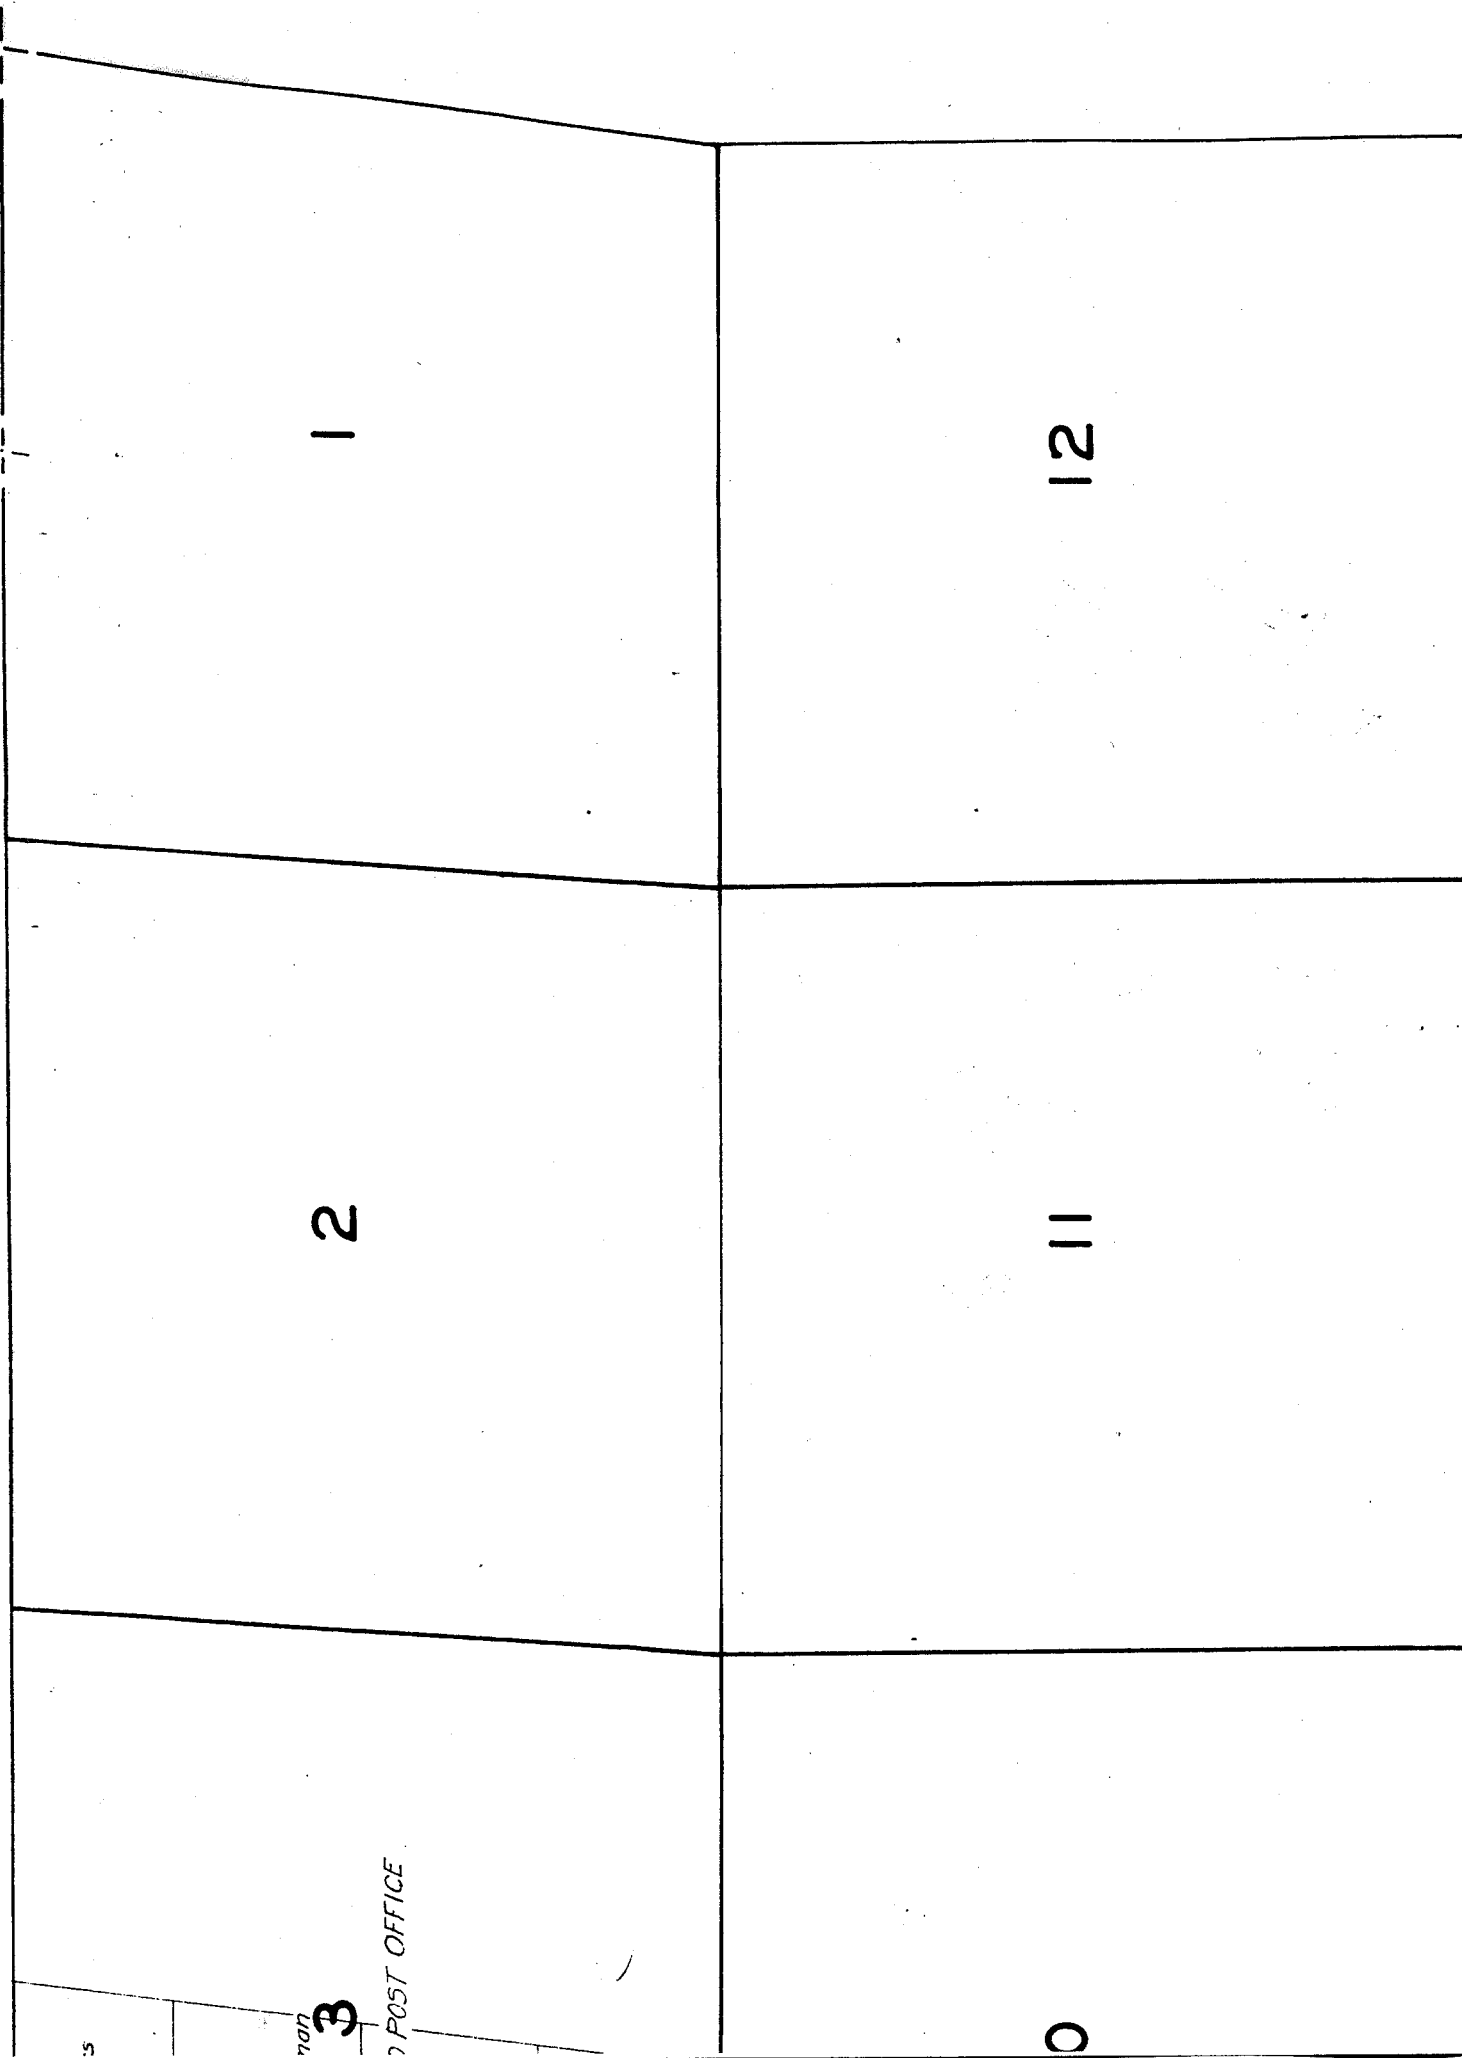

23

24

Location sketched from US Plots.

C.S. Hicks
Sub-irrigated
Farm Land

26

Rim Rock

4°

509°E

Brush

25


0°

6'ump

35

Location sketched from U.S. Plots.

36

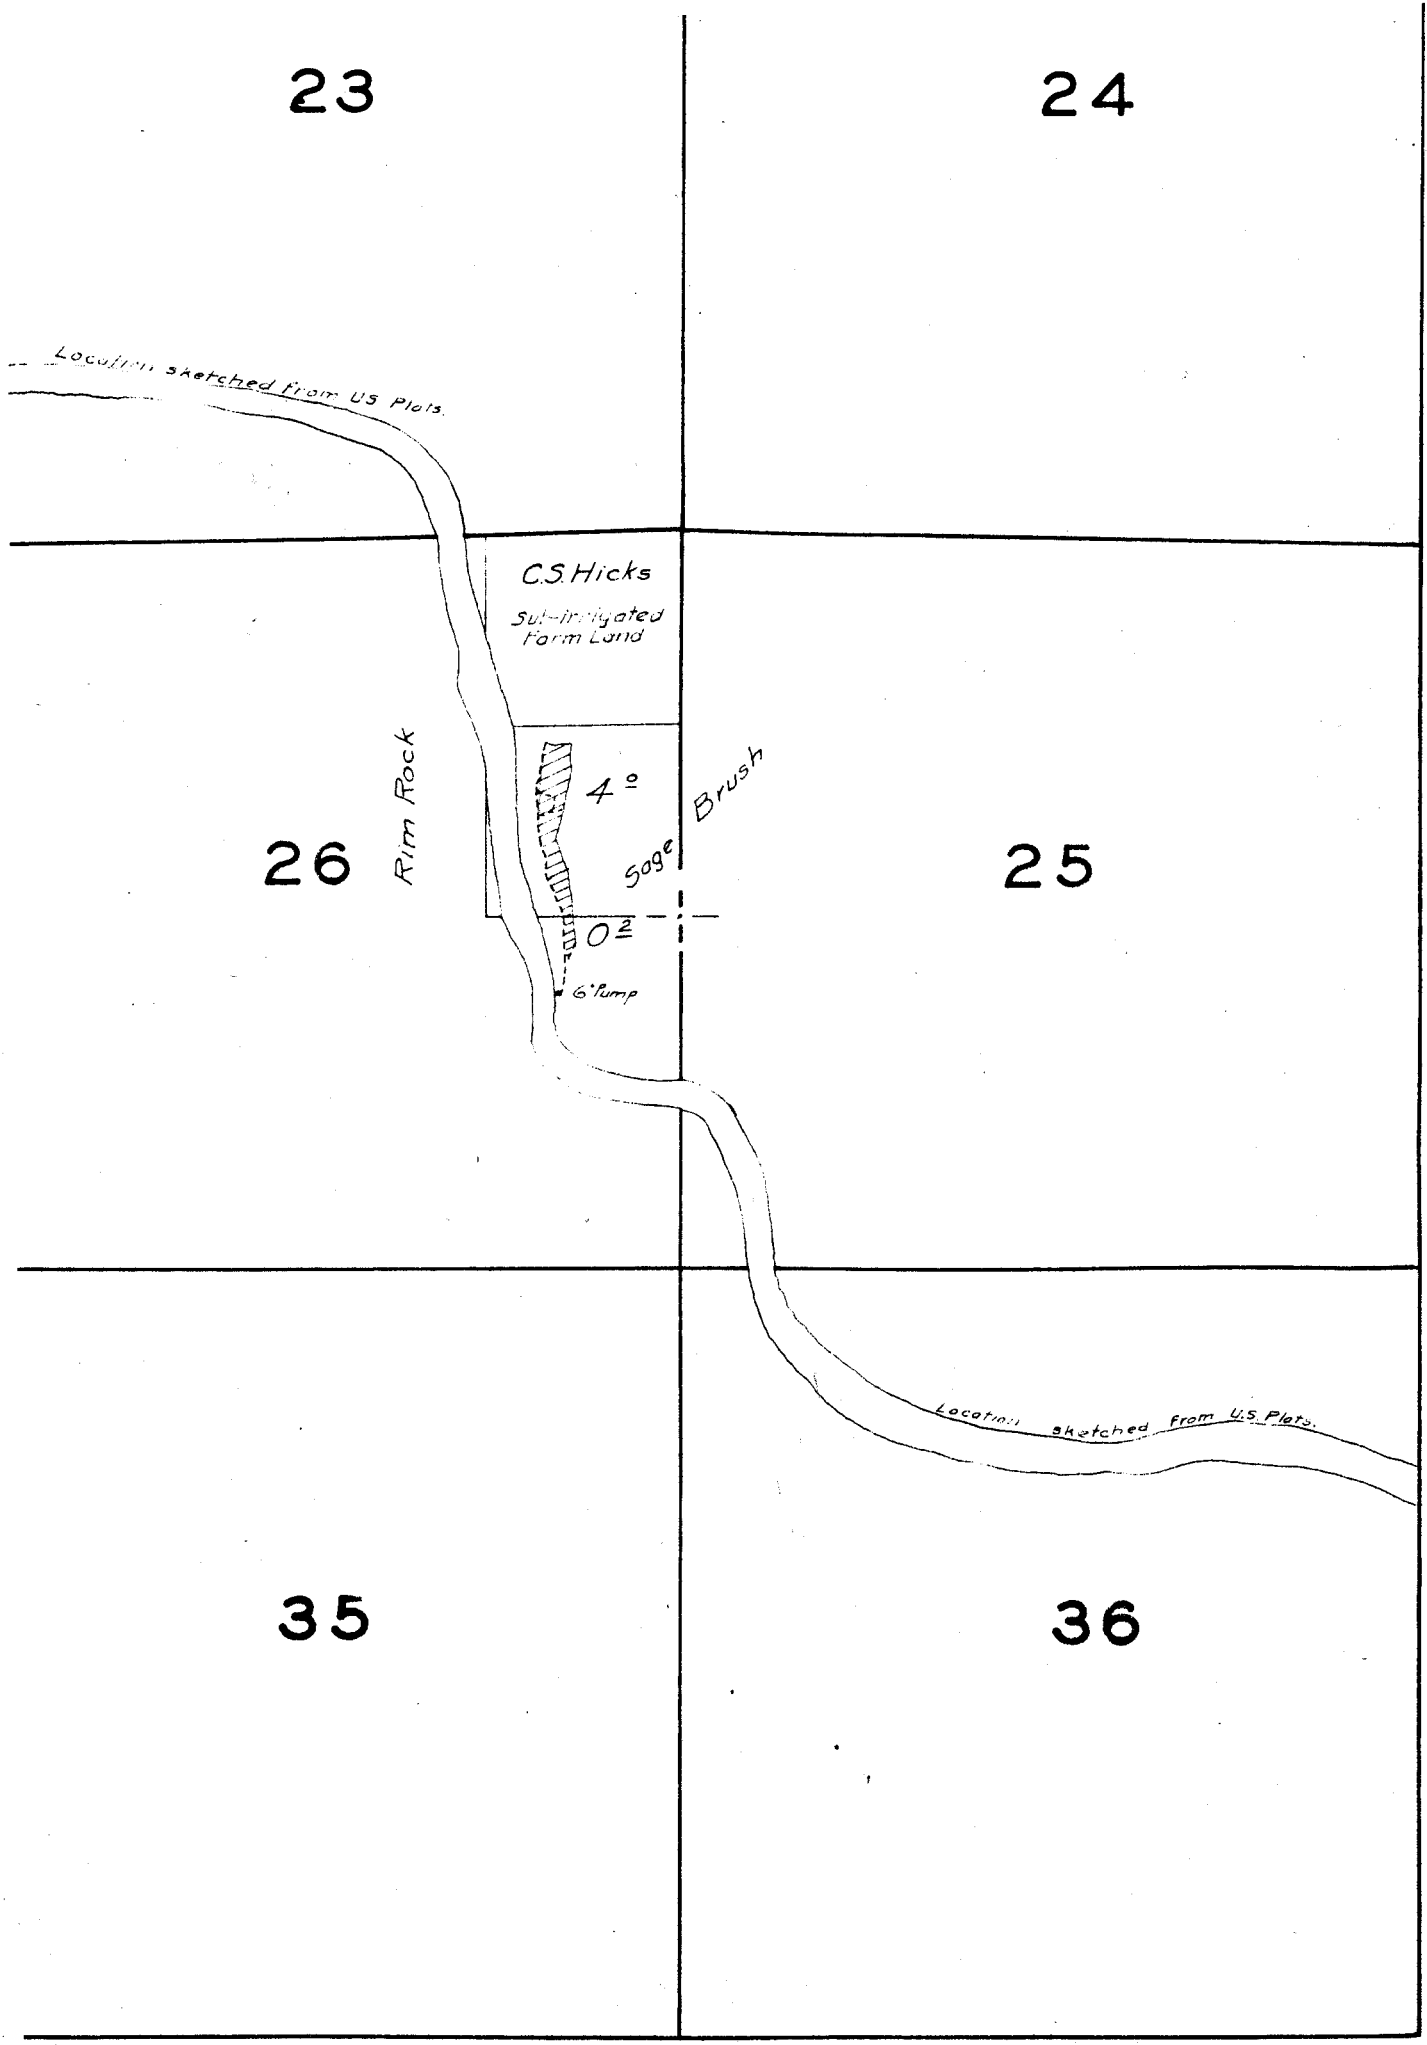


19

20

30

29

Sage Brush
MUDDY

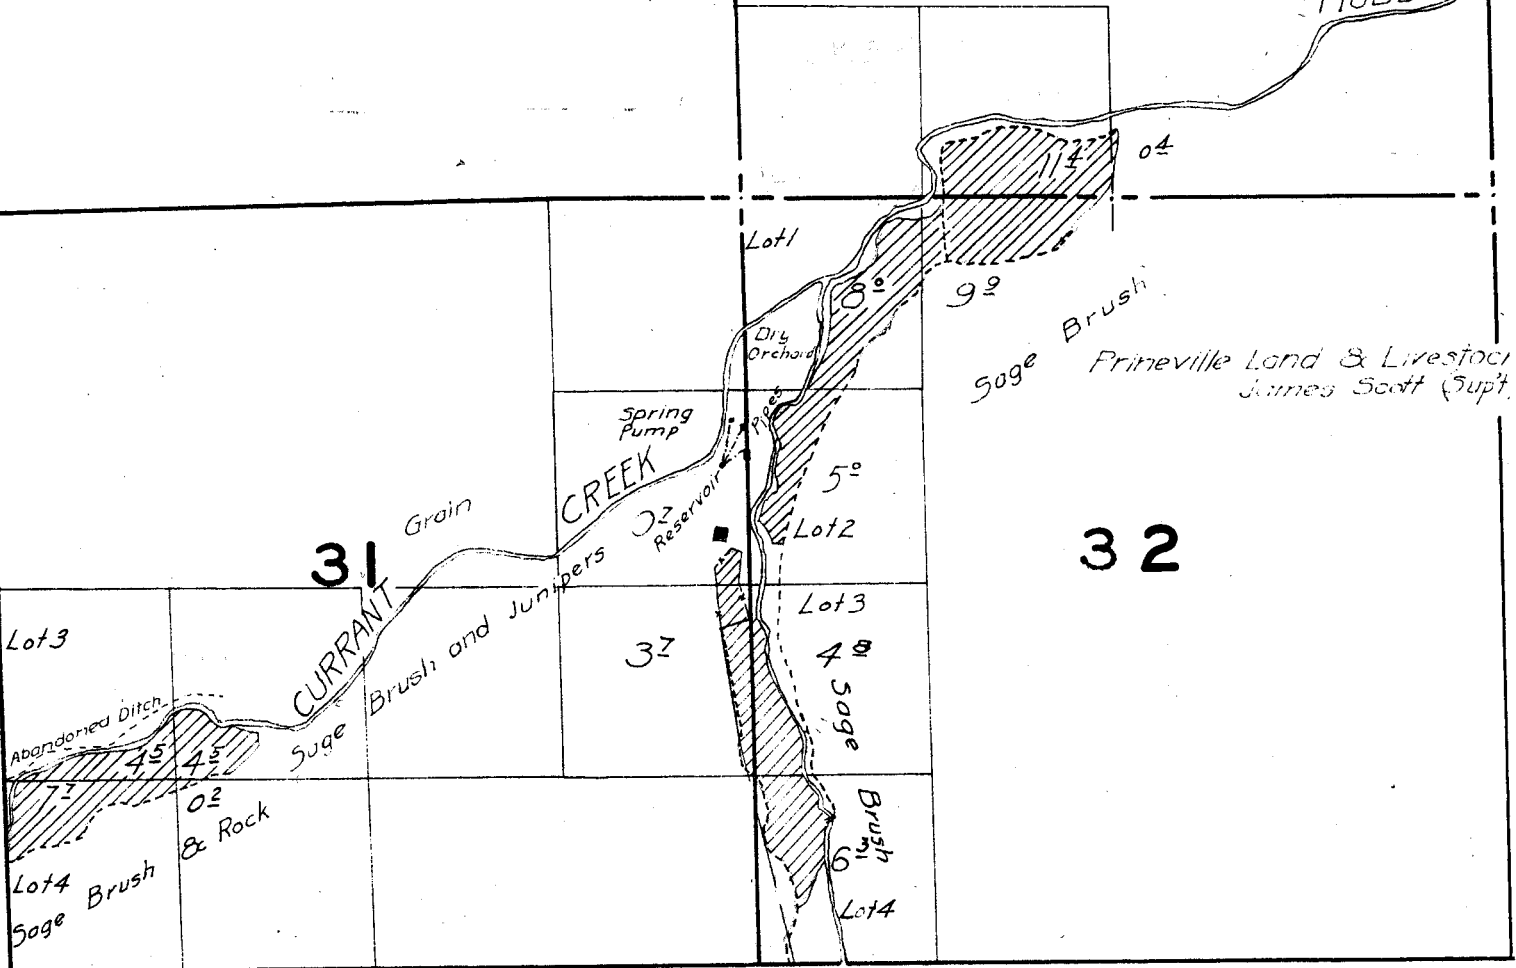

32

Lot 3

Lot 4
Sage
Brush

31

Grain
CURRANT
Sage Brush and Junipers

37

Lot 1

Dry Orchard

Spring Pump

CREEK

Reservoir

Lot 2

Lot 3


4
Sage

Brush

Lot 4

Prineville Land & Livestock
James Scott (Supt)

TOWNSHIP 8 S. RANGE 19 E.

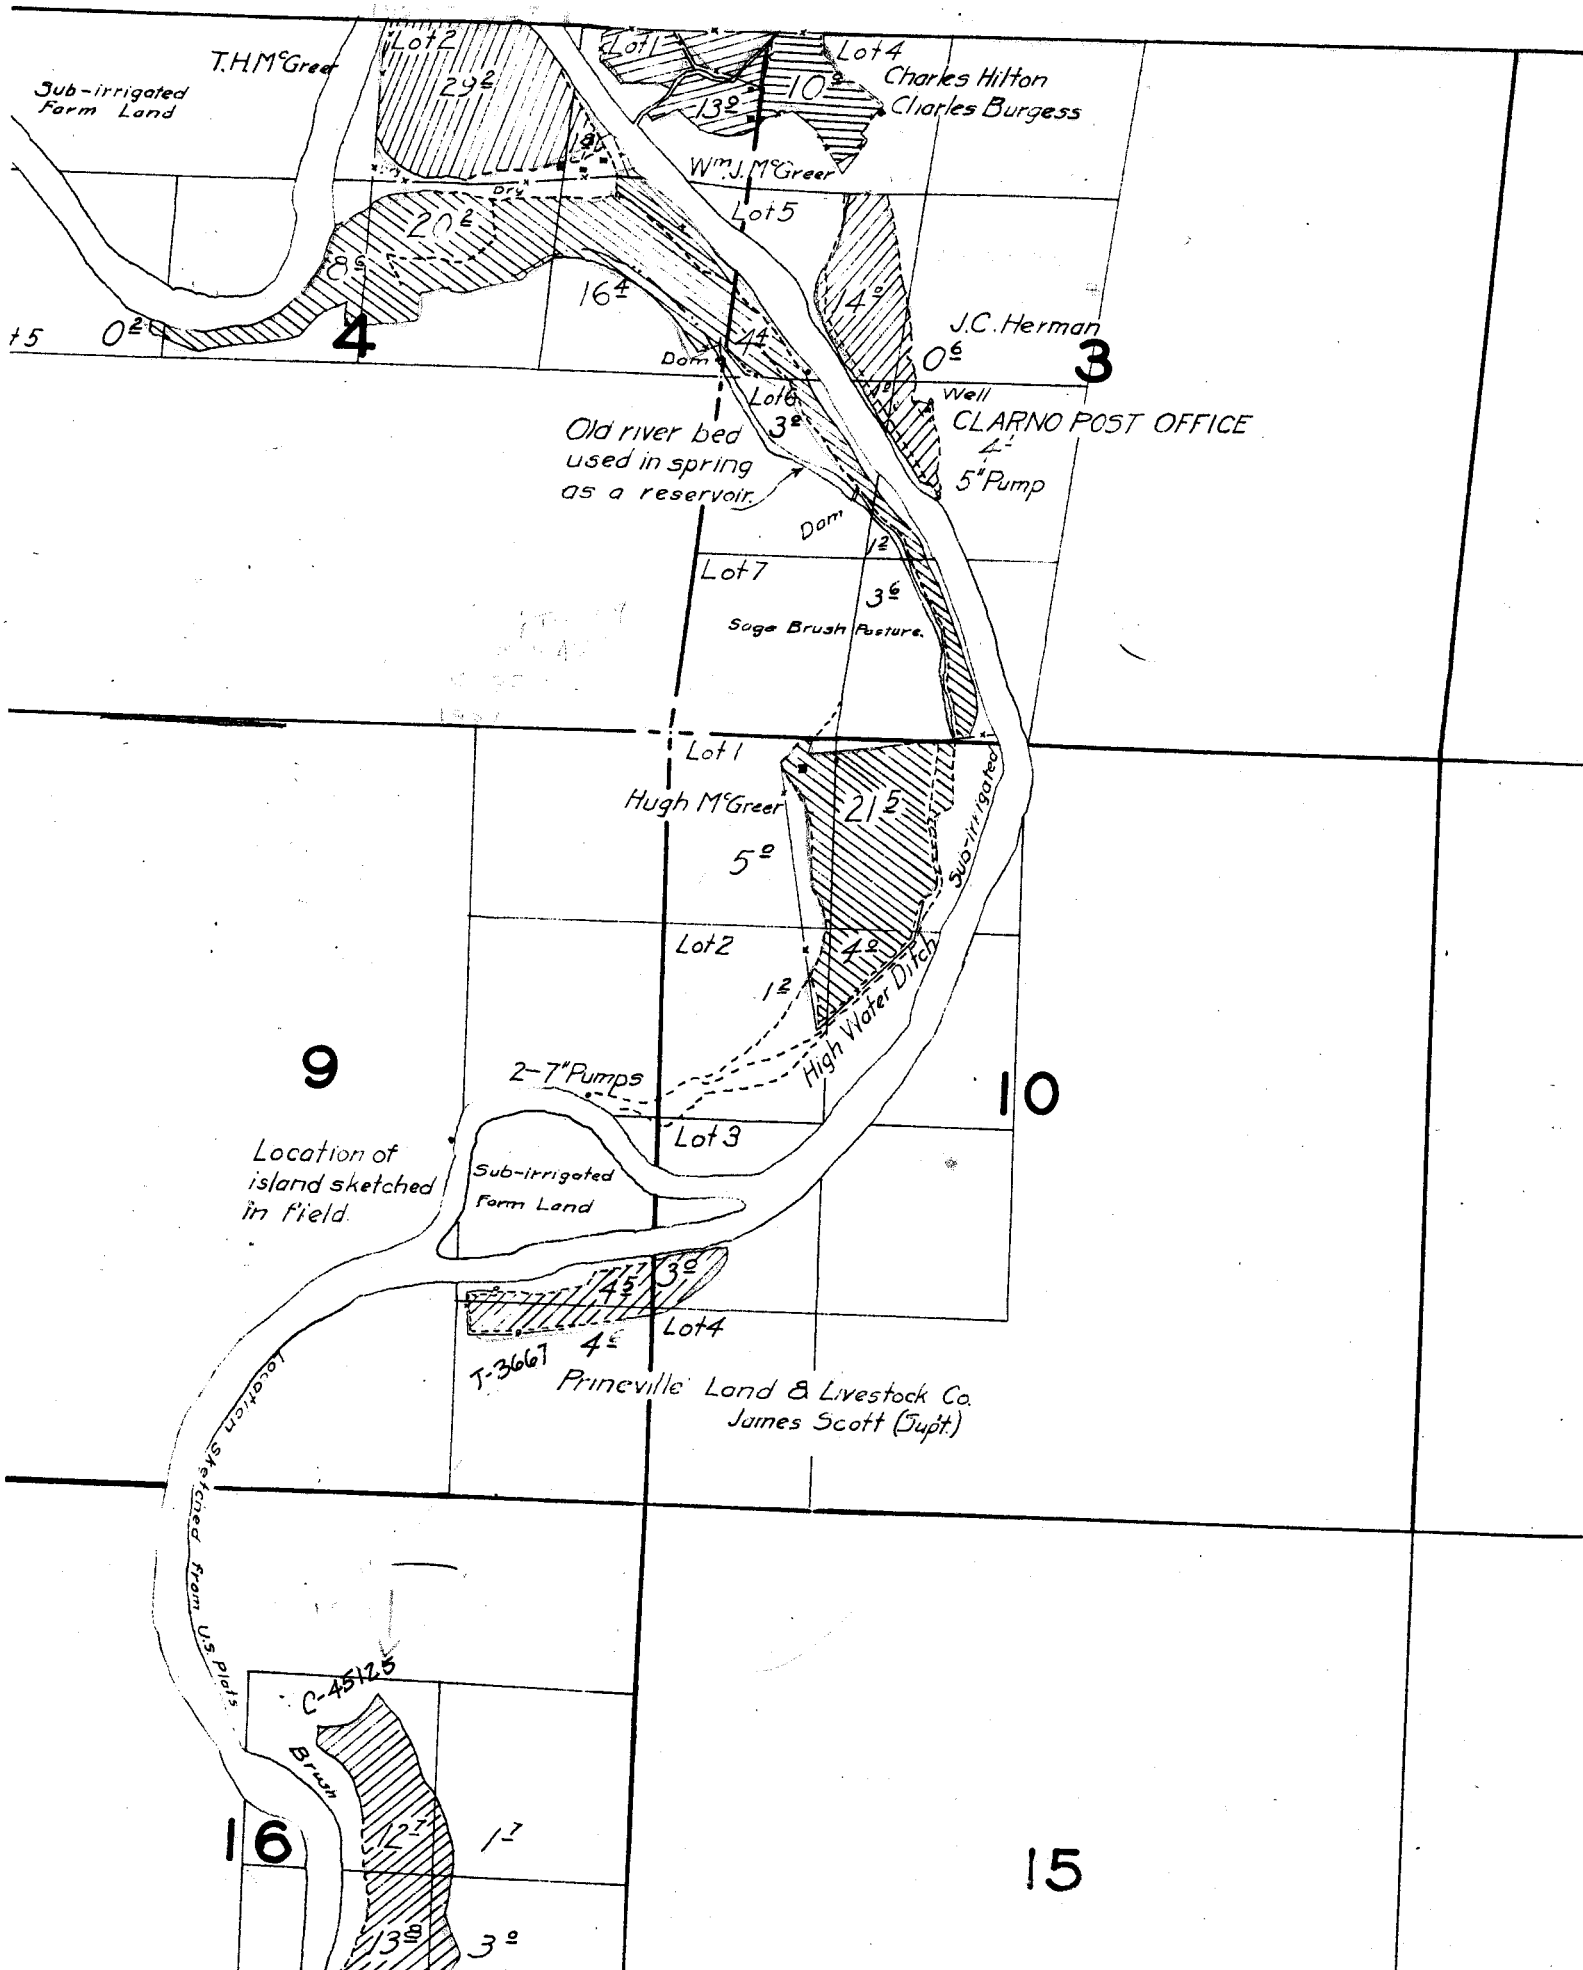

29

28

27

32

33

34

506^e Pineville Land & Livestock Co
James Scott (Supt)

Brush



Sage Brush
Muddy
Rim
Rock
and Junipers
CREEK

9^e

04

32

Fume

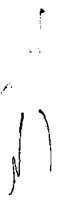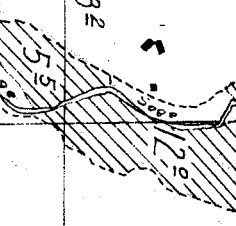

17

16


15


20

21

22

Surveyed Aug. 16, 17, 18, 19, & 20, 1921

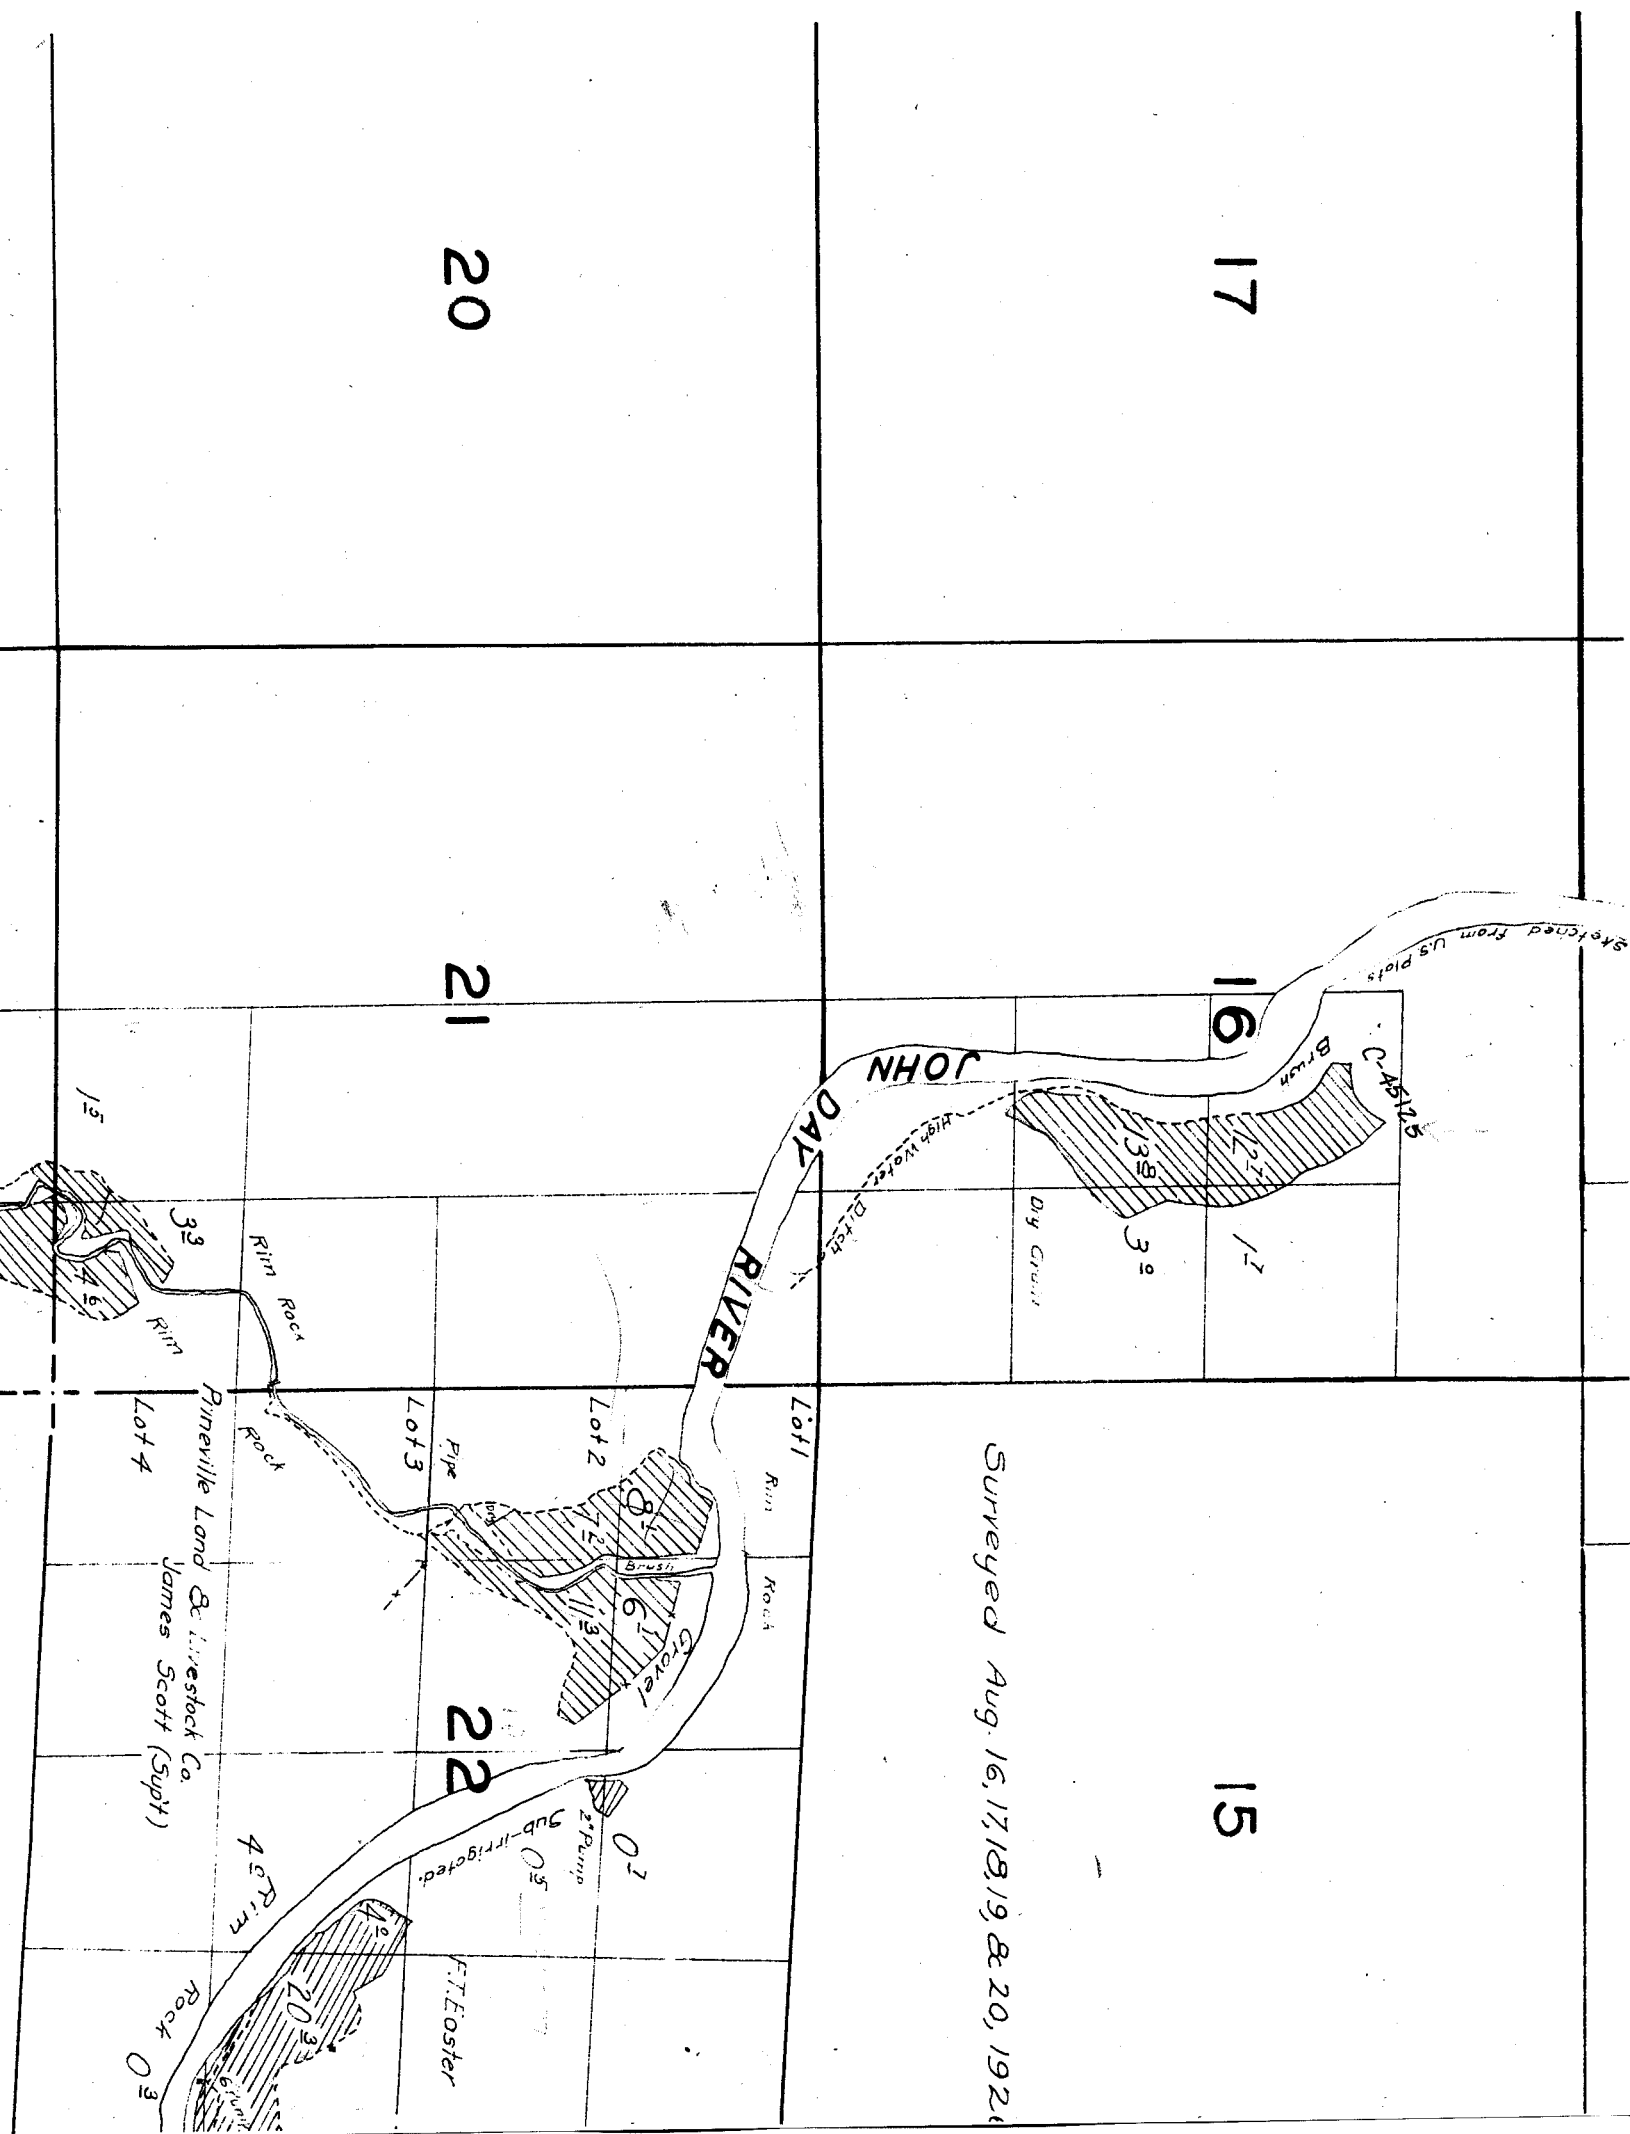

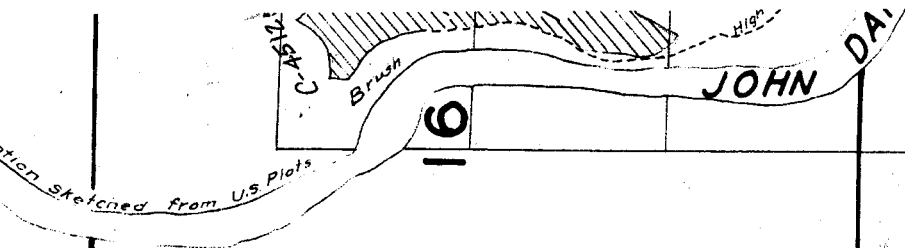

21

17

20

18

19