

21


22

28

27

33

34

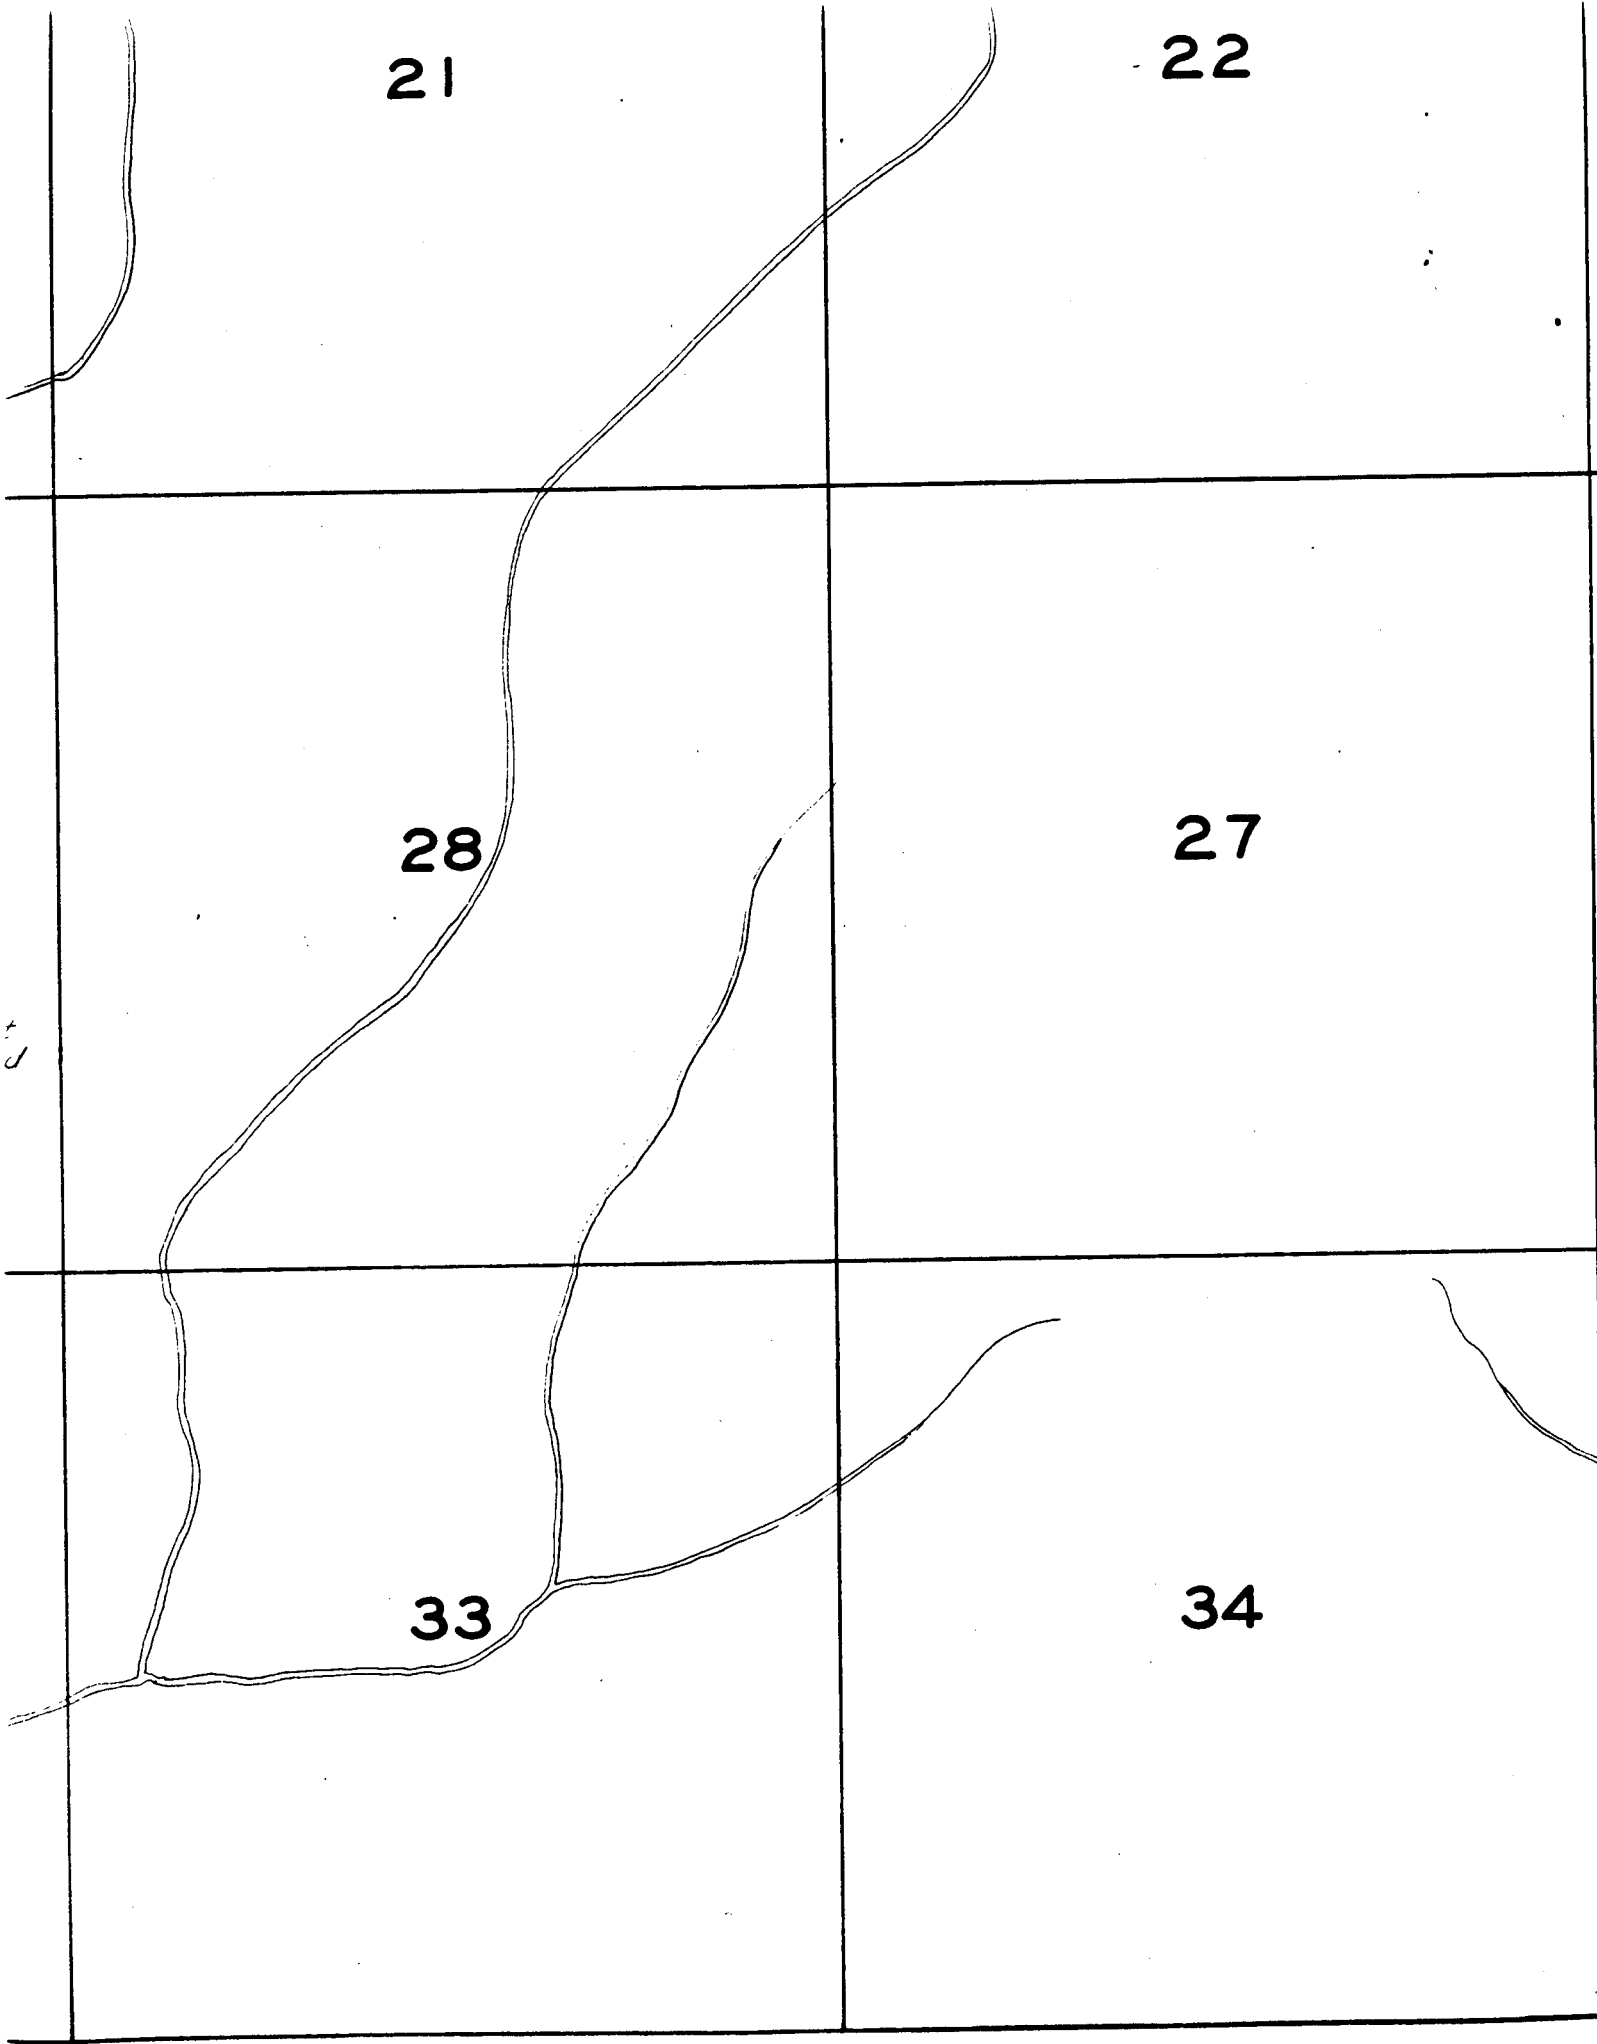

6

5

7

8

18

17

2

1

11

12

14

13

16

15

22


TOWNSHIP 7 S. RANGE 24E.

4

3

9

10

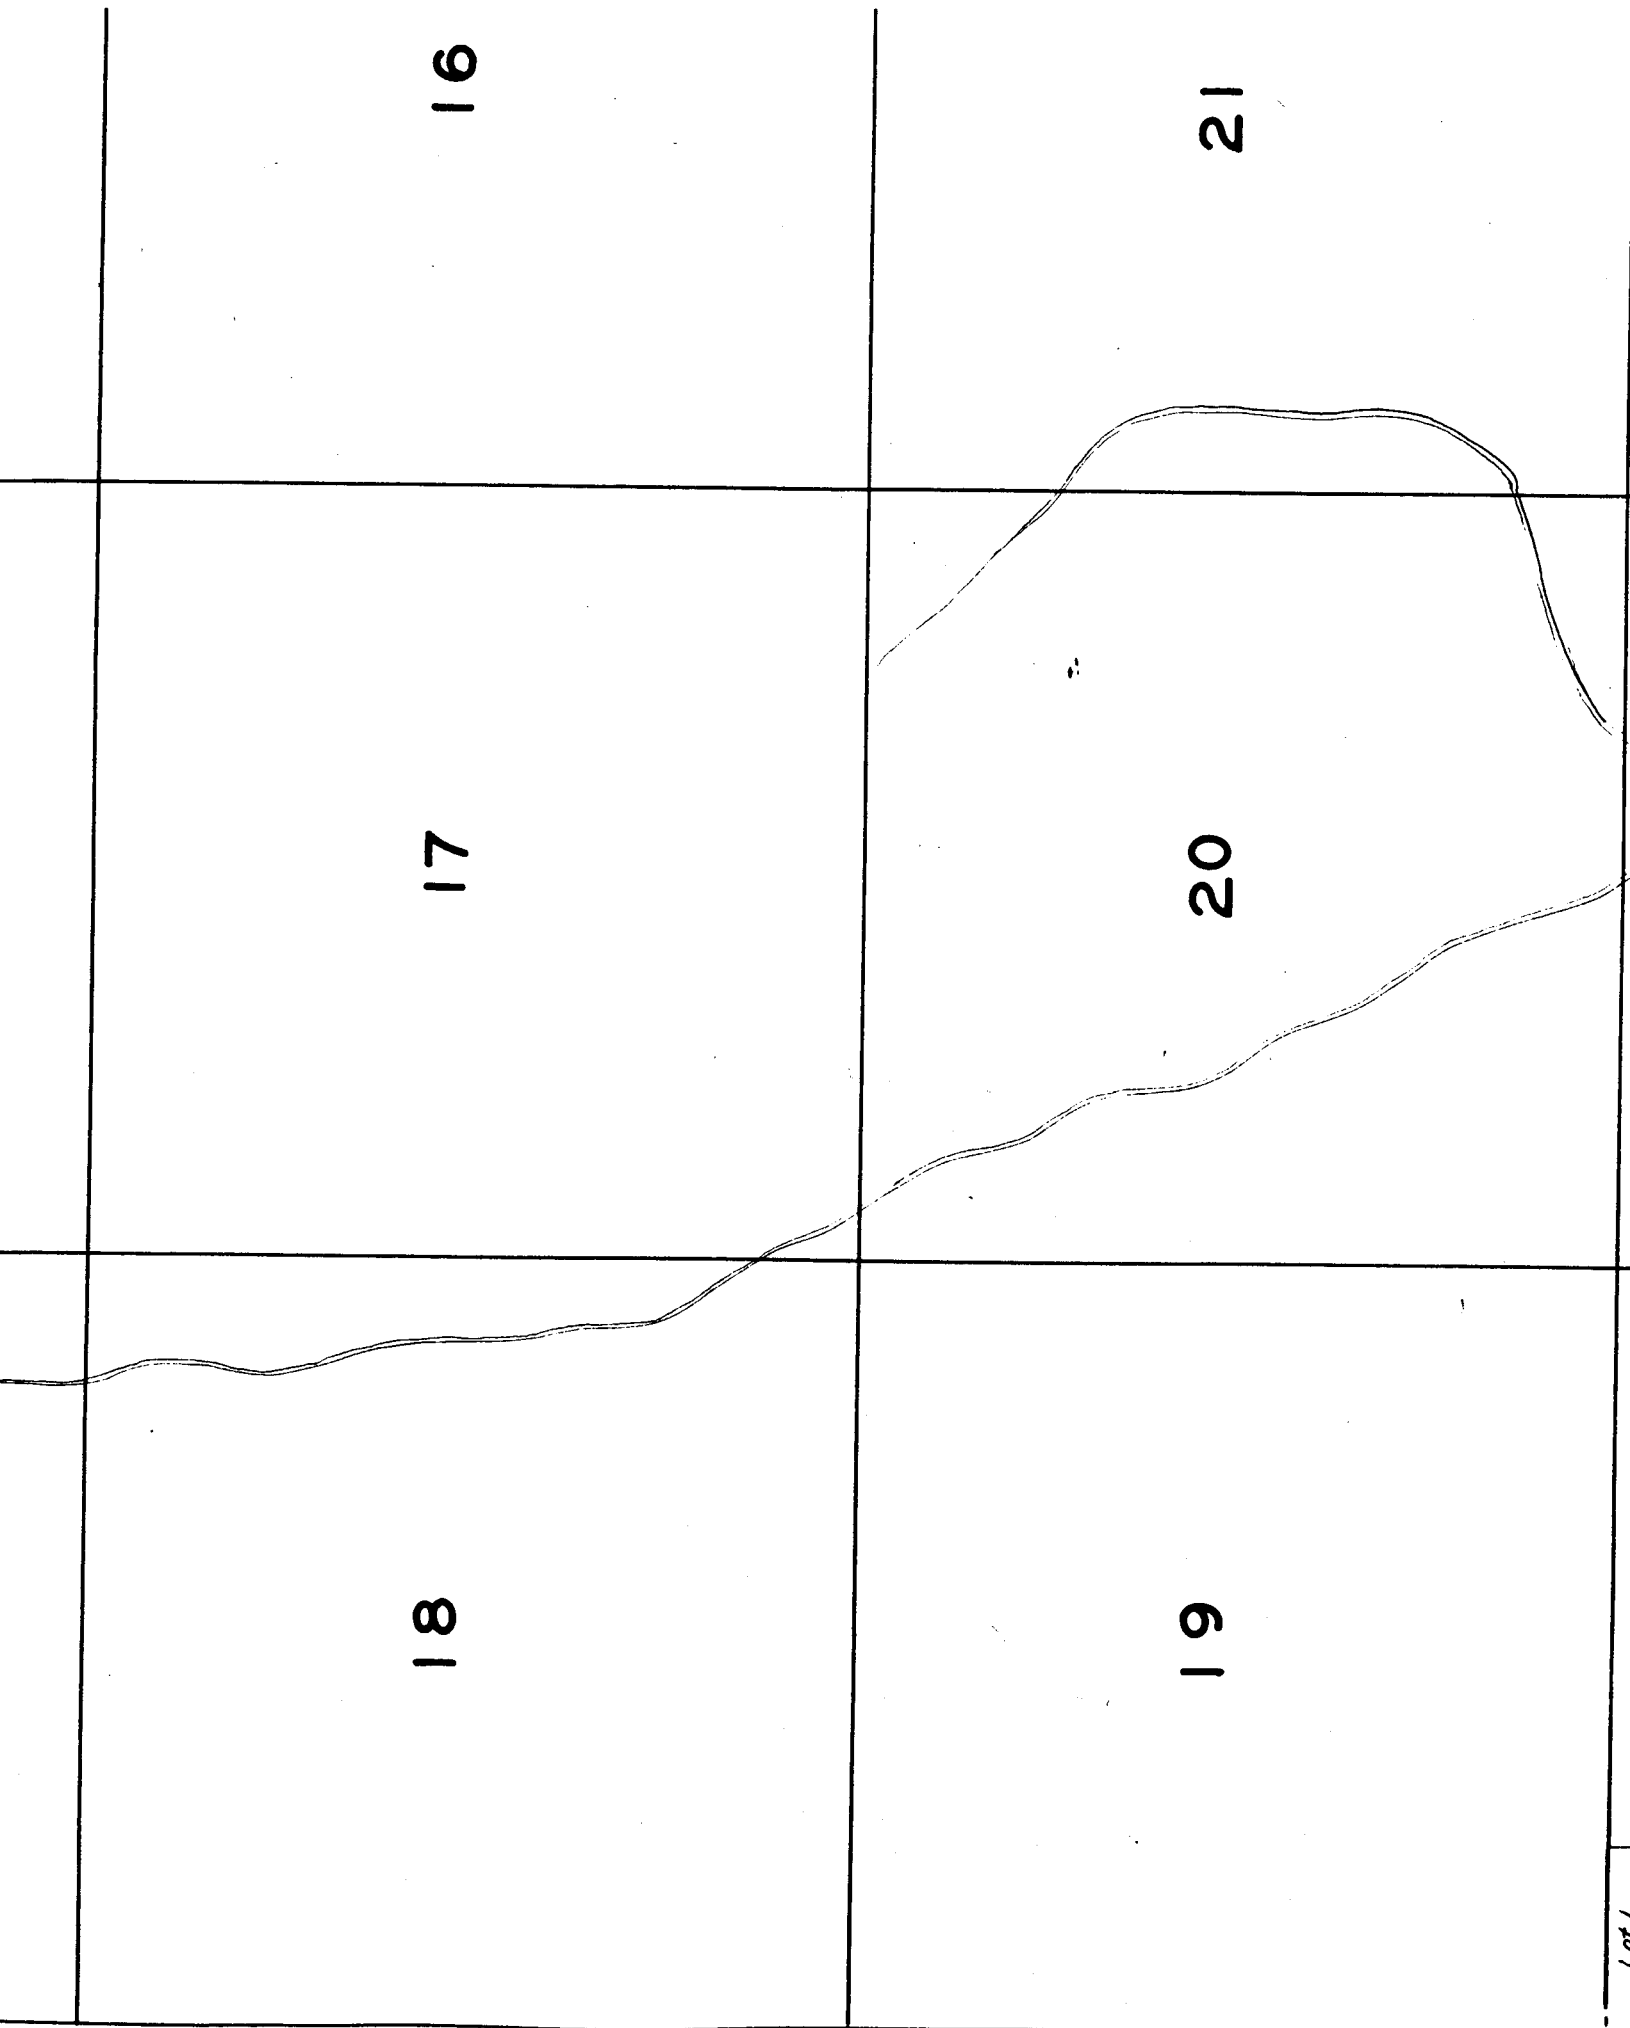

Lot 1.

Surveyed October 20, 1925.

Lot 2.

N S. Nelson

1/5

Spring

1/3

Saw Mill

Lot 3.

30

28

29

Note: Location of streams and roads, except in the vicinity of irrigated land, sketched in approximate location.

Surveyed October 16 and 17, 1925.

31

Elmer M's Quinn

Art. Ahin

8'

1/3

32

H A Warrington

Weir

23'

03

Ed. Boush

1/4

152

33

Baye

27

26



25

34

35

36

*Zachary Spring piped to
house for domestic
use.*

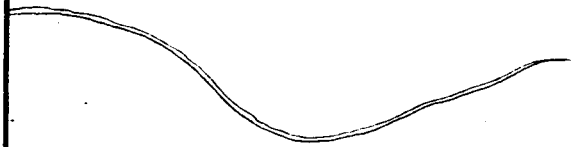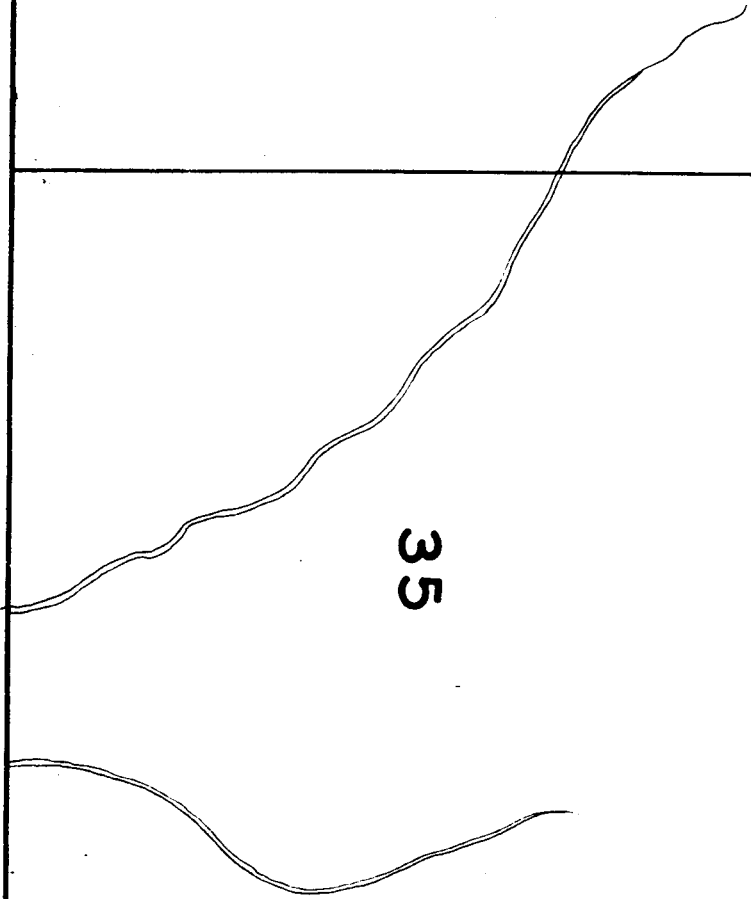

15

14

13

22

23

24