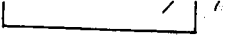


TOWNSHIP 8 S., RANGE 24 E.

	4	3	 <i>Surveyed.</i>
1925.	9	10	

30

15

22

16

21


15

14

13

22

23

24

A.S. Borges

Amos Hawks


4⁺

15⁹

2^o

2⁺

5²

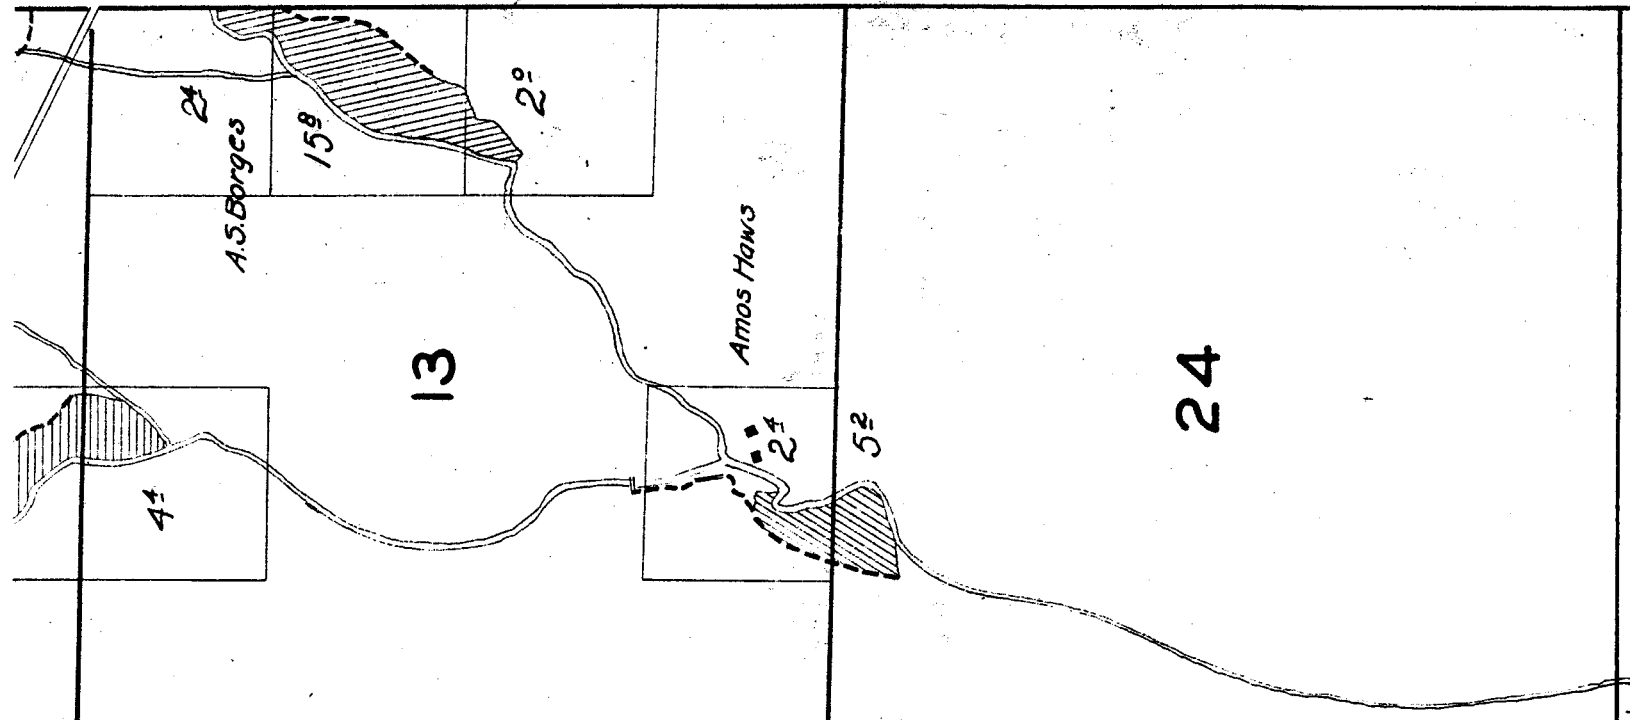

27

1 Sept. 24 and 30, 1925.

26

25

CREEK

HATLER

Frank Wright
28
25

F.R. Davenport

Avery Showr

SPRAY

























35

34

36

CREEK

RIVER

JOHN DAY

Avery Showr












J.F. Asher

Sam Johnson

City

Warren Davenport

CC + Lou Morris

Note: Streams and Rivers except in the vicinity of irrigated land, sketched in approximate location.

30

29



28

MATHIS
31

32

33

Surveyed Oct 29, 1925

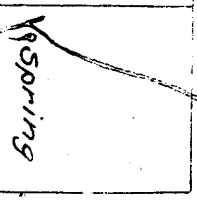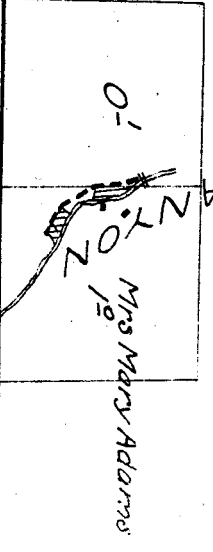

Baugh.

18

17

16

19

20

21

Elmer McQuinn

Lot 4.


20'

3'

6

5

CREEK

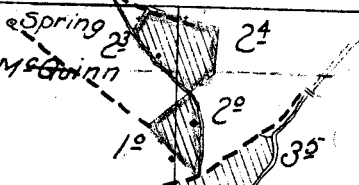

Mrs. Elmer McQuinn

Lot 1.

83' ALDER 1'

Surveyed October 16, 1925.

Lot 2.

01'

7

8

09'

Lot 3.


Lot 4.

73'

49'

18

17

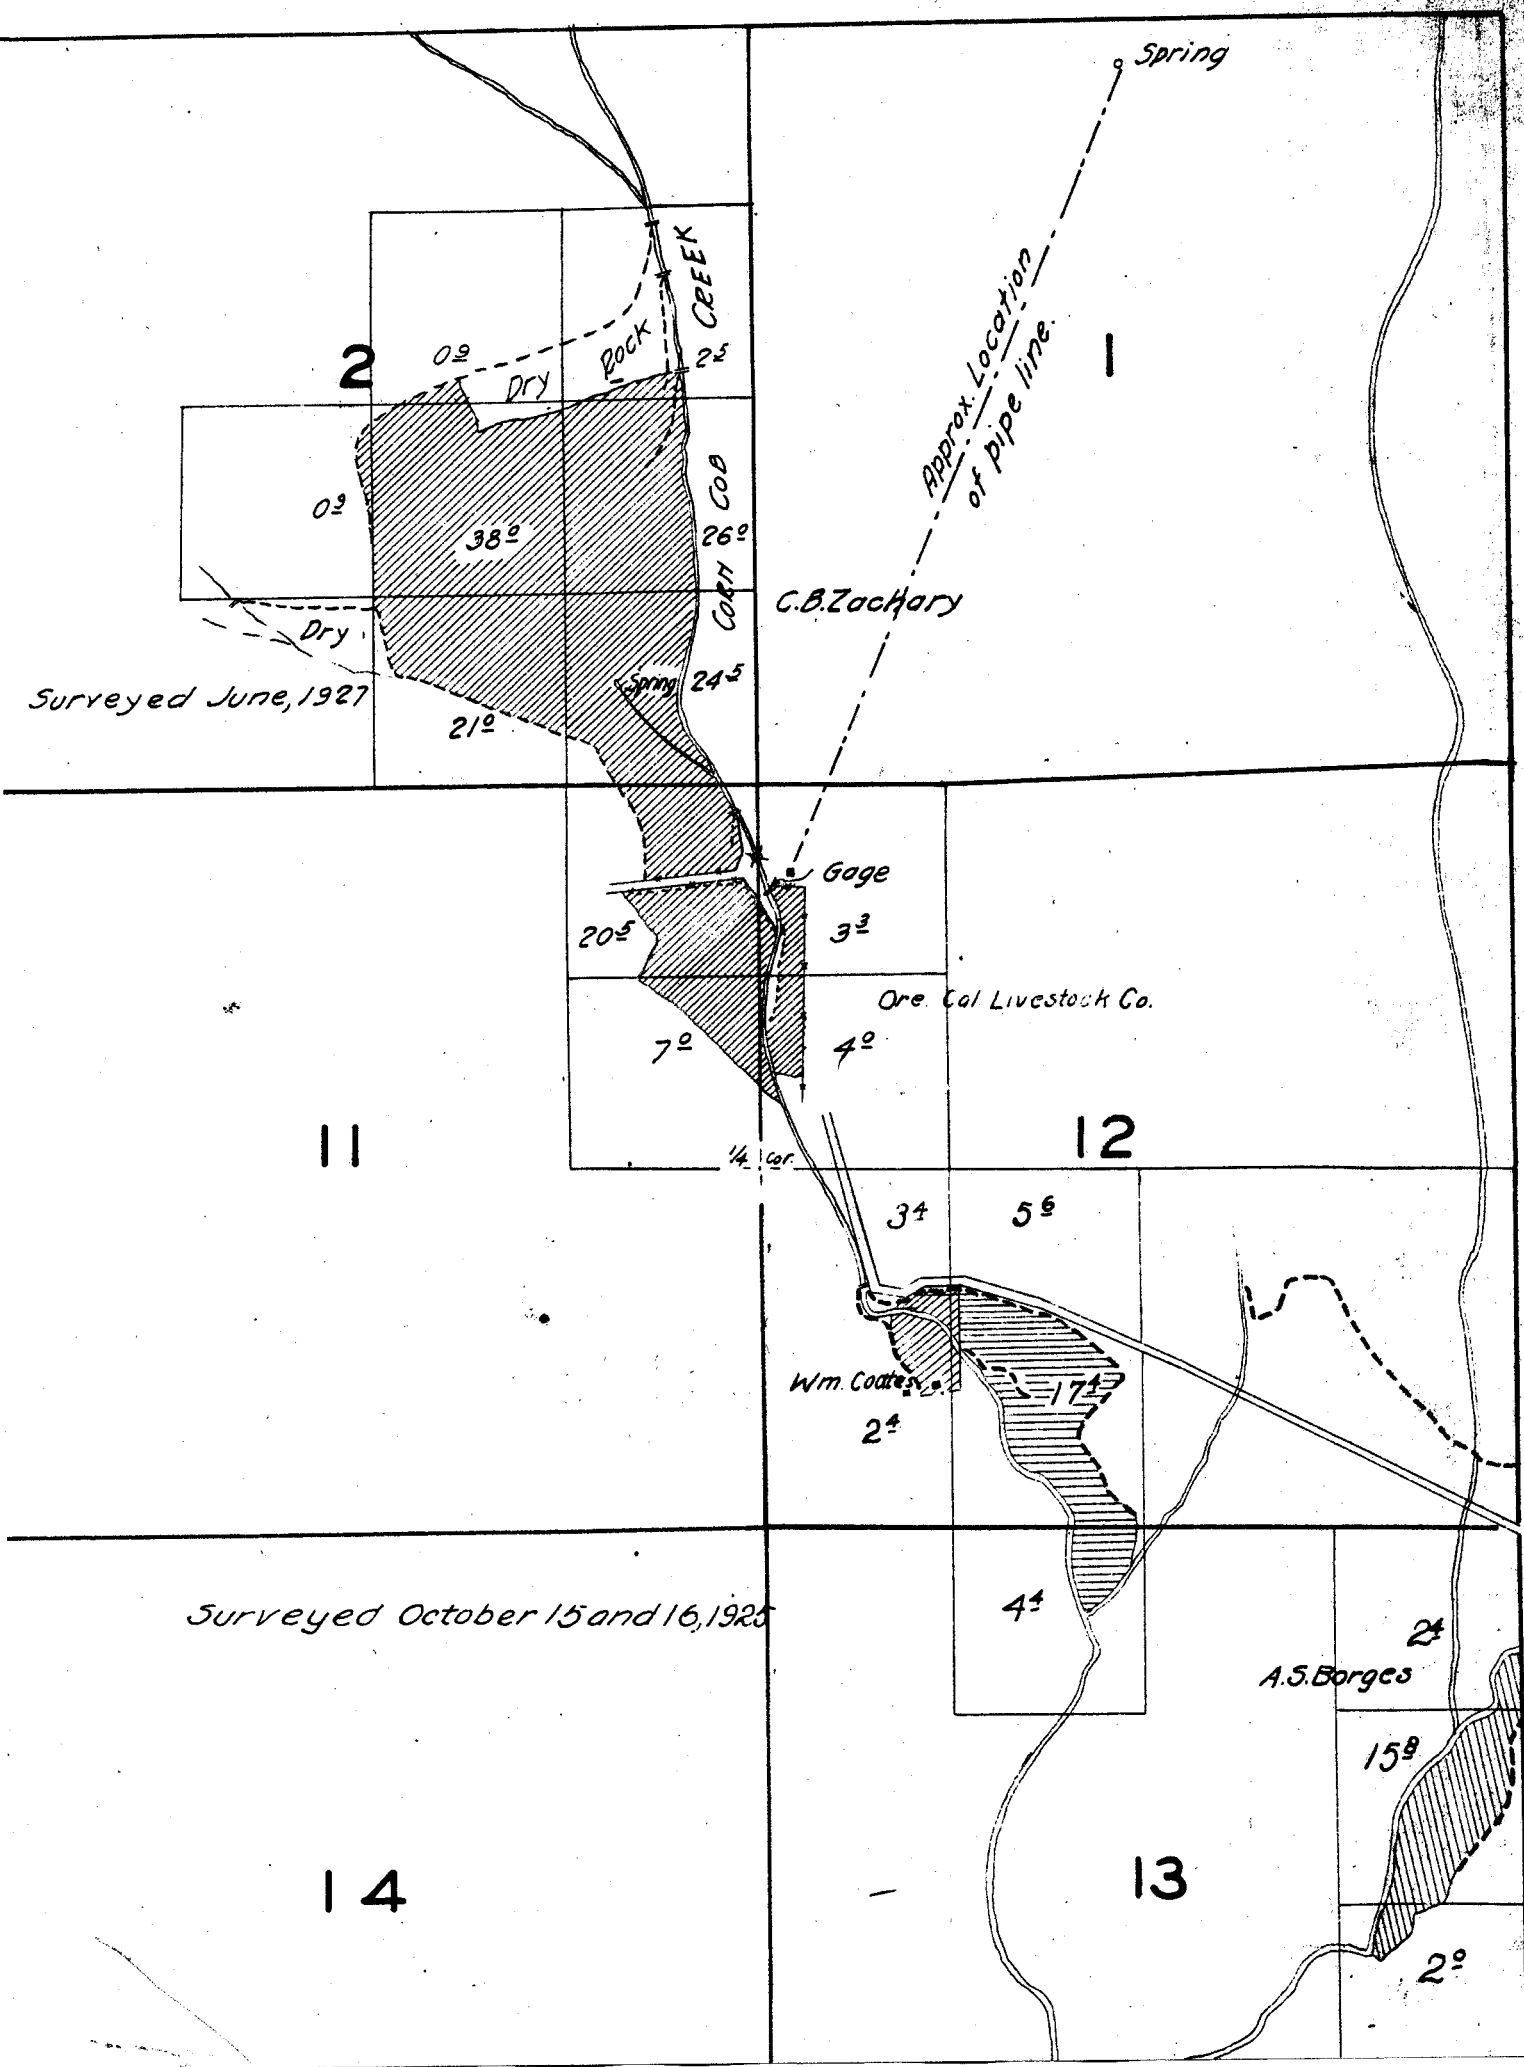

21

22

28

27

Surveyed Sept. 24 and 30, 1925.

33

34

Baughn

0³

6²

pump

Snable

JOHN DAY RIVER

