

TOWNSHIP 7 S.. RANGE 18 E.

4

3

9

10

16

15

18

17

16

19

20

21

TOWNSH-

6

5

4


7

8

9

23

24

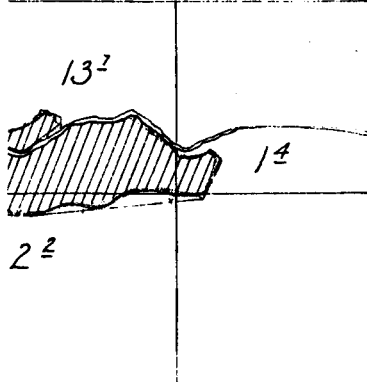

SOREFOOT

CREEK

Location Sketched from U.S. Plats.

Surveyed Aug. 24, 1926.

26

25

35

36

19

20

30

29

31

32

15

14

13

22

23

24

Springs

52

55

47

03

22

132

14

SOREFOOT

CREEK
location Sketch from U.S. Plats.

JGE 18 E.

29-2-1

3	2	1
10	11	12

15

16

22

21

Spring

13²


4²

5²


5²

2²

0³

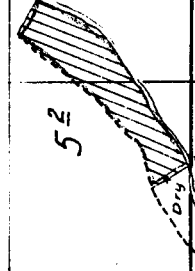

Surveyed

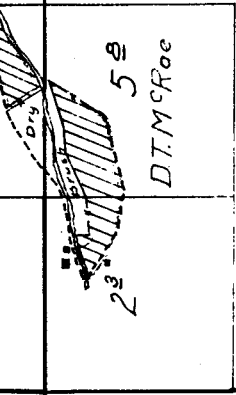

27

34

28

33