


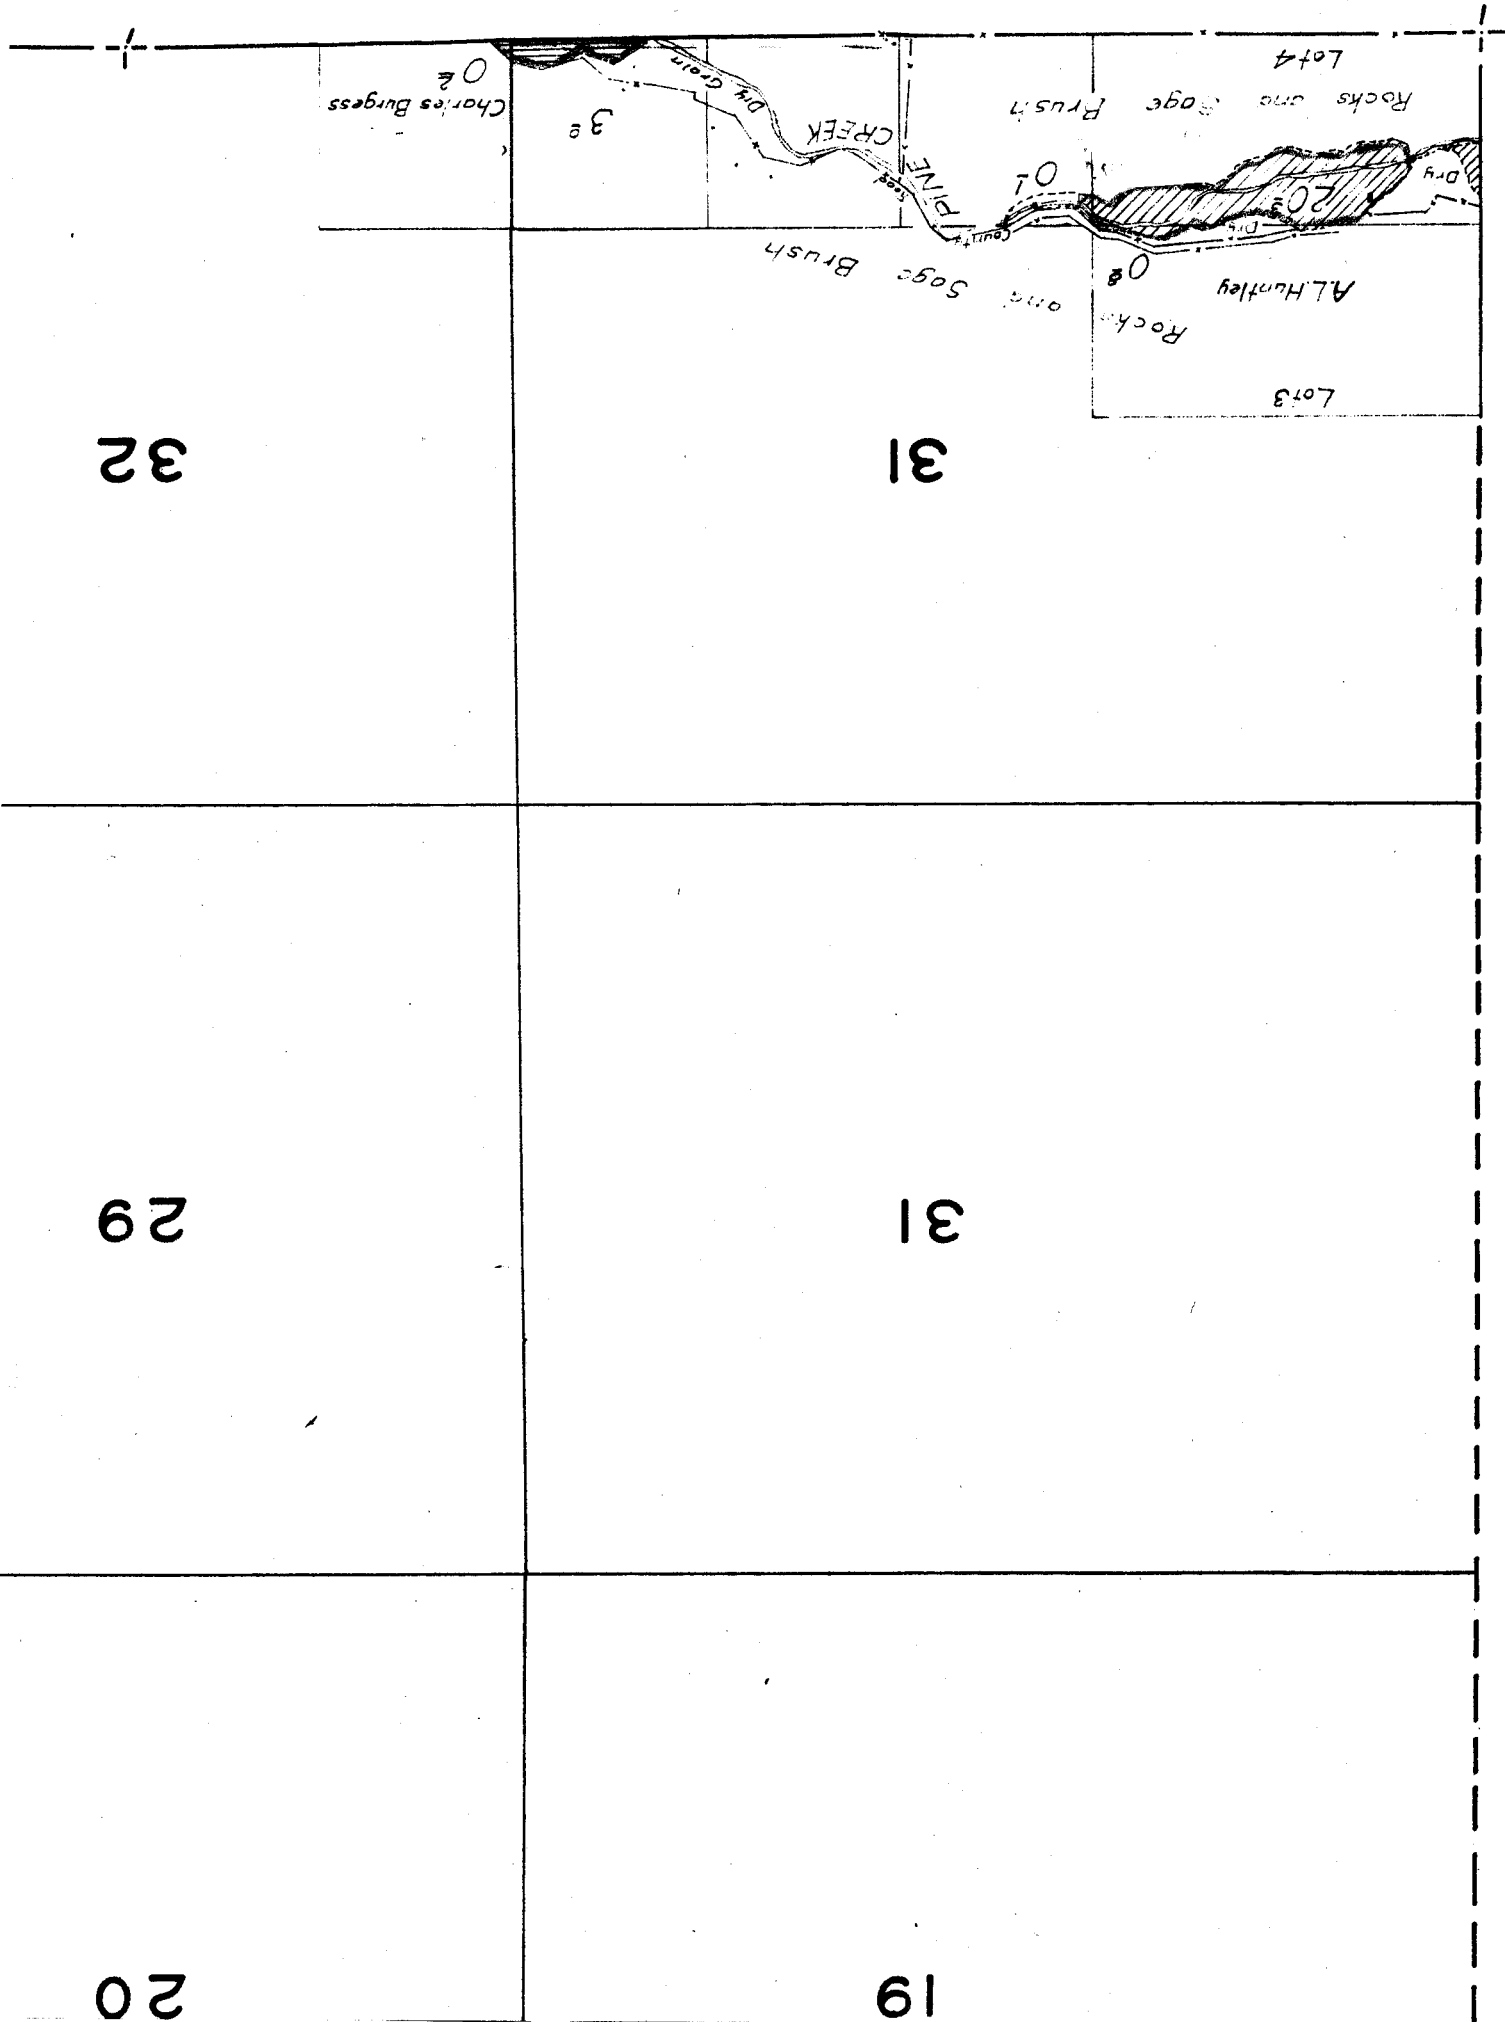

23

24

26

25

35

36

Wm. Metteer
OZ

Flume
LONE PINE CREEK
County Road

Rim
Rocks

F.E. Metteer

40

PINE

TOWNSHIP 7 S. RANGE 20 E.

4

3

9

10

16

15

18

17

19

20

TOWN

6

5

7

8

15

14

13

22

23

24

3	2	1
10	11	12

28


27

33

34

Surveyed Aug. 12 to 14, 1926.

TO

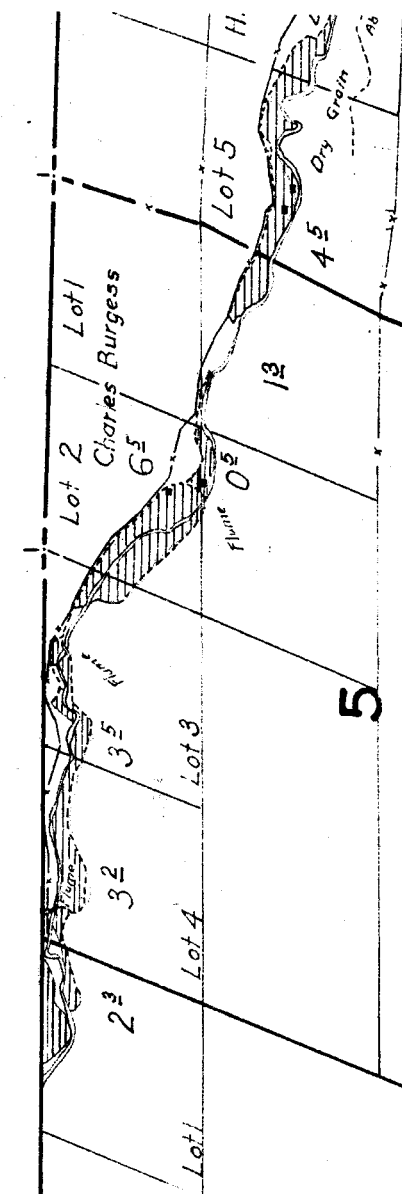

Surveyed Aug. 12:

6

5

7

8

9



17

00

—
2

20

၈

23

24

26

25

35

36

Aug. 12 to 14, 1926.

Note: Bearings of section lines taken from U.S. Township Plats.

NOTE: Stream in the vicinity of in approximate

*Note: Bearings of section lines
taken from U.S. Township Plats.*

NOTE: Stream
the vicinity of
in approximate

19

20

30

29


31

32

JOHN
DAY
RIVER

RANGE 20 E.

43-2-1

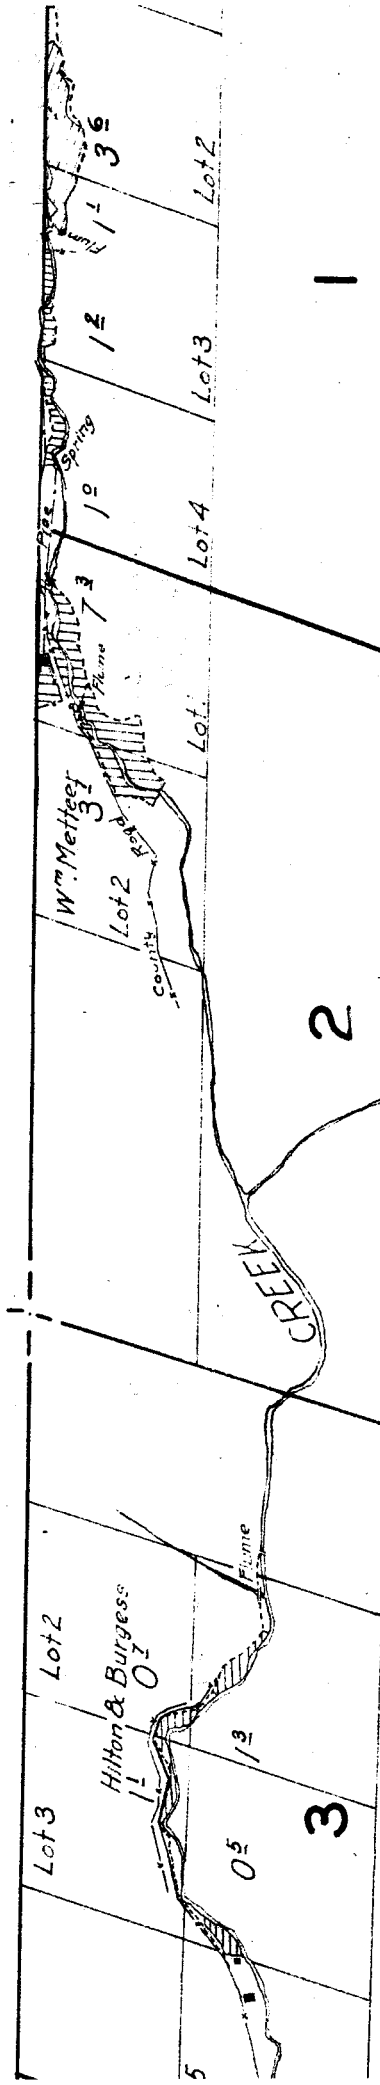

earings of section lines
on U.S. Township Plats.

10

11

12

15

14

*NOTE: Streams and river, except in
the vicinity of irrigated land sketched
in approximate location.*

13

22

23

24

29

28

27

32

33

34

17

16

15

20

21

22

28

27

33

34

Surveyed Aug. 12 to 14, 1926.