


TOWNSHIP 8 S., RANGE 25 E.

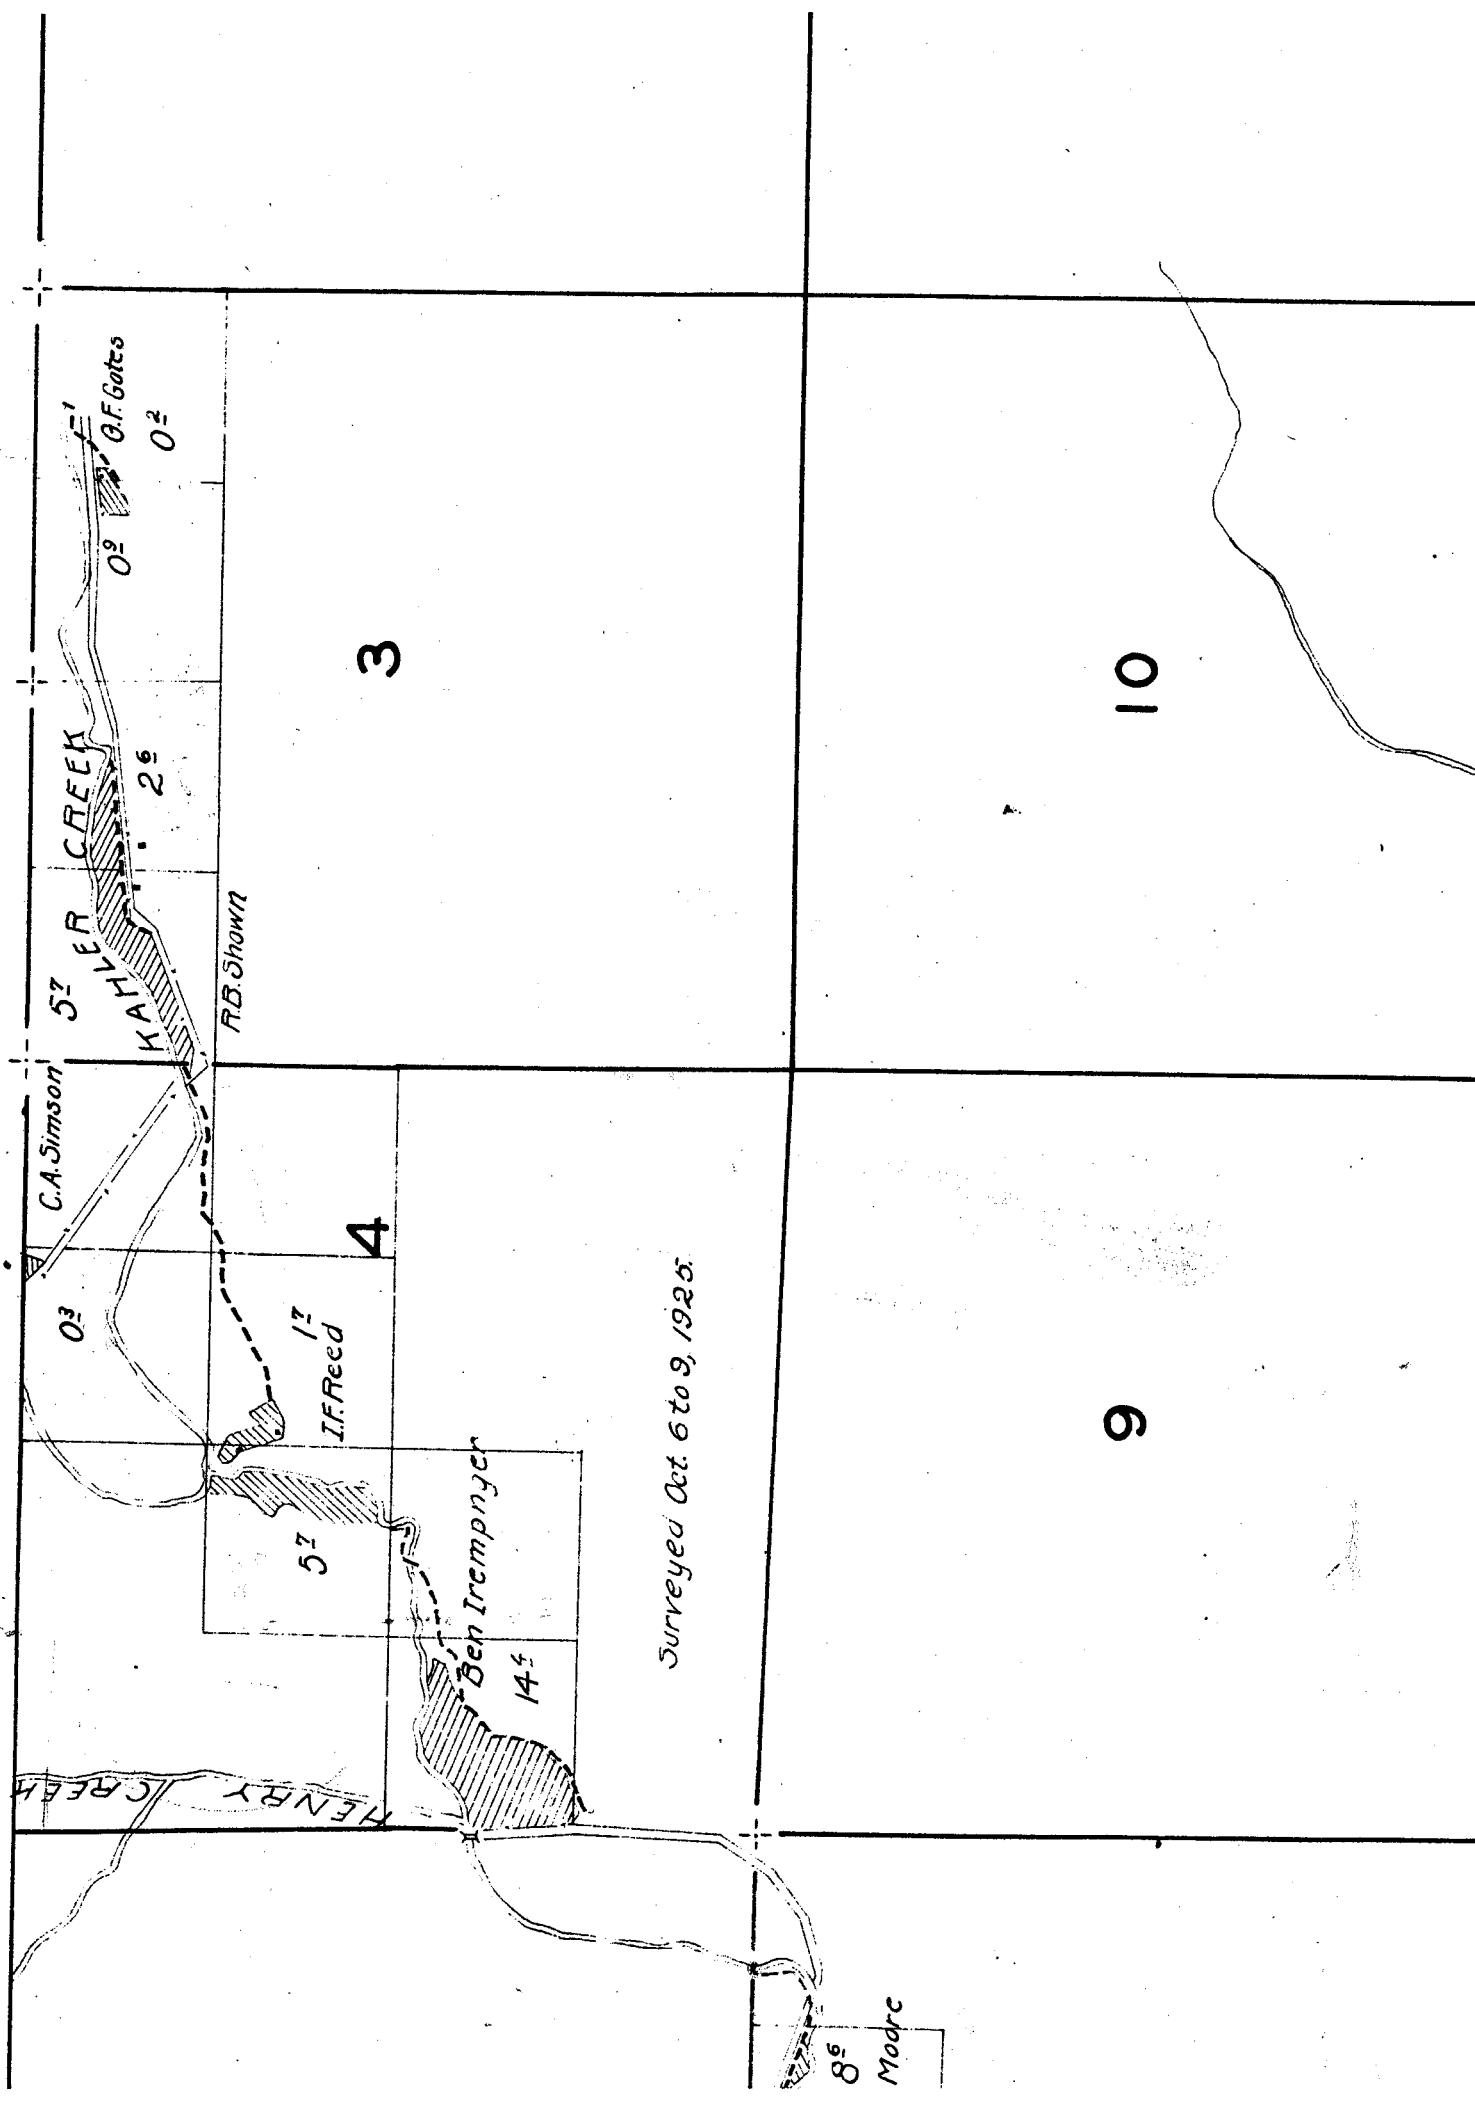


15

22

16

21

L.H. Donovan

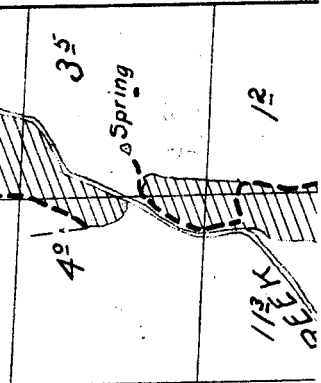

As, except
nd, is
ation.

6

5

7

13

03

8

buge 8⁶

E. R. Moore

07

4⁹

A. S. Borges

18

17

Surveyed Sept. 29, 1925.

Palm Cr.

27

26

25

34

35

36

15

14

13

22

23

24

IVES CREEK

02

62

RI Corner

17

05



30

29

28

31


32


33

Surveyed Sept. 29, 1925

Surveyed Se

First National Bank
London
Oct. 03

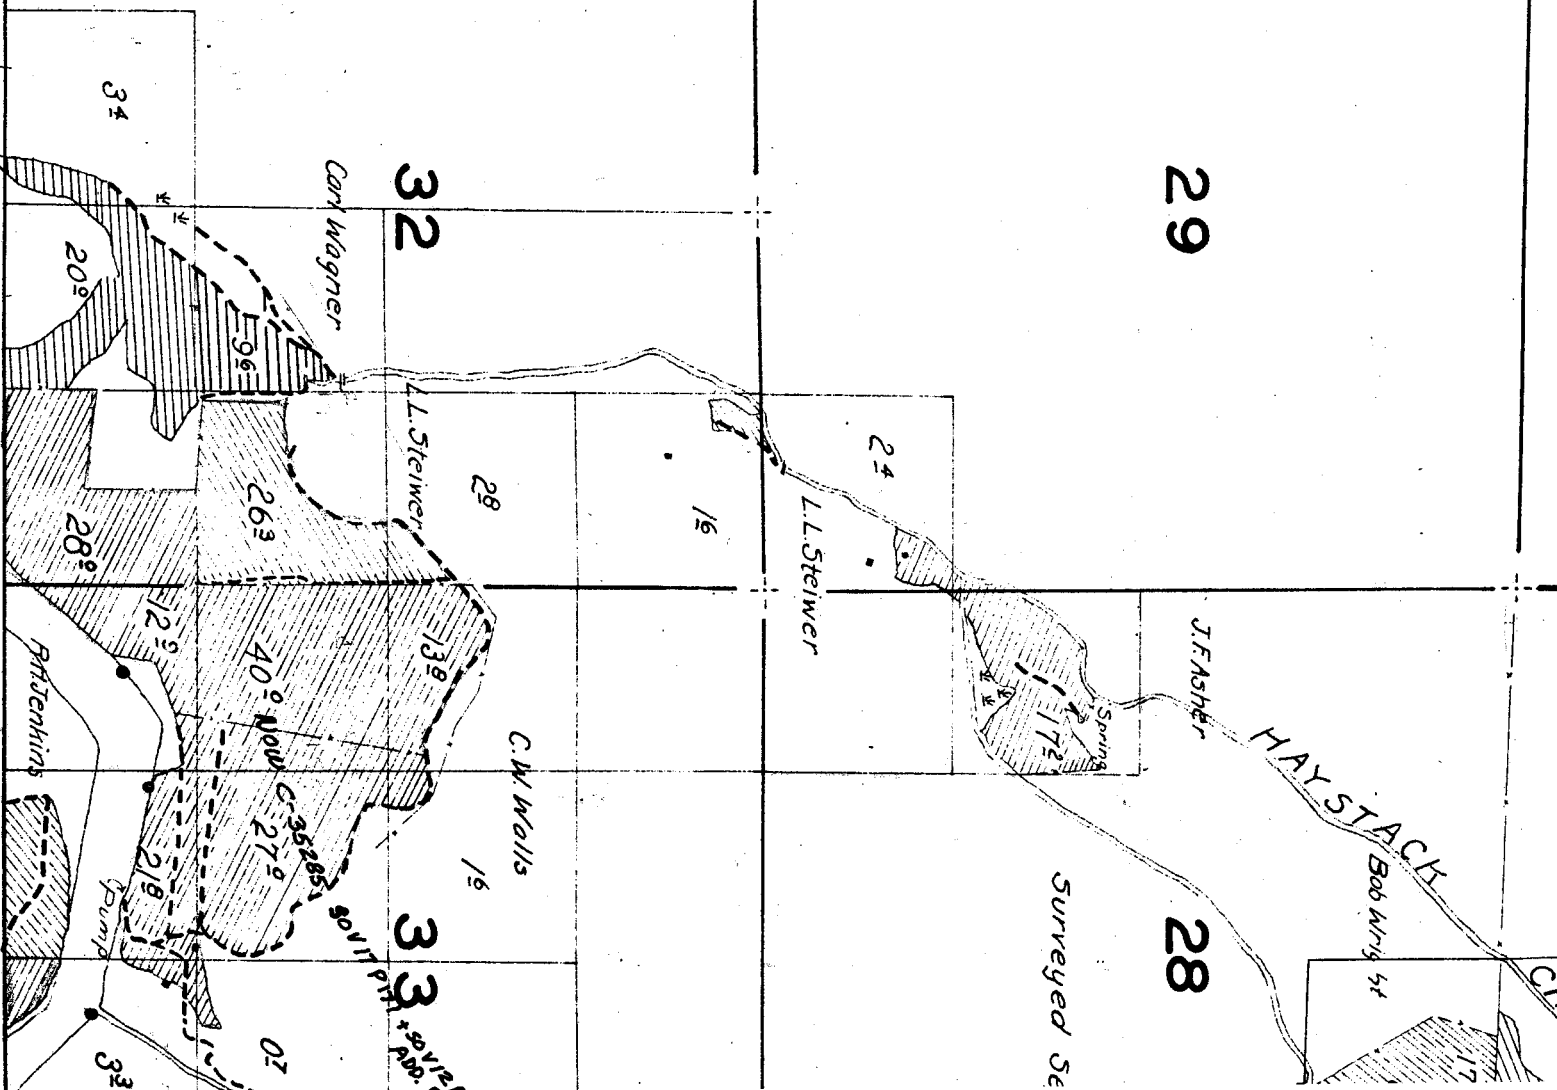

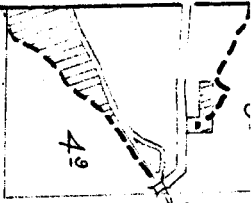

A.S. Borges

49

18

17


16

19

20

21

Note: Location of streams and roads, except in the vicinity of irrigated land, is sketched in approximate location.

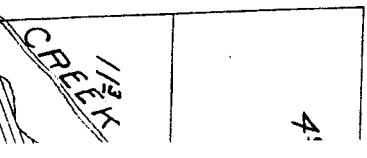

41

113 K
CREEK

21

22

4°

35°

Spring

L.H. Donavon

112
CREEK

12

175

45°

HAYSTACK

Bob Wrig. St

J.F. Asher

28

27

Spring

175

Surveyed Sept. 19 to 23, 1926

Steiner

5°

C.W. Walls

16

A.E. Cress

12

33

34

138

40°

Now C-35285

27°

02

12°

218

Pump

32

B.H. Jenkins

2

1

11

12

14

13