

19E.

18-2-1

3	2	1
10	11	12

15

14

13

22

23

24

18

17


16

19


20

21

Note: Streams, except in the vicinity of irrigated land, are sketched in the approximate location.

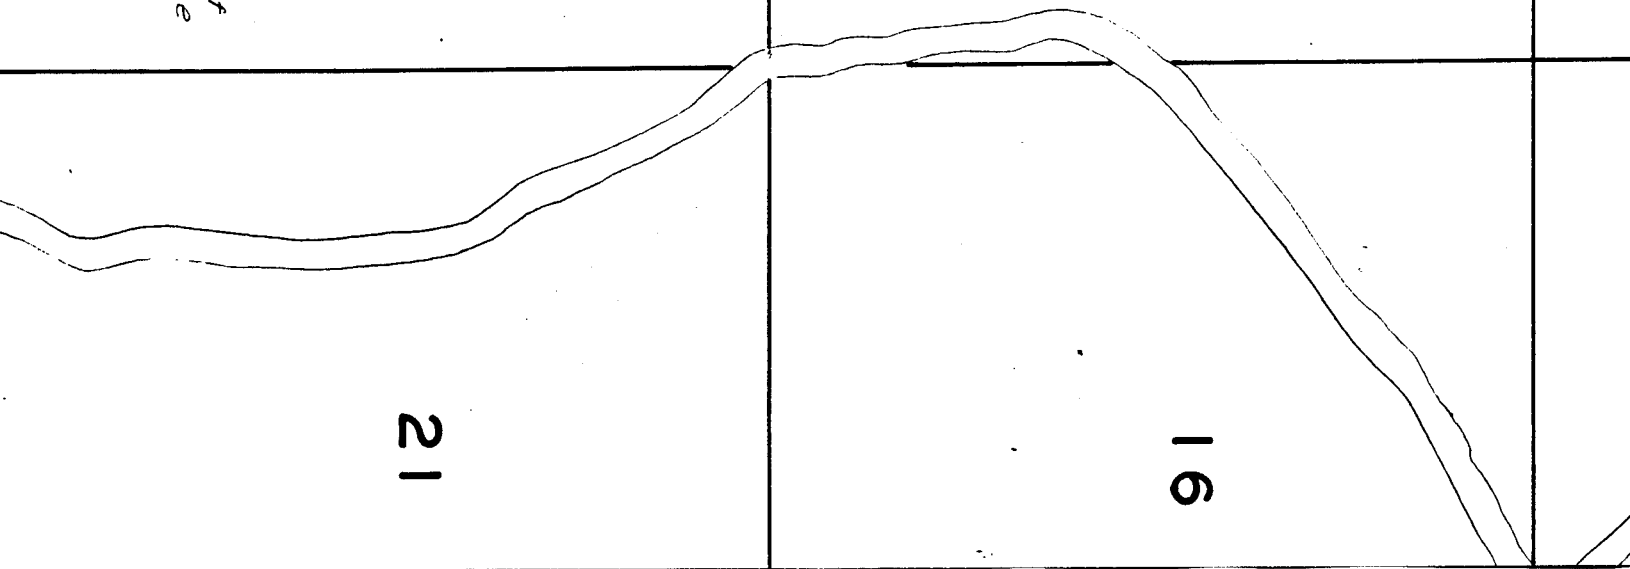

TOWNSHIP 1

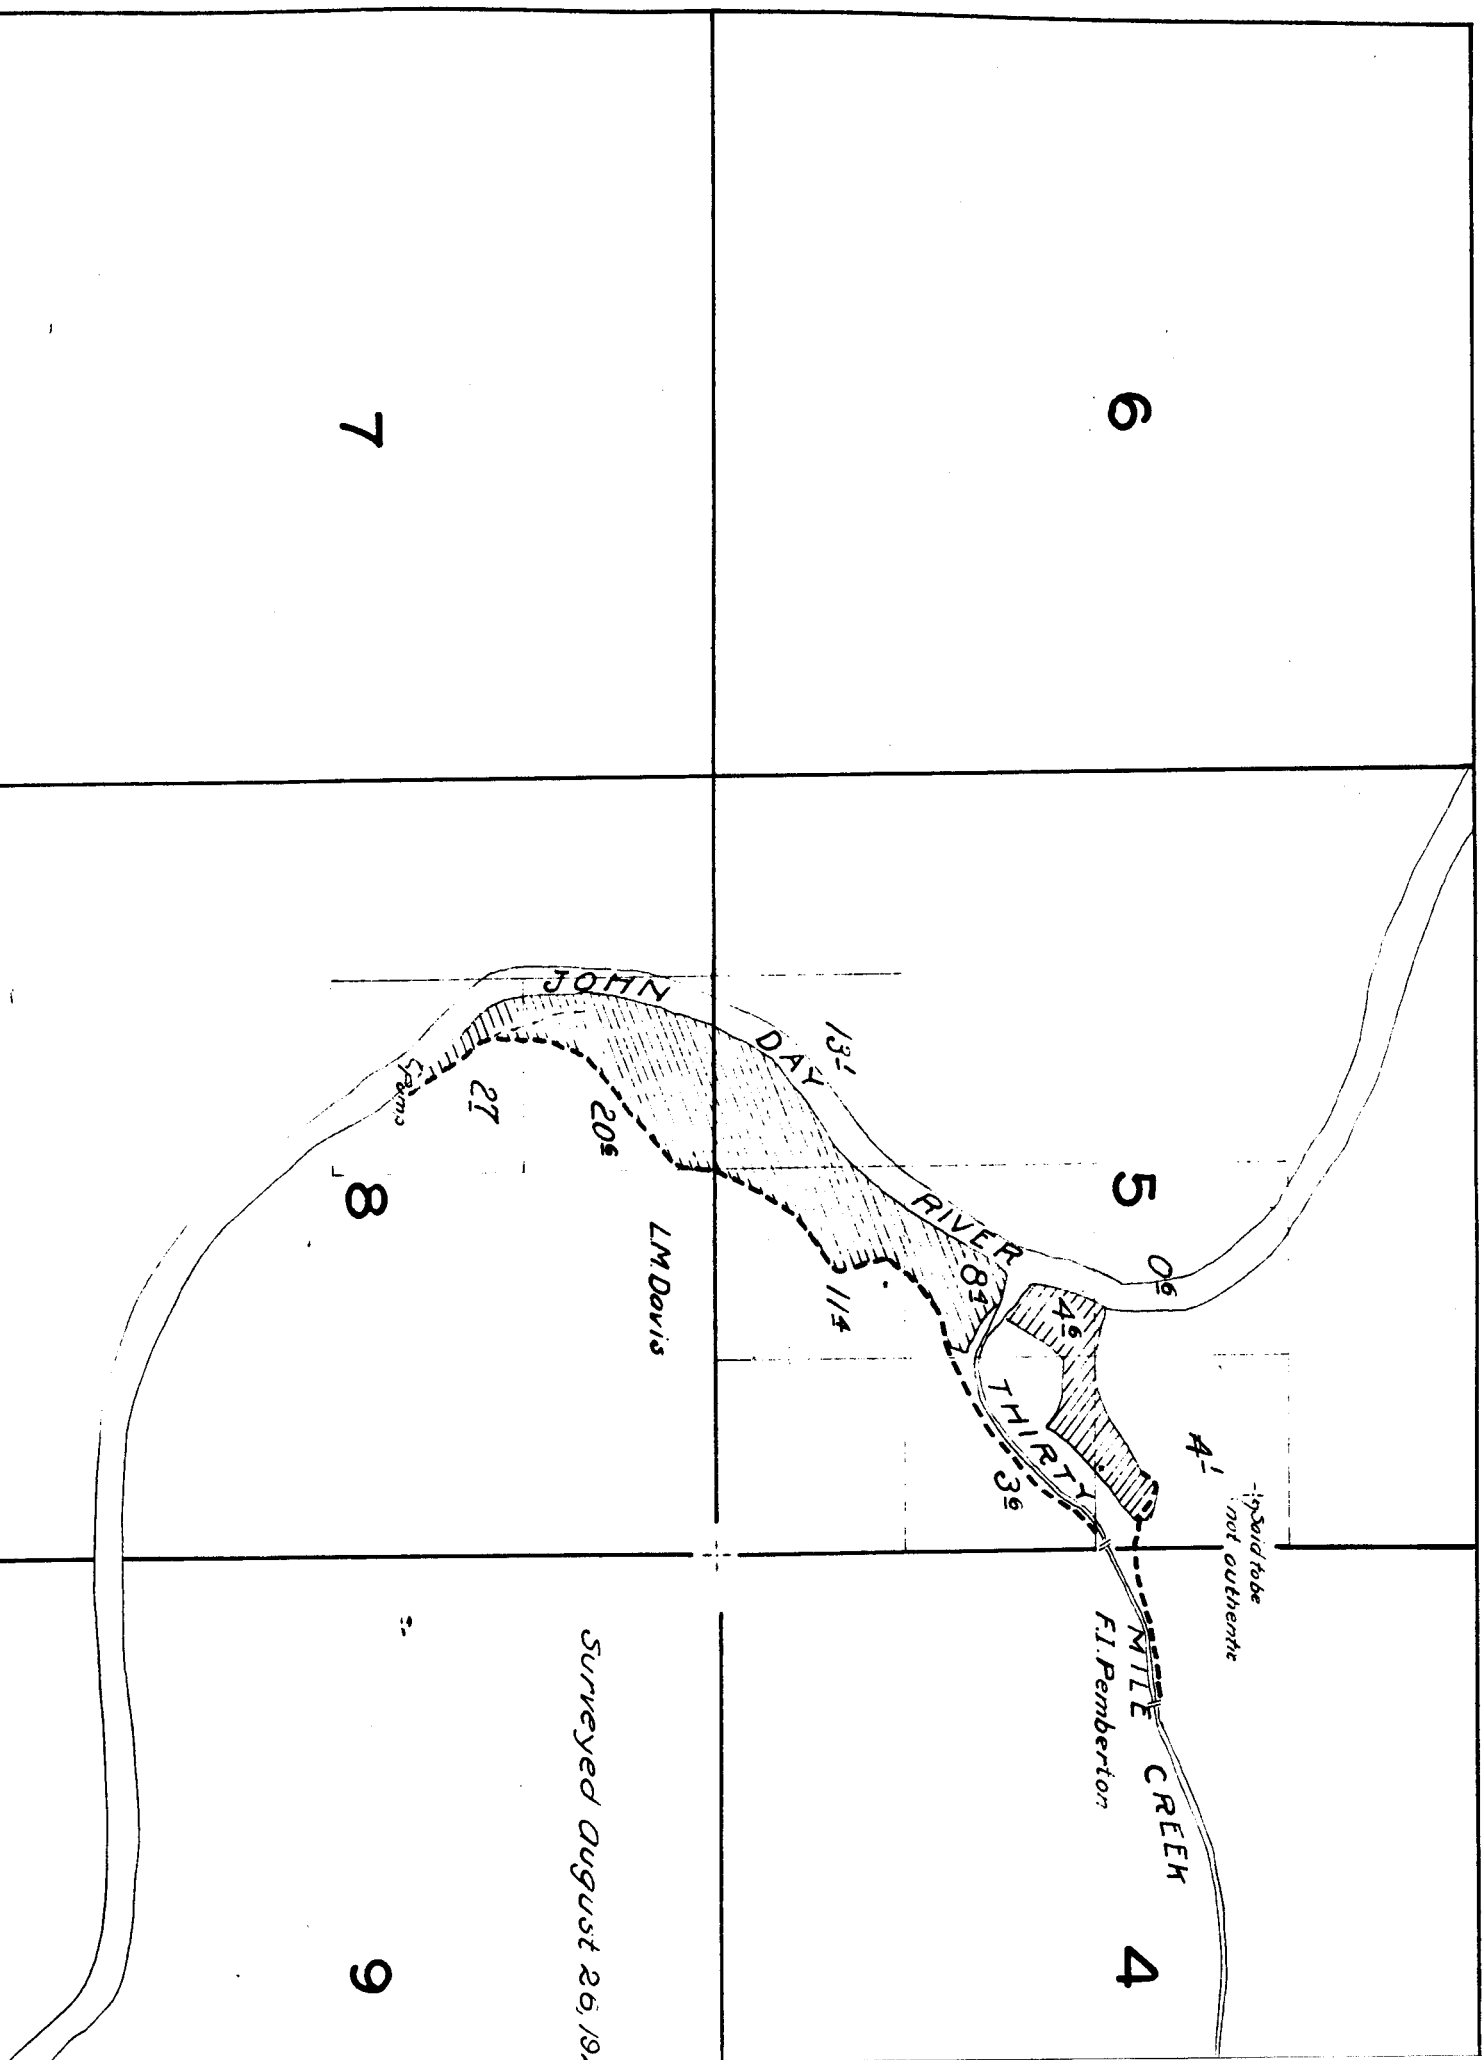

15

22

16

21


the vicinity of
hed in the

27

34

28

33

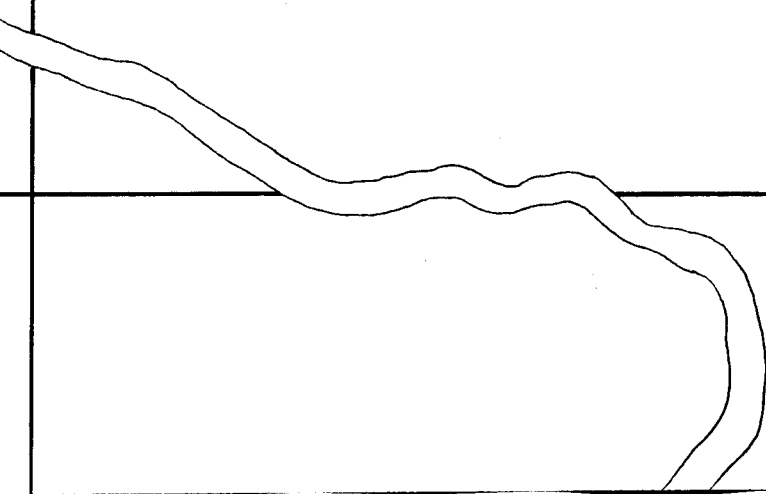

23

24

26

25

35

36

19

20


Note: Streams, except in the vicinity of irrigated land, are sketched in the approximate location.

30

29

31

32

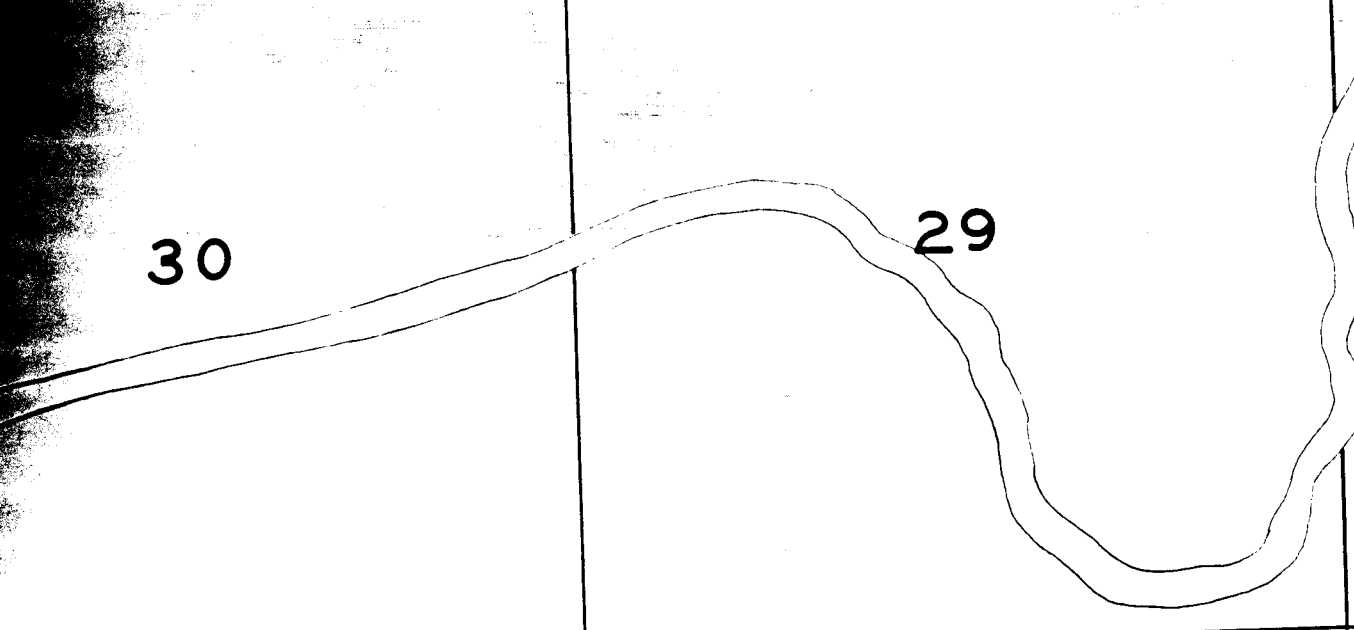

TOWNSHIP 5 S., RANGE 19 E.

