

21

22

28

27

33

34

24

2

1

11

12

14

13

	13	24
	14	23
	15	22

27


26

25

34

35

36

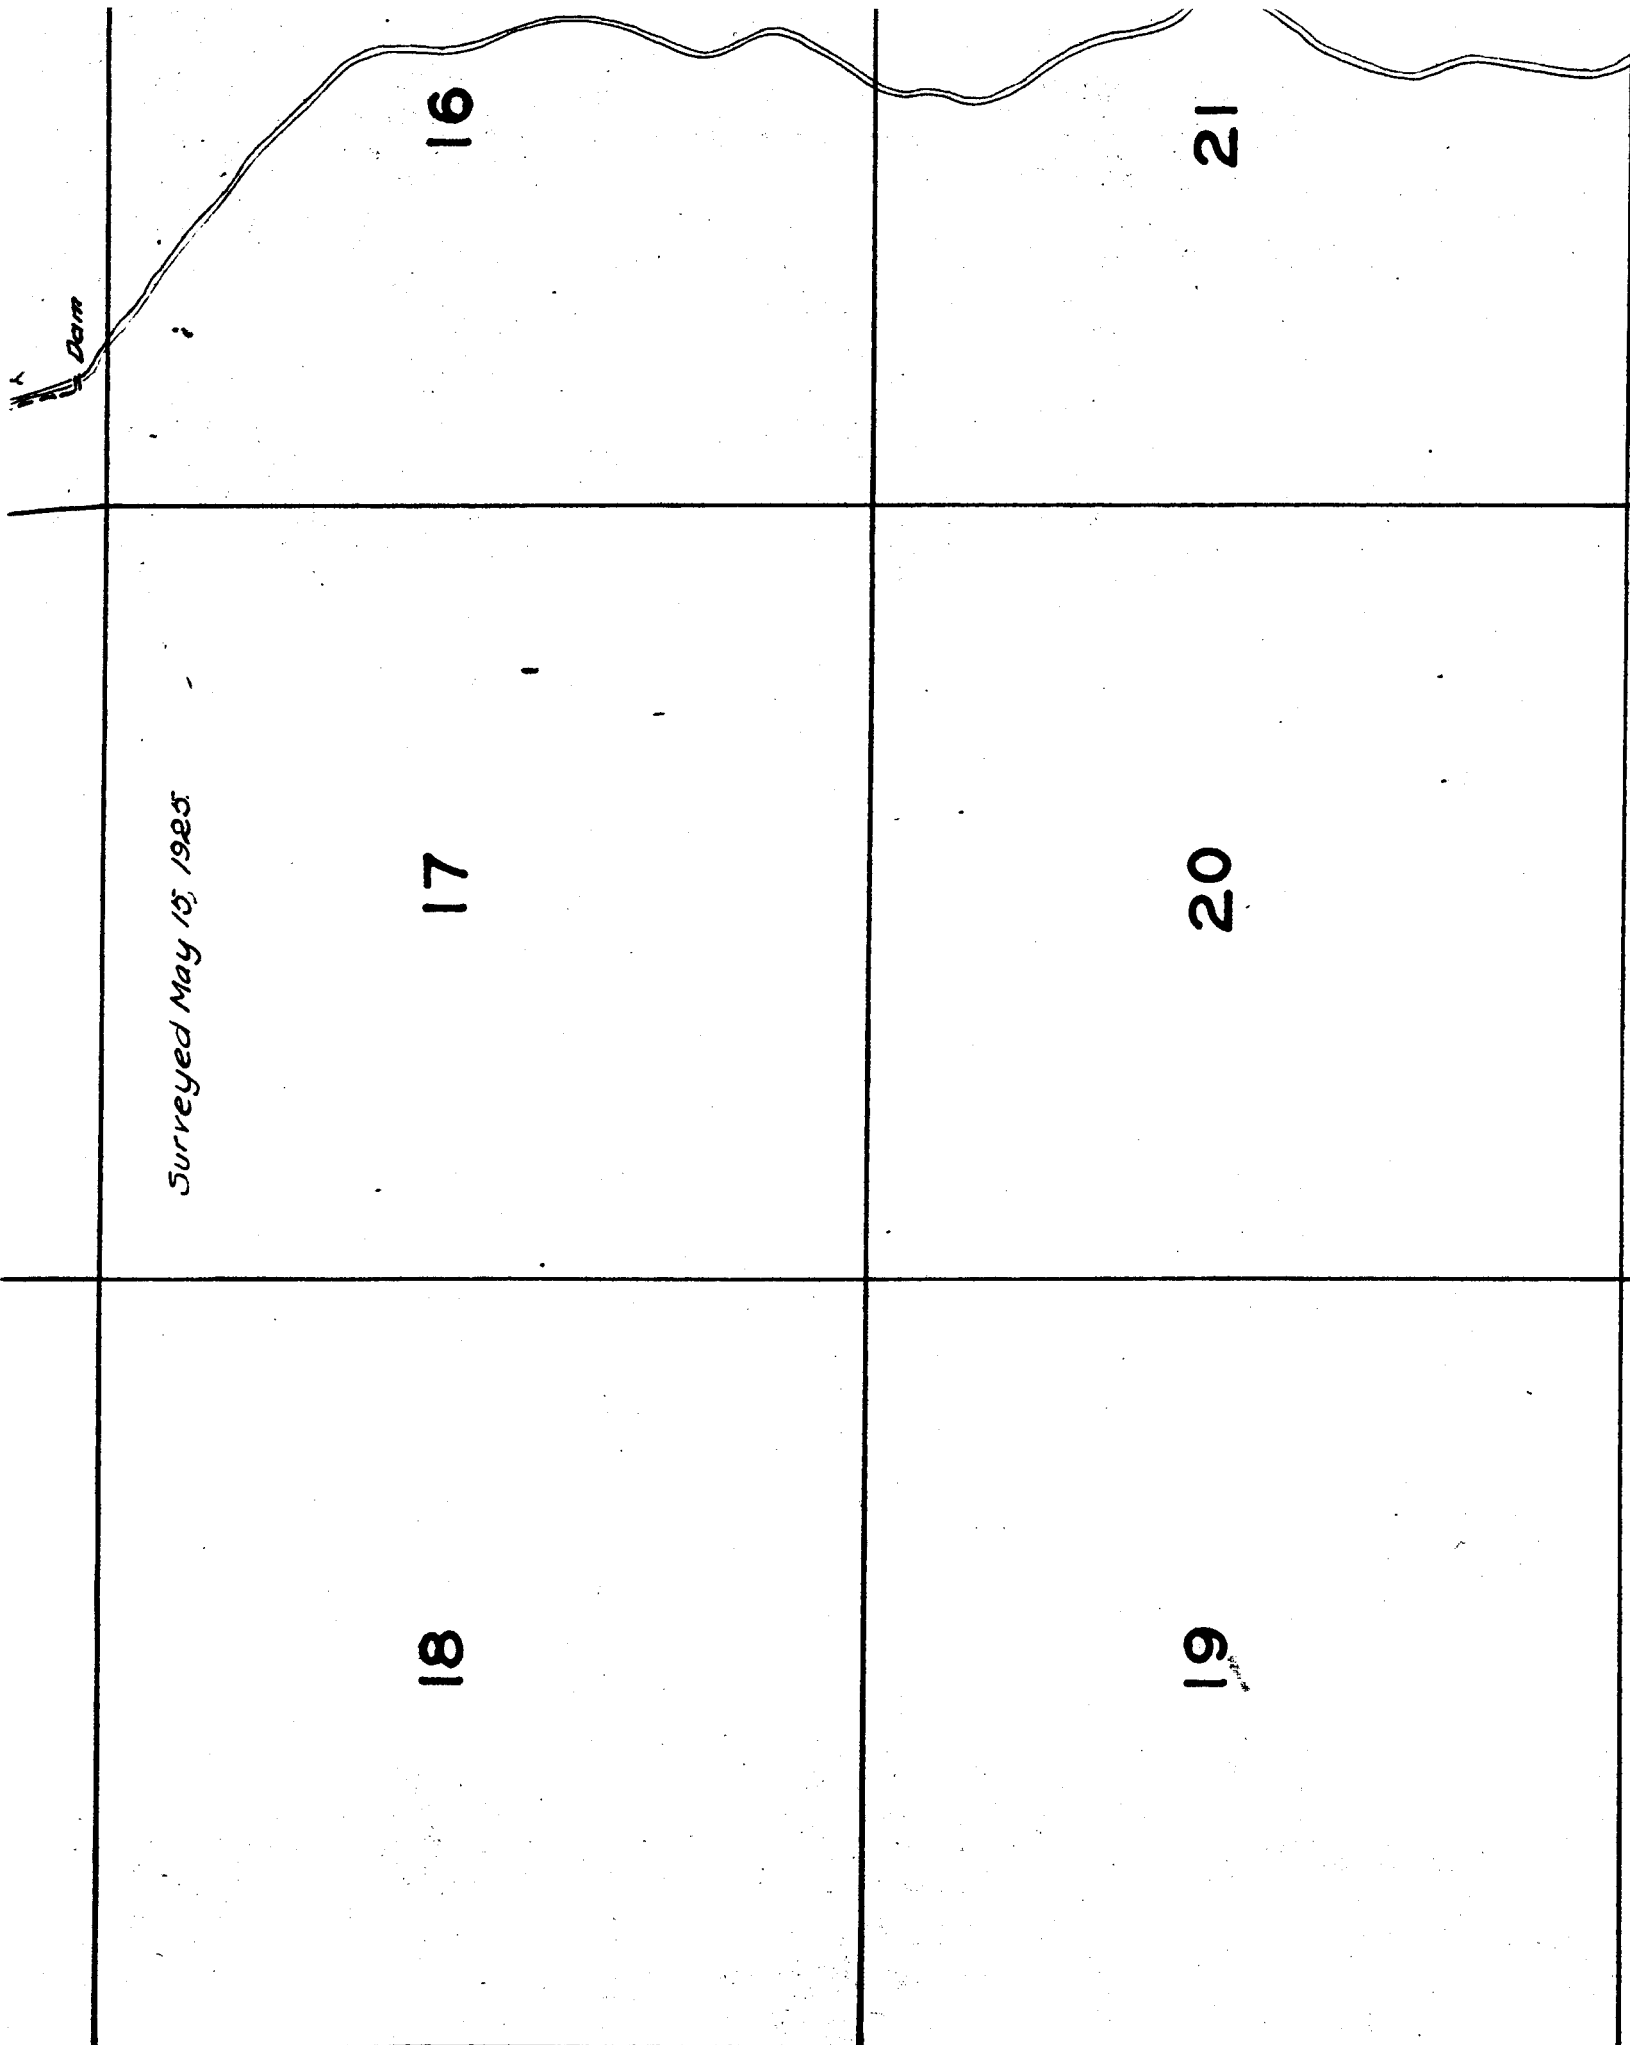

16

21

17

20

18

19

Surveyed May 15, 1925

Dam

30

29

*Note:
Streams, except in the vicinity
of irrigated land, are sketched
in approximate location.*

28

31

32

33

TOWNSHIP 1 S., RANGE 20 E.

3

10

4

9

5

8

U.S.G.S. Mon.


86 30

Flume

24

S. Mon.

HAY CREEK

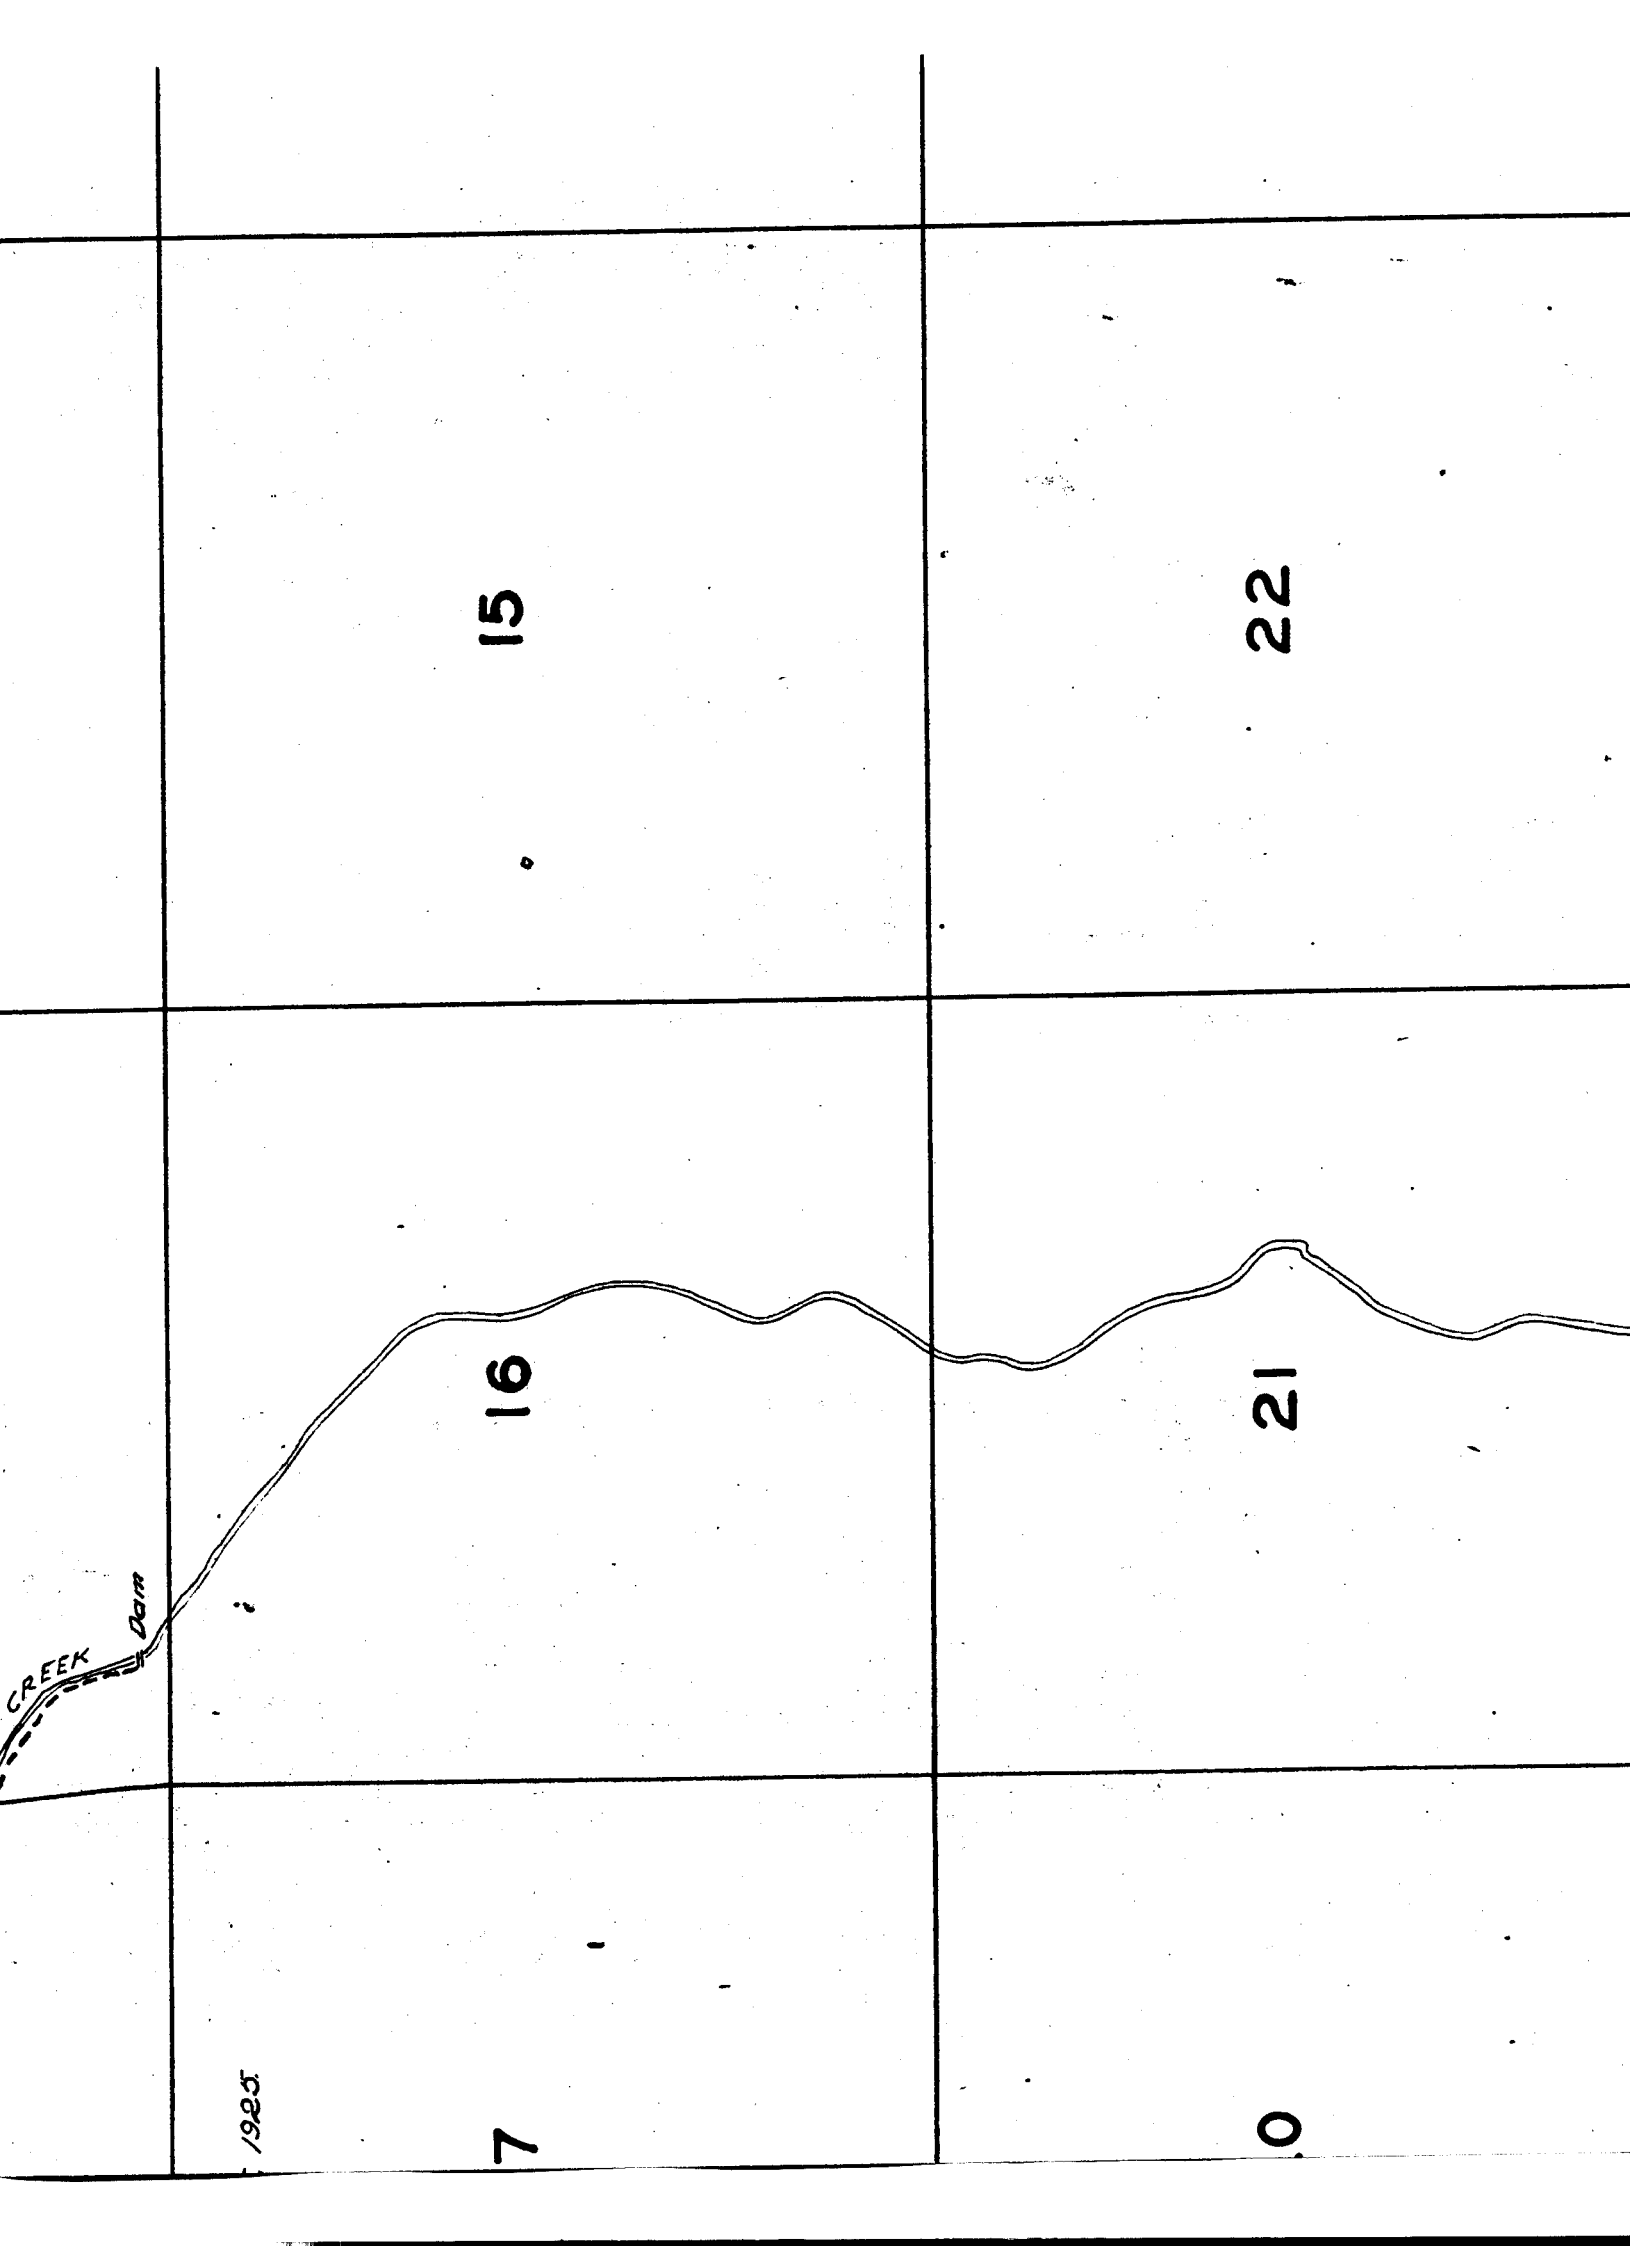

15

22

16

21

7

0

CREEK
Dam

1925