


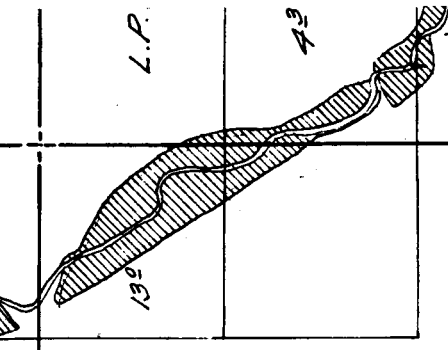

27


Note: Streams, except in the vicinity of irrigated land are sketched in approximate location.

34

28




33

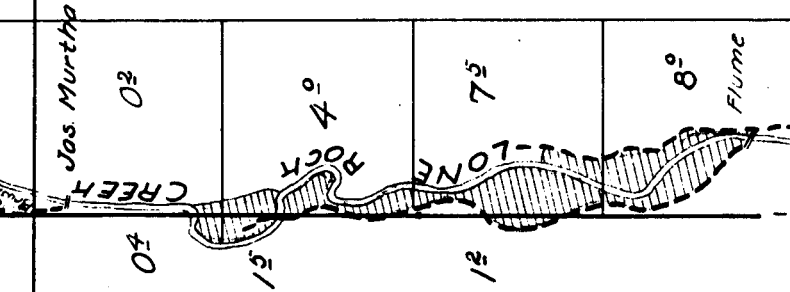

29

32

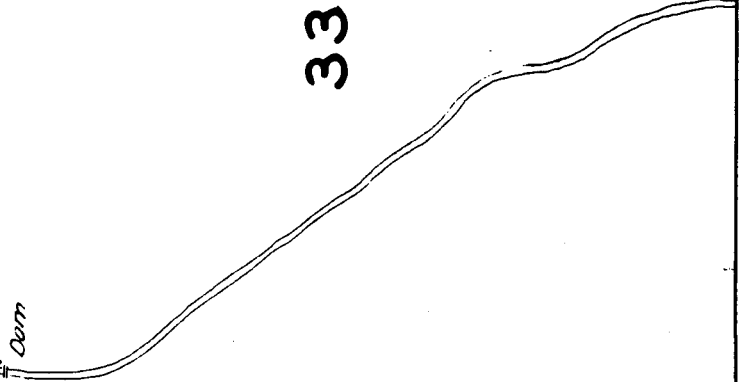

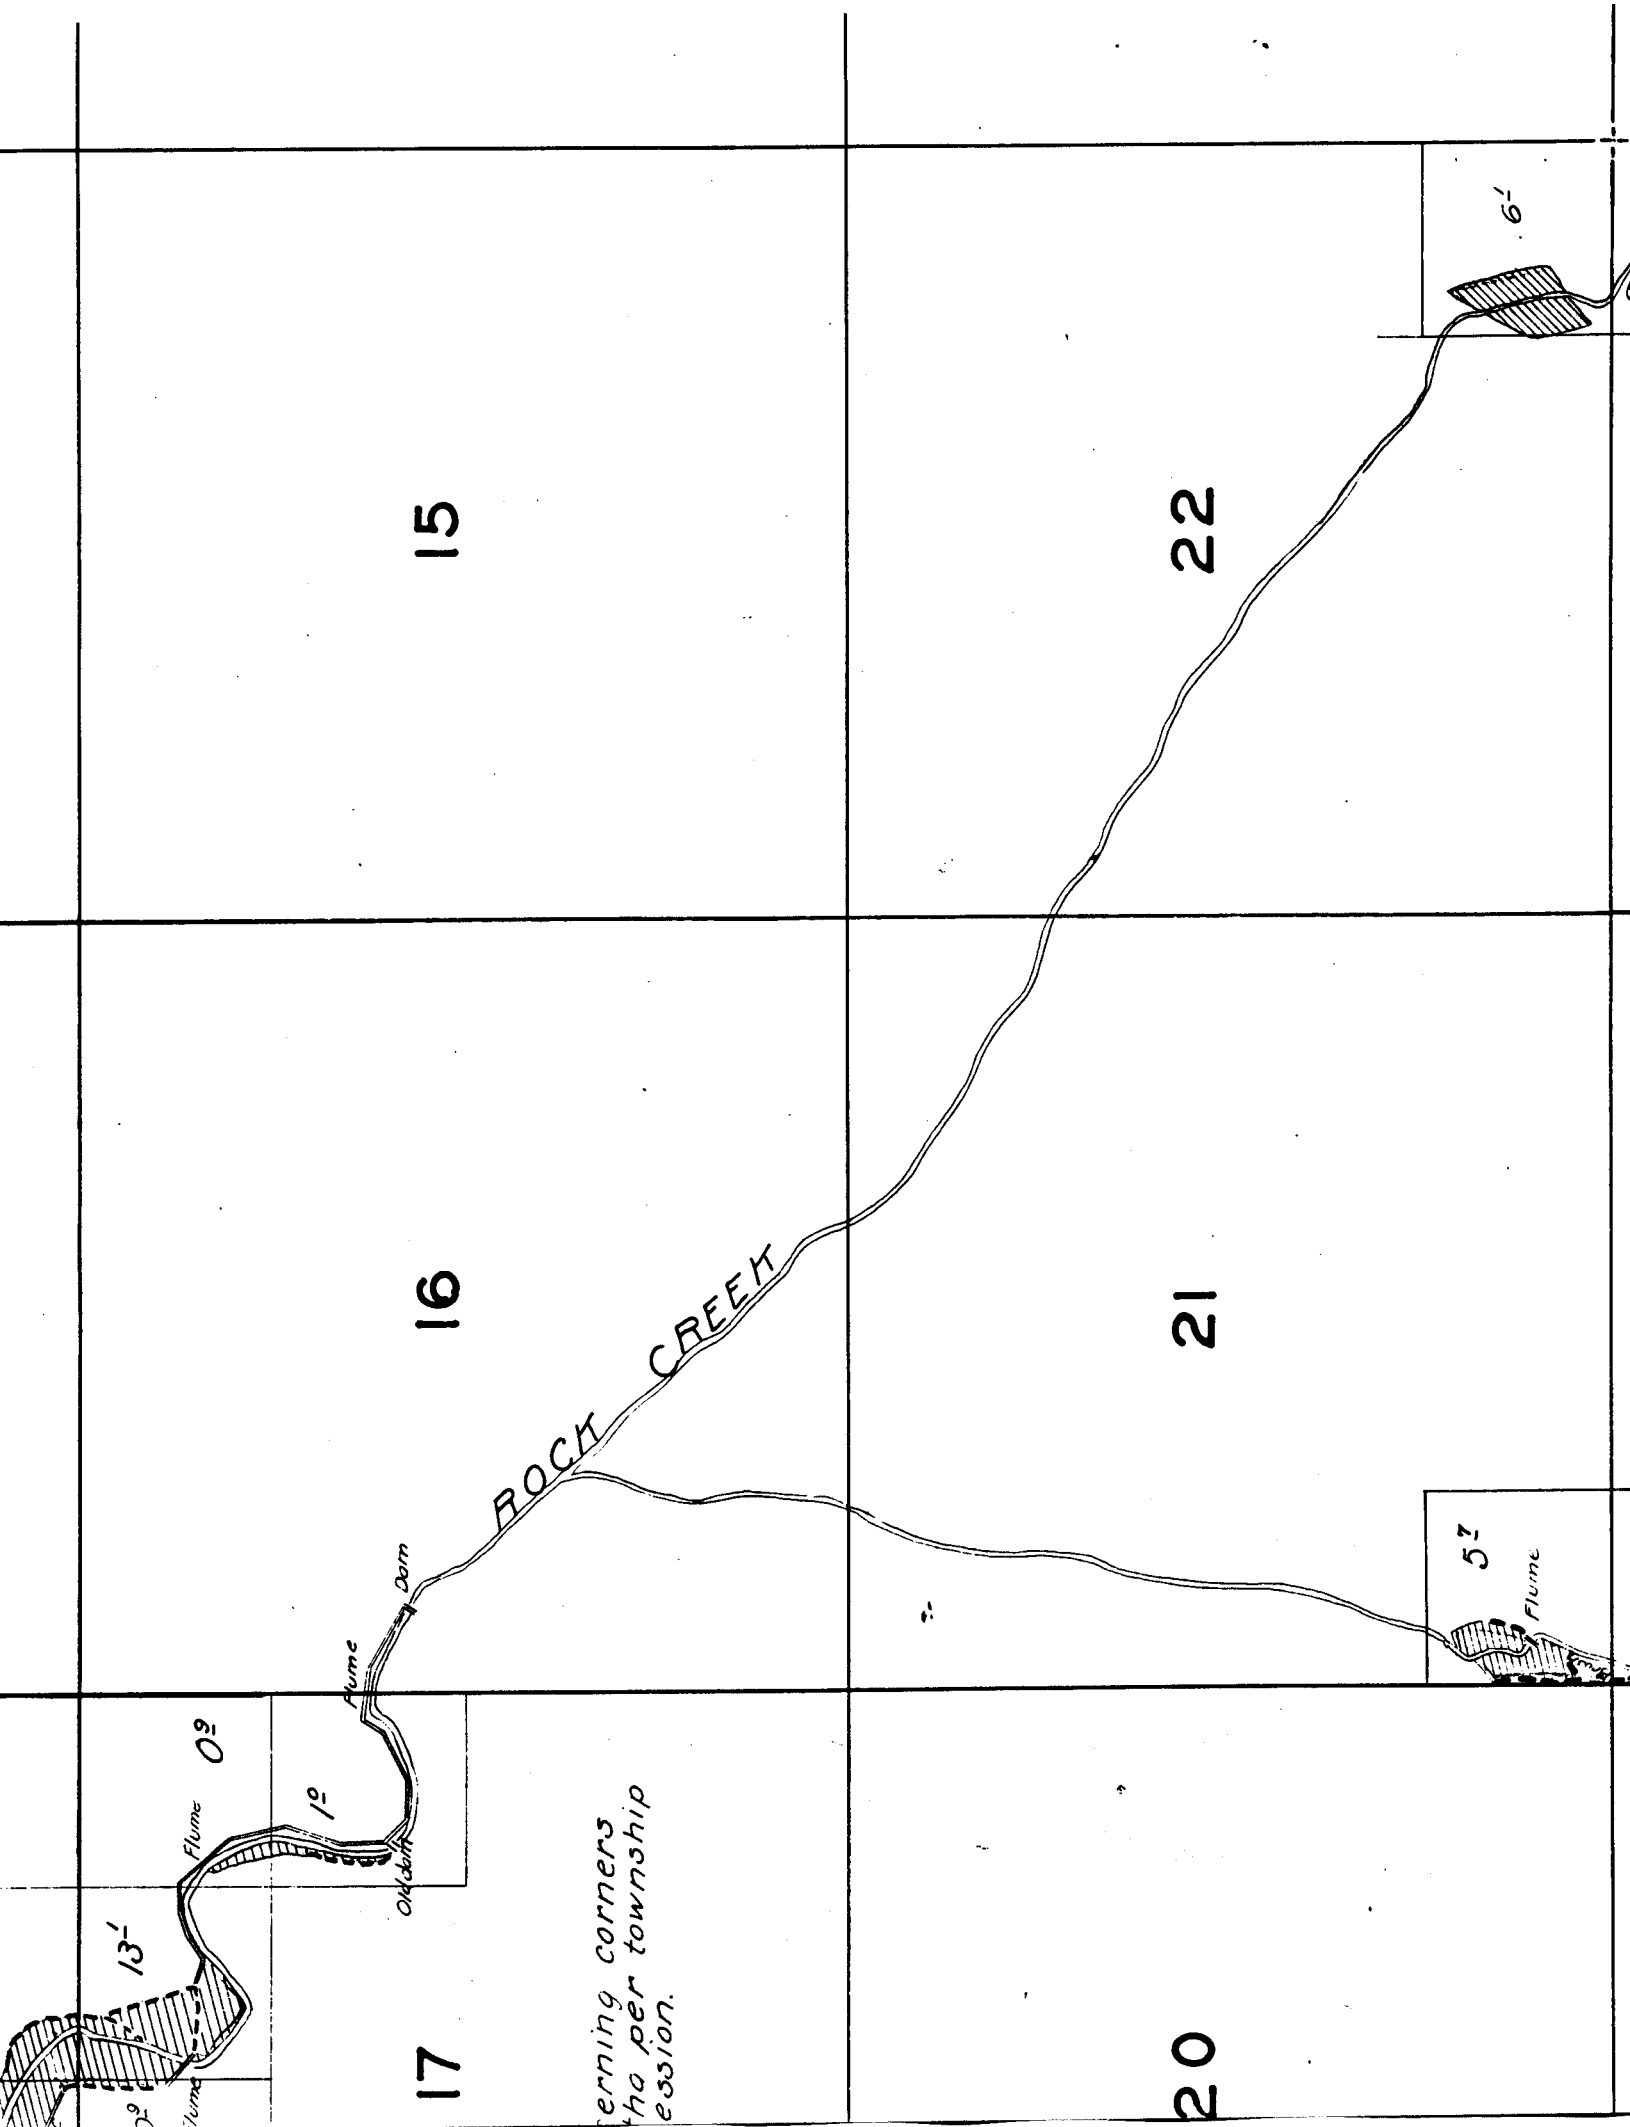

erning corners
who per township
ession.

19

20

30

29

31

32

04

12

12

TOWNSHIP 4 S., RANGE 23 E.

4

3


9

10

Surveyed May 23, 1925

16

15

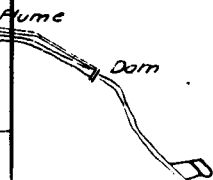

23

24

L.P. Davidson

Surveyed June 1927

26

25

4³

2²

4¹

0⁵

3²

1²

5⁵

4⁴

L.P. Davidson

Note: Location according to L.P. Davidson

Surveyed June, 1927

35

36

15

14


13

22

23

24

6'

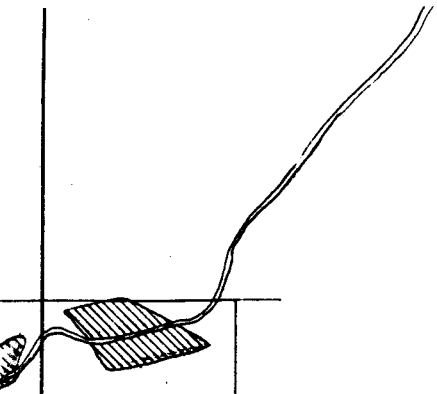

3	2	1
10	11	12

18

17


16

19


20

21

Note:-
Information concerning corners
supplied by Murtha per township
plat in his possession.

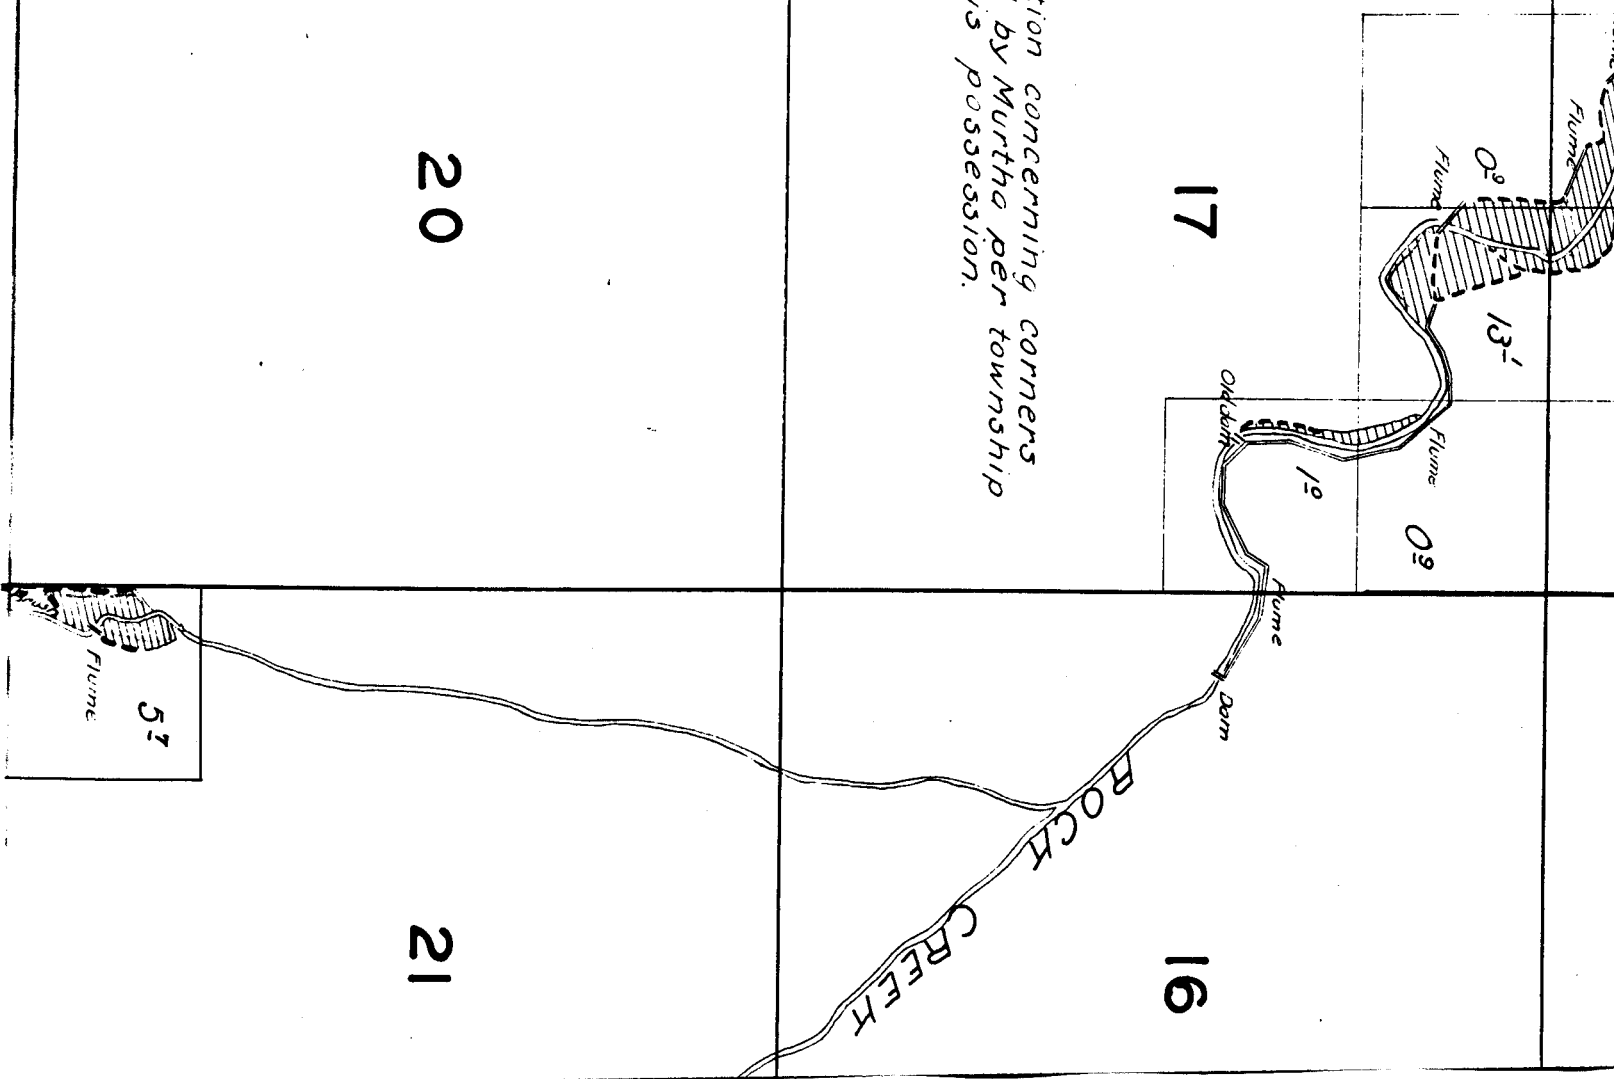

TOWNS

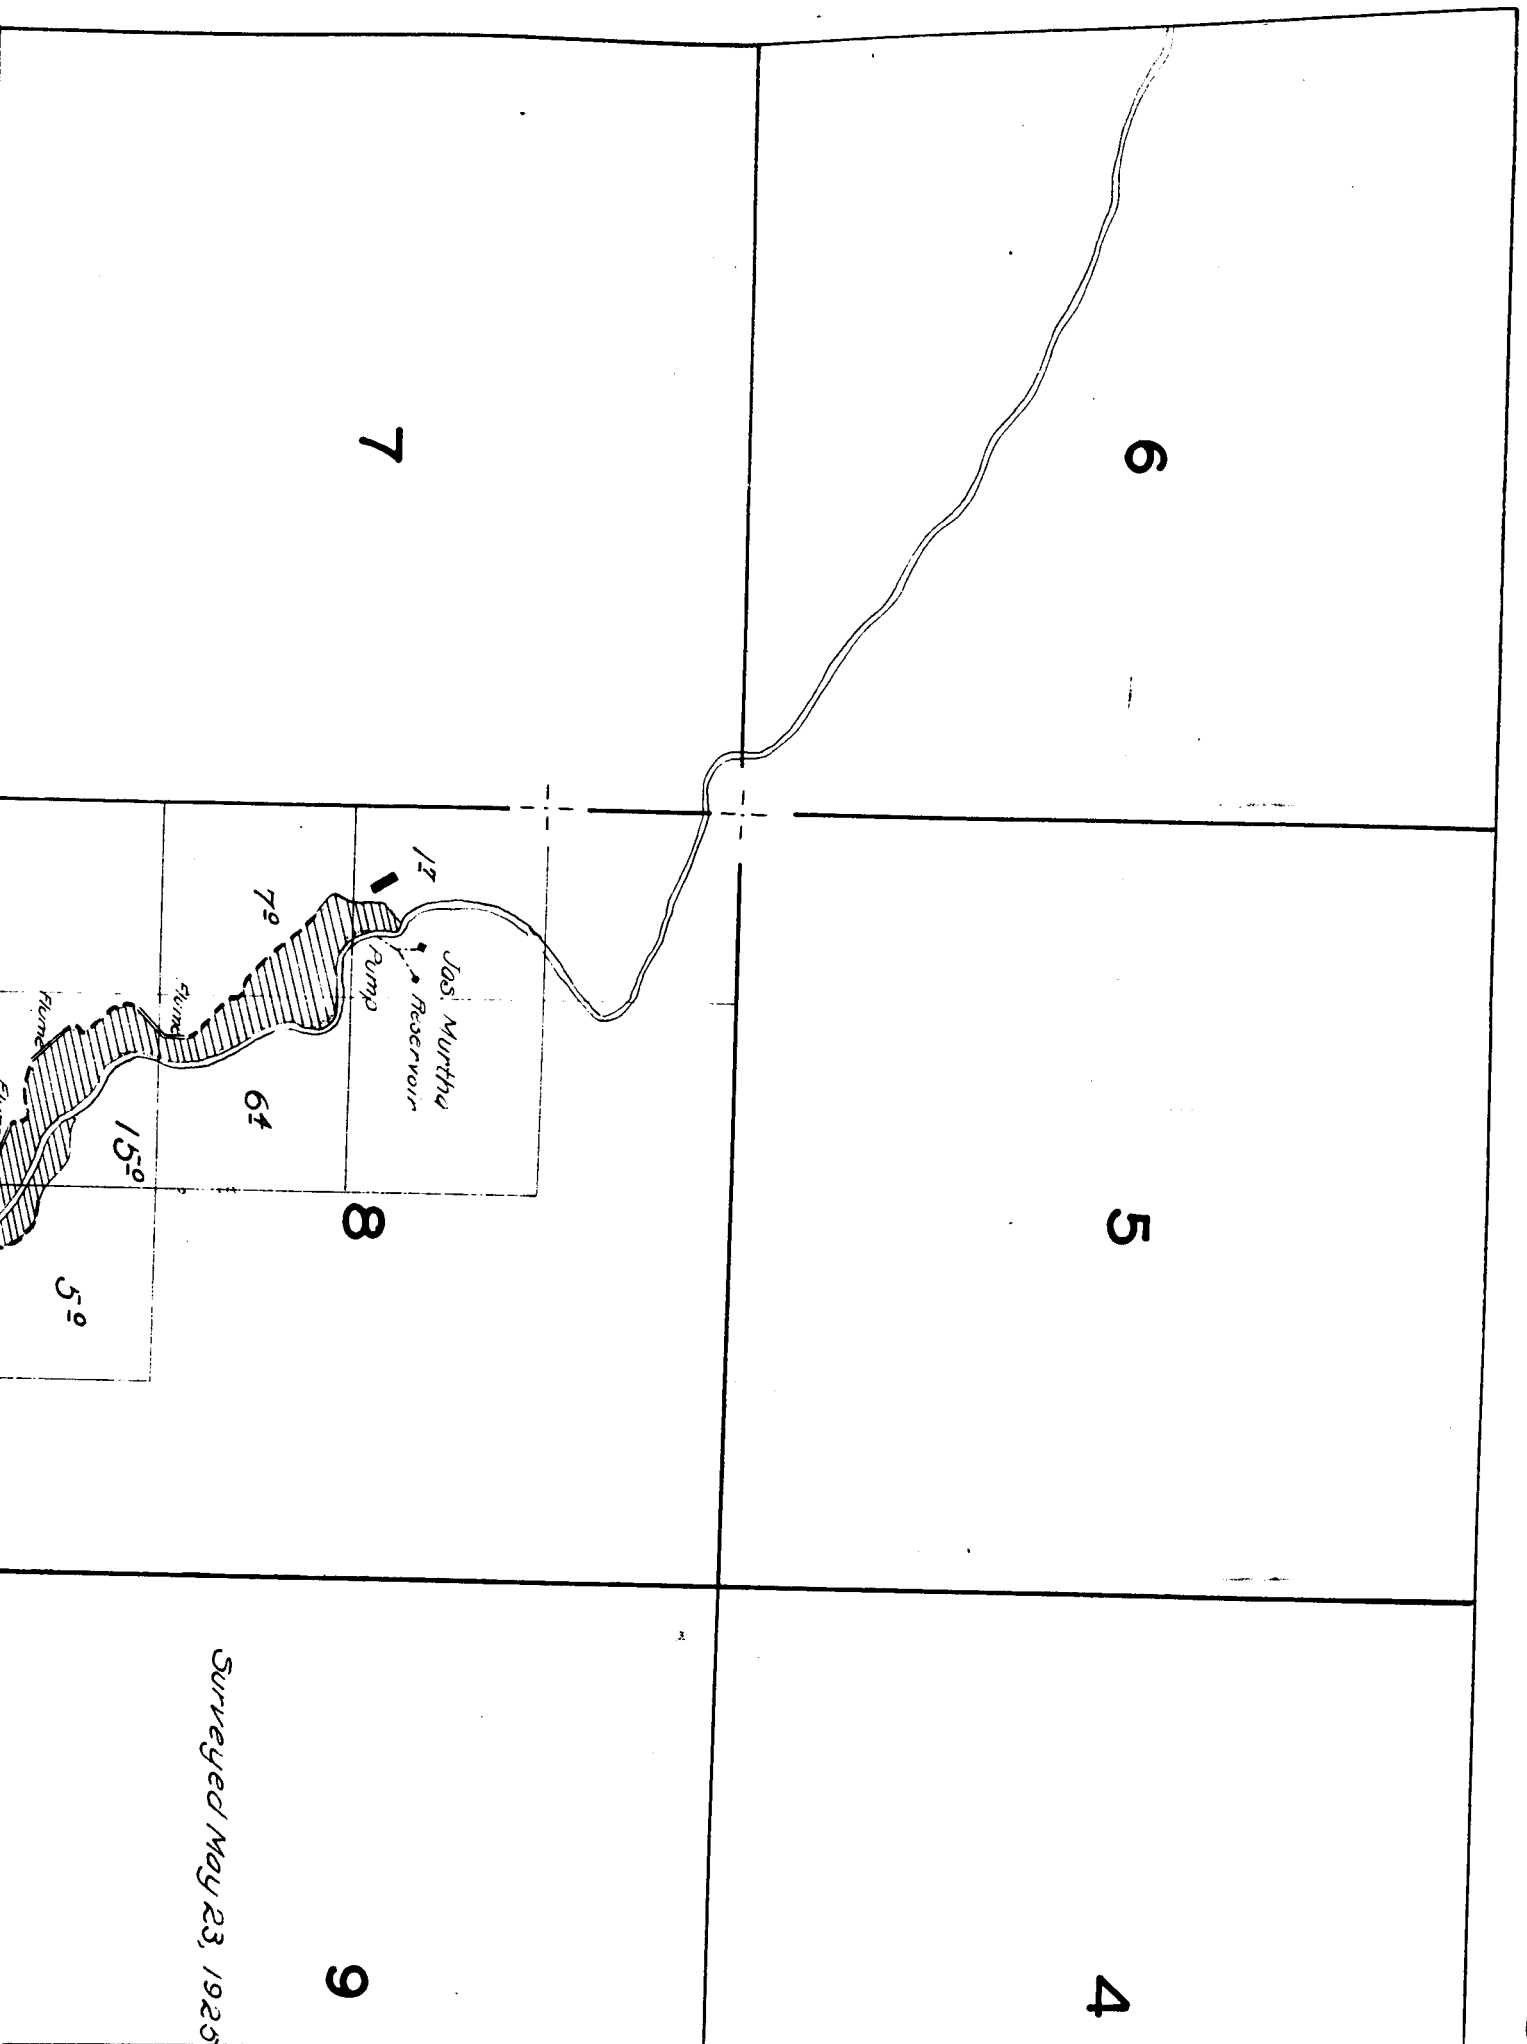

Surveyed May 23, 1925