


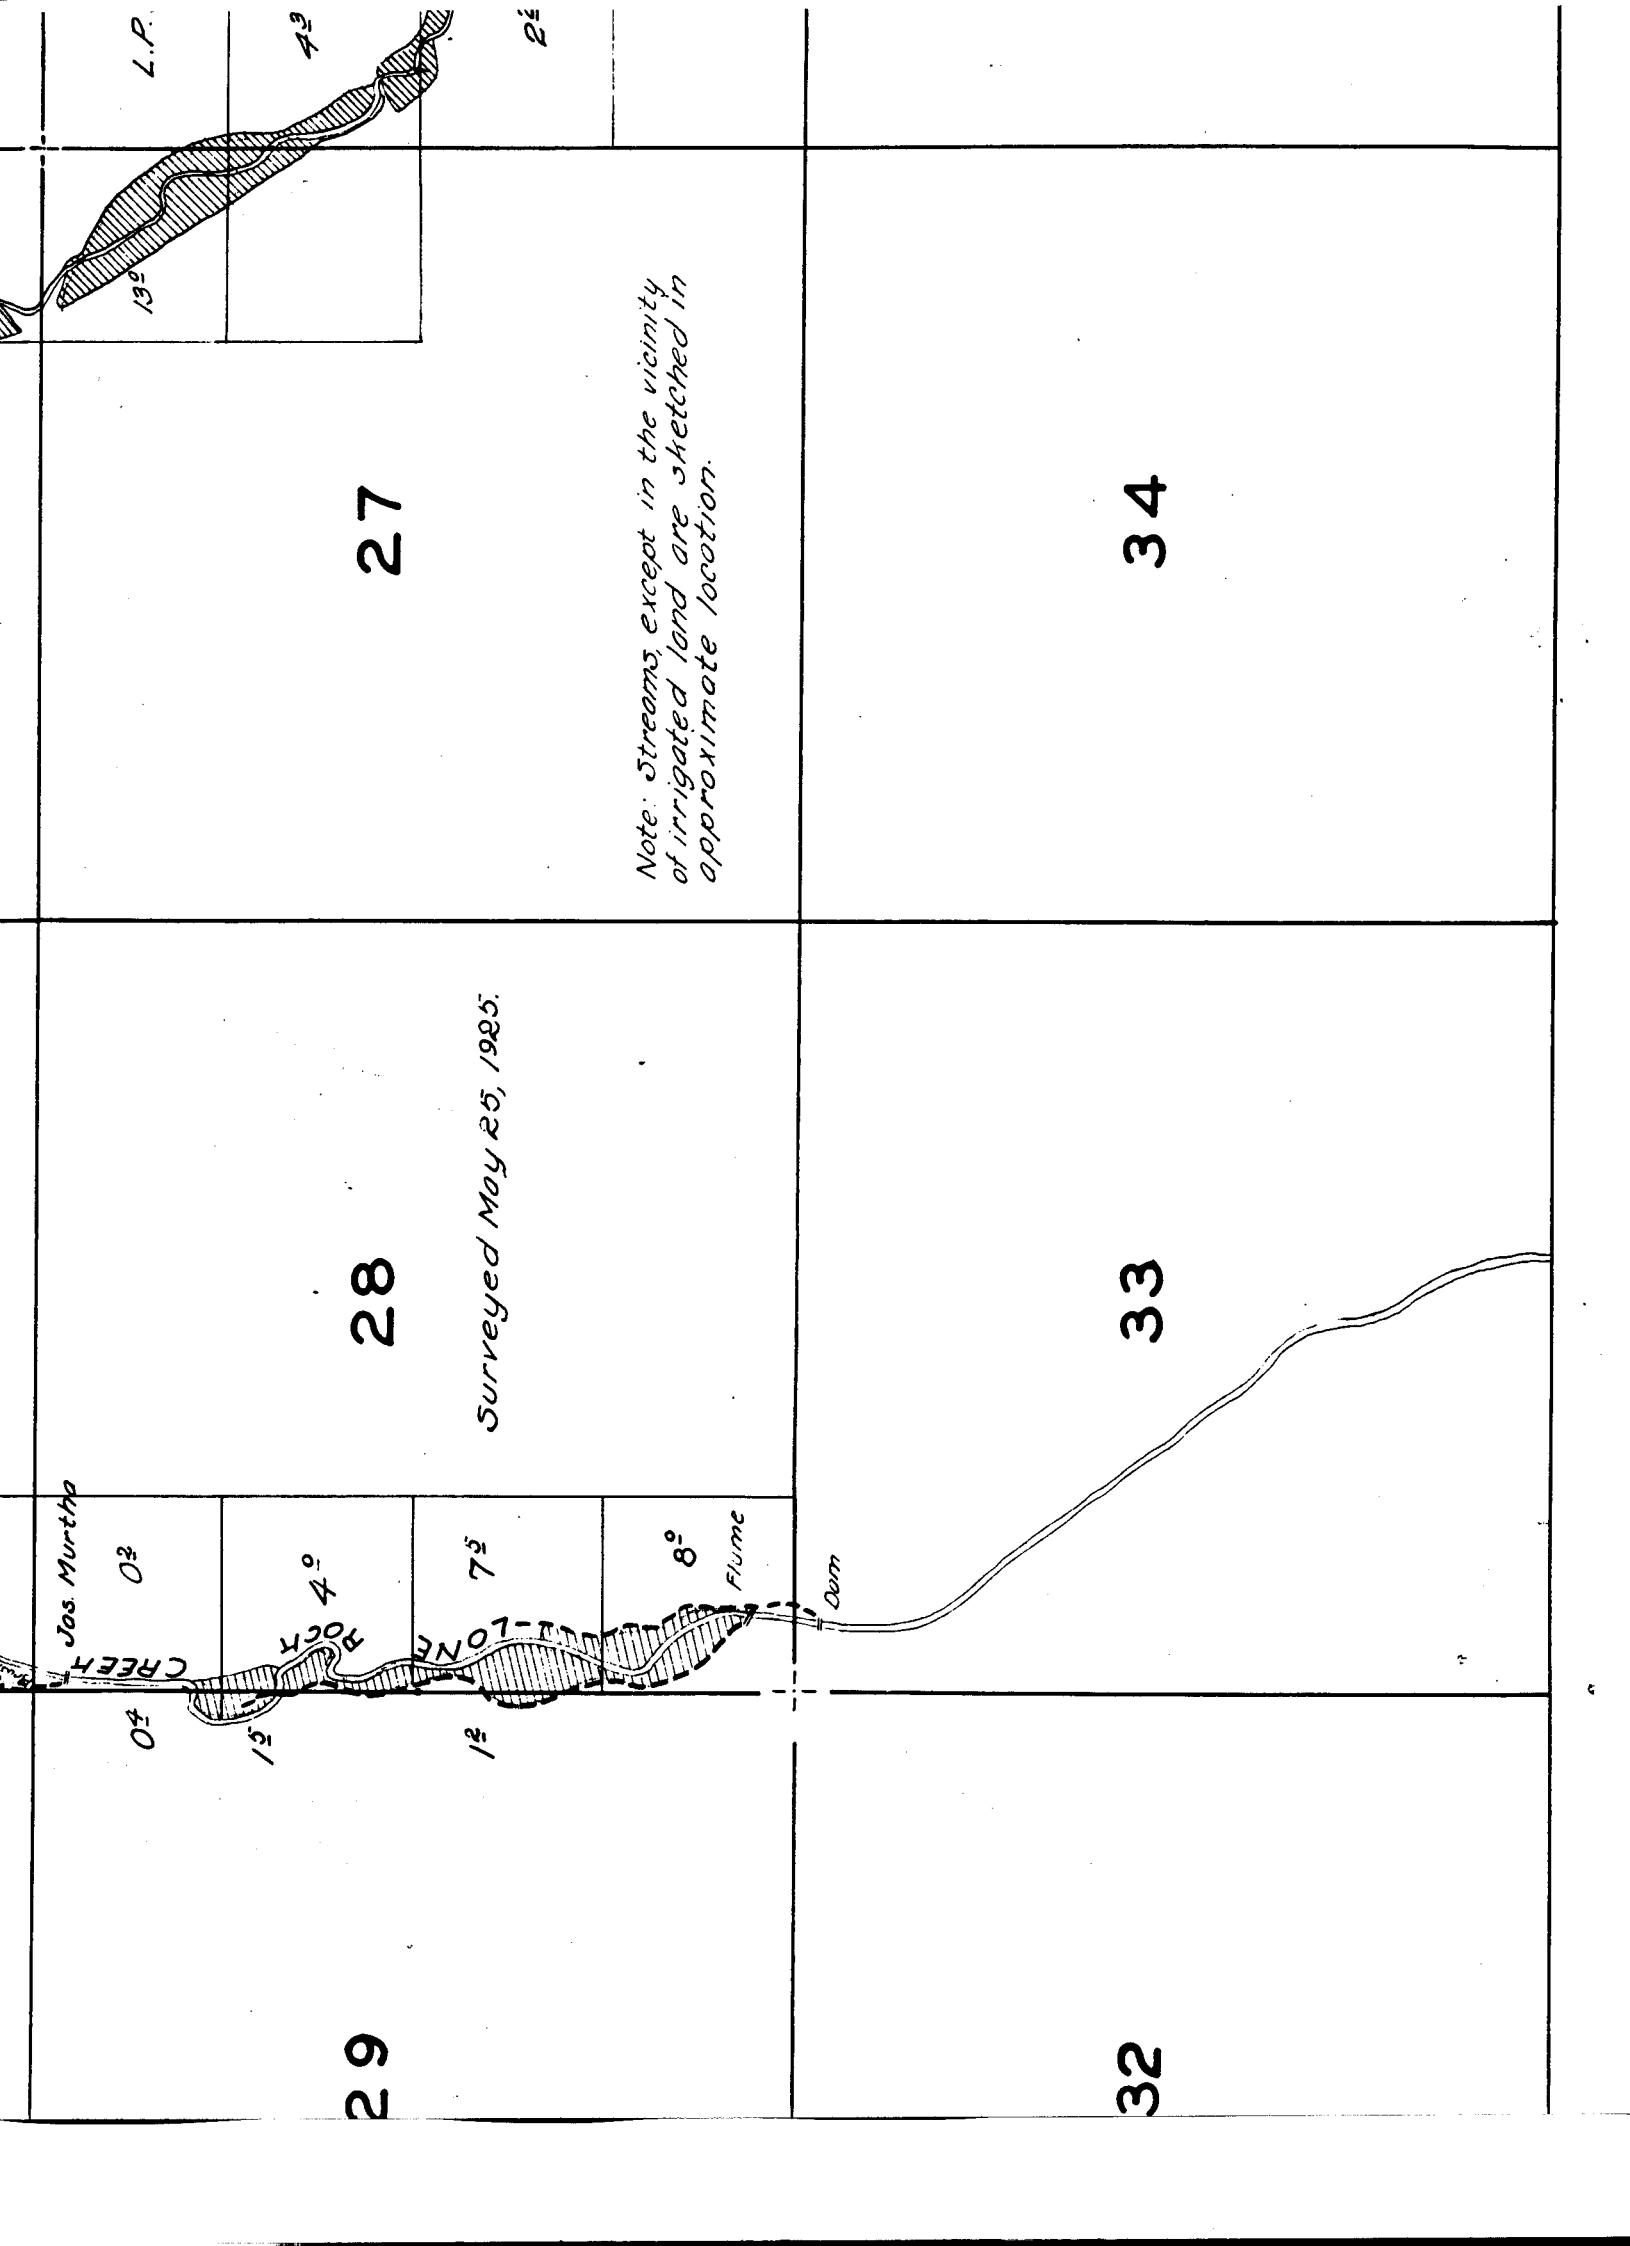

27

Note: Streams, except in the vicinity of irrigated land are sketched in approximate location.

34


28

Surveyed May 25, 1925.

33

29

32

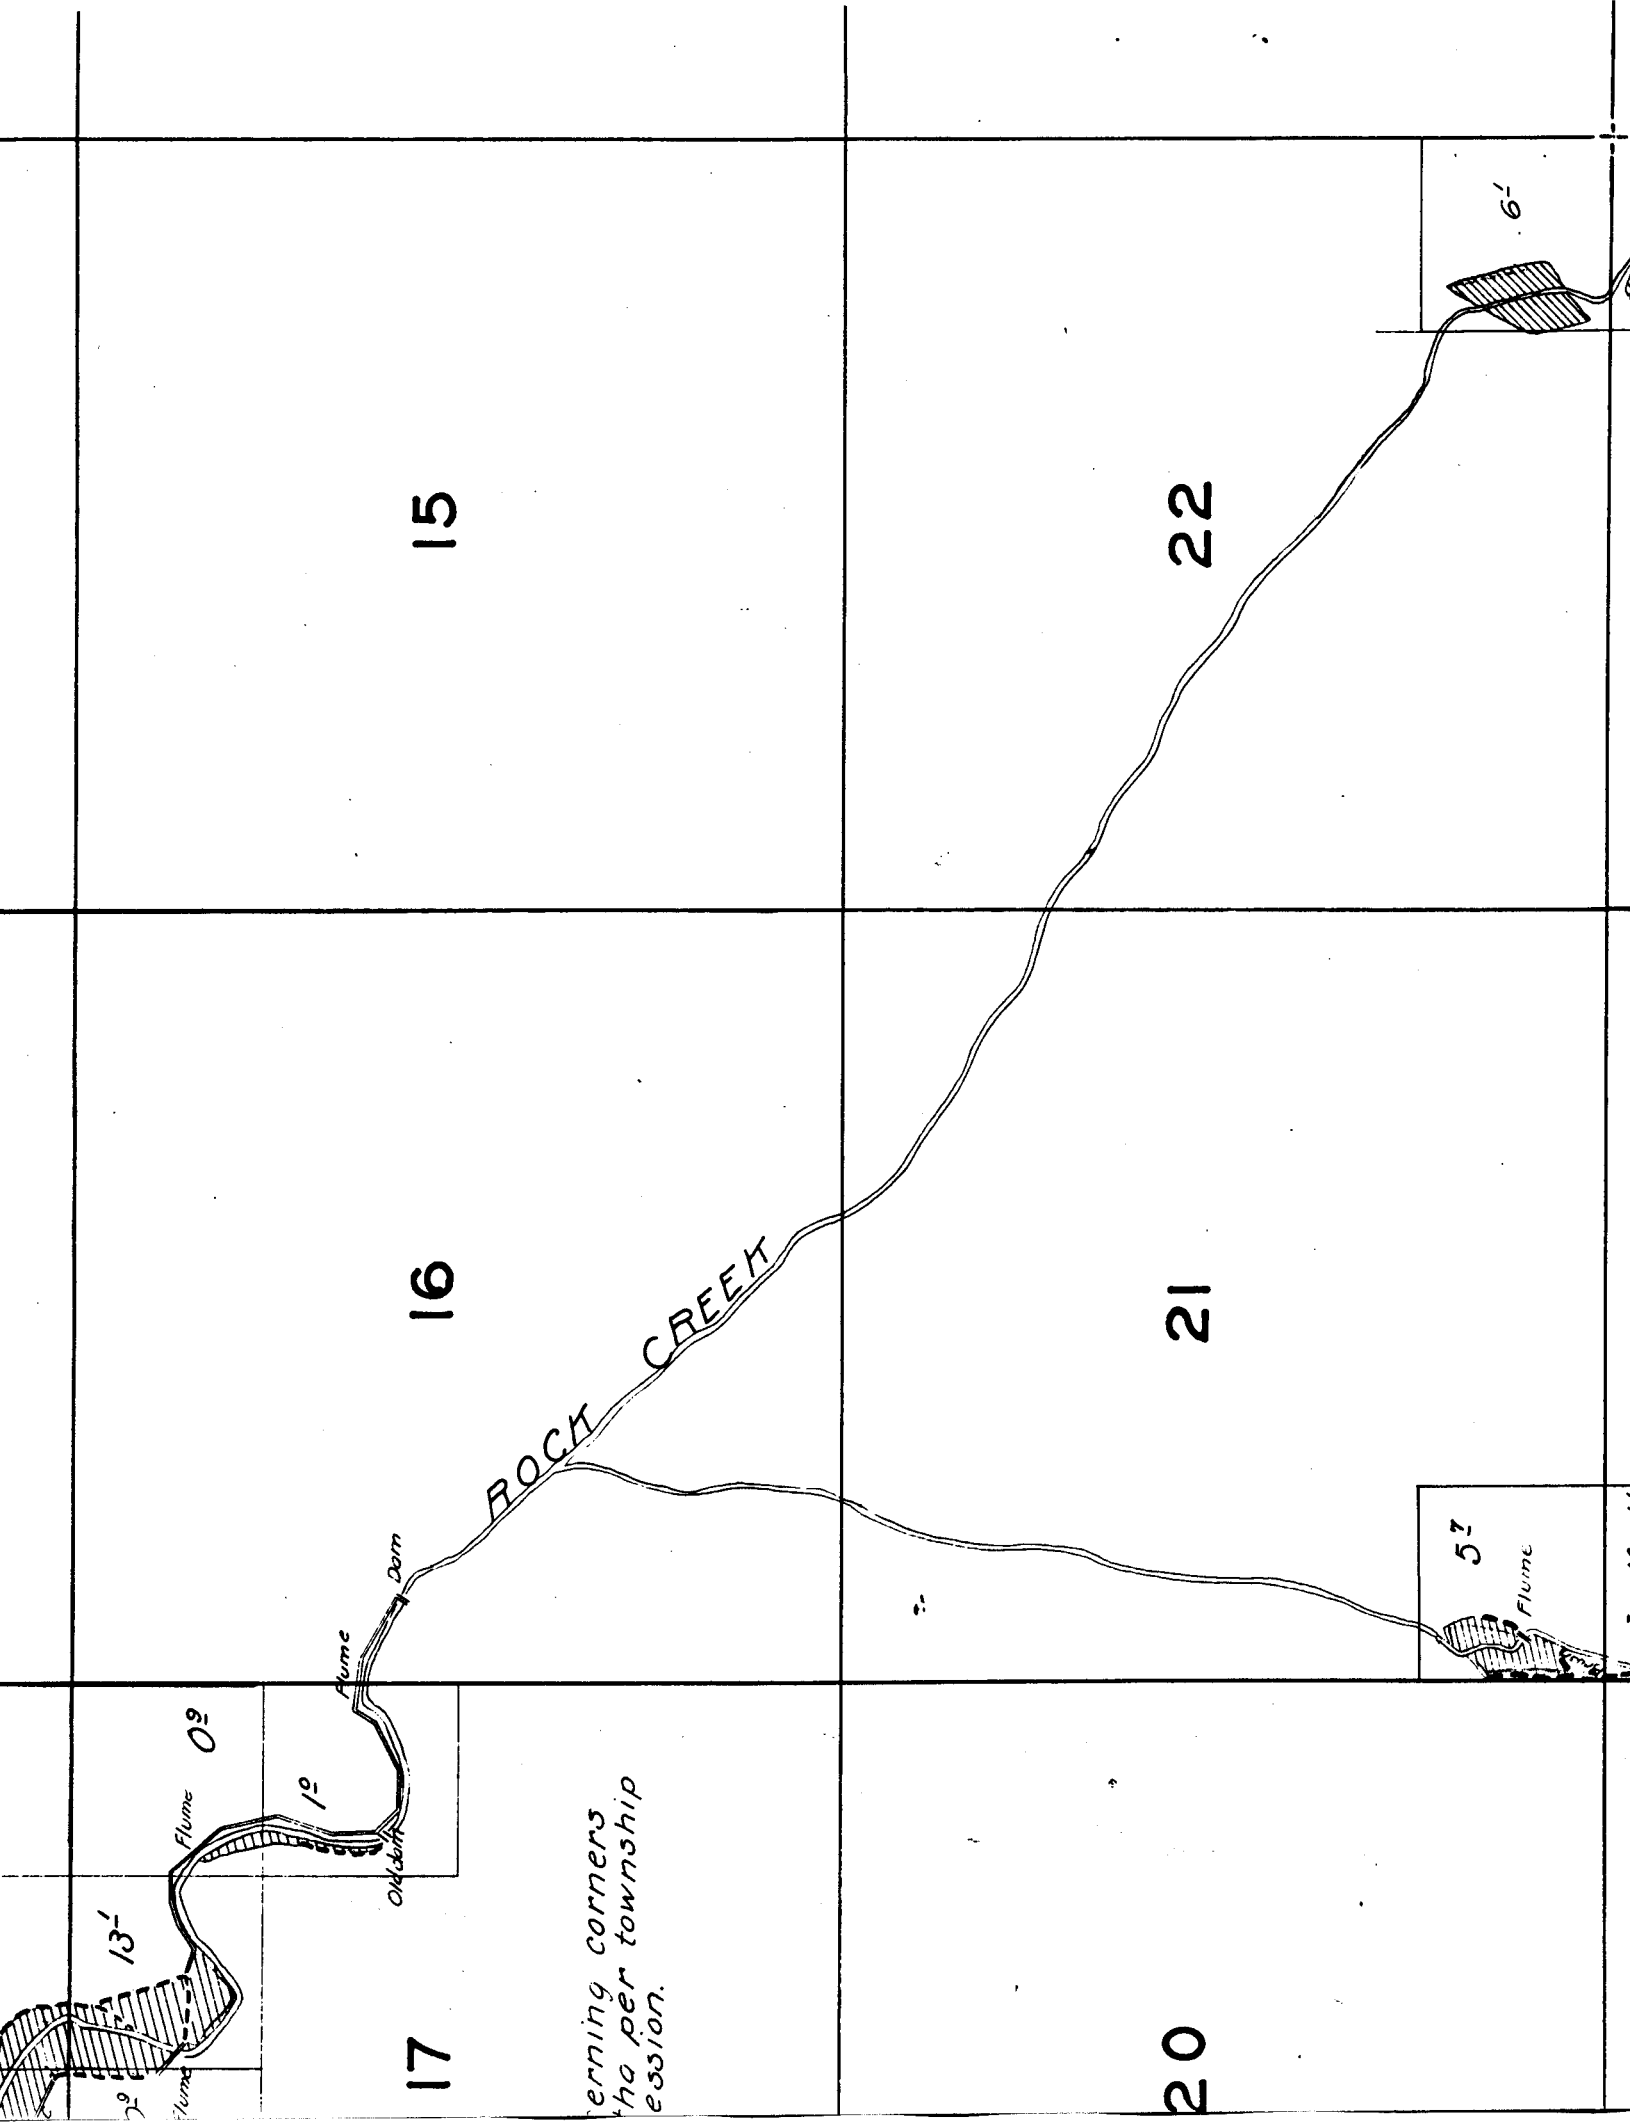

15

22

16

21

17

20

ROCK CREEK

Turning corners
the per township
session.

Flume 0²

10'

Dam

Outlet

5'

Flume

6'

19

20

30

29

31

32

04

15

12

TOWNSHIP 4 S., RANGE 23 E.

4

3


9

10


16

15

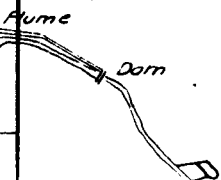

15


14

13

22

23

24

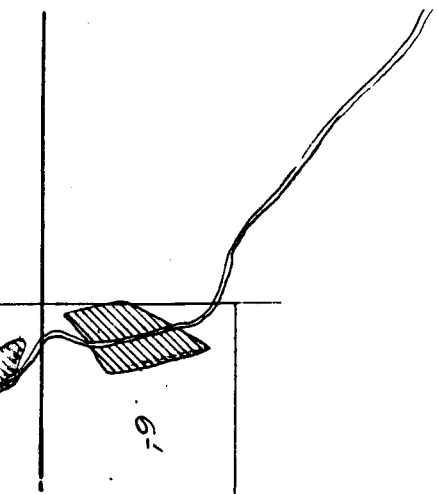

3	2	1
10	11	12

23

24

L.P. Davidson

Surveyed June 1927

26

25

4³

2²

4¹

0²

3²

1²

5⁶

4⁴

L.P. Davidson

Note: Location according to L.P. Davidson

Surveyed June, 1927

35

36

18

17



16

19


20

21

*Note:-
Information concerning corners
supplied by Murtha per township
plat in his possession.*

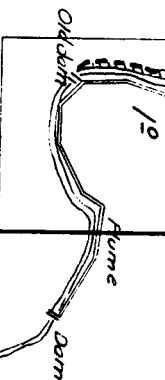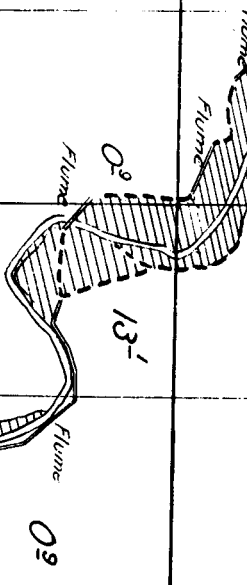

ROCK CREEK

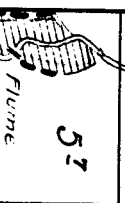

TOWNS

