

21

22

28

27

Surveyed Sept. 24 and 30, 1925.

33

34

Baughn


0^3

6^3

pump

Snoble

JOHN DAY RIVER

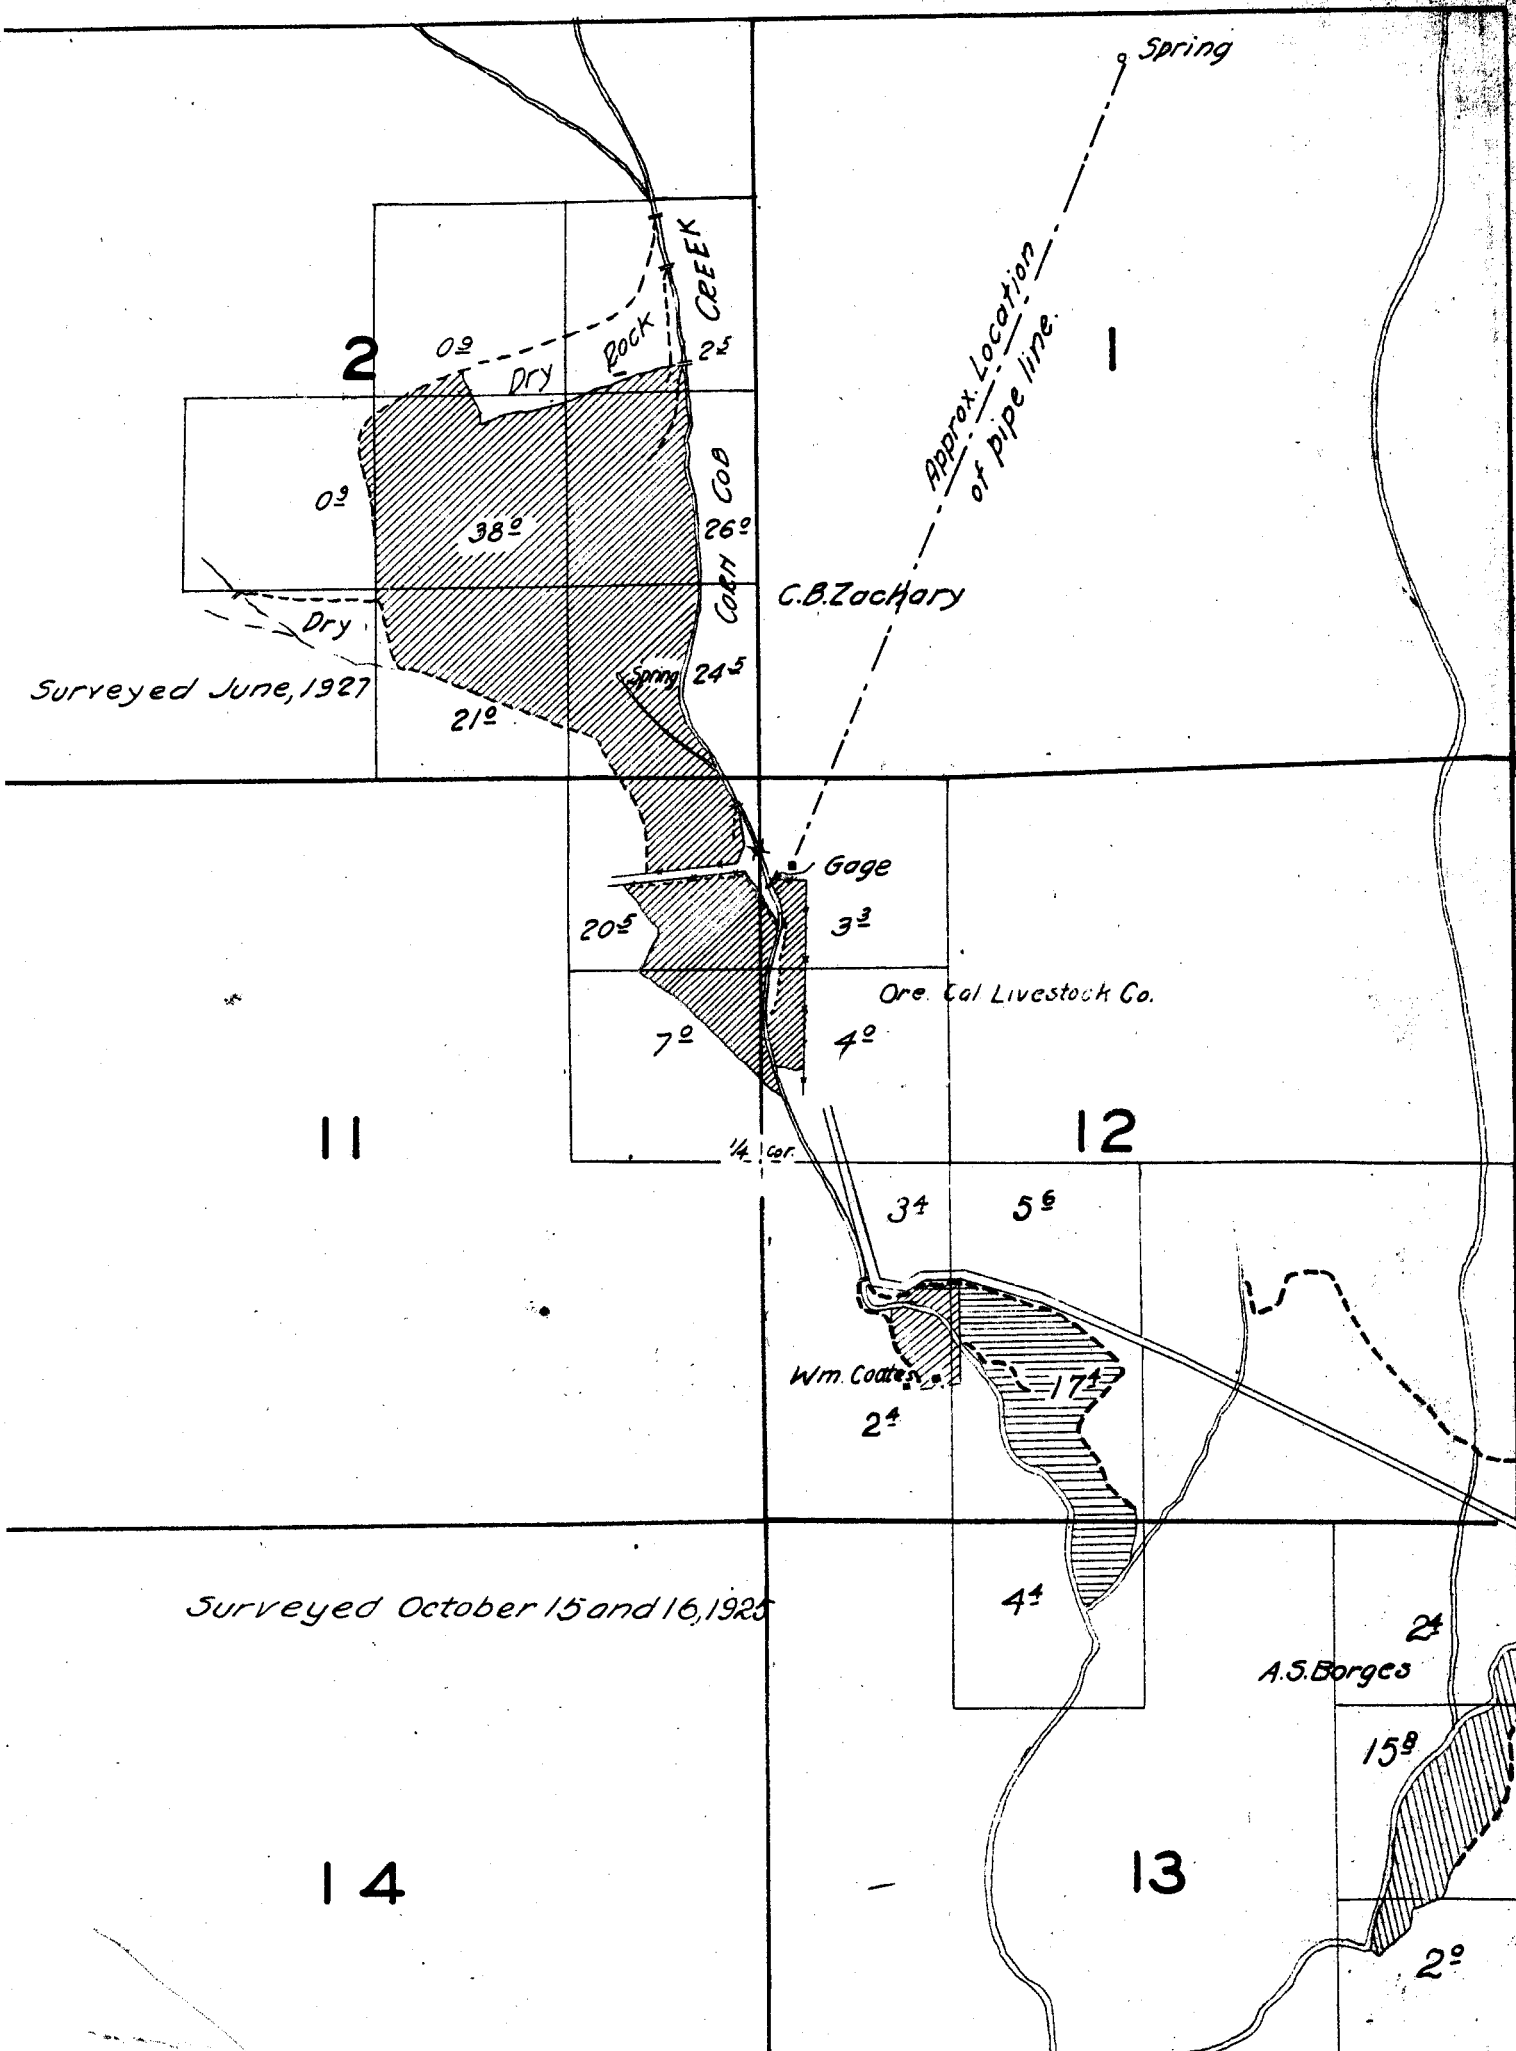

Elmer McQuinn

6

Lot 4

20'

3'

5

Spring
Mrs Elmer McQuinn

24'

2'

1'

35'

Lot 1.

1'

ALDER

Lot 2.

01'

4'

0'

7

Lot 3.

13'

4'

Lot 4.

CREEK

Surveyed October 16, 1925.

8

18

17

30

Note: Streams and Rivers except in the vicinity of irrigated land, sketched in approximate location.

29

28

32

33

31

MATHIS

Surveyed Oct 29, 1925

0-1

Mrs Mary Adams

Spring

Baugh

18

17

16

19

20

21

Surveyed October 15 and 16, 1925

15

14

13

22

23

24

A.S. Borges

Amos Hawks

4⁺

15^g

2°

2⁺

5²

50

15

22

16

21

15

Surveyed October 21, 1925.

14

13

Surveyed October 19, 1925.

23

Mrs. Nettie Hunt

22

30

02

22

23

24

J. R. Britt

10













27

Surveyed October 14, 1925.

26

25

34

35

36

Surveyed October 13, 1925.

ALDER CREEK

03

Merritt Frost

62

15

6

5

Lot 1

Lot 2

Sage Brush
and
Junipers

Surveyed Oct. 28, 1925.

7

8

19 4³
Sub-irrigated from
springs and ditch.

4⁰

14¹ Oregon and California Livestock Co.
CL Jamison

Lot 3

18


17

2

Peter Hartman
Surveyed Oct. 15, 1925.

Spring.

2⁸

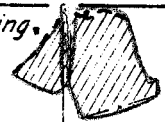

7⁸

Lot 2.

Lot 1.

1

Spring

1³



Spring

11

Spring

2⁸



Ralph + Ray Nash

12

3⁷

2⁷




Surveyed Oct. 16, 1925.

9⁷

1⁹

7⁸

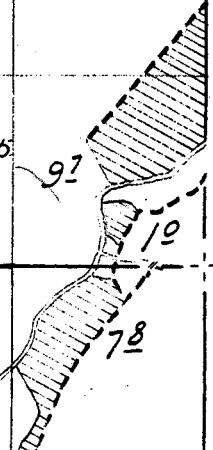

14

13

18

17

16

Oregon-California Live.

19

20

21

30

29


28

*Note: Streams, except in the vicinity
of irrigated land, are sketched in
the approximate location.*

31

32

33

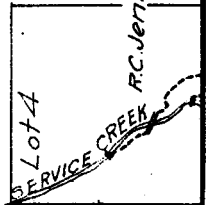


Surveyed Oct 26, 1925

—
67

Surveyed October 21, 1925.


22

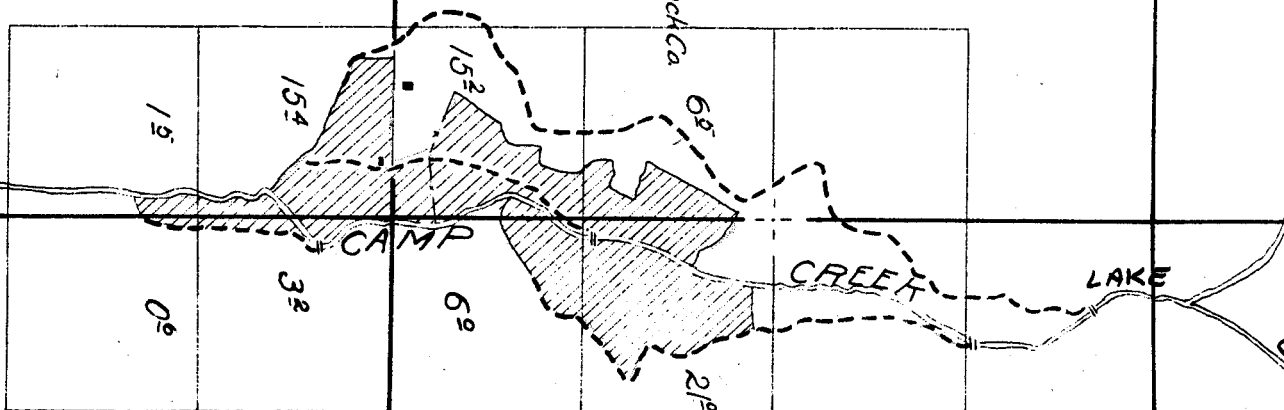

J. R. Britt



TOWNSHIP 8 S. RANGE 23 E.

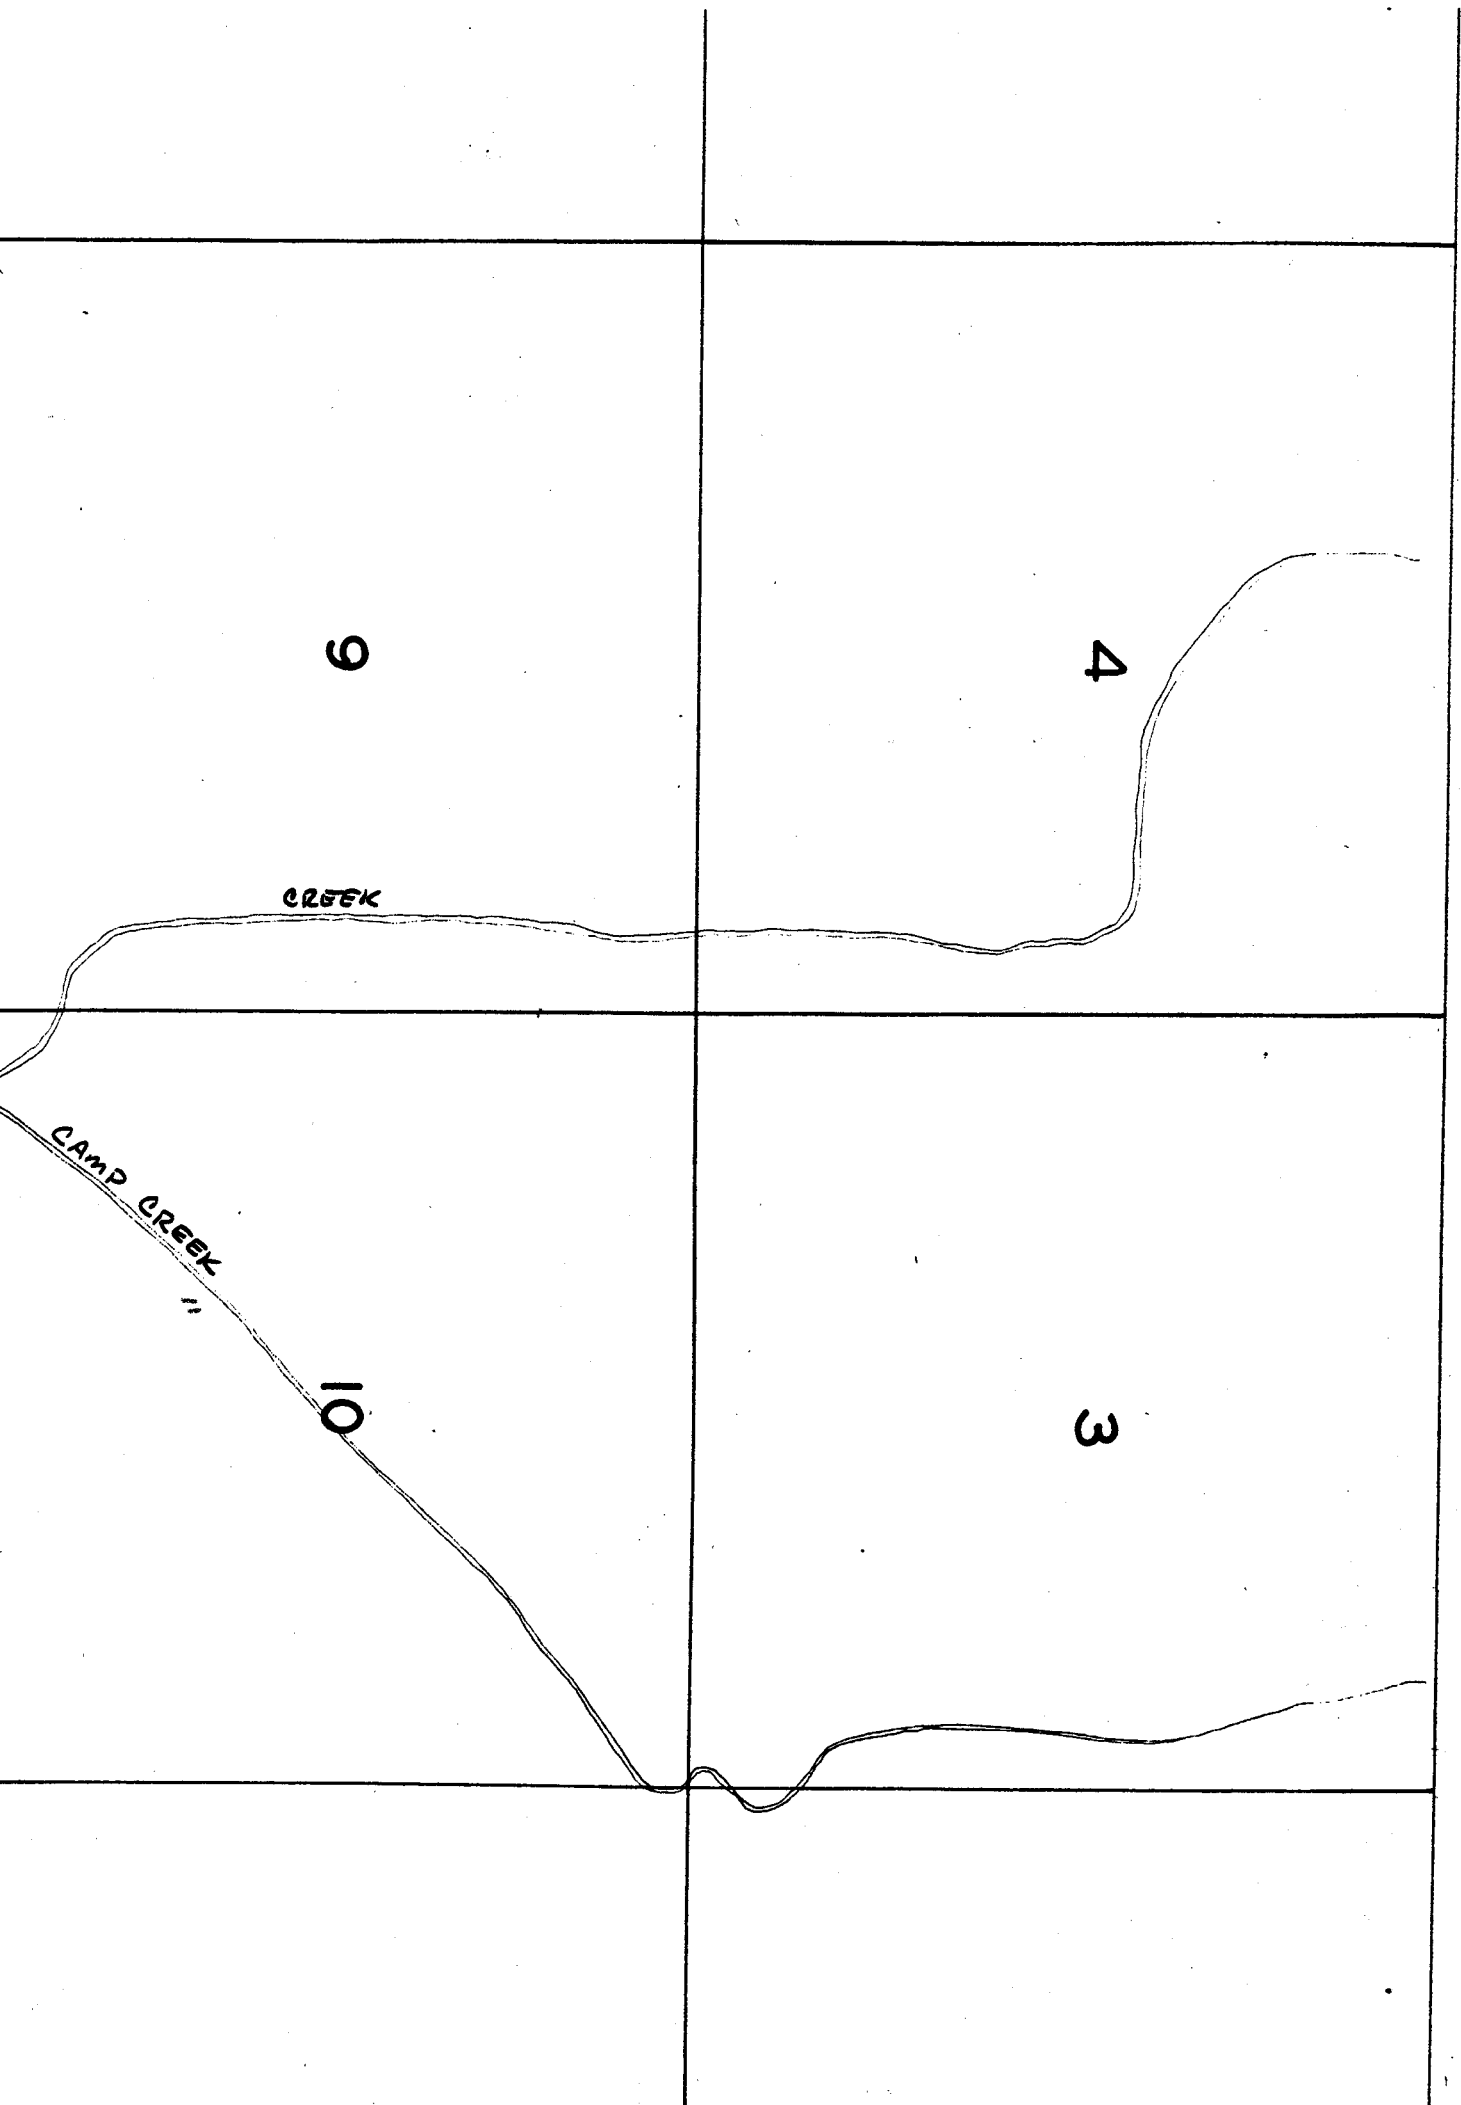

21

22

J.R. Britt

28

27

LAKE CREEK

33

34

