

2

1

Lot 7

Lot 1

Lot 2

LITTLE SERVICE

Rocks Sage Brush

12


11

Oregon-California Live Stock Co.

Surveyed Oct. 27, 28, 29, 1925.

14

13

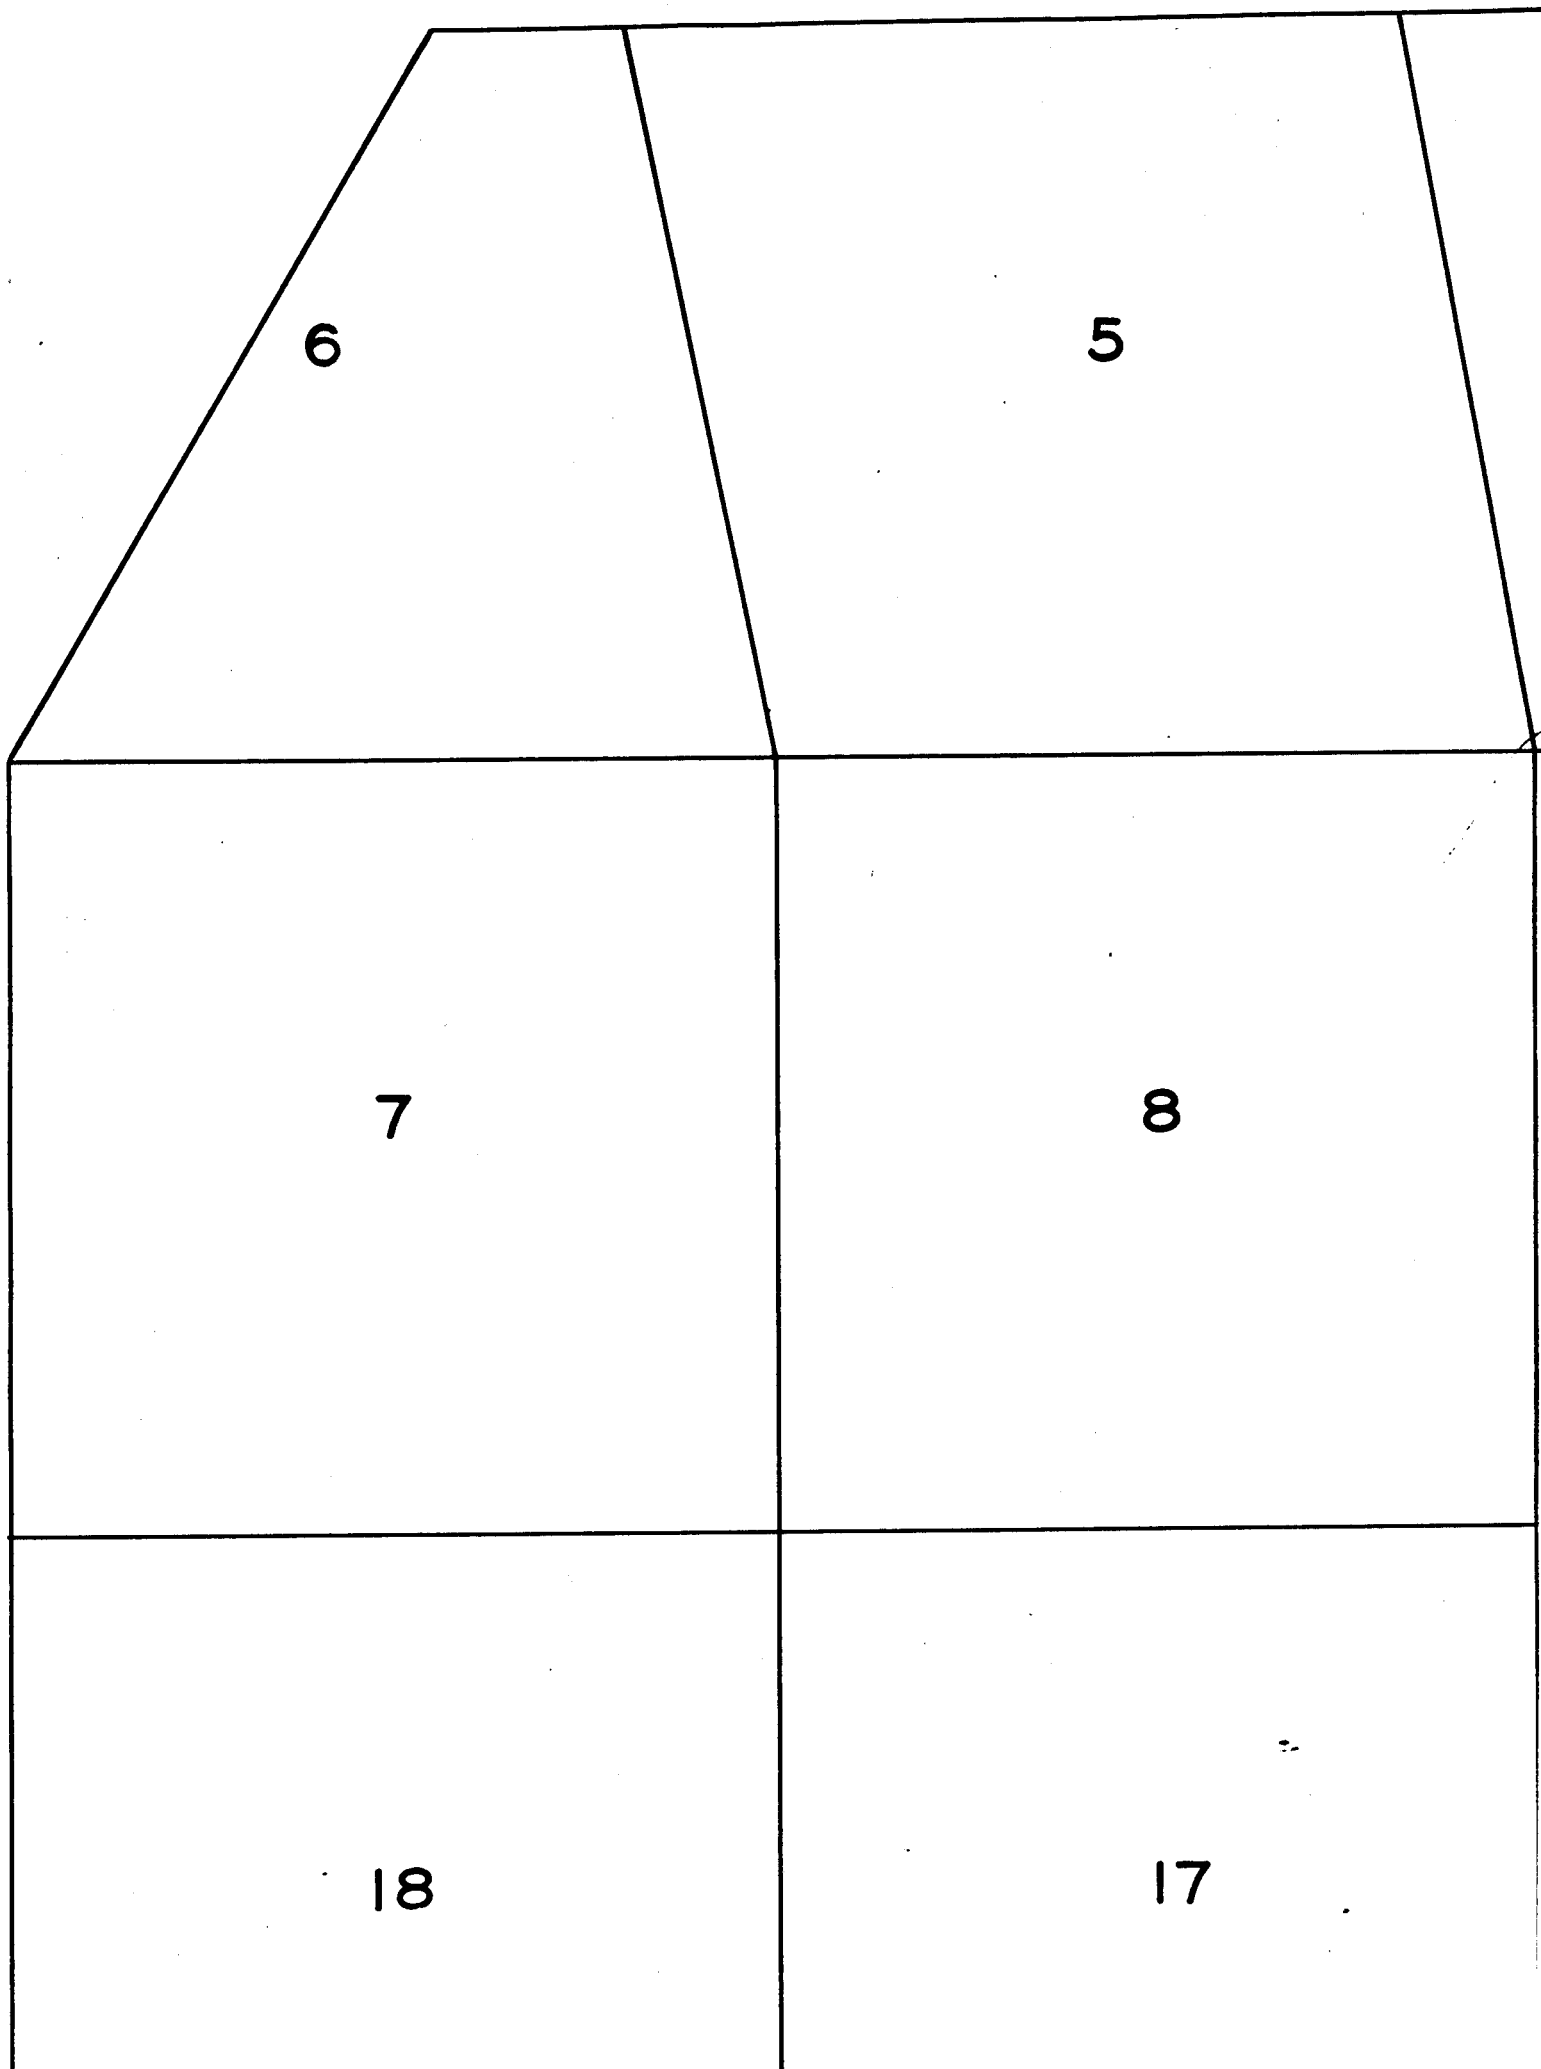

6

5

7

8

18

17

21

22

28

27

33

34

27

26

25

34

35

36

SERVICE

R.C. Jenkins

Oregon-California Live Stock Co.

CREEK

John Day Highway

R. Parrish

Surveyed Oct. 27, 28, 29, 1925.

15

14


13

ms, except in the vicinity
of land, sketched in
location.

22

23

24

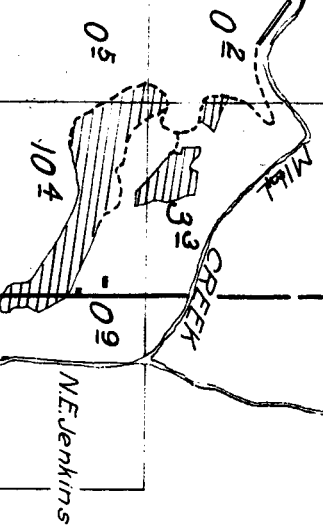

30

29

28

31

32

33

18

17


16

19

20

21

TOWNSHIP 8 S., RANGE 22 E.

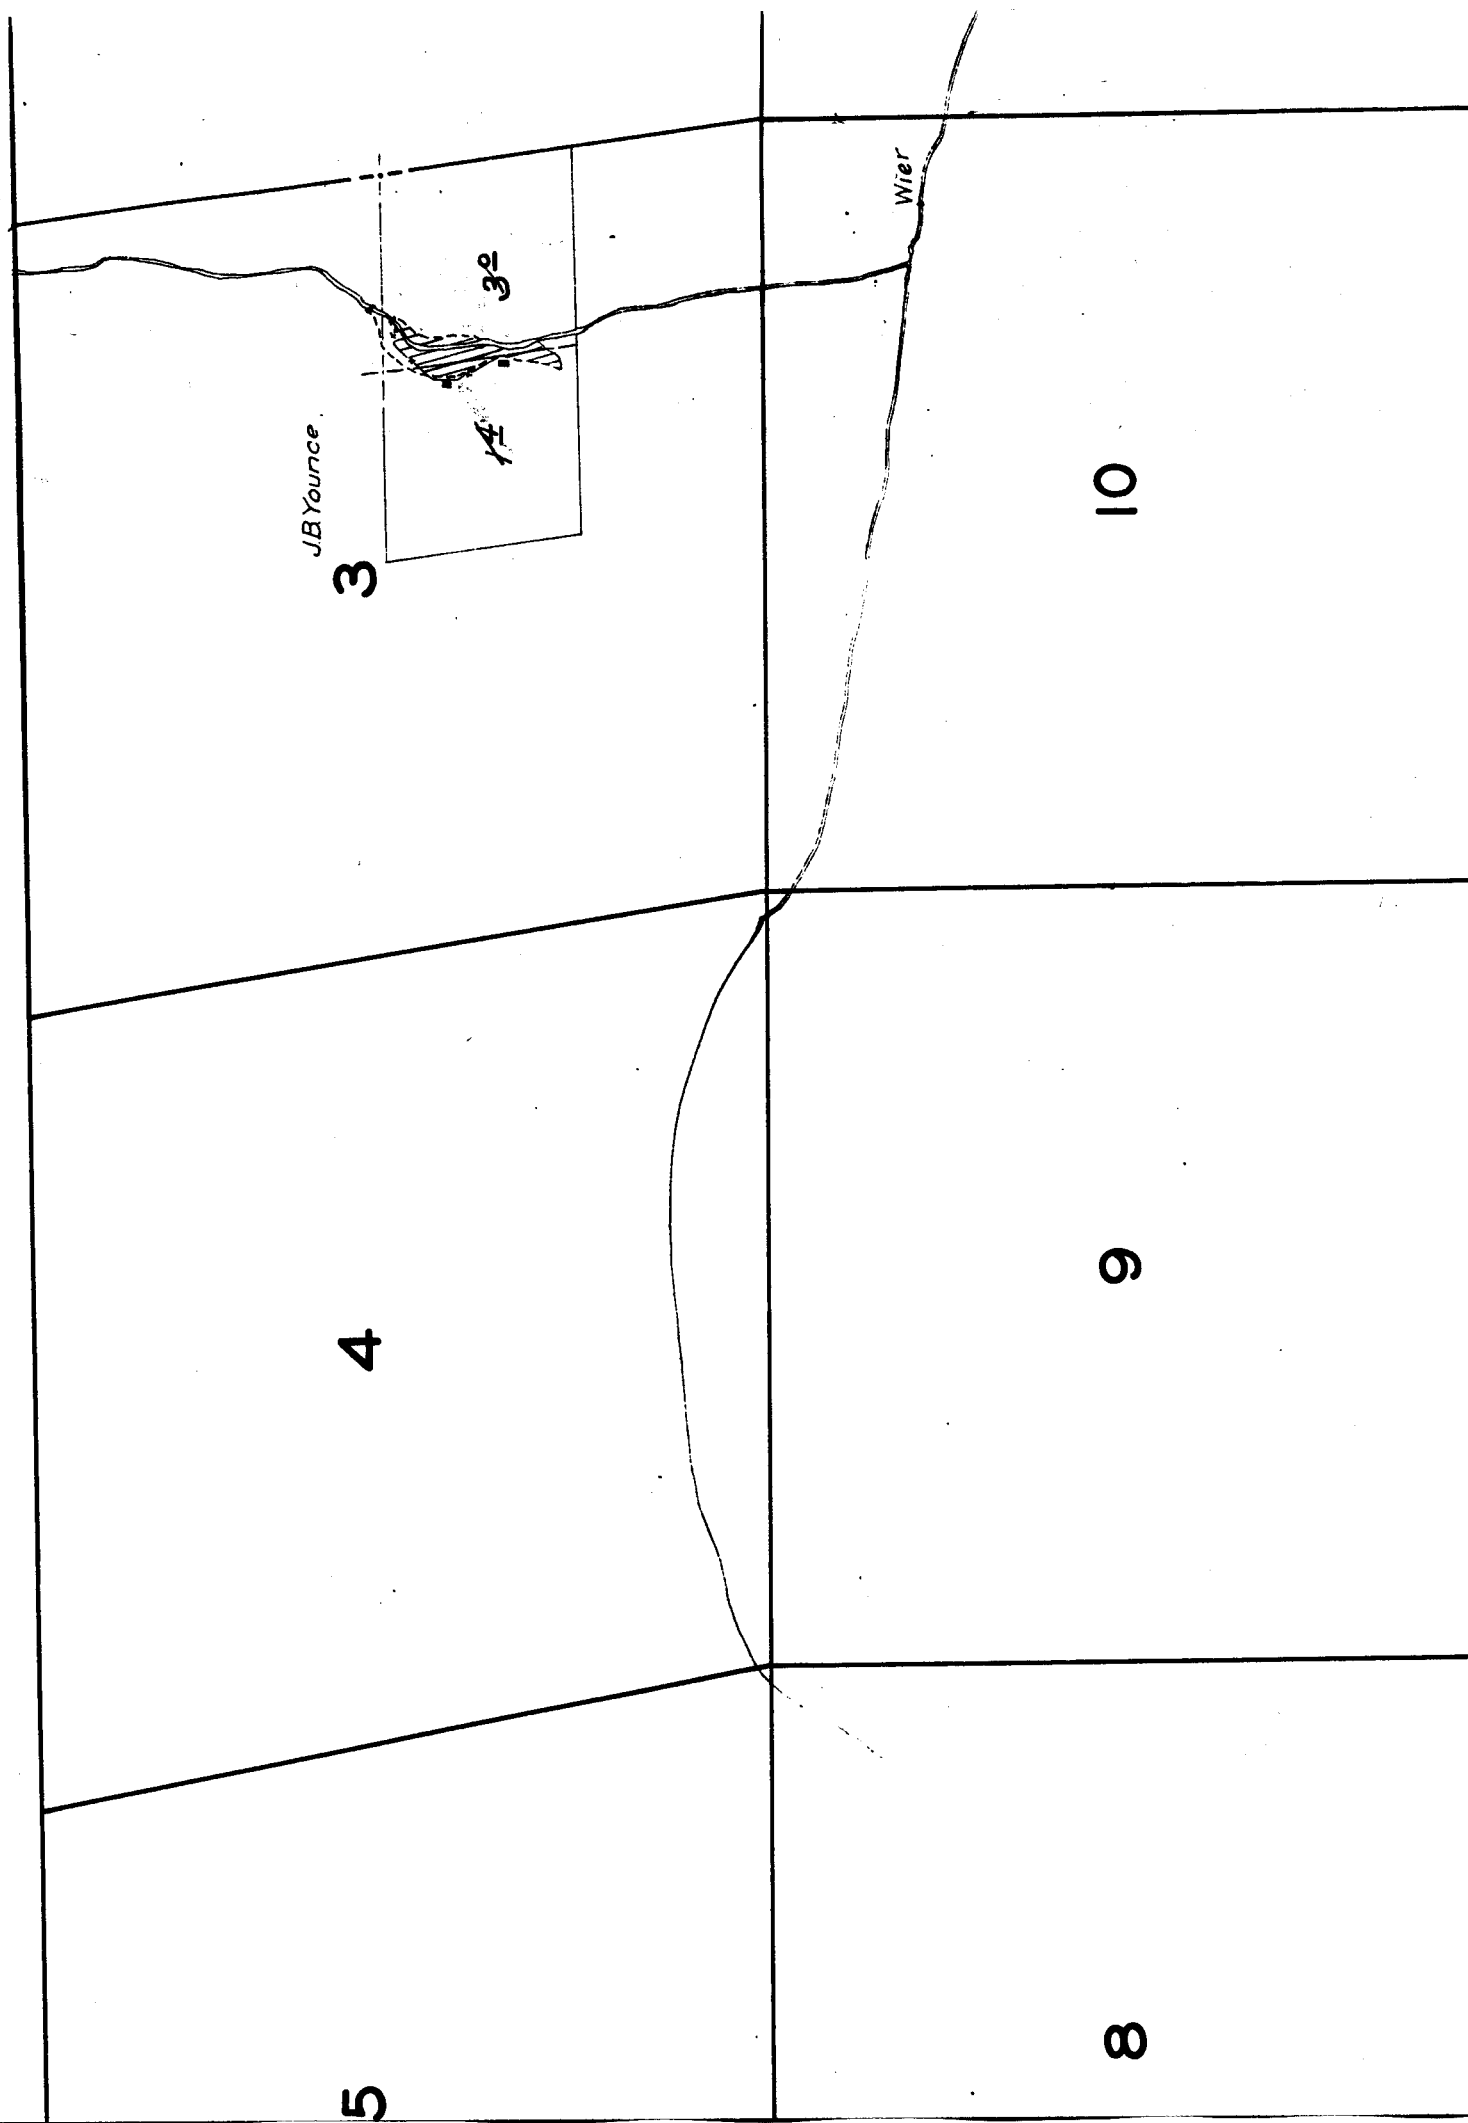

Surv.

17

16

15

Note: Straums, except in the vicinity
of irrigated land, sketched in
approximate location.

20

21

22

