

2

1

11

12

14

13

21


22

NOTE: Streams sketched in approximate location except in the vicinity of irrigated land.

28



27

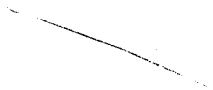

33

34

Surveyed Nov. 14 to 18, 1925.

16

21

17

20

CREEK .

FORK

WEST

18

19

x

28


33

29

32

30

31

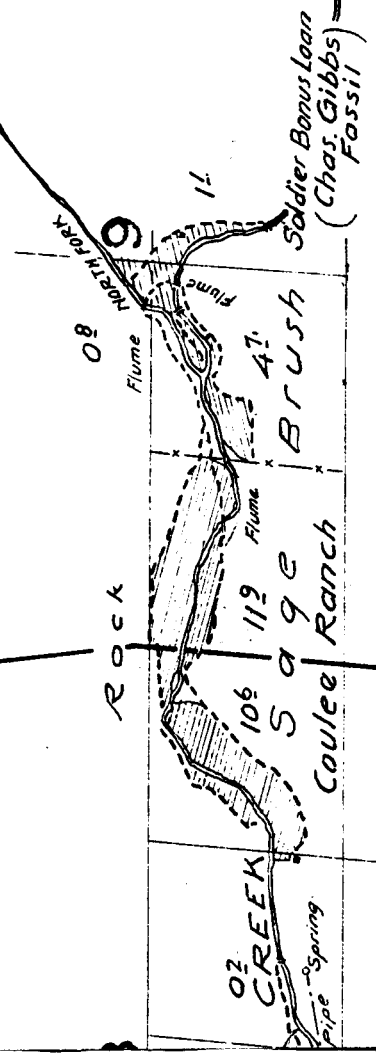

Stock Co.

x

Surveyed Nov. 14 to 19, 1925.

16

24

18

Wm H. Higgins
(Ad. Cornett)

15

41

Arthur Penrecoast

05

Flume 1

50

Schoec

21

22

NOTE: Streams sketched in approximate location except in the vicinity of irrigated land.

5

8

Hand-drawn map of West Fork Ranch and Butte Creek Land. The map shows a winding creek with several labeled points: 10, 11, 12, 09, 55, 1/4 Pipe, Flume, and a Dam. A dashed line indicates a boundary or path. The text "West Fork Ranch" and "Butte Creek Land" are written across the map.

A hand-drawn map on a grid background. The map shows a winding line representing a creek or path. To the left of the line is the word "BUTTE". Above the line, the word "Rock" is written in large letters, with "09" below it. To the right of the line, the word "CREEK" is written in large letters, with "02" above it. Further right, the word "Spring" is written above the line, and "2" is written below it. To the far right, the word "Coule" is written. A dashed line runs horizontally across the middle of the map, with "1 3/4" Pipe" written below it on the left and "2" Pipe" written below it on the right. The number "10" is written to the right of the "CREEK" label. The number "5" is written to the right of the "Coule" label.

Rock Creek

BUTTE

09

02

10

5

1 3/4" Pipe

2" Pipe

Spring

Coule

Location of Pipe and Creek approximate


d, Lumber & Live Stock Co.


18

WEST

FORK

17

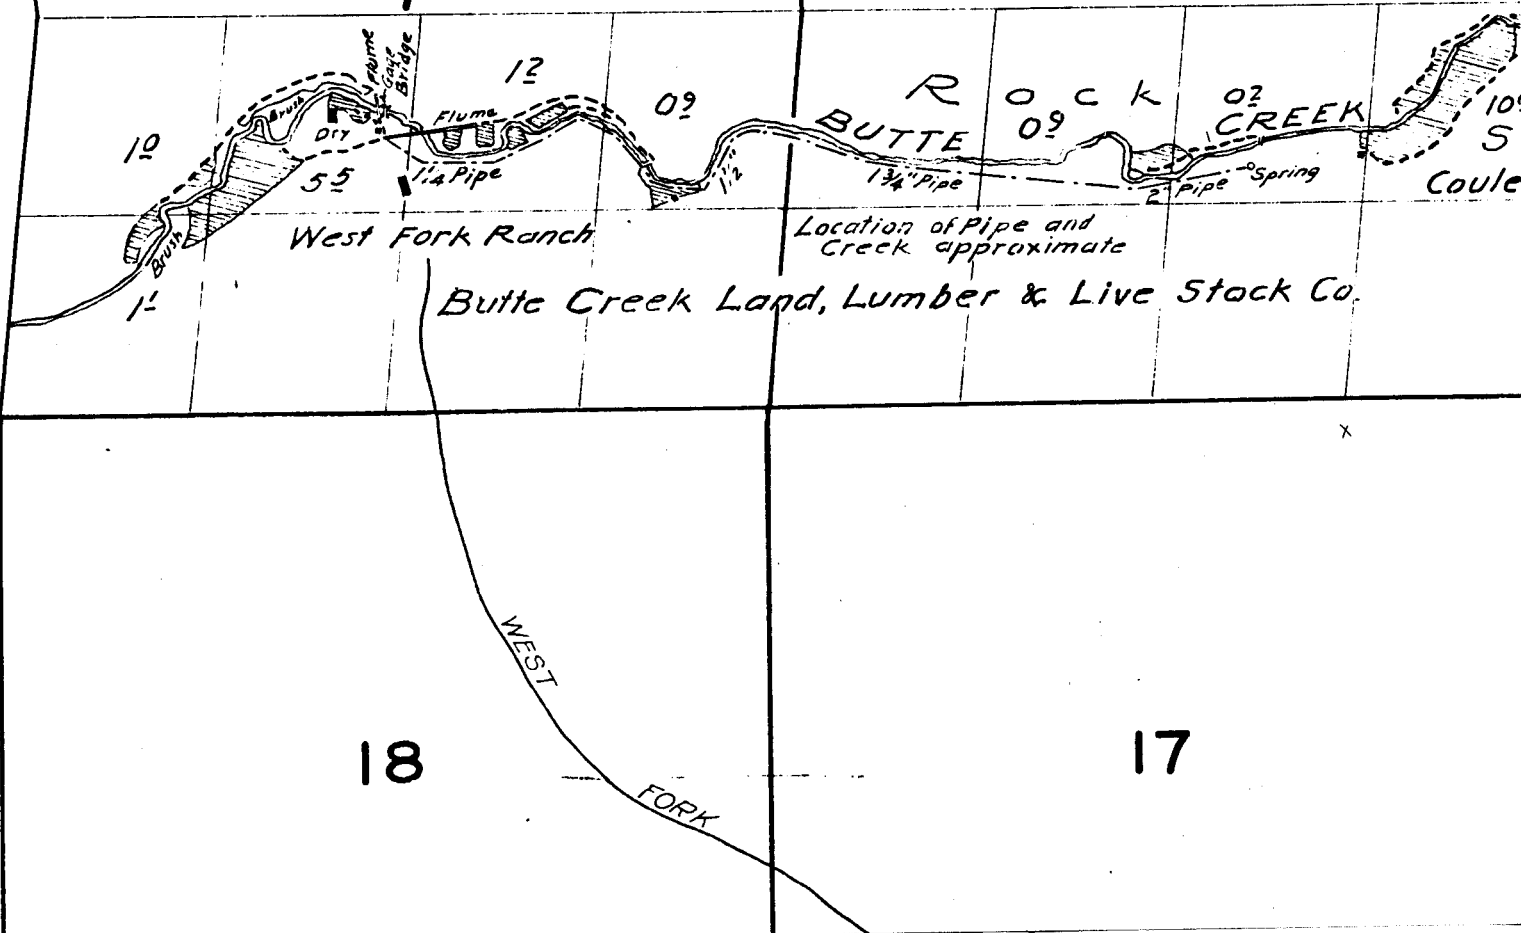

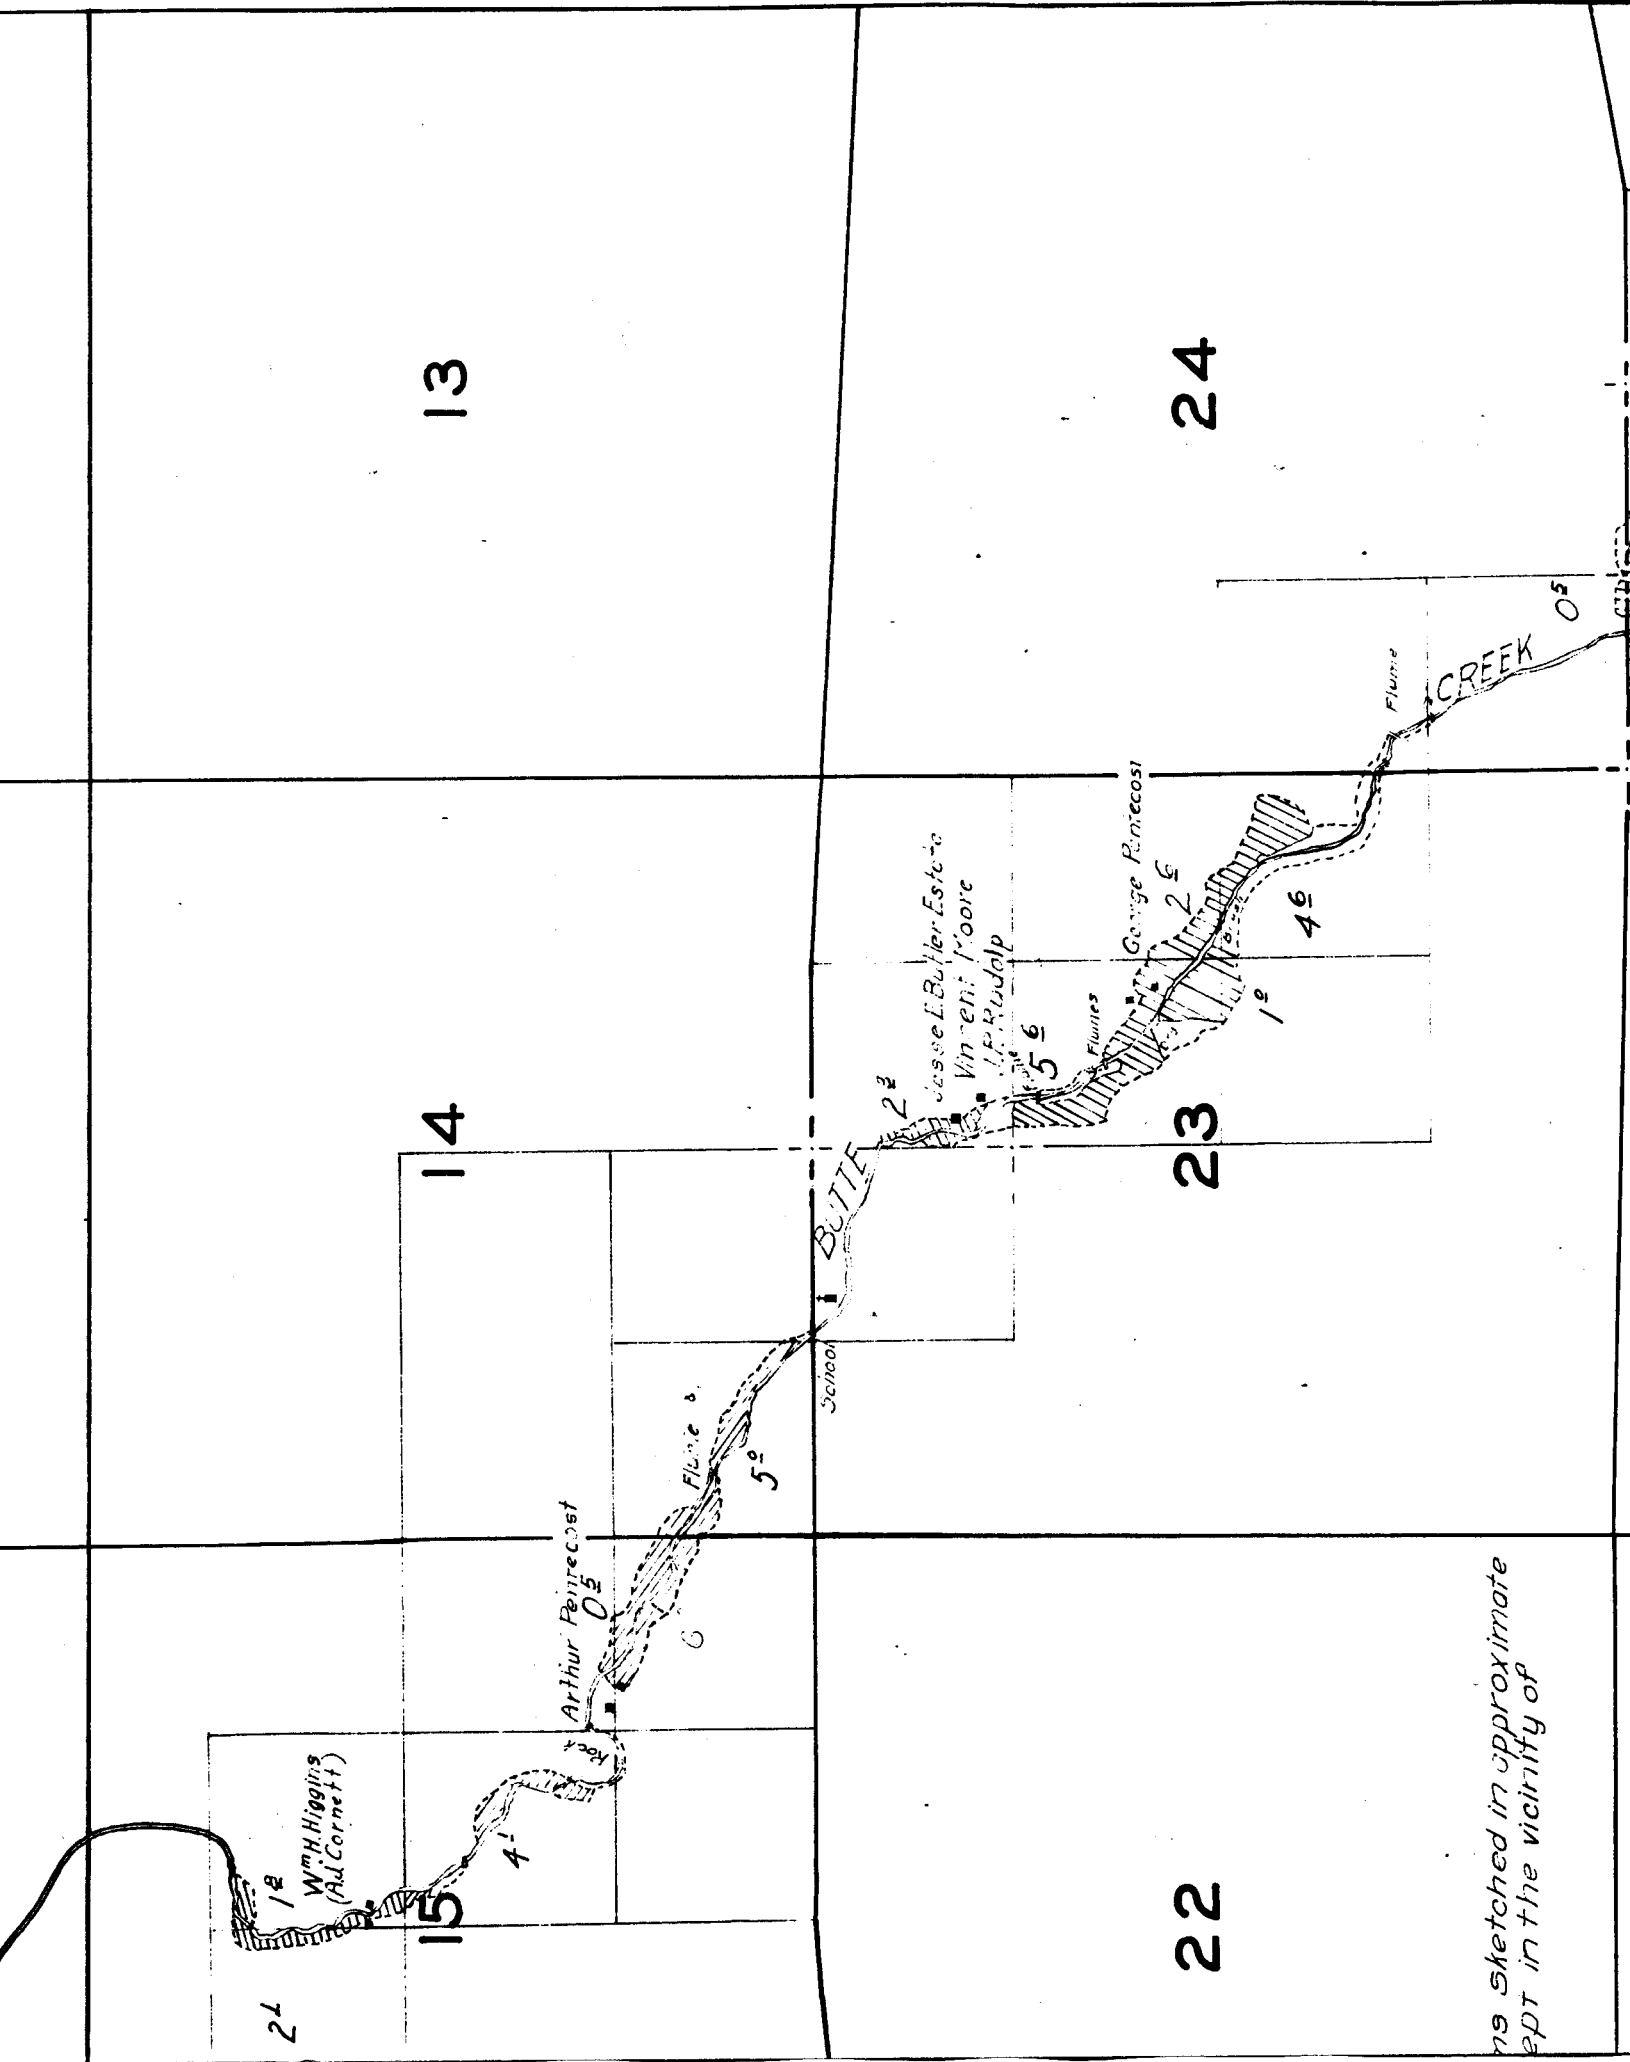

27

26

34

35

Stewer & Carpenter Bank

12

500 ft Pipe
Spring

36

Blunt Stamp Creek

25

23

35

32

10

Mrs Margaret E. Barnera
Clt Brown