

TOWNSHIP

6

5

4

7

8

9

	18	17	16
19	20	<i>Note: Streams, except in the vicinity of irrigated land, are sketched in approximate location.</i>	
		21	

7	16	15	

	27		34
	28		33

23

24

26

25

35

36

19

20

*Note: Streams, except in the vicinity of
irrigated land, are sketched in
approximate location.*

30

29

31

32

15


14

13

22

23

24

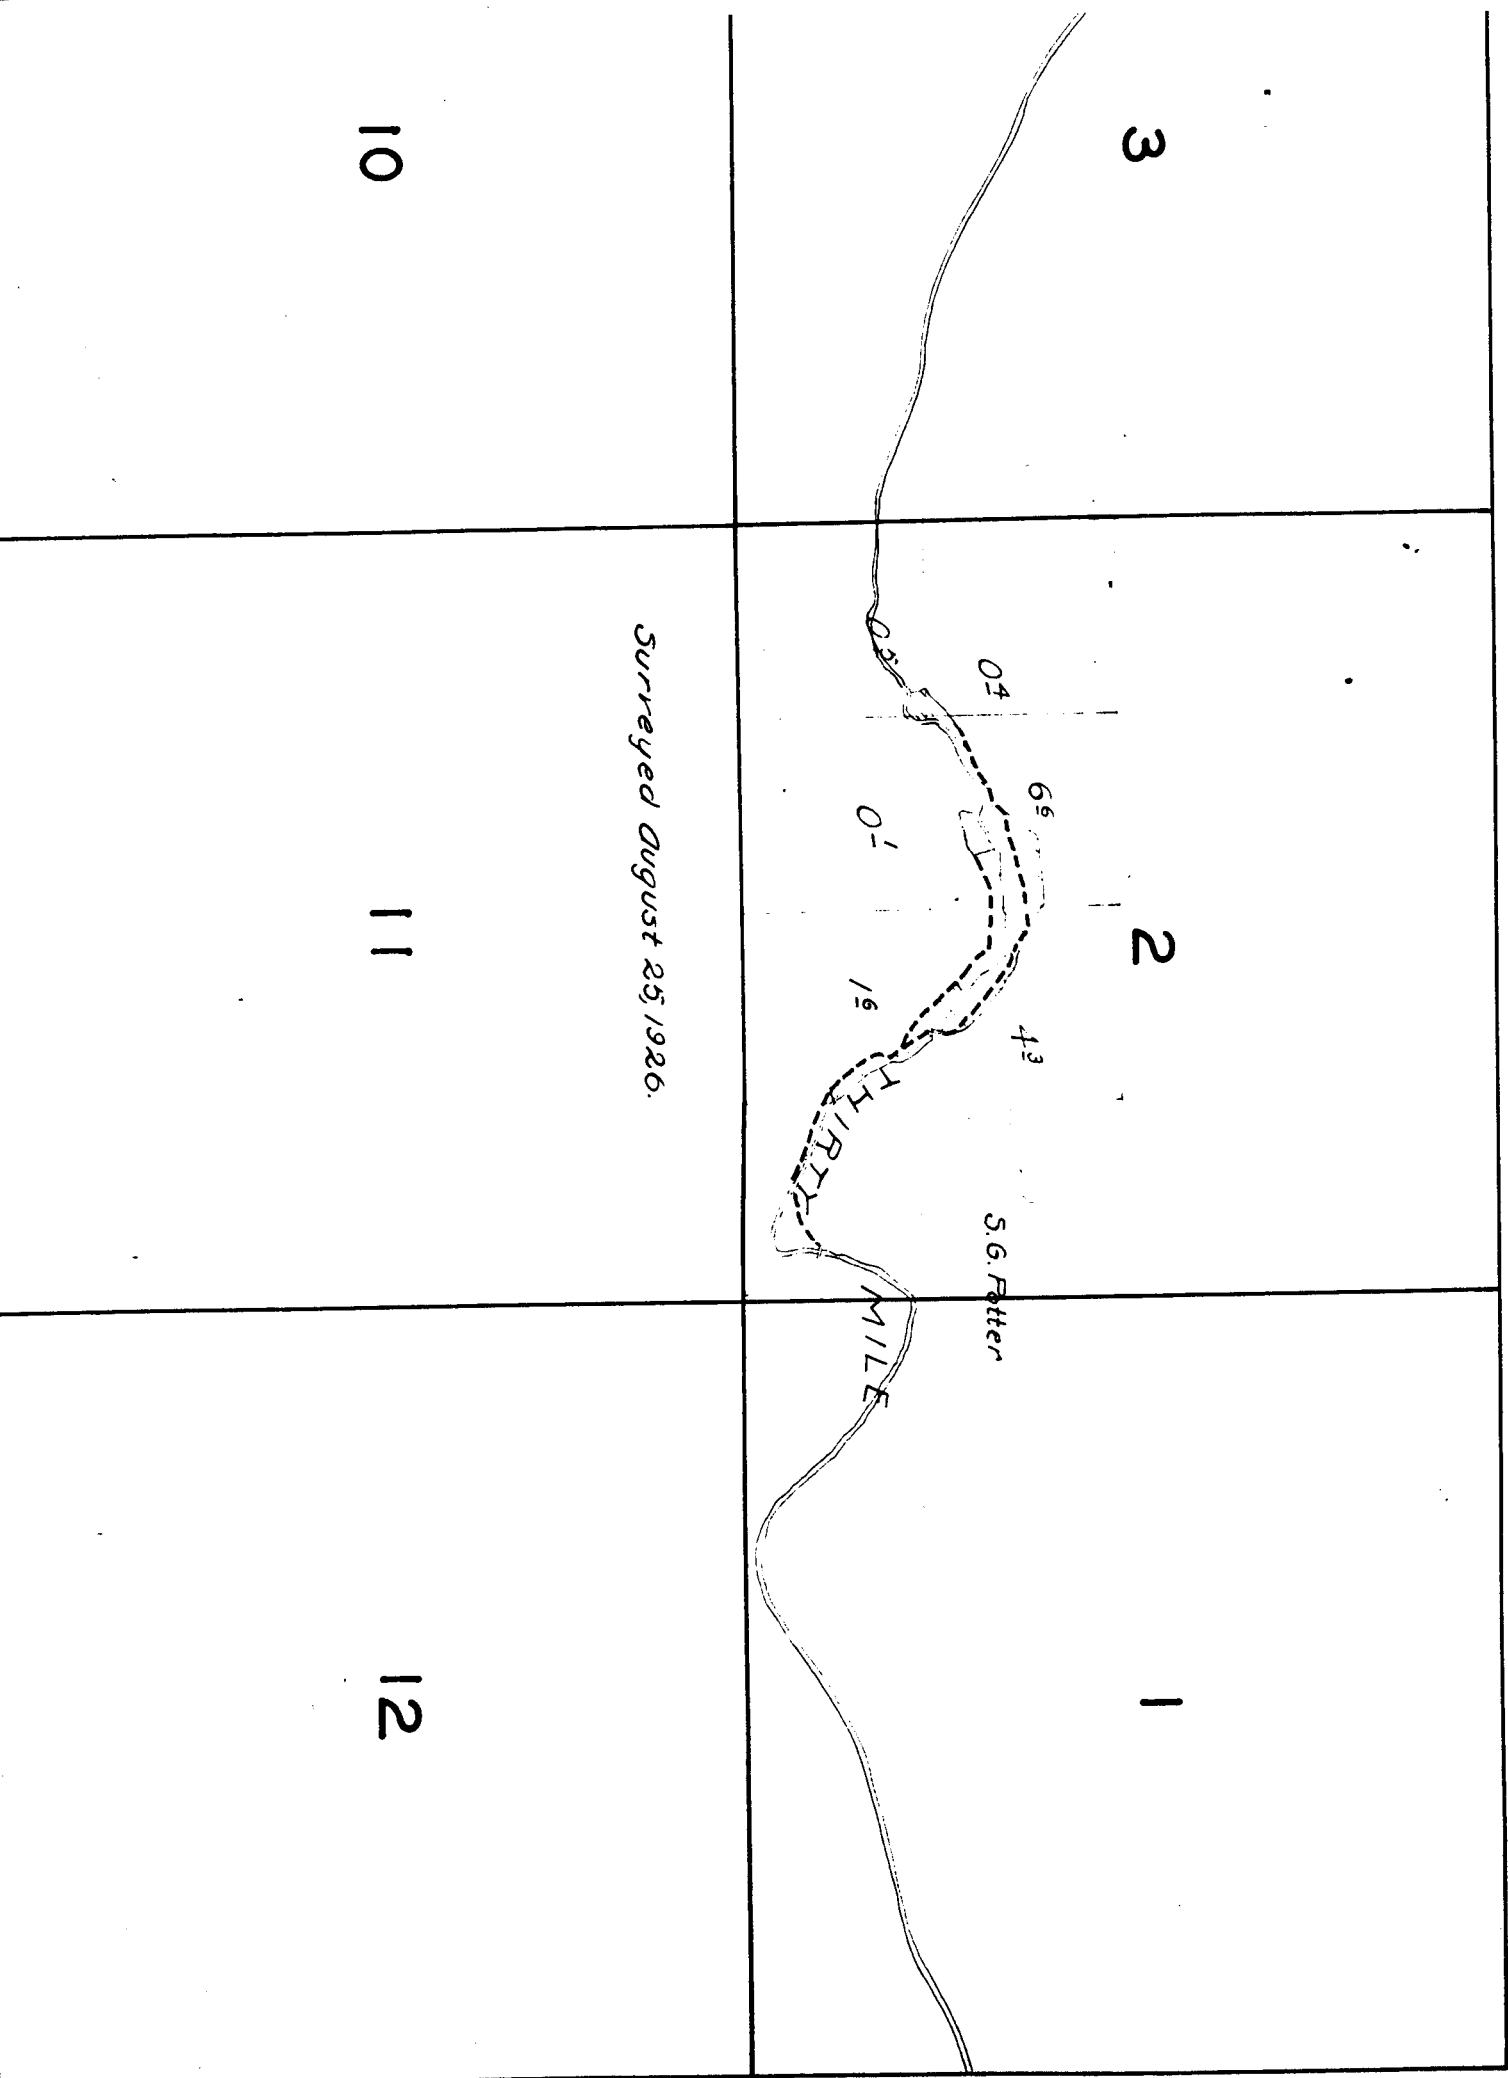

TOWNSHIP 5 S., RANGE 20 E.

