




Range 25 E.W.M.

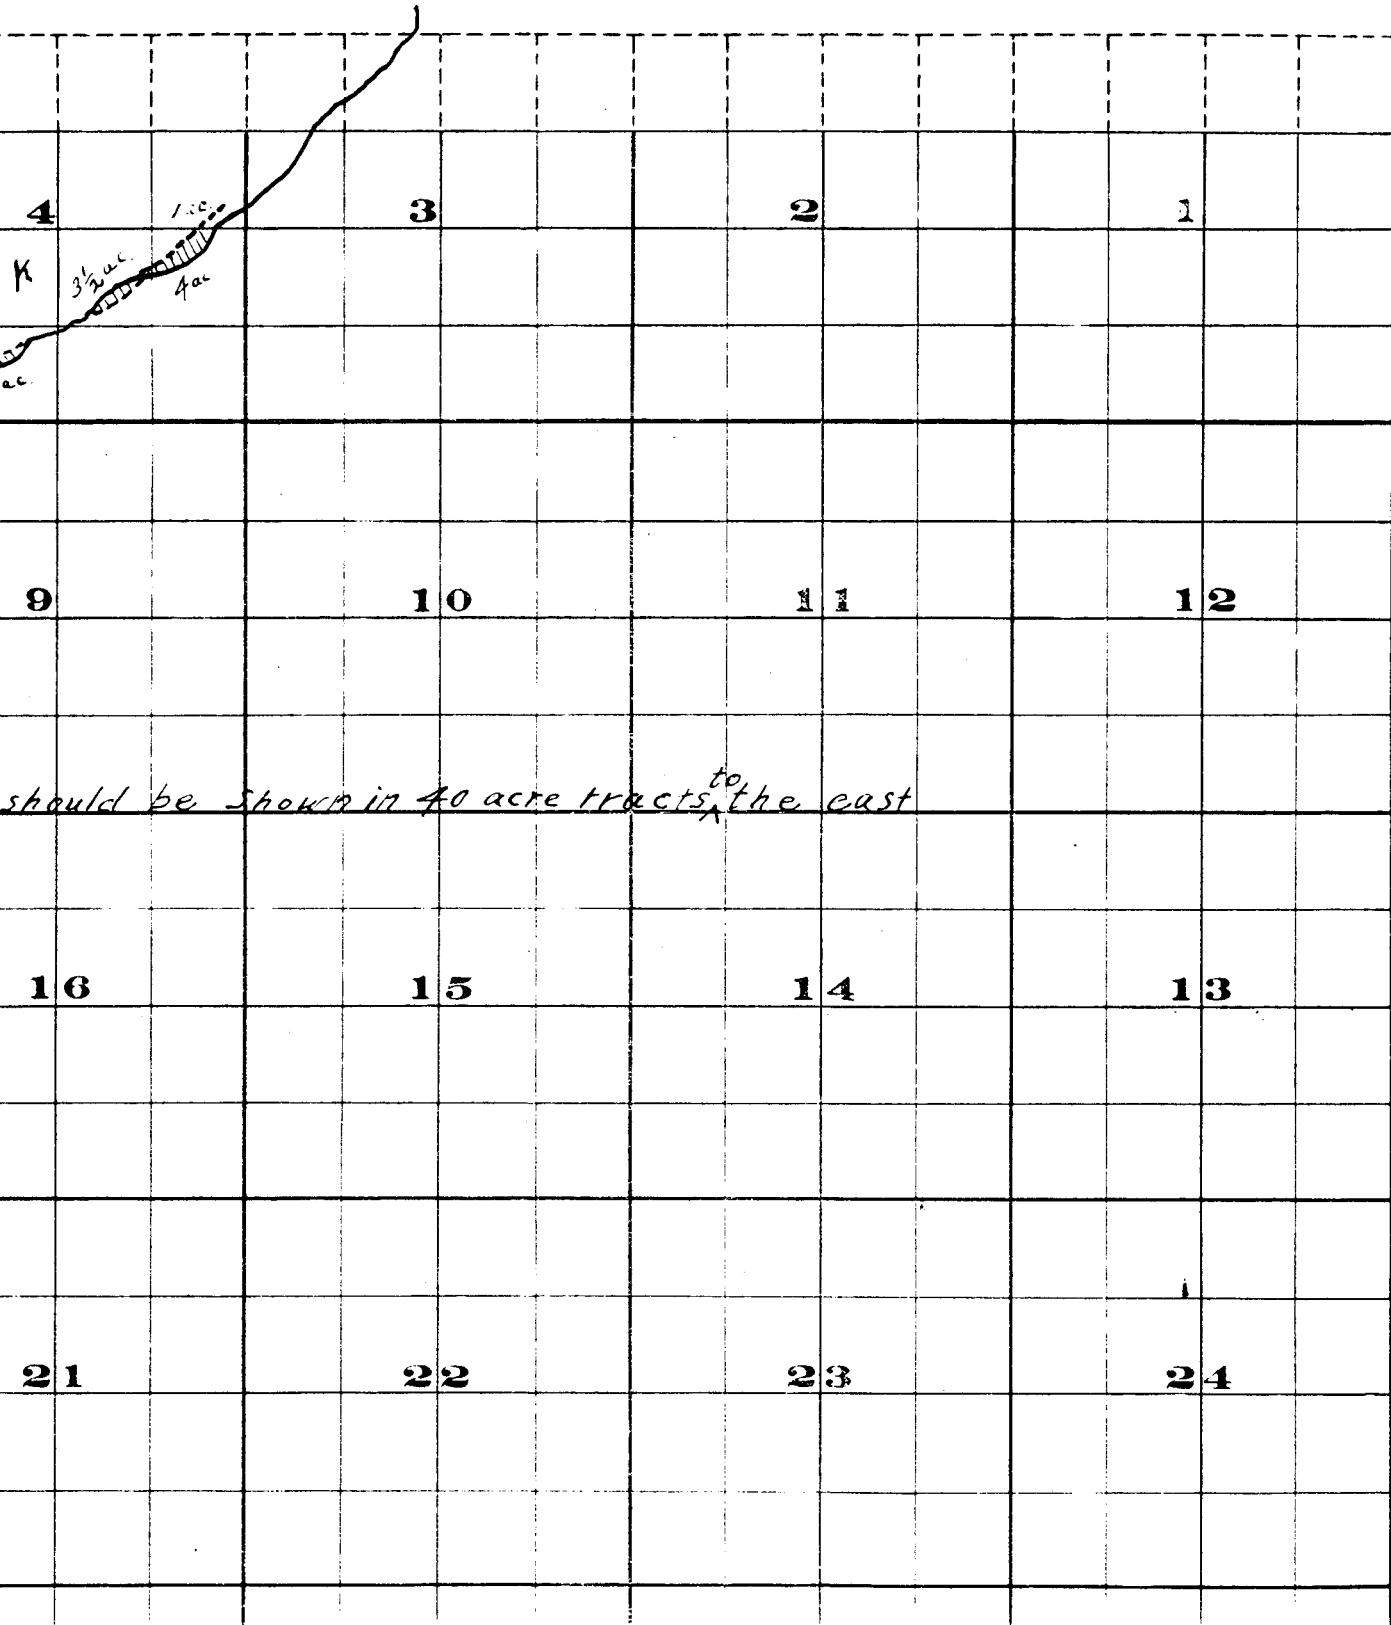

Township 4 S.

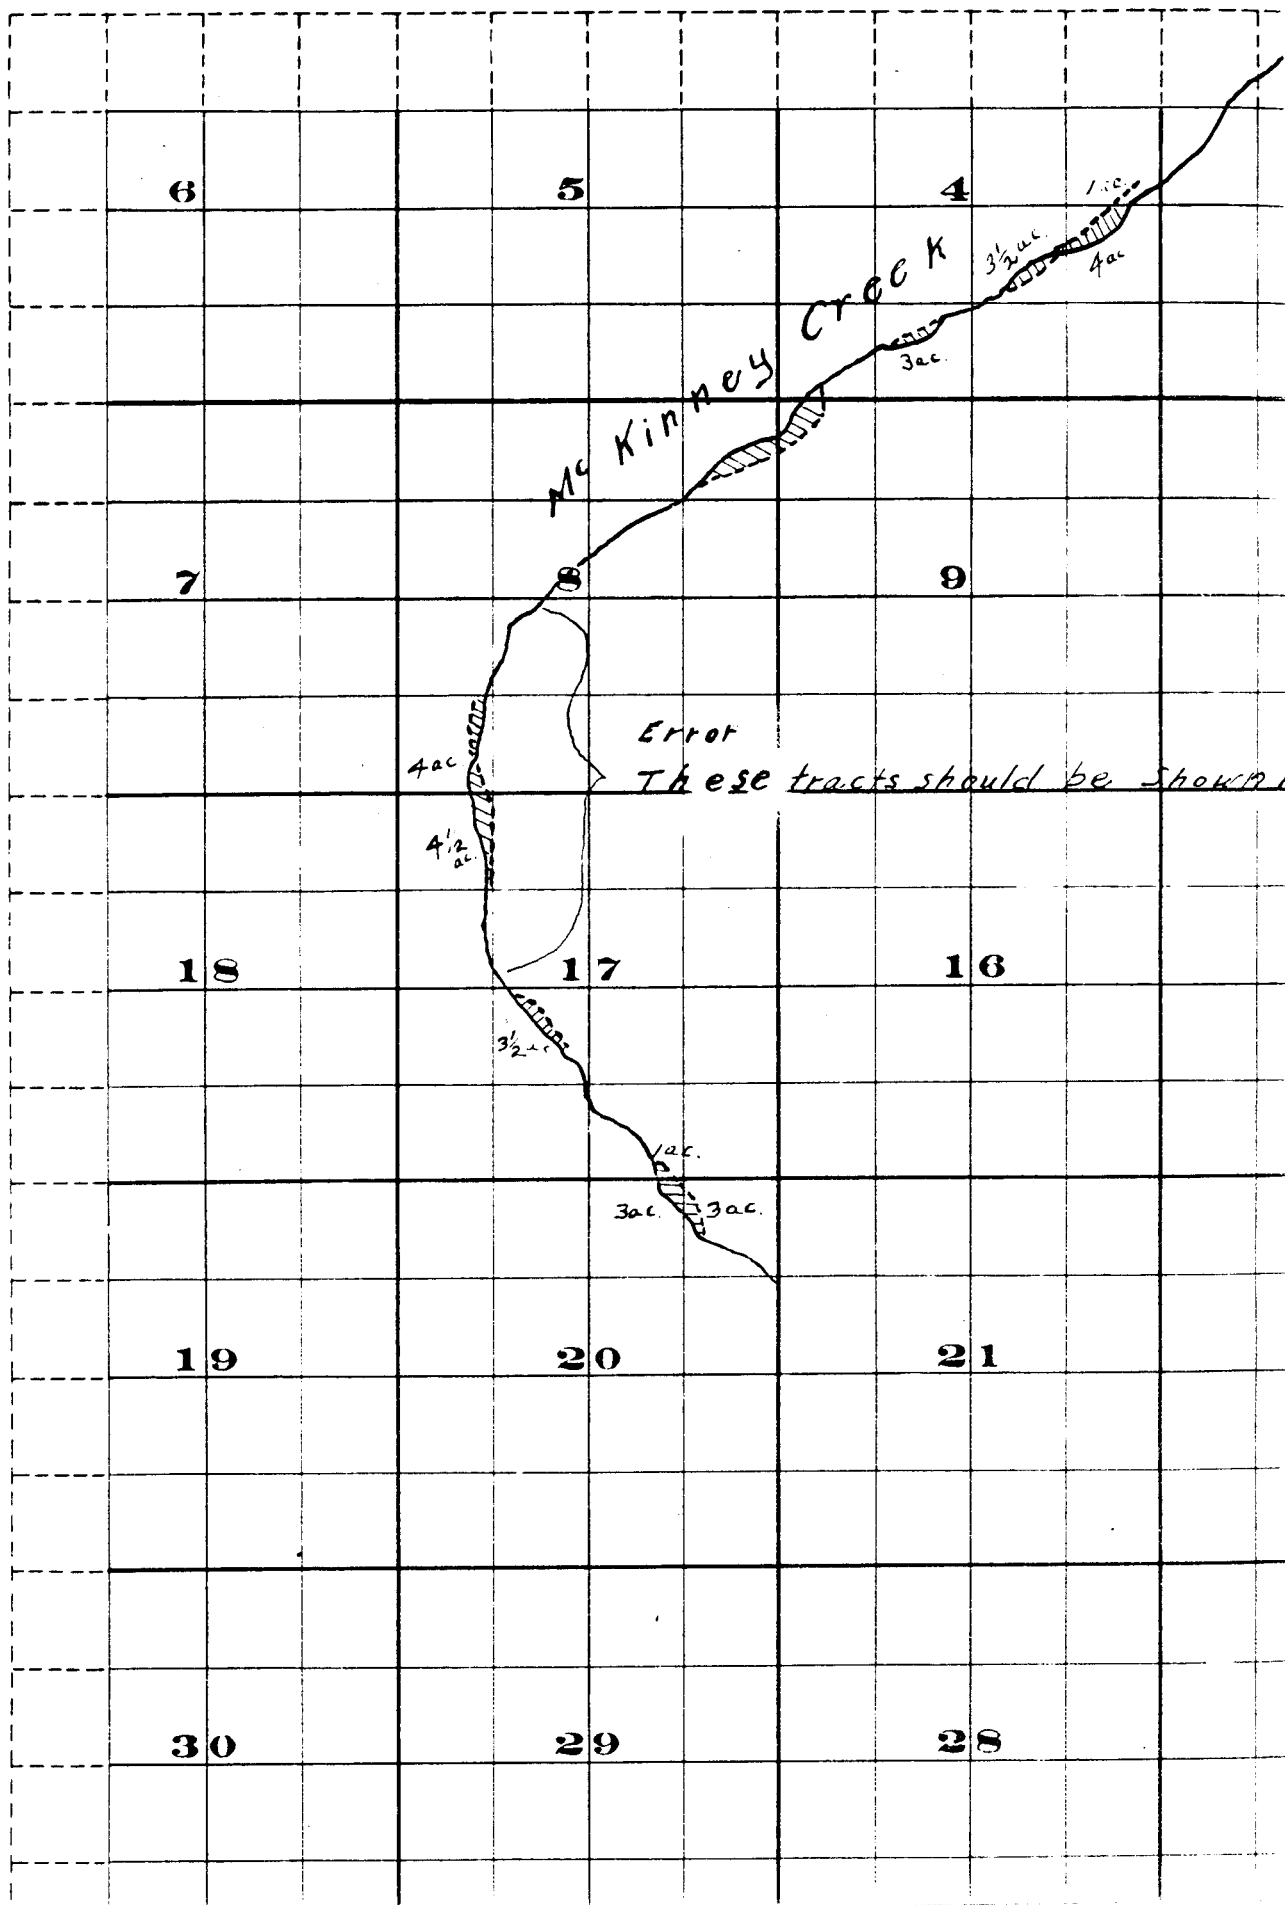

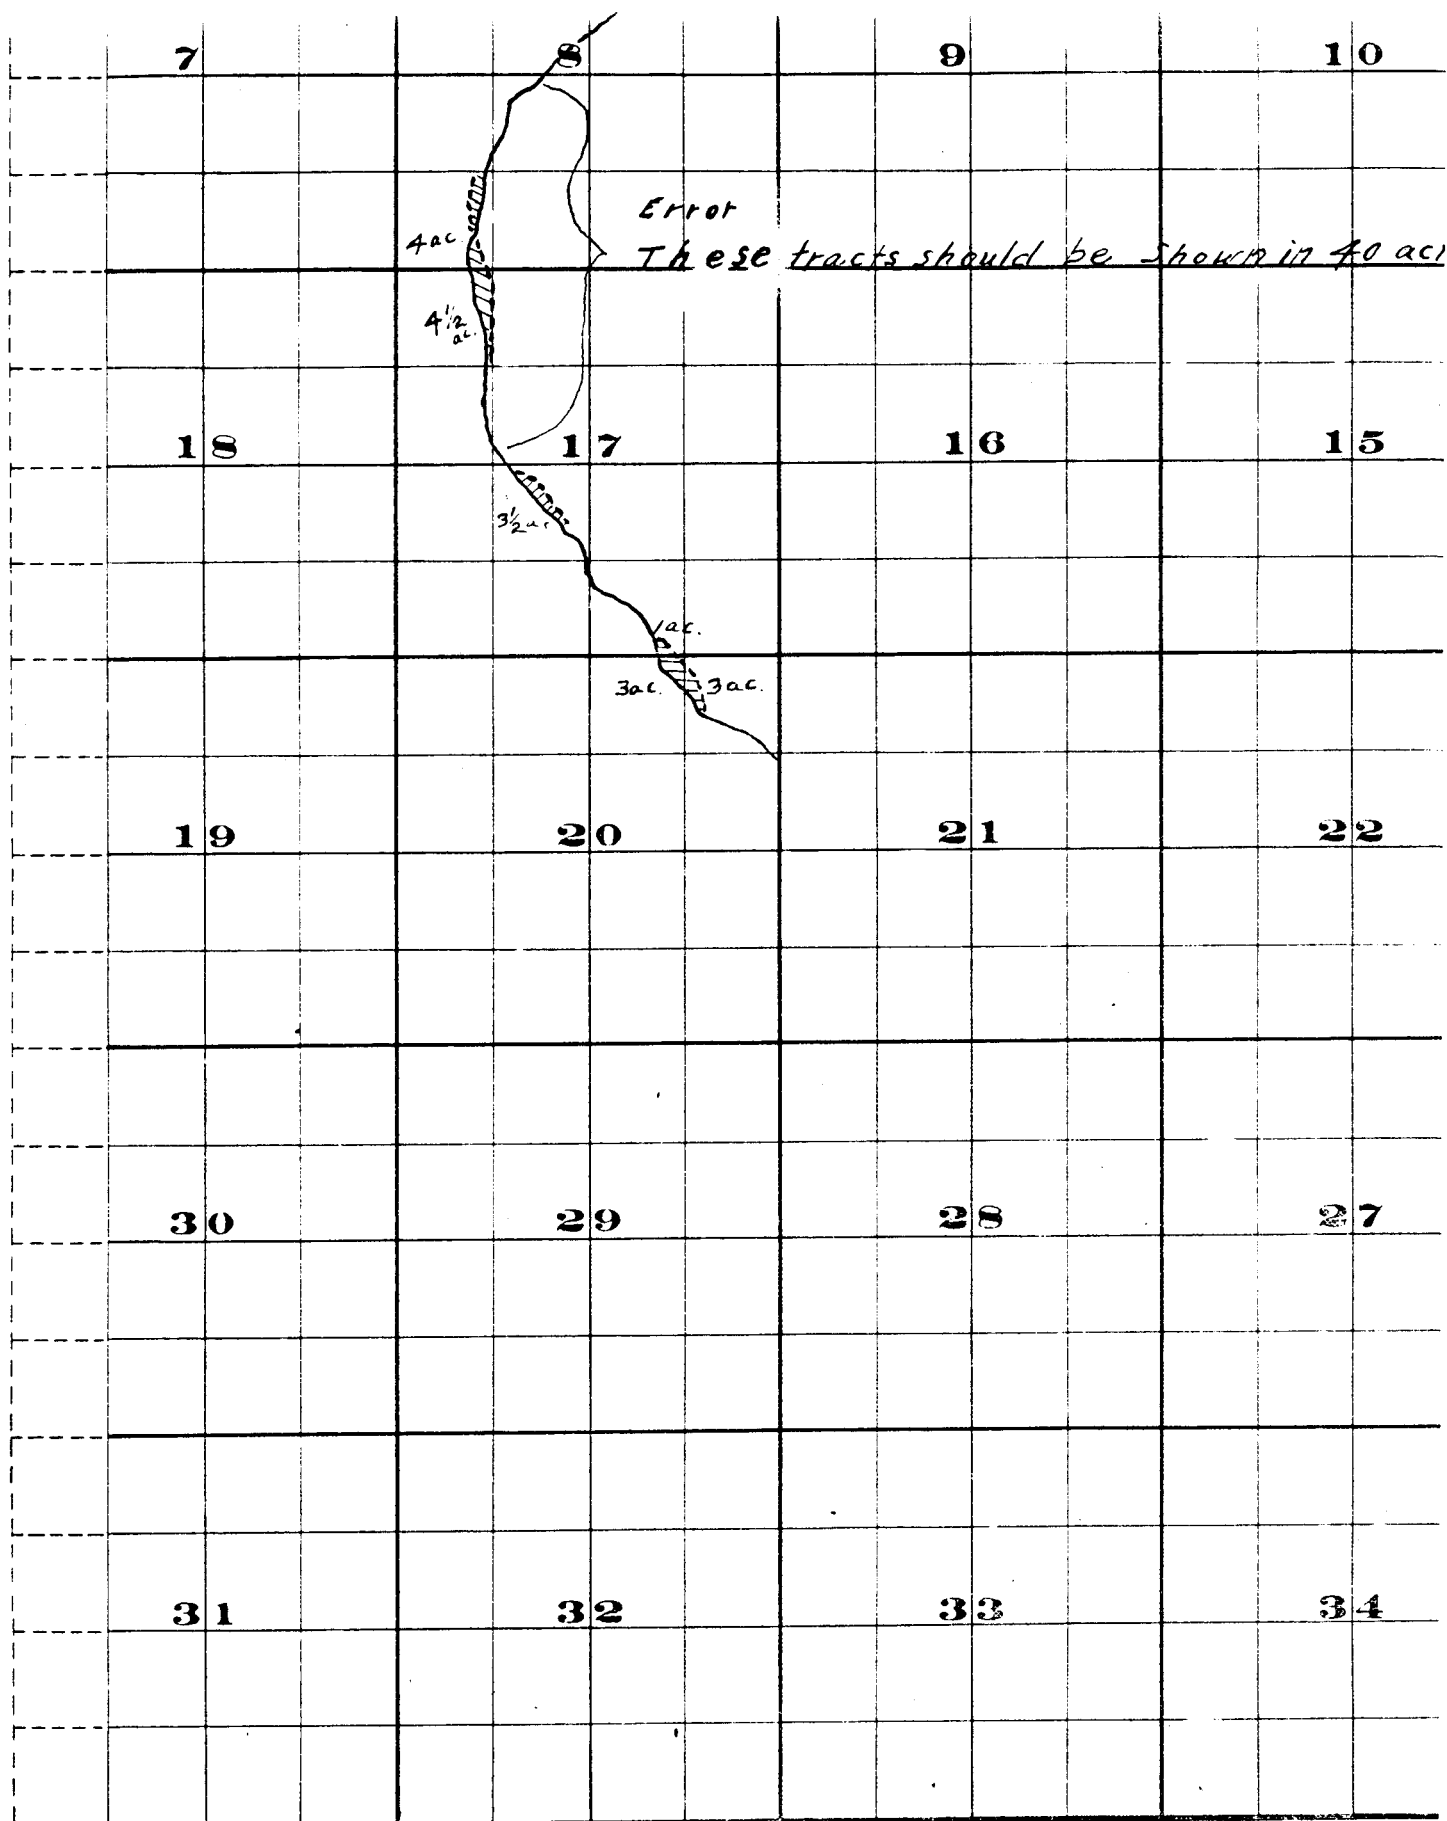

Surveyed by R.D. Cooper - July 1909
 John H. Lewis - State Engineer
 July 14, 1909 - Examined.

up in 40 acre tracts, ^{to} the east

15

14

13

22

23

24

27

26

25

34

35

36

FROM OFFICE OF THE STATE ENGINEER, SALEM, OREGON

Willow Creek Adjudication

4 S. 25 E.