


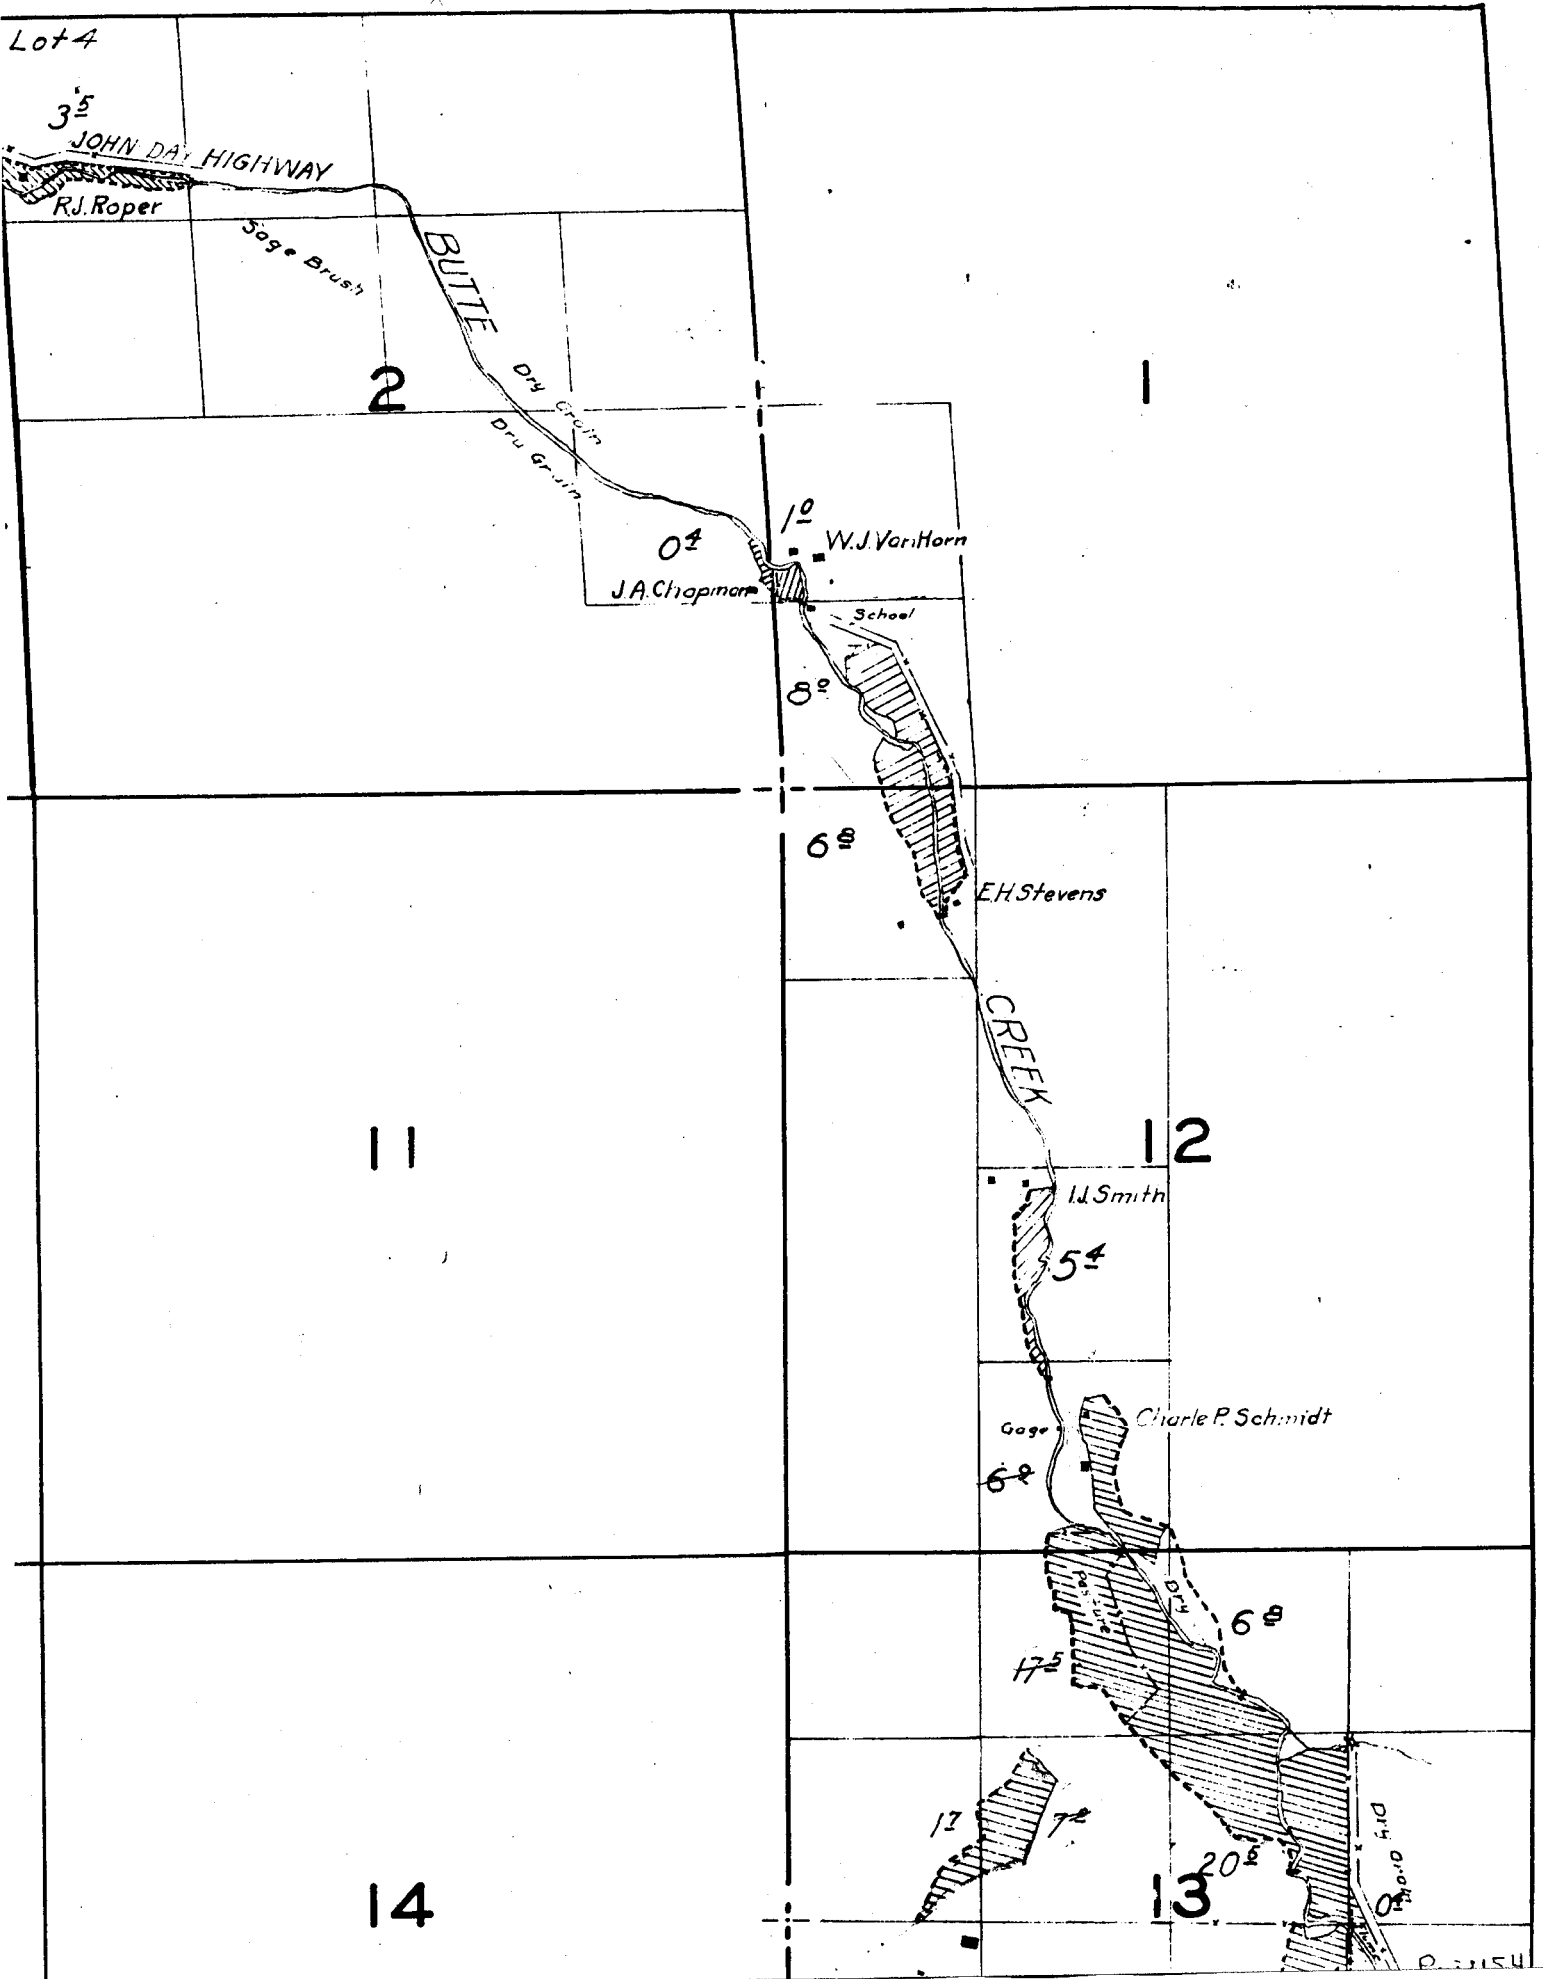

27


26

25

34

35

36

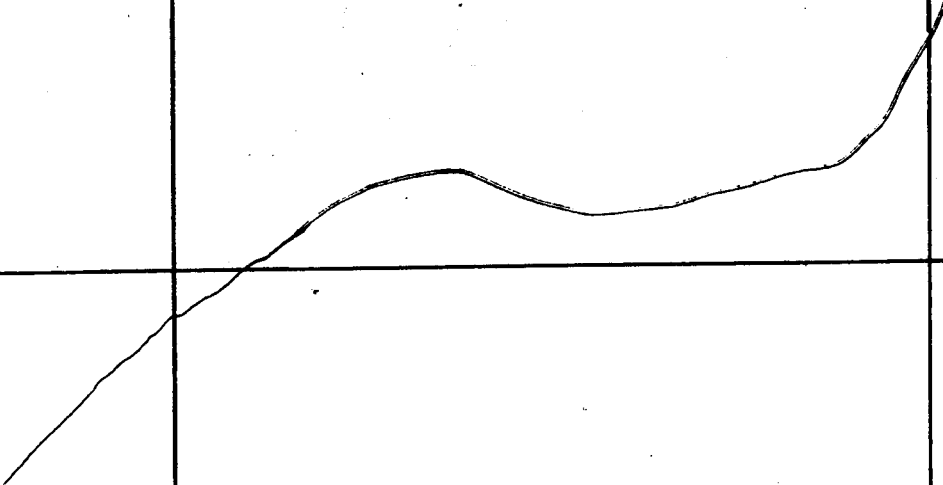

15


14

22


23

24

Location according
to Mt. Ball

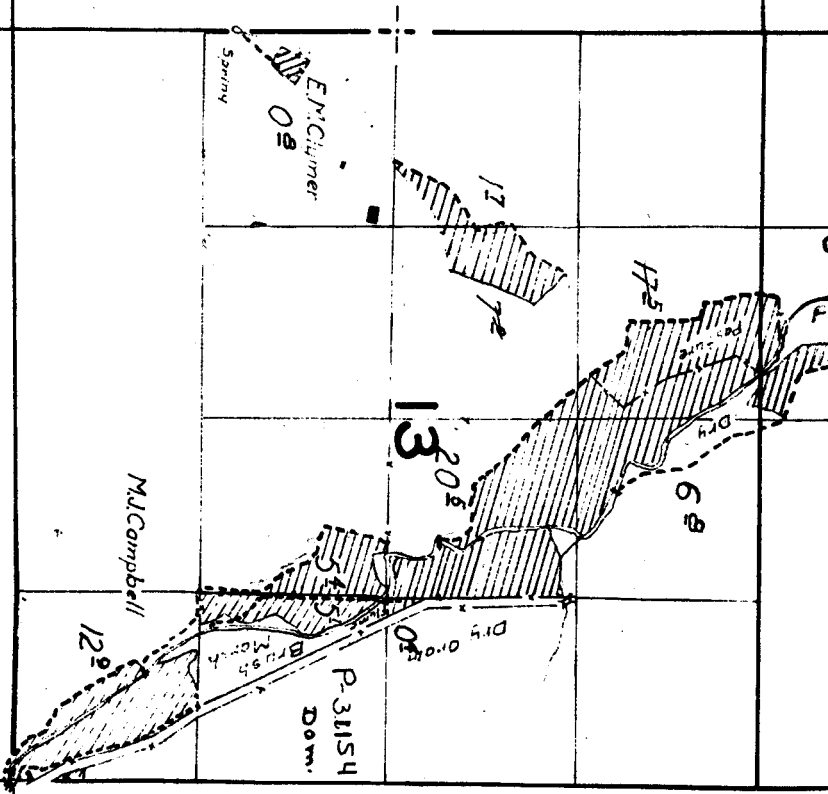

Note: Streams not in the irrigated lands sketched.

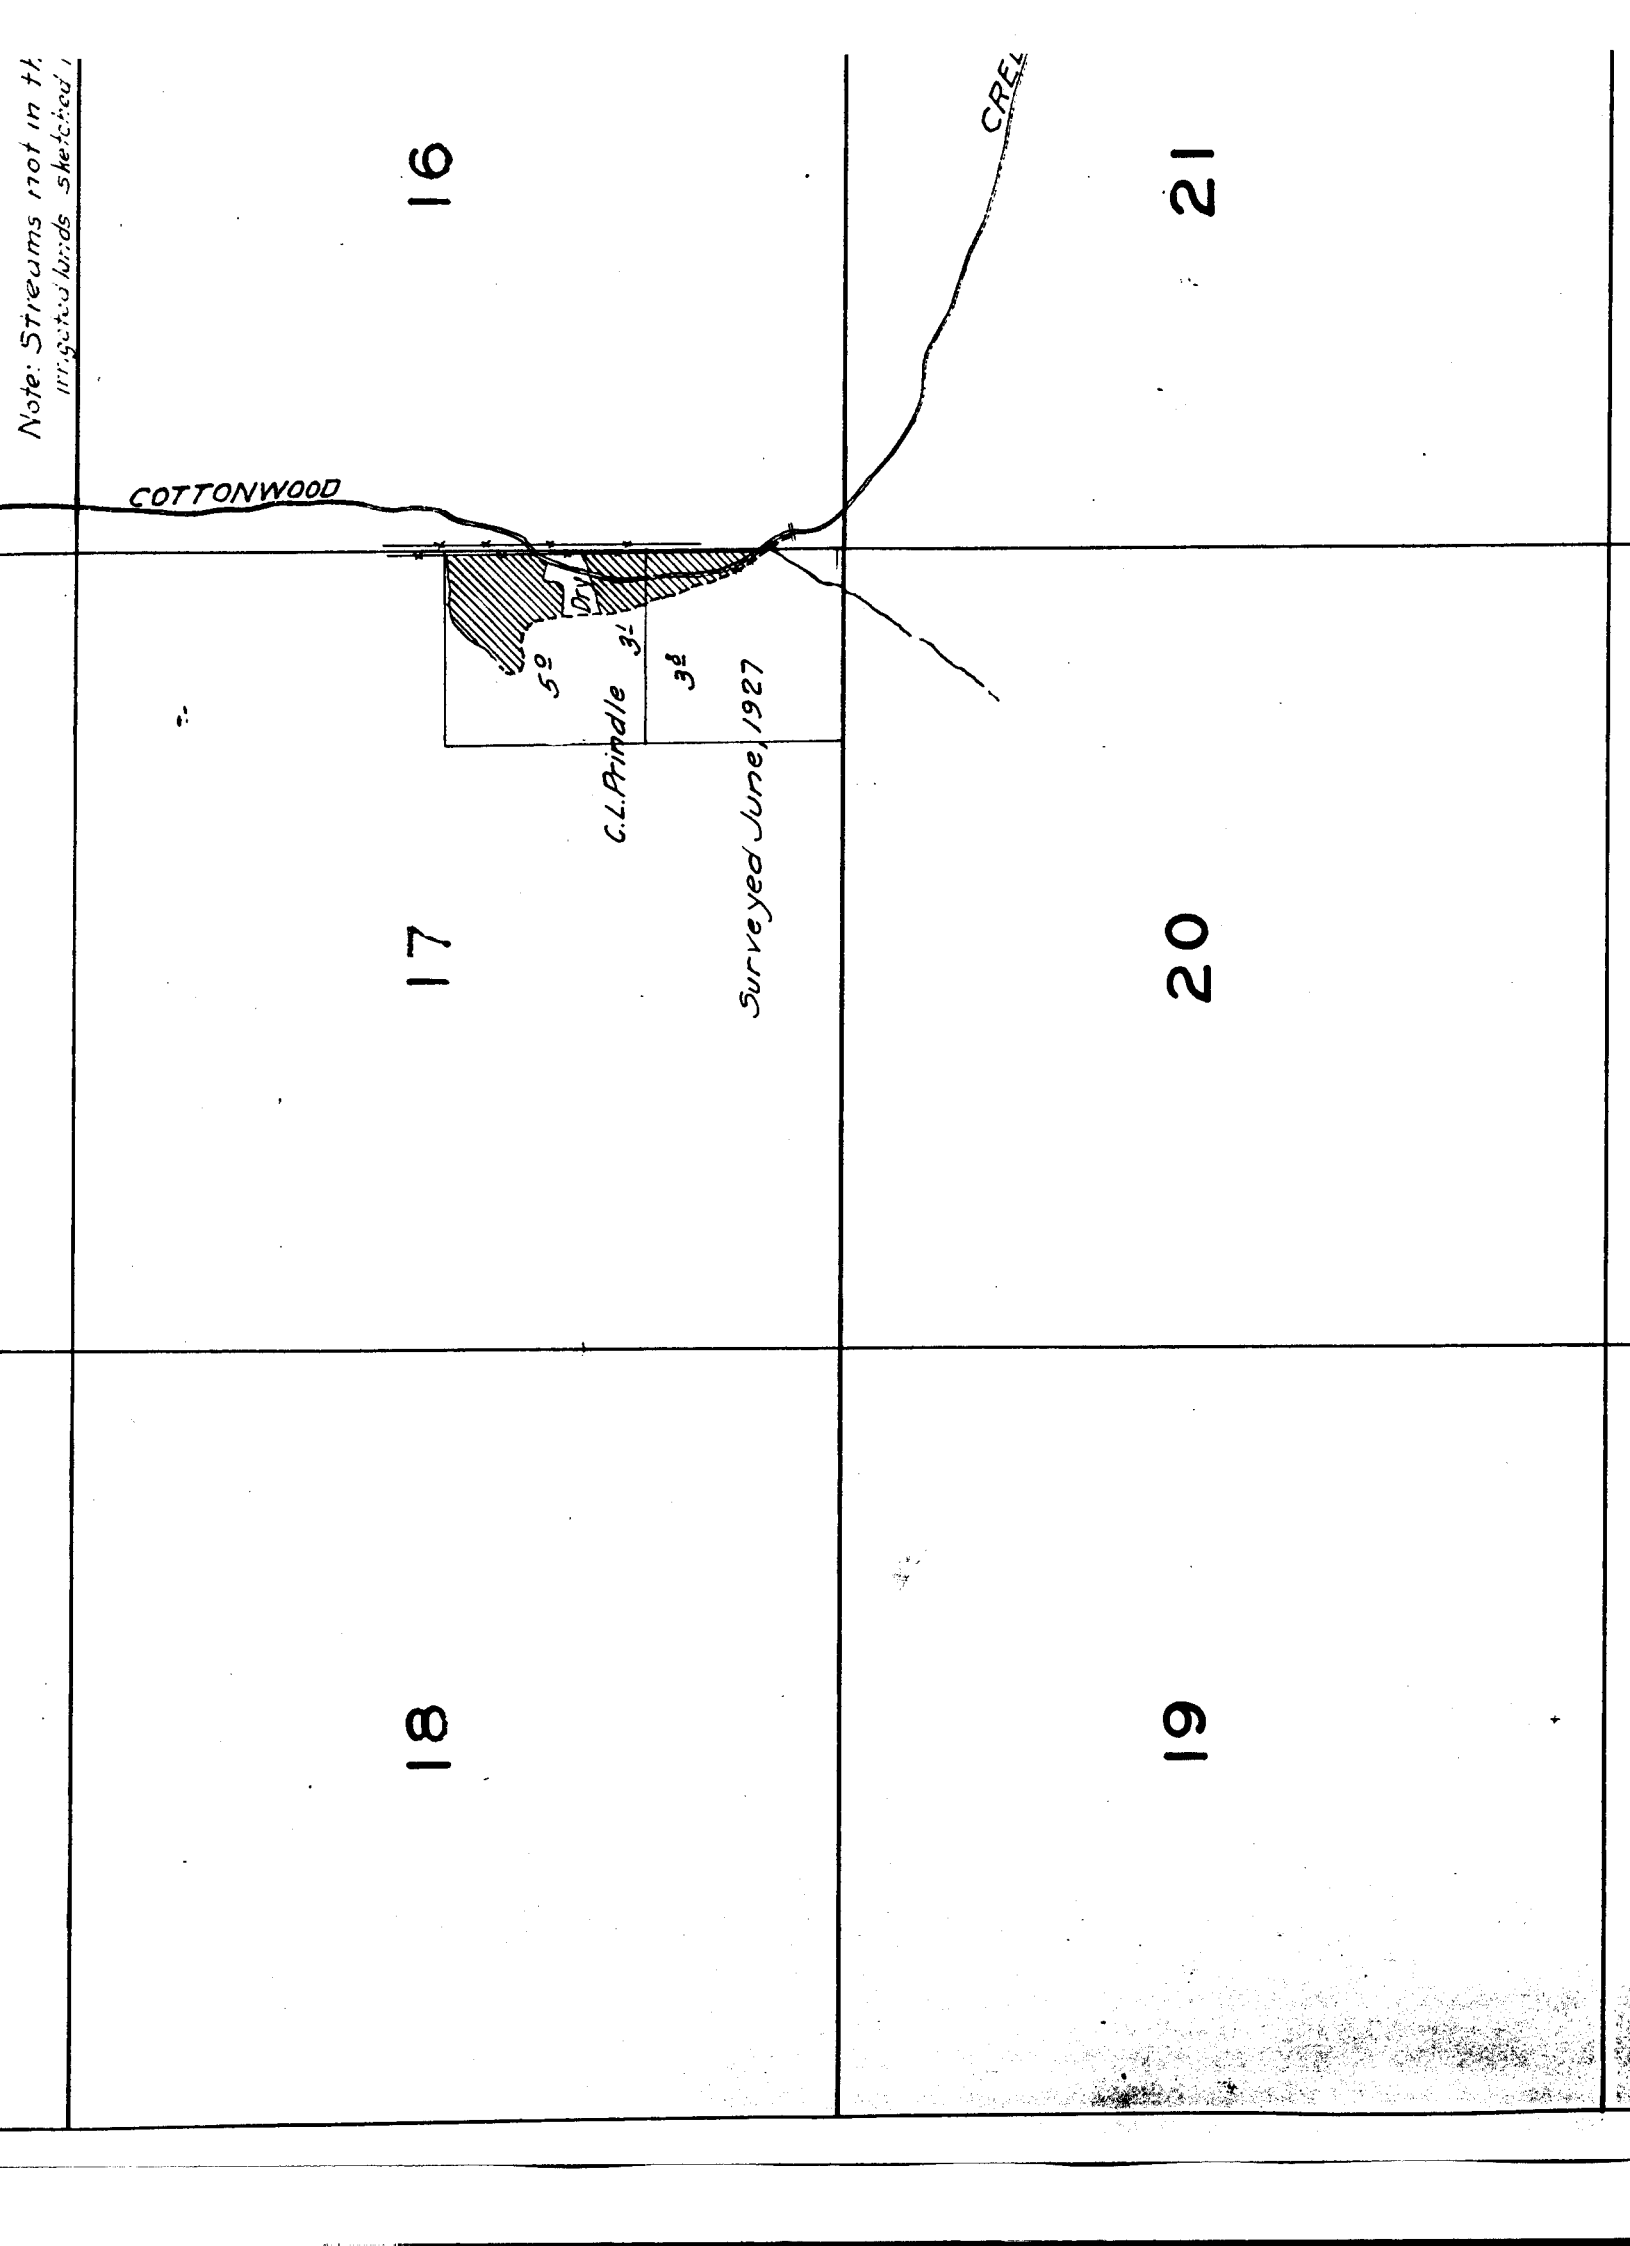

18

17

16

19

20

21

COTTONWOOD

C.R.E.L.

C.L. Prindle 31

Surveyed June, 1927

50

31

82


92



33

23


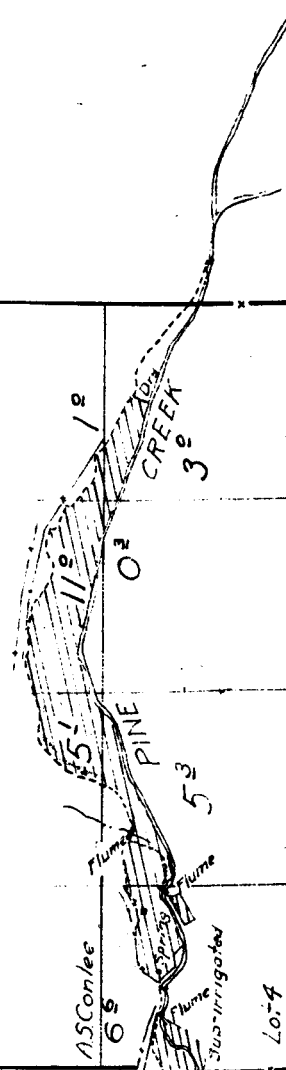

TOWNSHIP 7 S., RANGE 21 E.

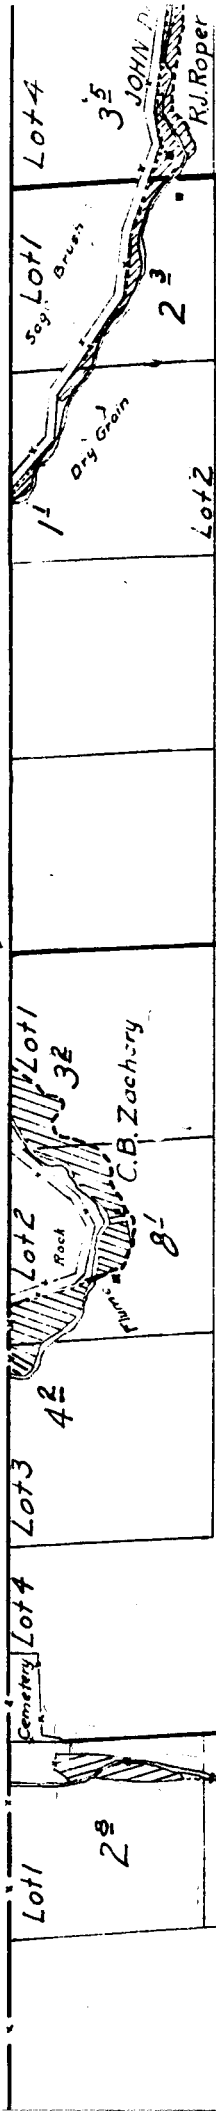

3

4


10


9

Surveyed Nov. 9 to 13, 1925.

8

Note: Streams not in the vicinity of irrigated lands sketched in approximate location.

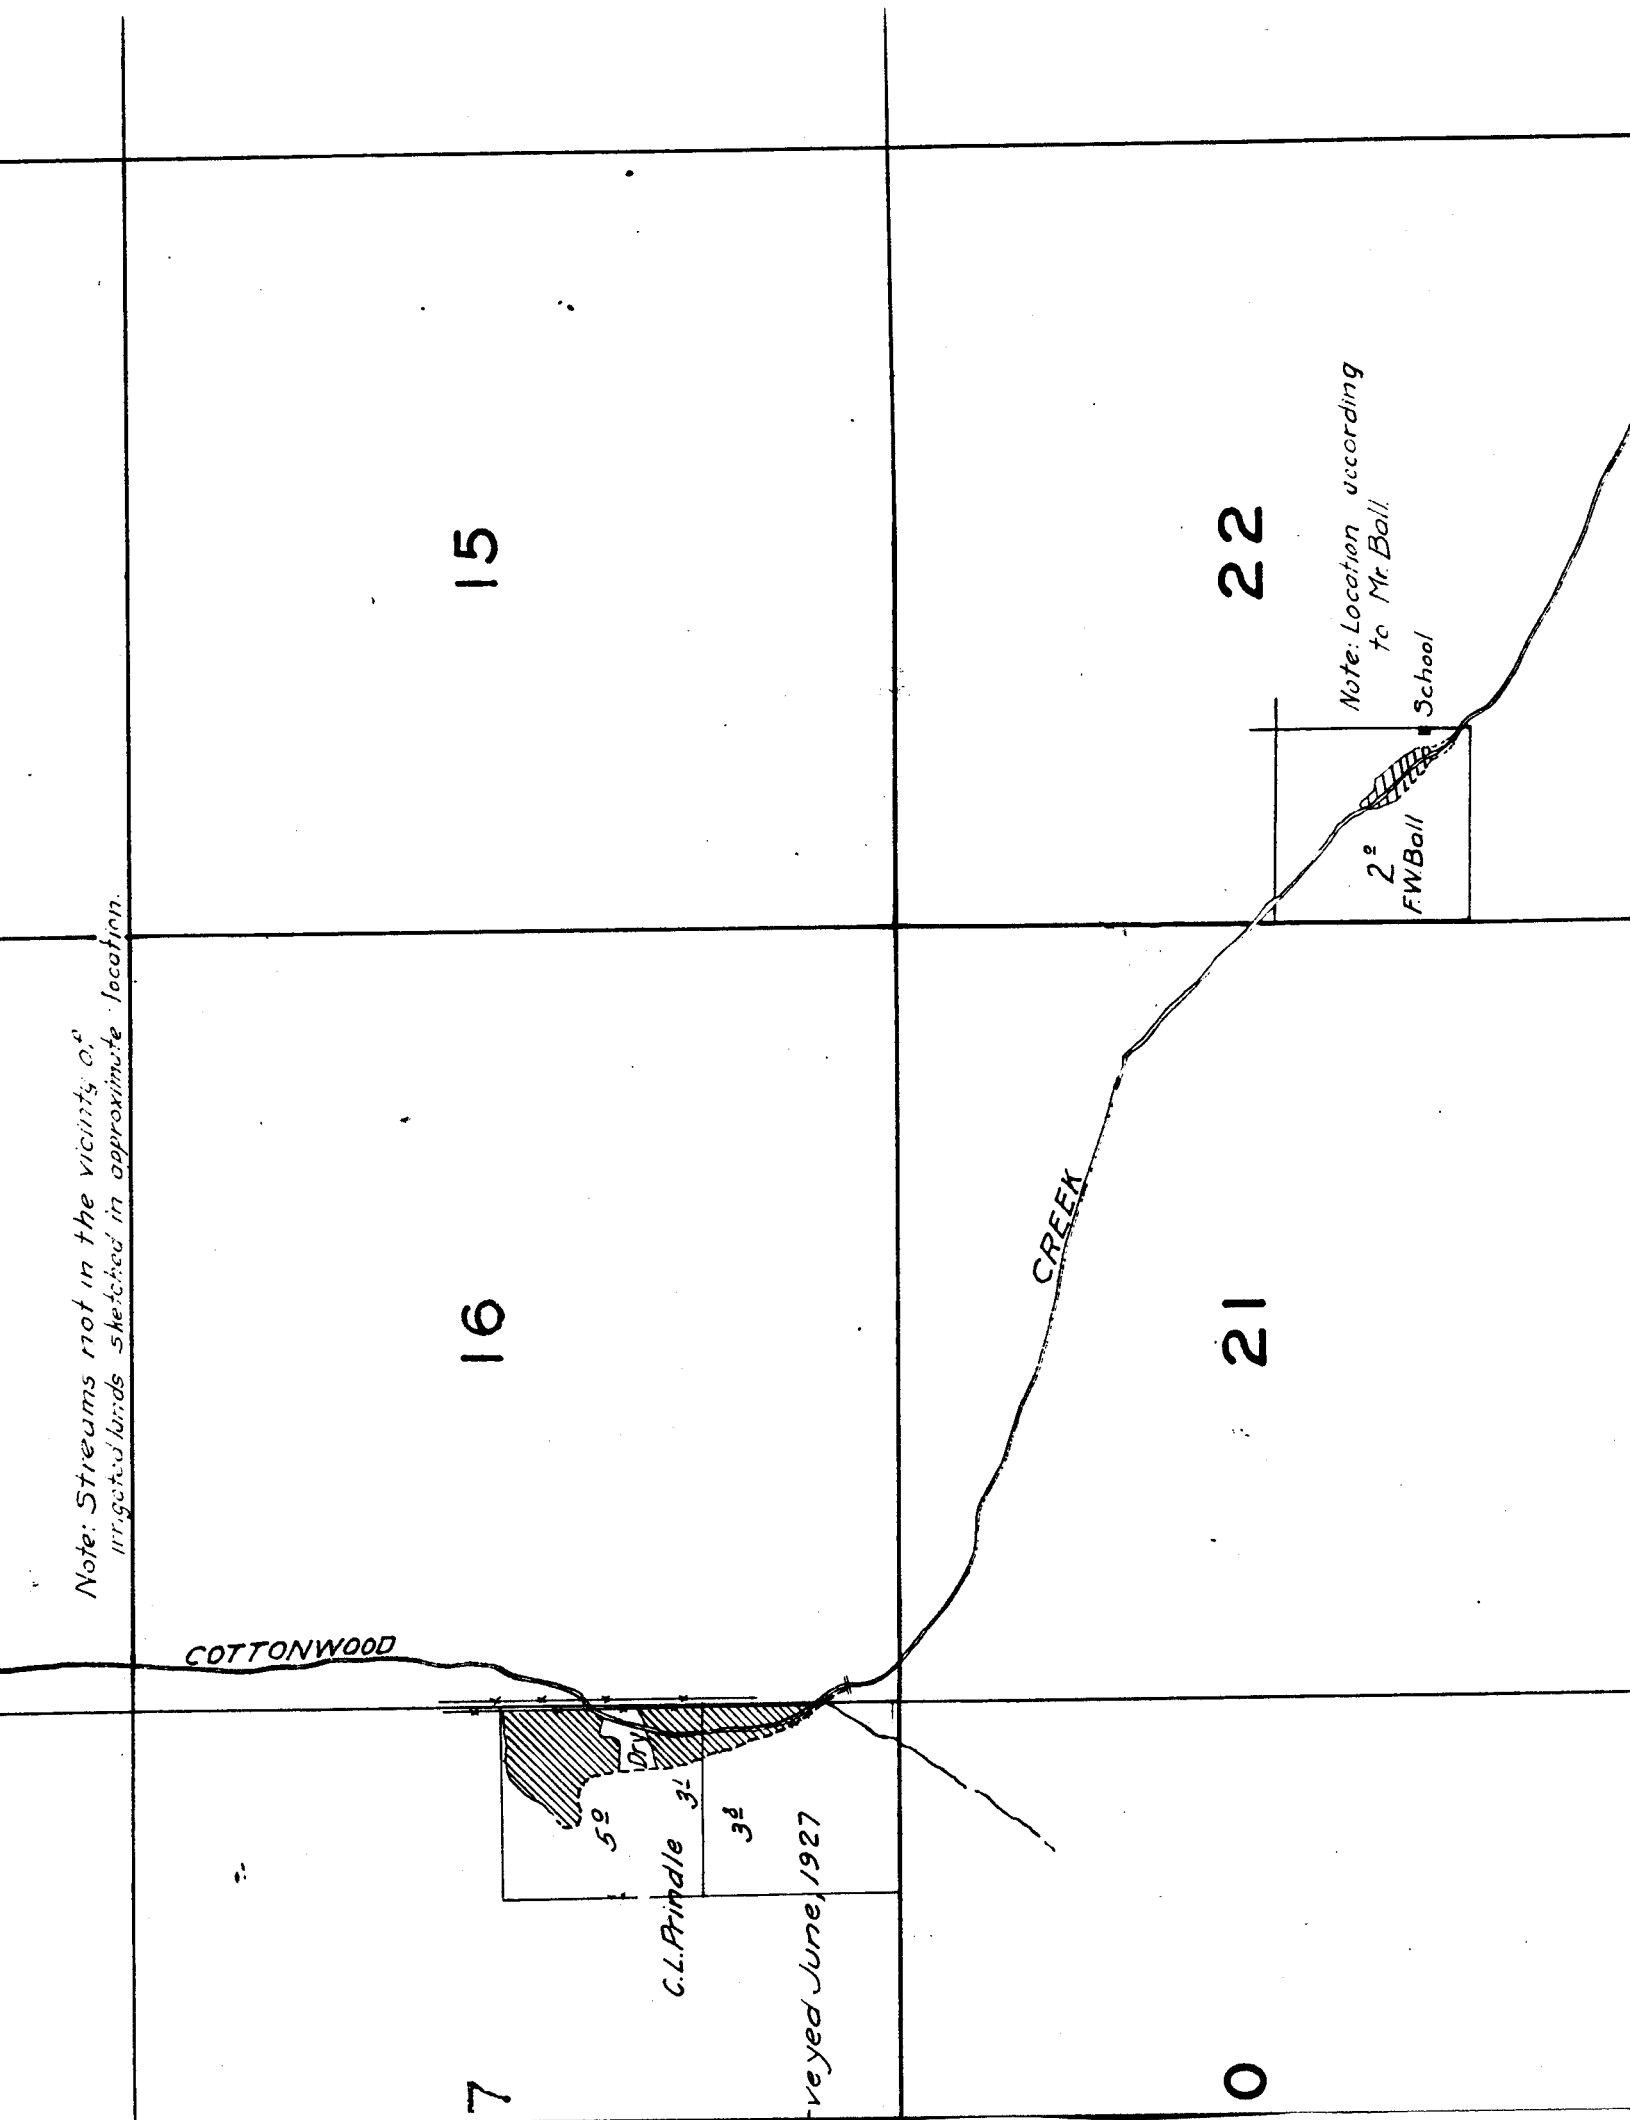

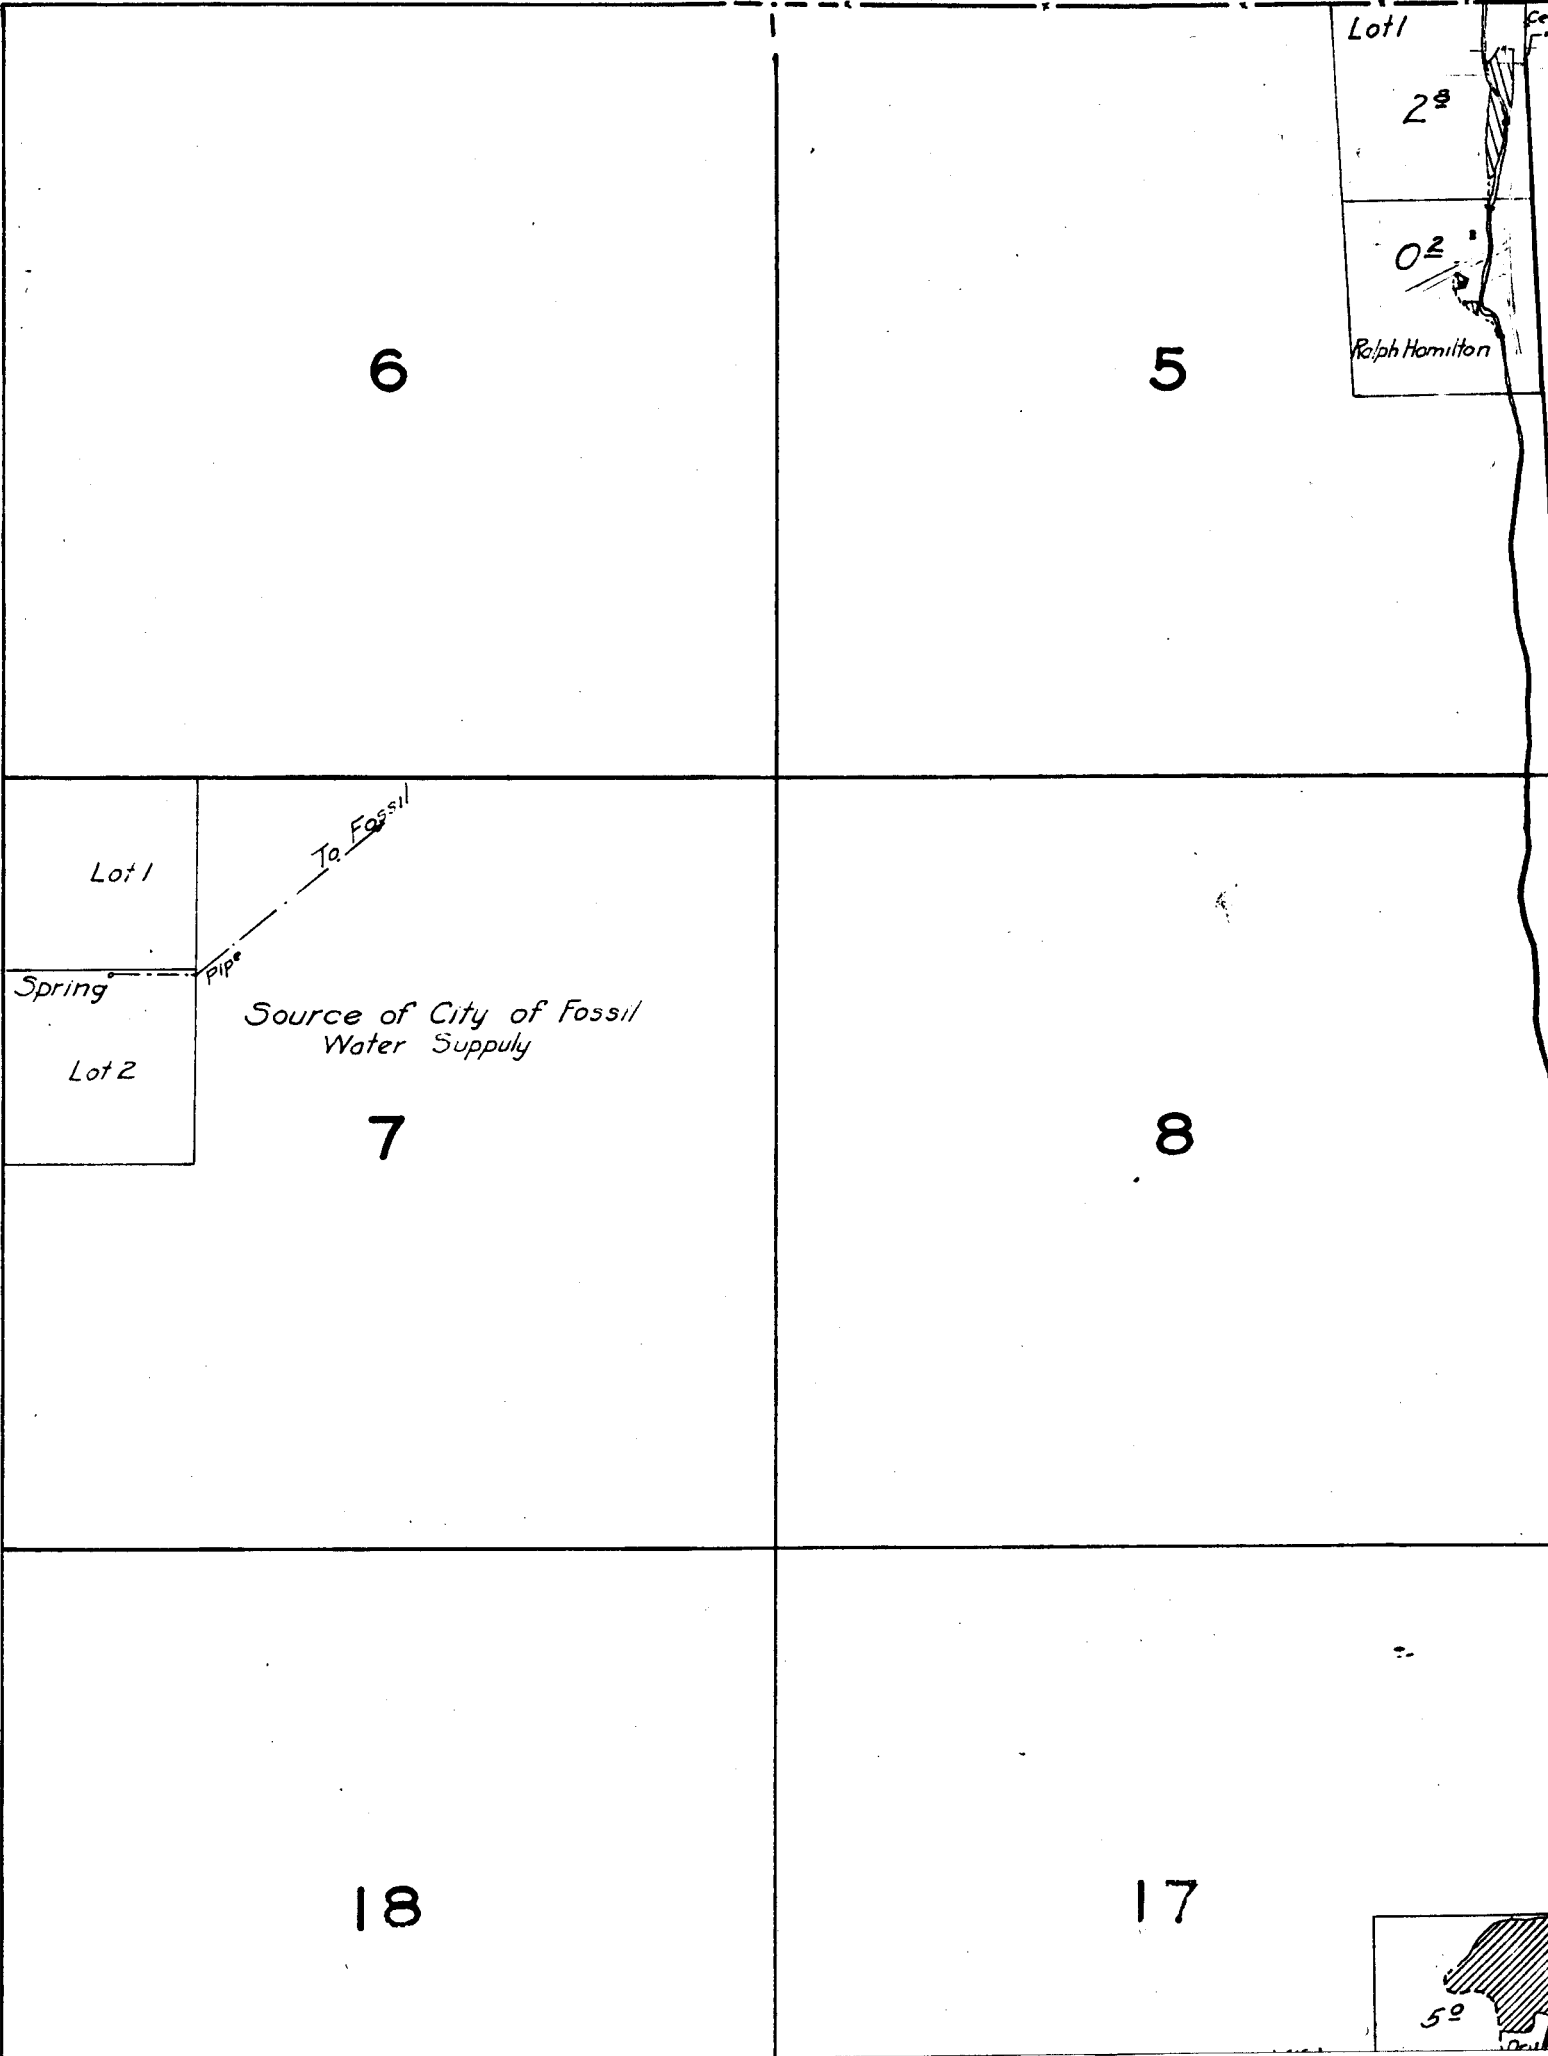

6

5

Lot 1

2^d

0²

Ralph Hamilton

Lot 1

Spring

Lot 2

To Fossil

Pipe

Source of City of Fossil
Water Supply

7

8

18

17

50

50

21

22

2^d
FW.Ball

*Note: Location according
to Mr. Ball.*

School

28

27

33

34