


# TOWNSHIP 8 S., RANGE 19 E.

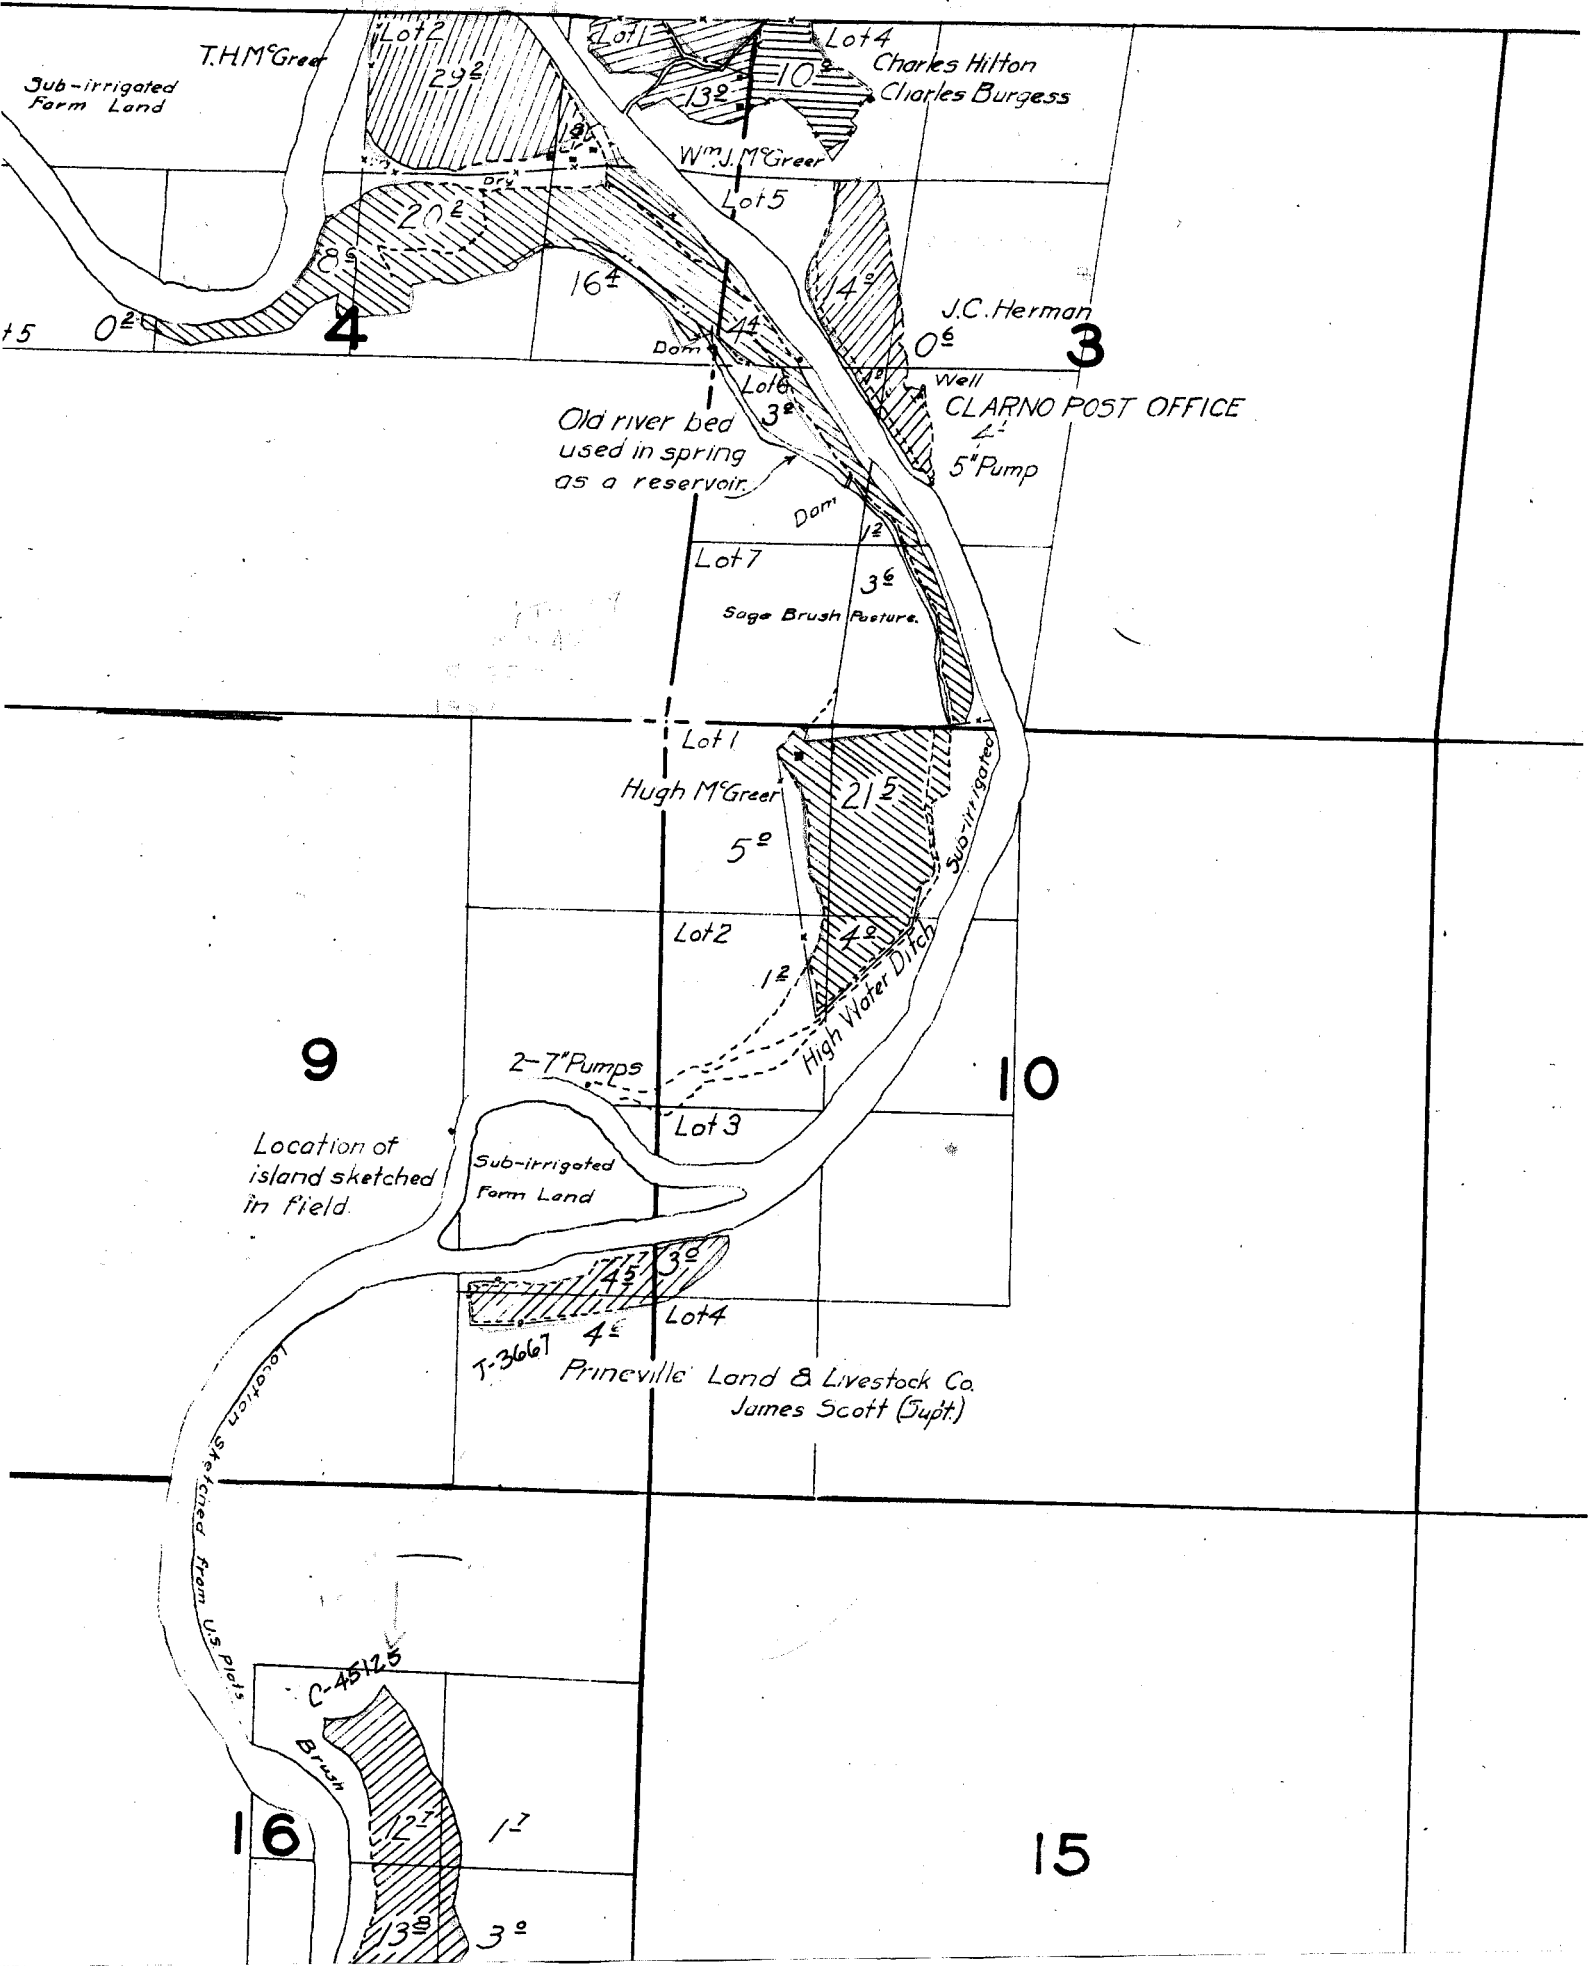

T.H.M. Greer  
Sub-irrigated  
Farm Land

Charles Hilton  
Charles Burgess

Wm. J. McGreer

J.C. Herman

CLARNO POST OFFICE

Old river bed  
used in spring  
as a reservoir.

Hugh McGreer

Prineville Land & Livestock Co  
James Scott (Supt.)

Location of  
island sketched  
in field.

Location sketched from US plat

9

10

16

15

19

20

30

29

Sage Brush  
MUDDY

Sage Brush  
Prineville Land & Livestock  
James Scott (Supt)

31

32

Lot 3

Lot 4

Sage

Brush

& Rock

CURRENT  
Sage Brush and Junipers

Grain

CREEK

Spring Pump

Reservoir

Lot 1

Dry Orchard

Lot 2

Lot 3

Lot 4

Sage

Brush

Lot 4

37

8°

9°

5°

45

45

02












23

24

*Location sketched from U.S. Plats.*

C.S. Hicks  
Sub-irrigated  
Farm Land

26

Rim Rock



Brush

25

0 1/2

6'ump

*Location sketched from U.S. Plats.*

35

36



29

28

27

32

33

34

509<sup>e</sup> Firreville Land & Livestock Co  
James Scott (Supt)

Brush

Gage Brush

Rim Rock

and Junipers  
CREEK

MUDDY

9<sup>e</sup>

04

32

Flume




























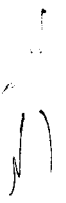

17

16


15

20

21


22

Surveyed Aug. 16, 17, 18, 19, & 20, 1924

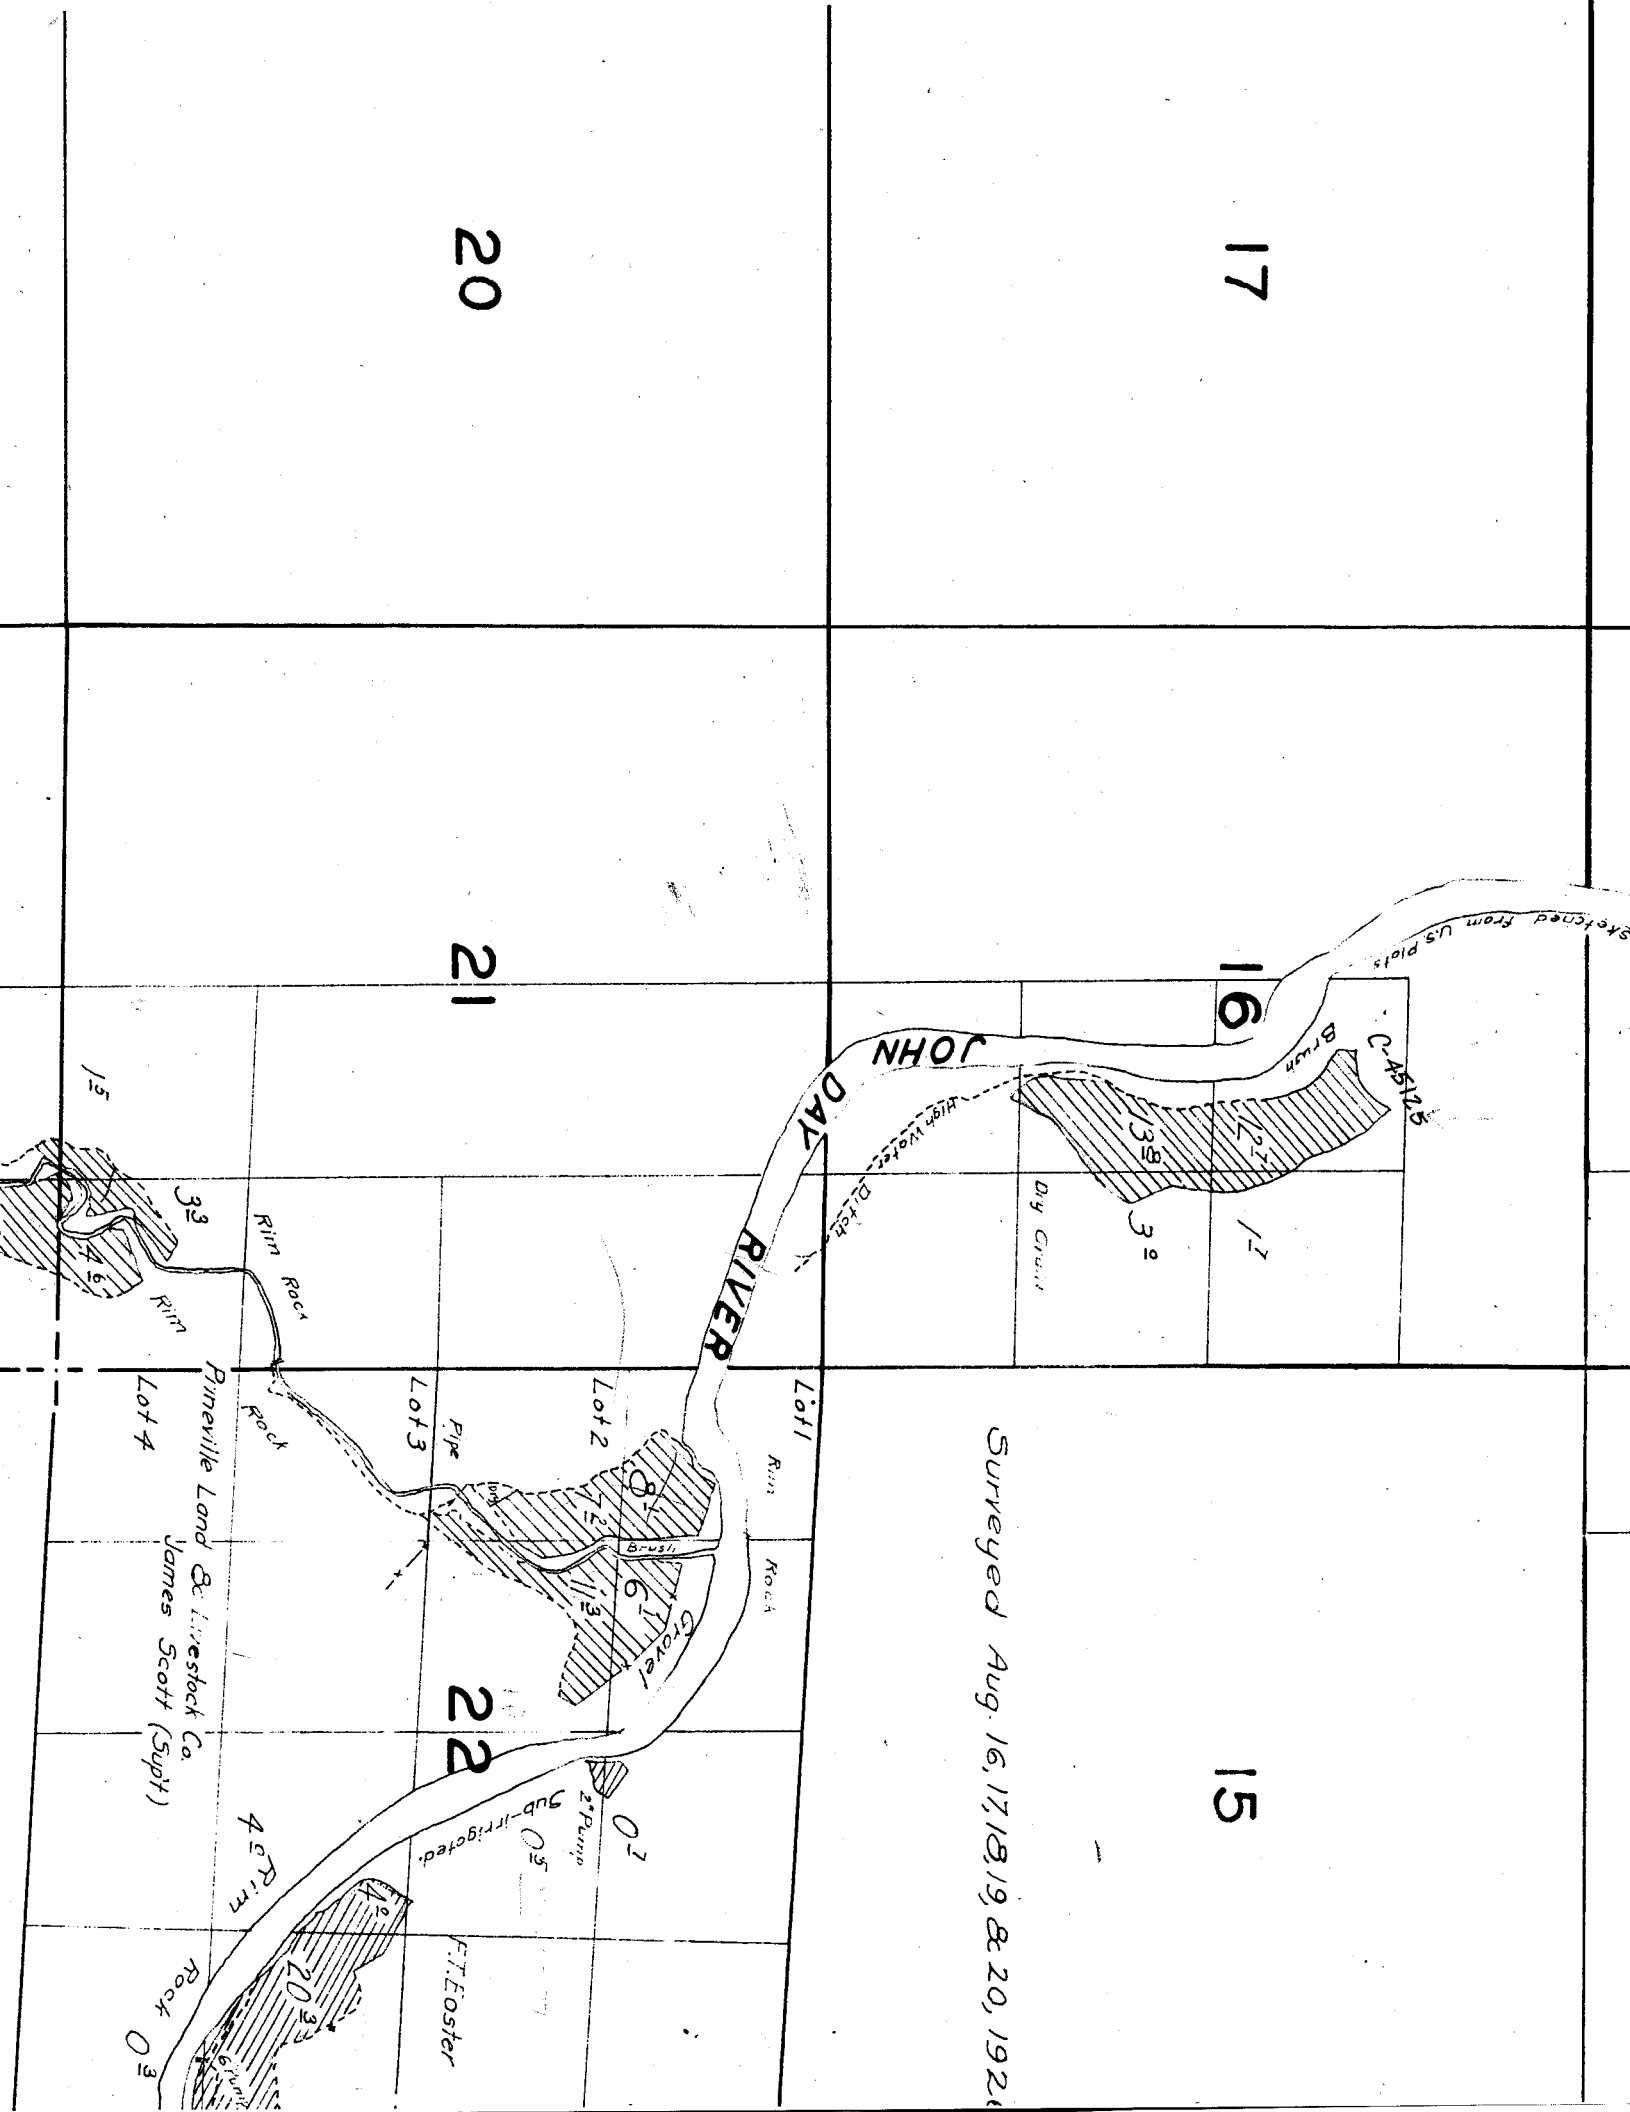

GE 19 E.

42-2-1

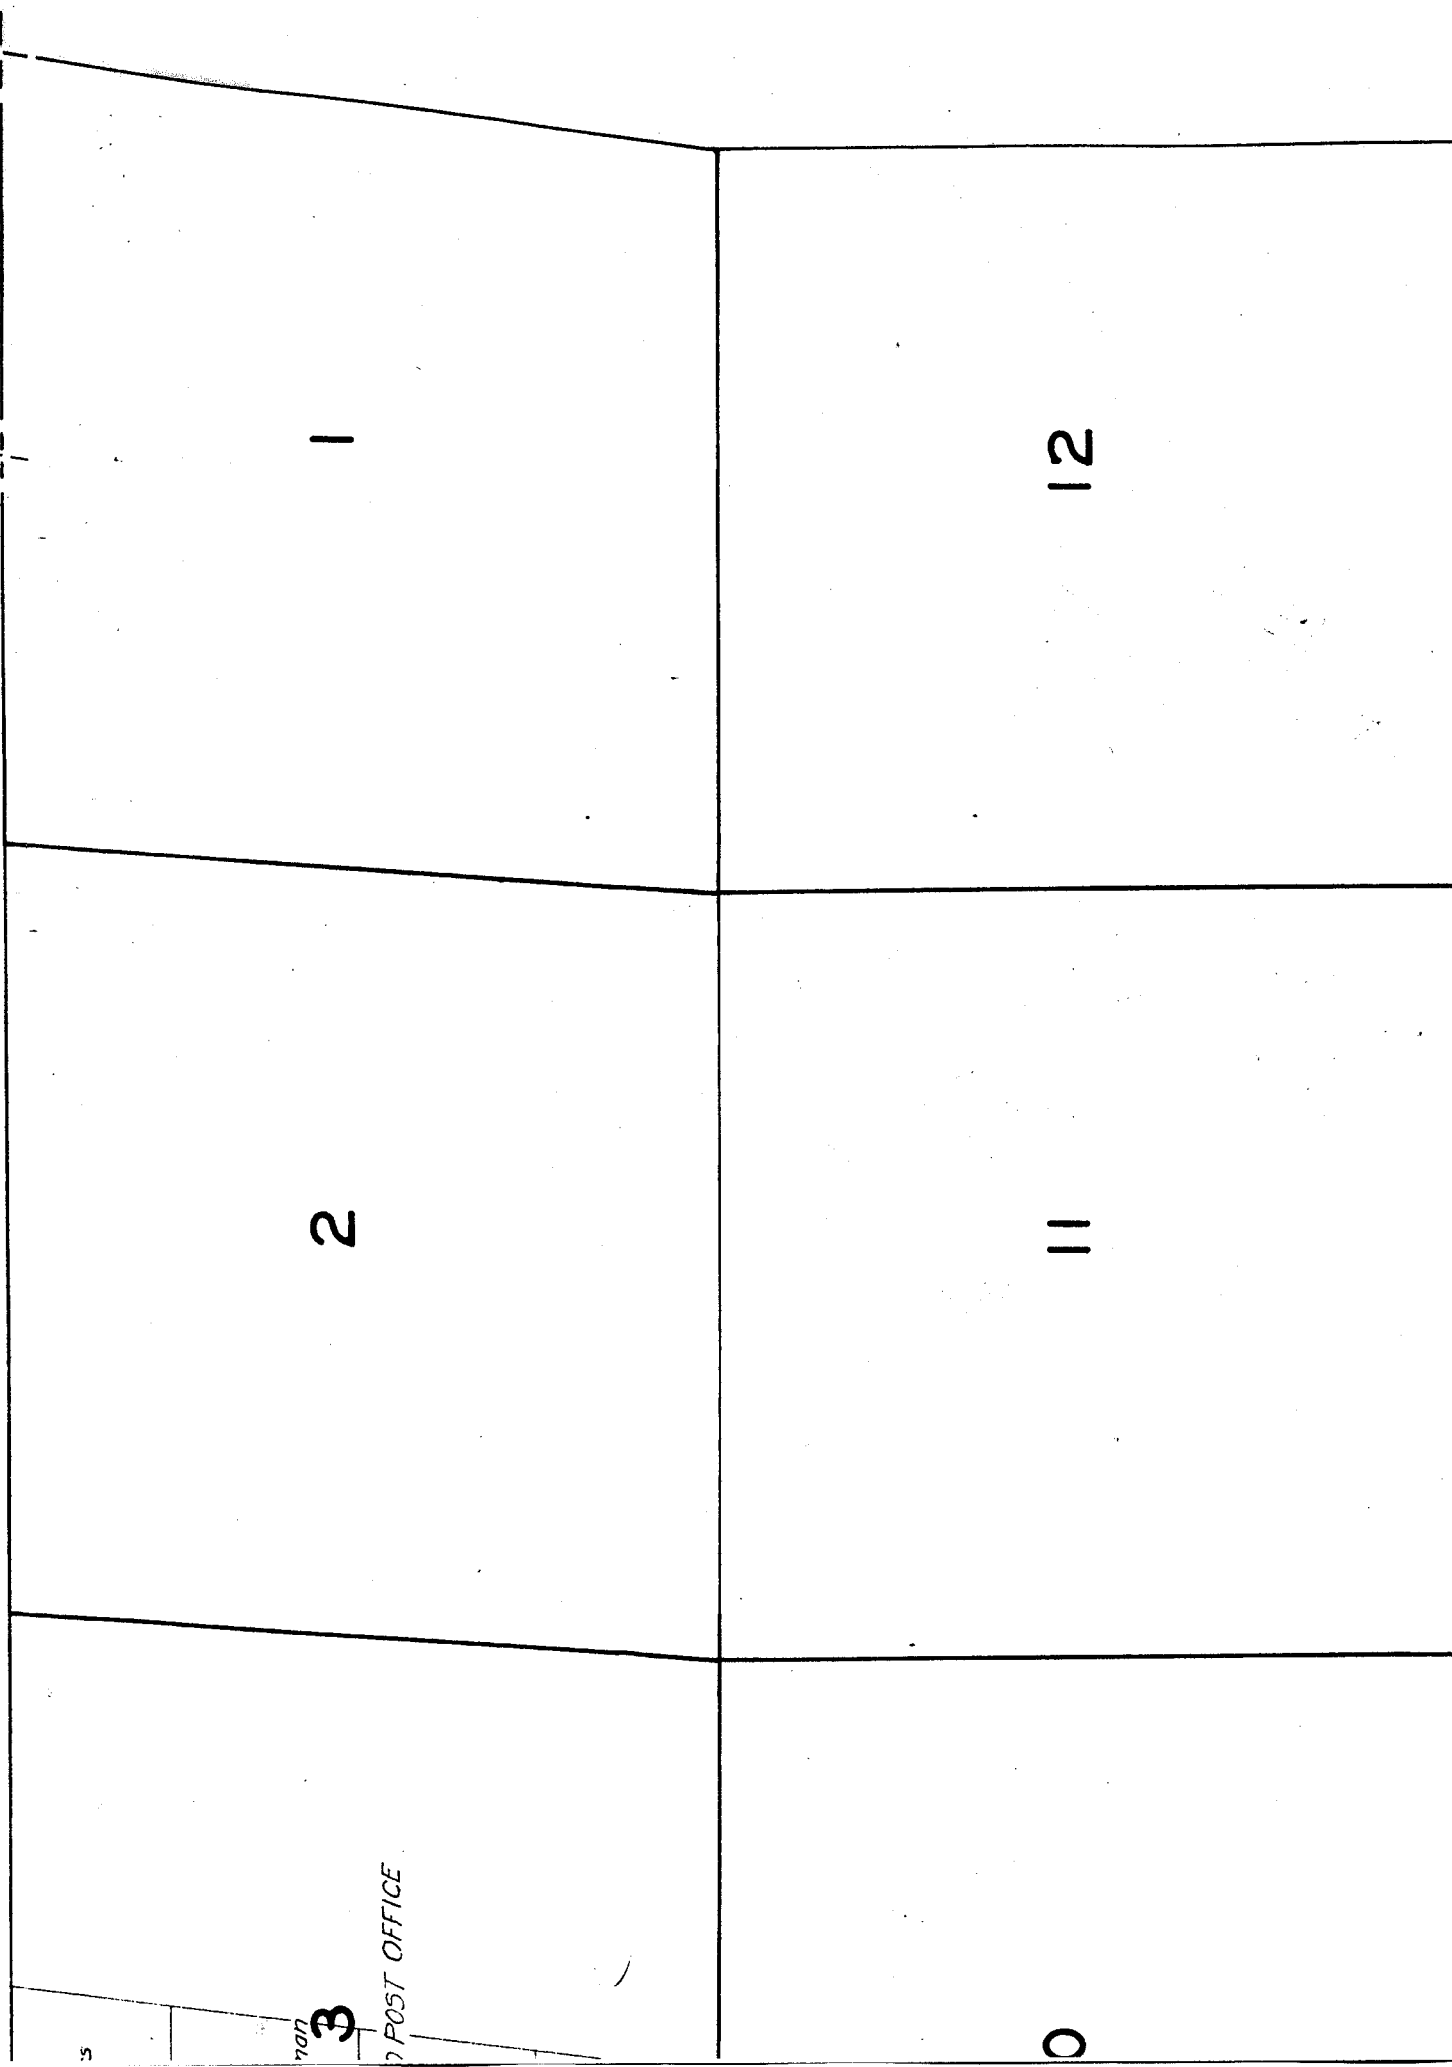

5

POST

3

POST OFFICE

2

1

0

11

12

15

14

13

'6, 17, 18, 19, & 20, 1926.

2




2" Pump

0.5

Sub-irrigated

F.T. Easter

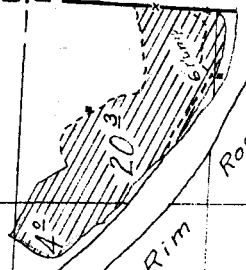

4" Rim

Rock 0 3


Co. Supt)

Location sketched from US Plots


23

24

# TOWNS

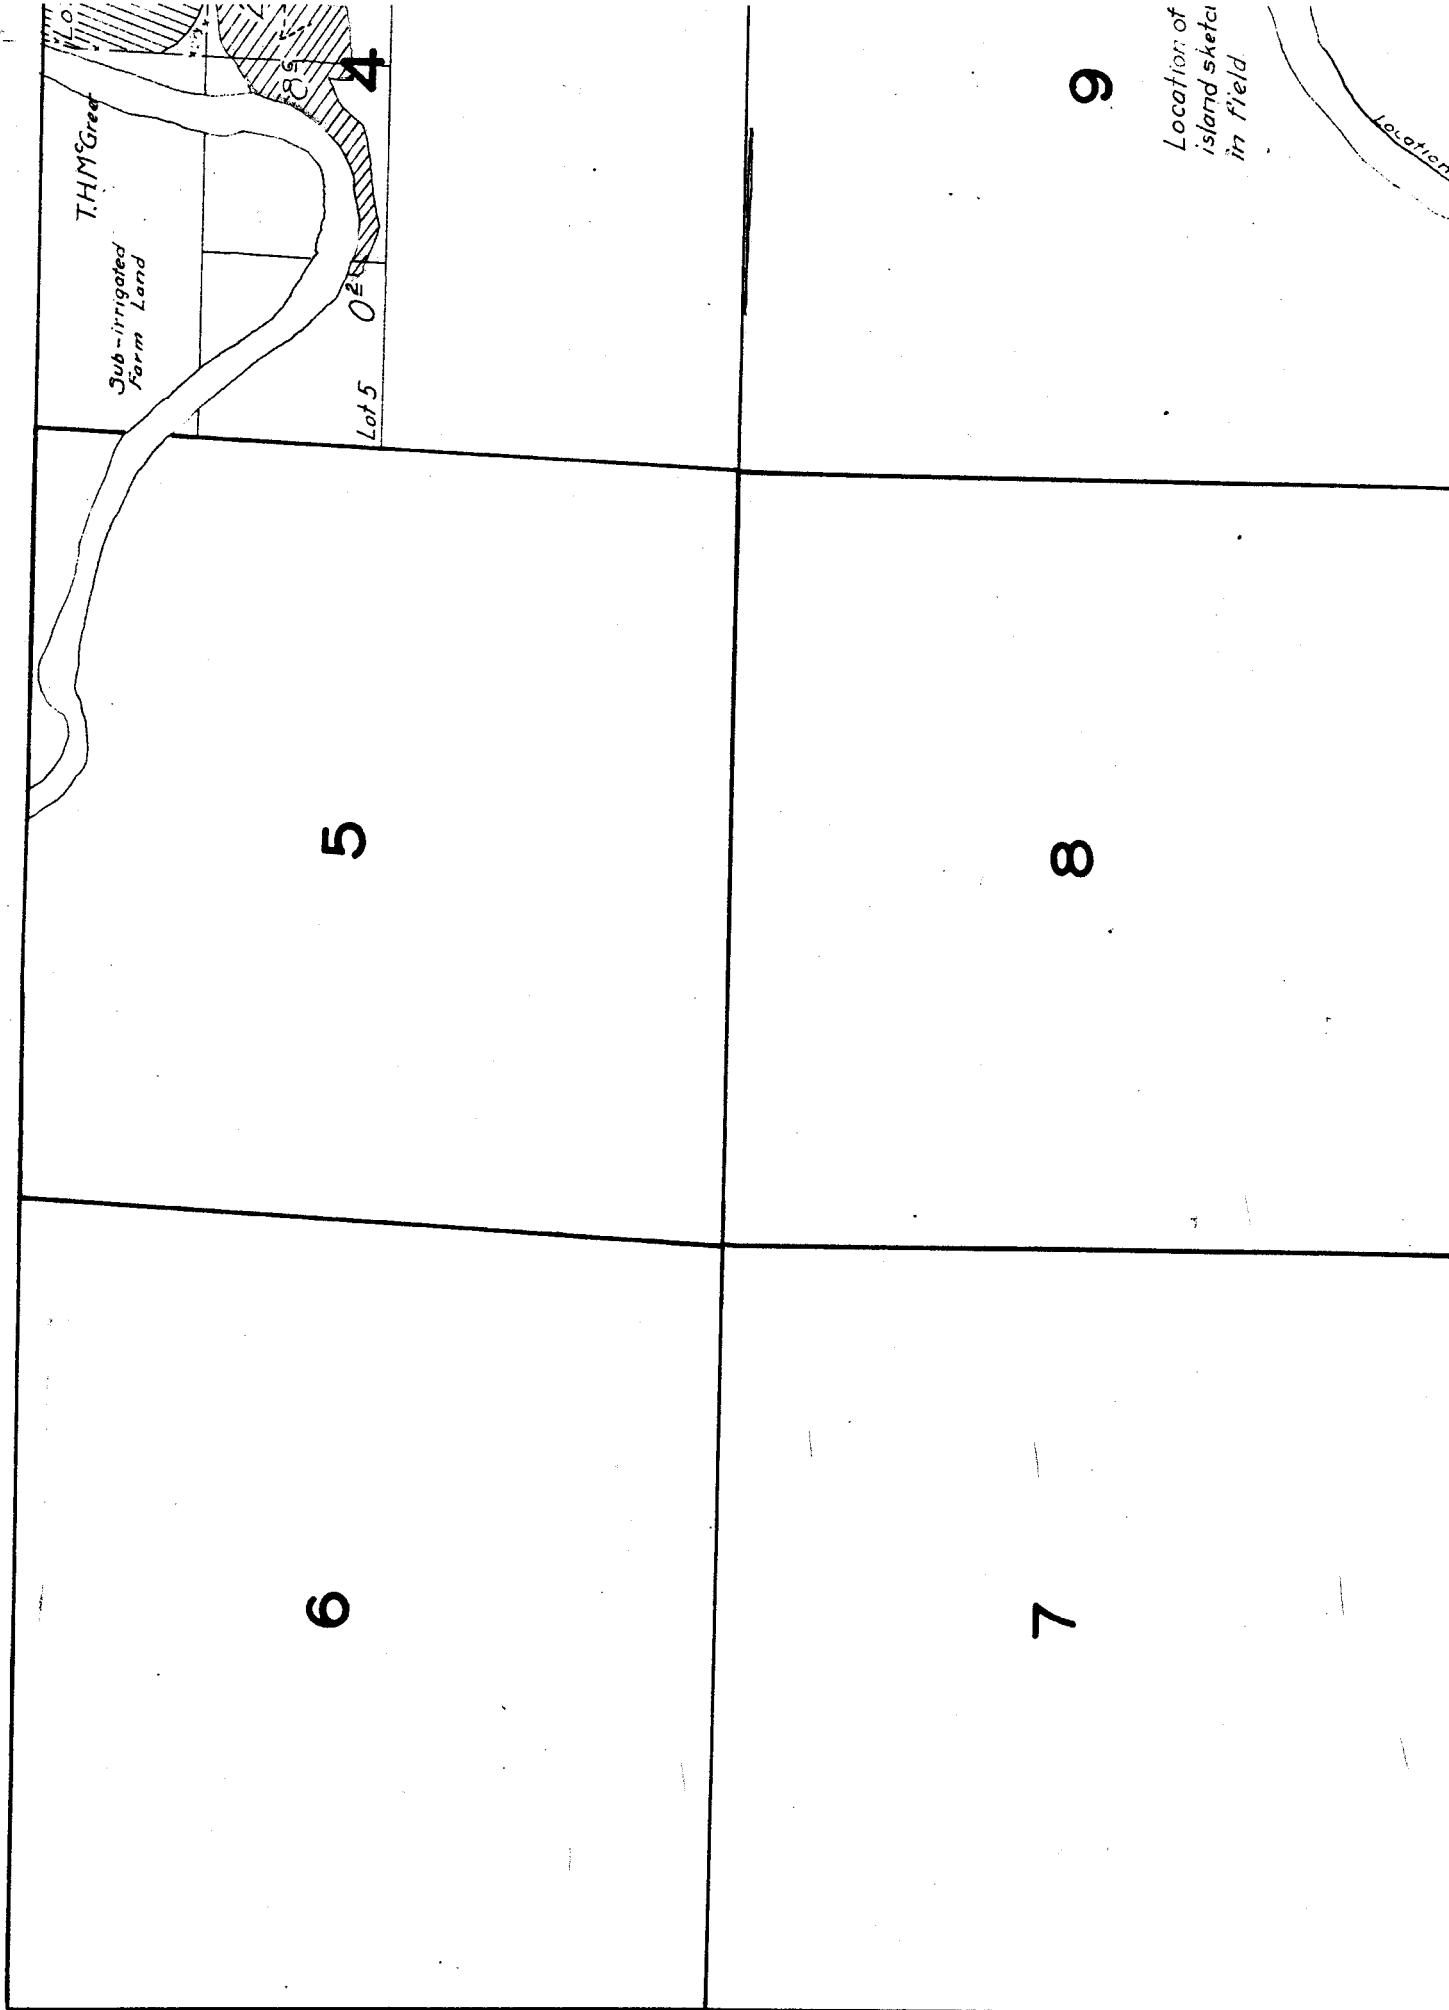



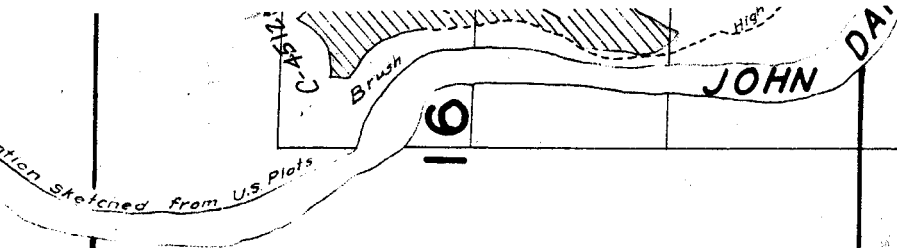

16

21

17

20

18

19

lot