

30

29

28

31

32

33

18

17

16

19


20

21

27

26

25

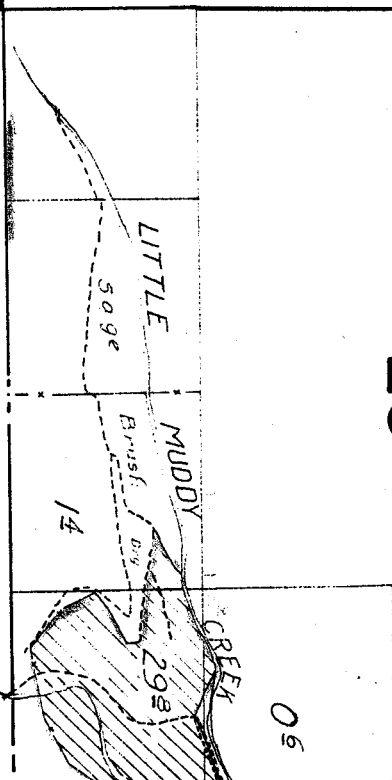

Surveyed Aug. 27, 1926.


Prineville Land & Livestock Co
James Scott (Supt) CREEK

MUDDY
509e
Brush

34

35

36

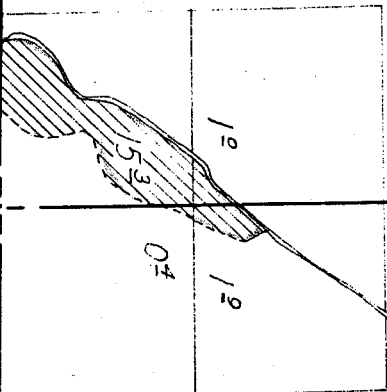

10 10

04

15

14

13

22

23

24

TOWNSHIP 9 S., RANGE 18 E.

4

3

9

10

15

22

16

21

2

1

11

12

14

13

6

5

7

8

18

17

21

22

28

27

33

34

TOWNSHIP 9 S. RANGE 19 E.

4

3

9

10

LEK

16

15

Surveyed Se

21

22

NOTE: Streams and river, except in the vicinity of irrigated land, sketched in approximate location.

27

26

25

CREEK

CHERRY

34

35

36



15


14

Surveyed Sept. 7 & 8, 1926.

22

23

no river, except in the
ad land, sketched in
on.

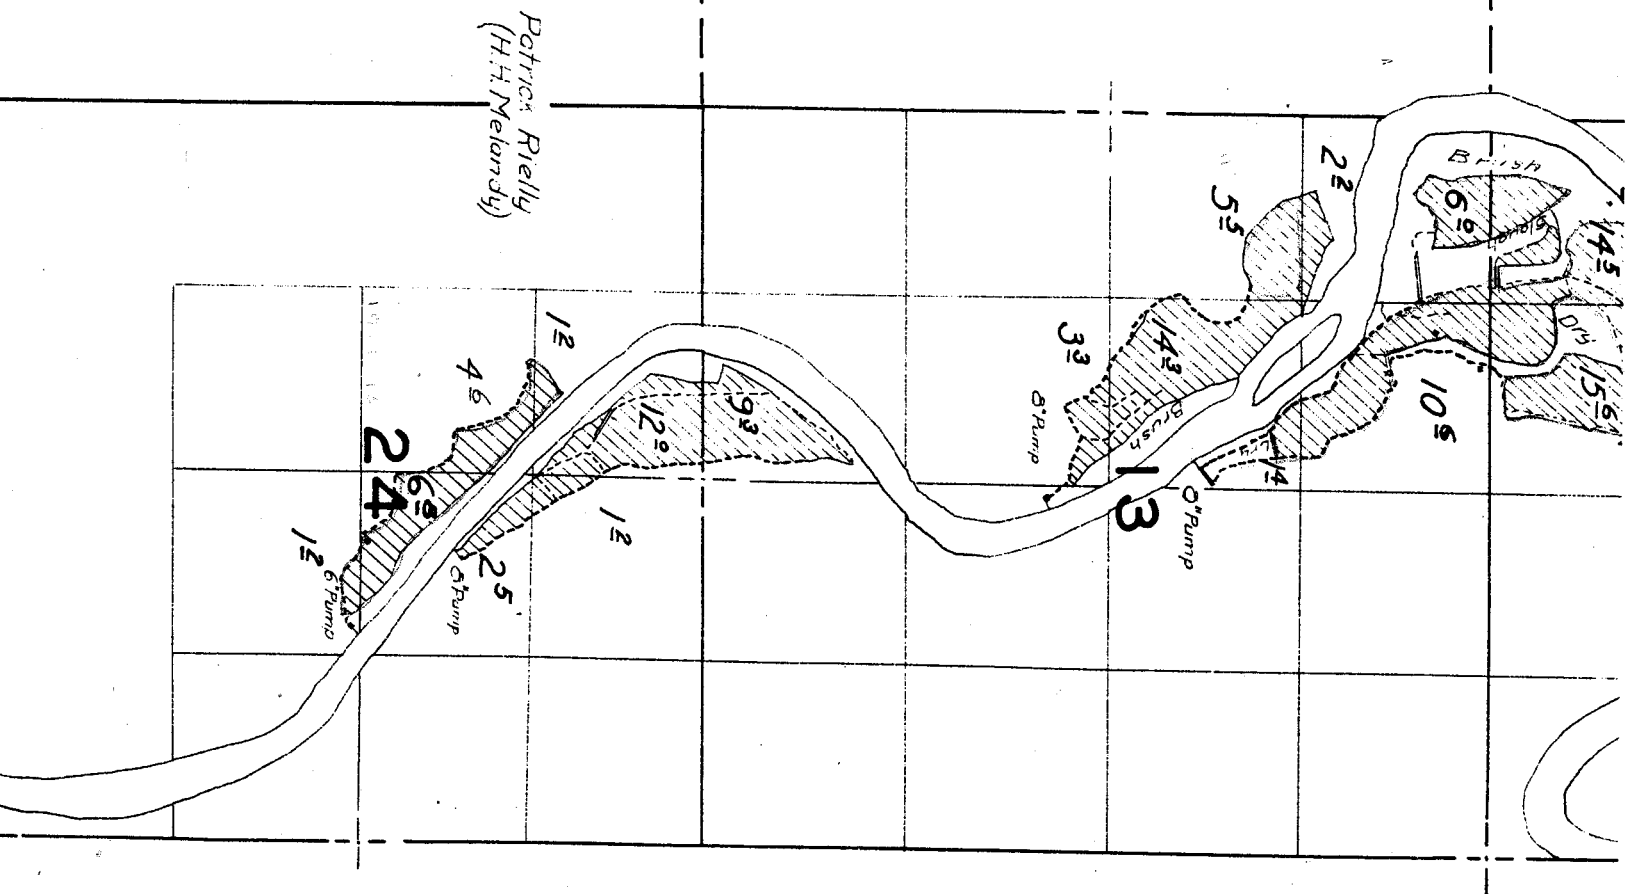

Patricia Rielly
(H.H. Melandsy)

21

22

NOTE: Streams and river, except in the vicinity of irrigated land, sketched in approximate location.

28

27

33


34


CHERRY

2

11

14

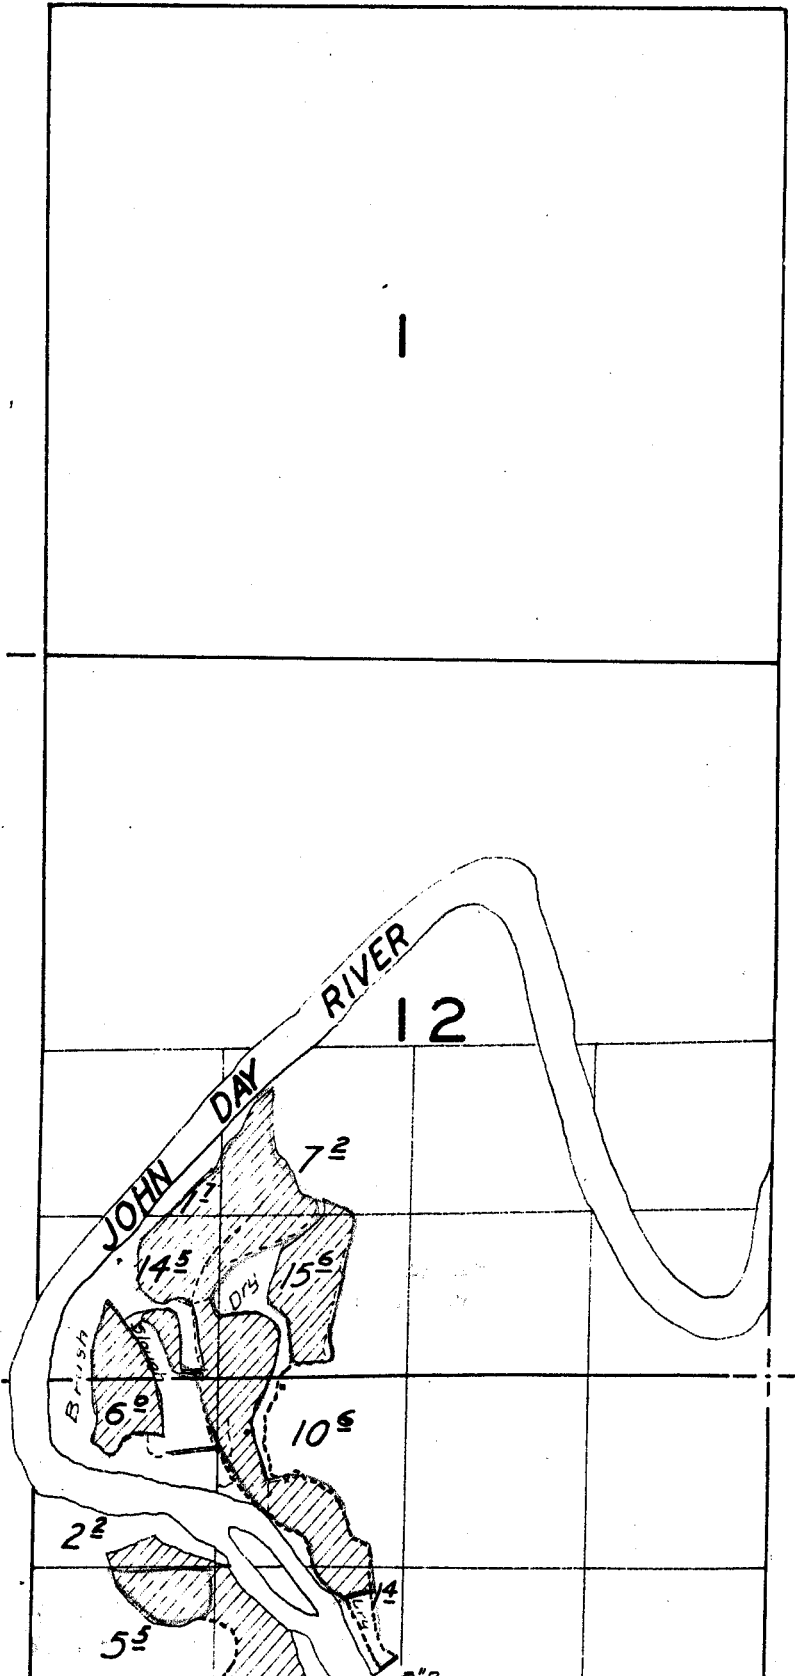

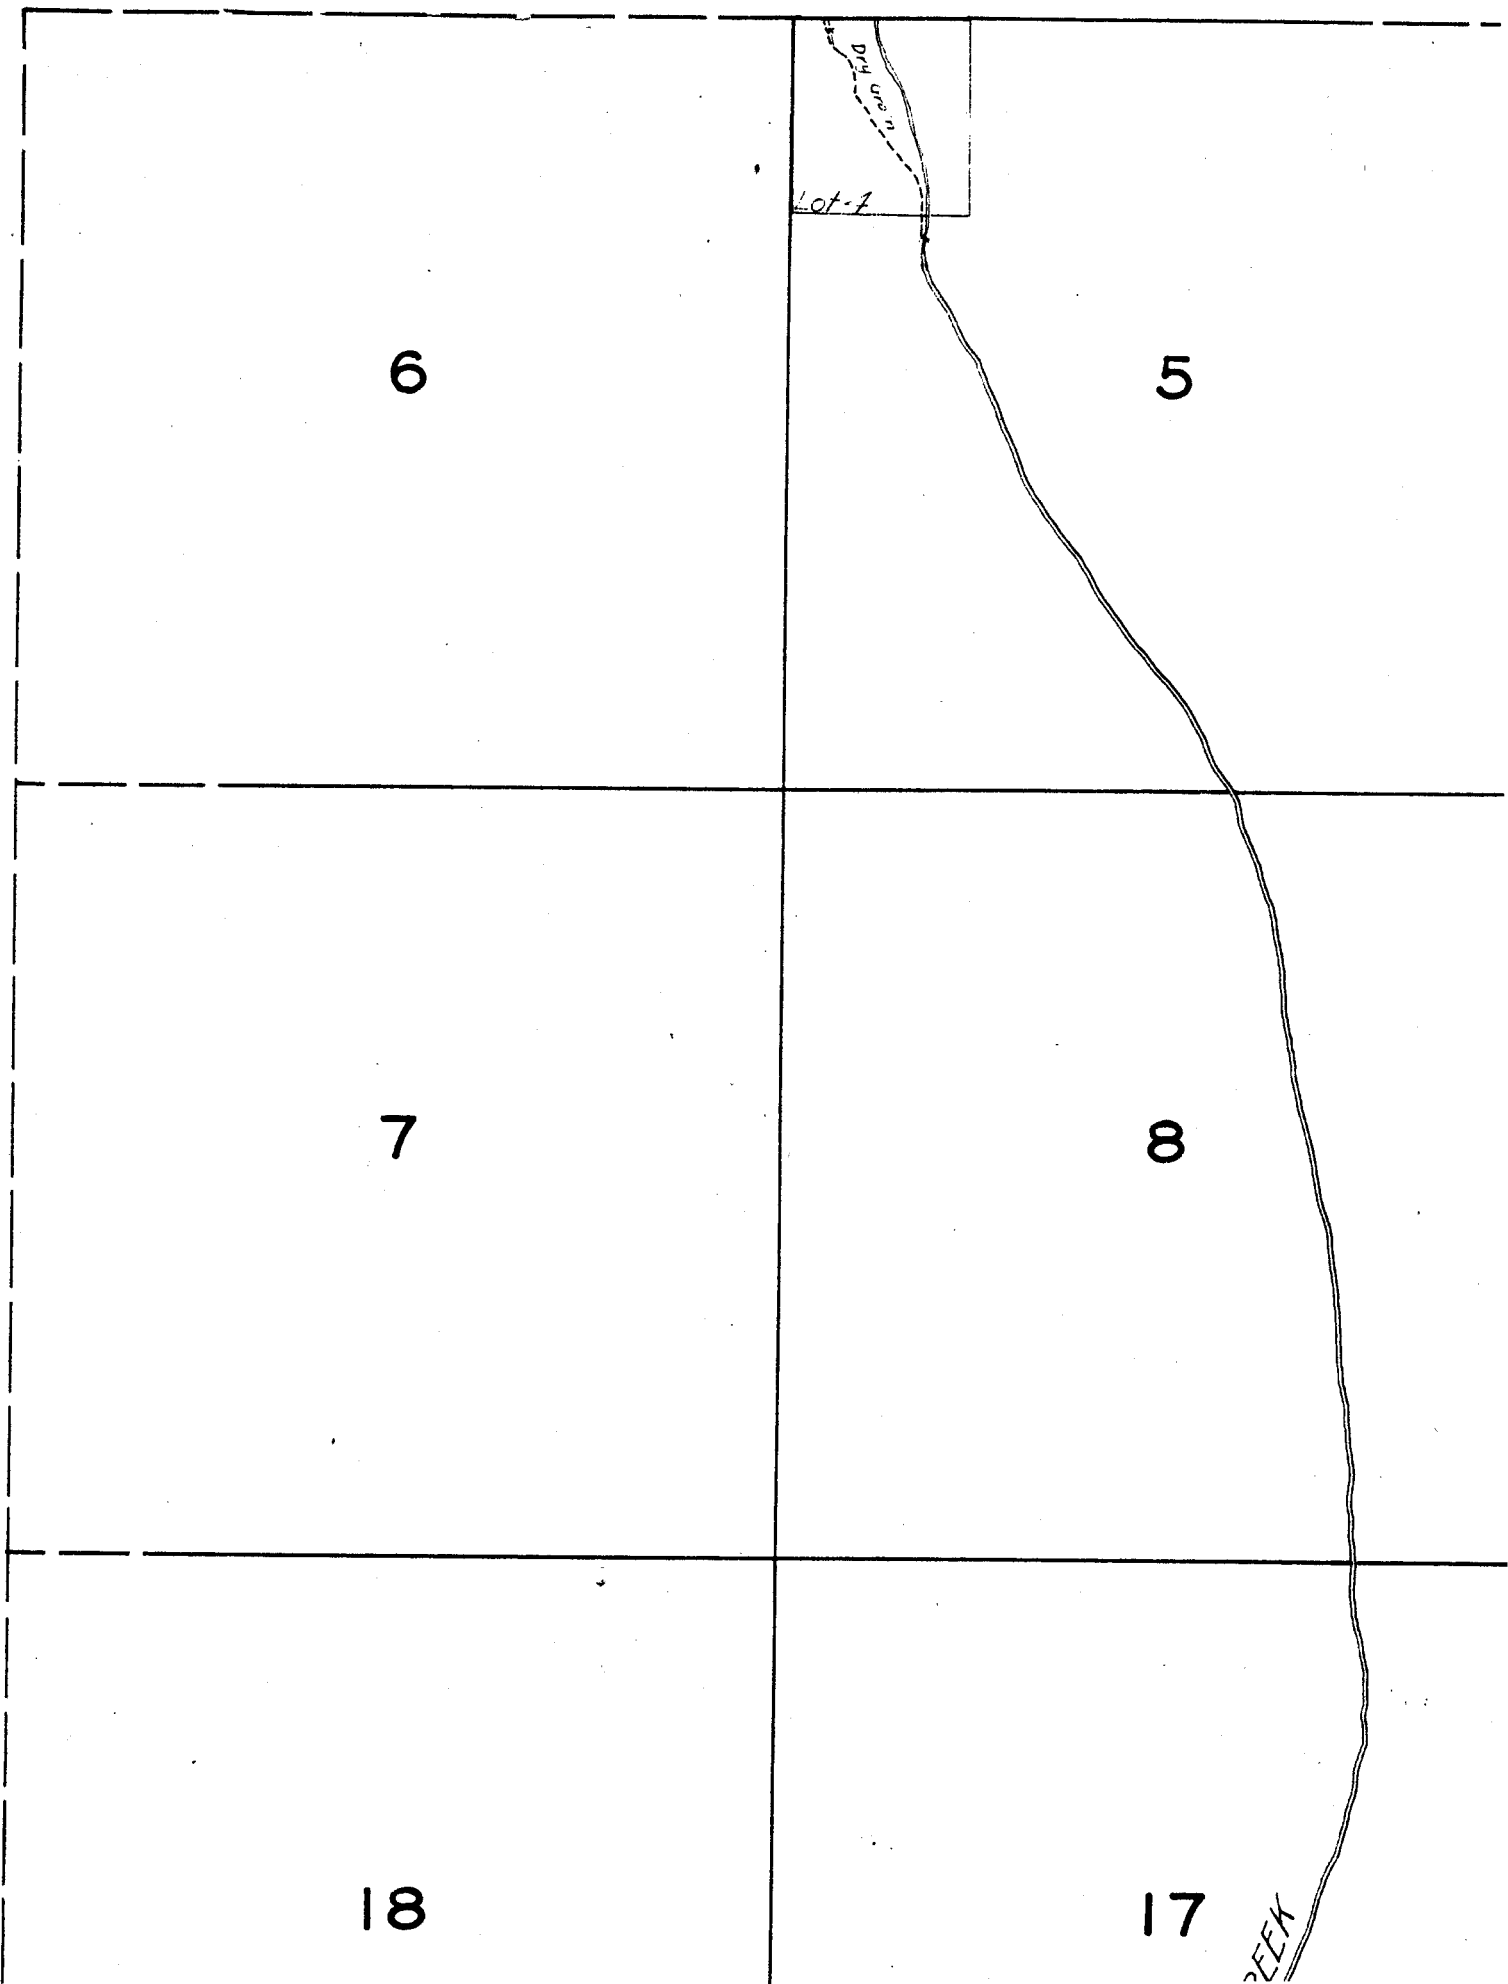

Surveyed Aug. 27, 1926.

Lot 2

Junipers

0 3/4

30 0 3/4

Lot 3

11 5/8

1 5/8

flume

3 1/2

Primeville Land & Livestock Co
James Scott (Sup't)

Lot 4

29

28

31

32

33

Surveyed Aug. 27, 1926.

18

19

17

20

16

21

CREEK

MUDDY

