


72-2-2

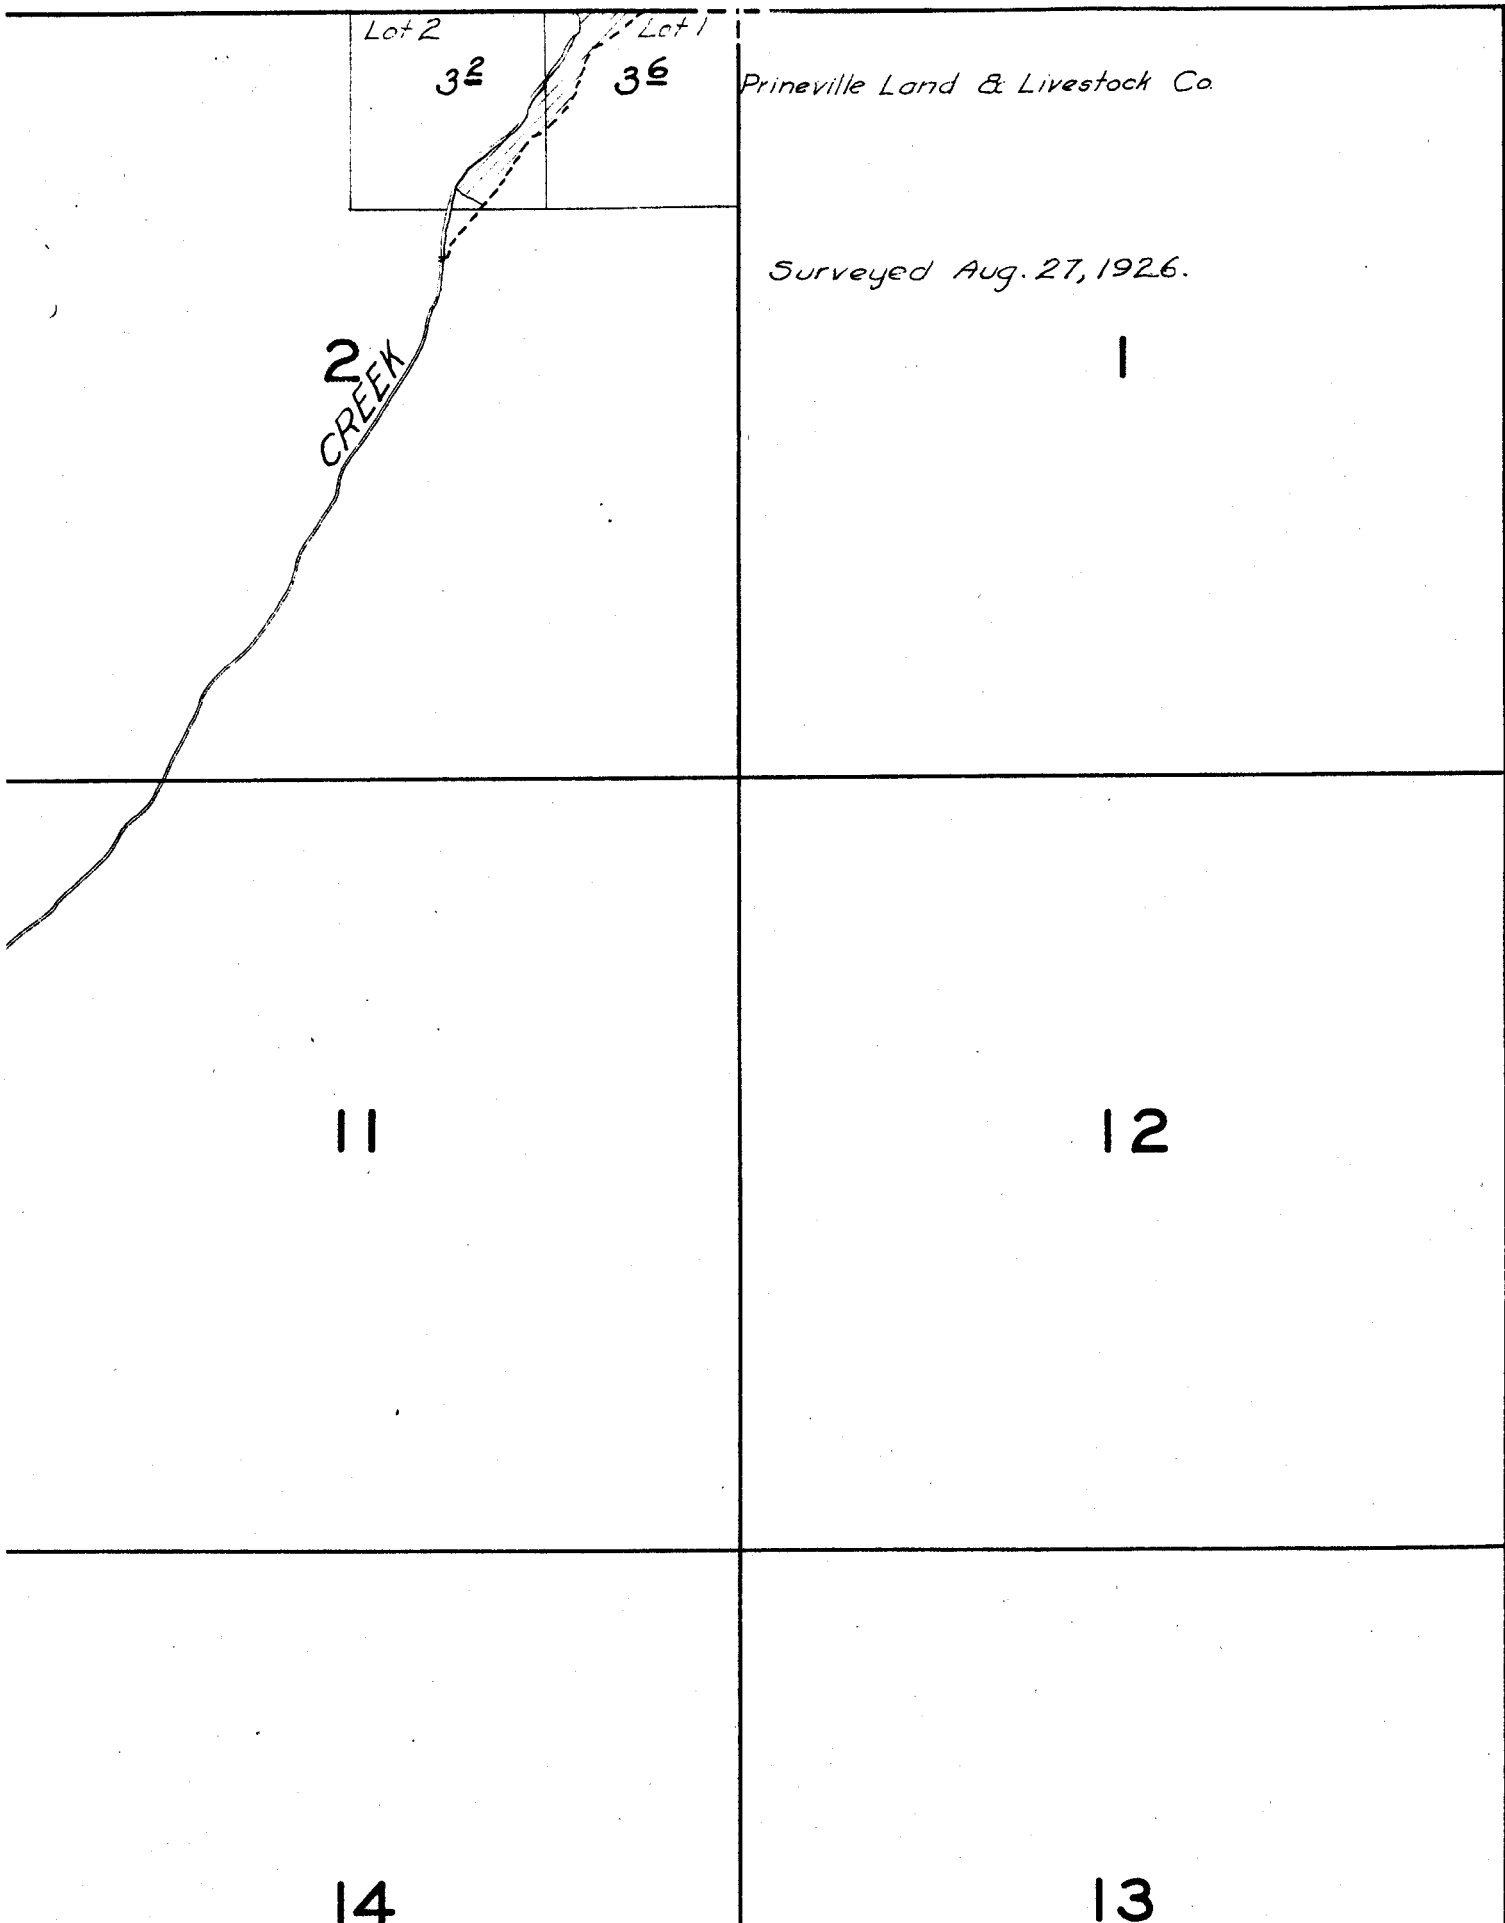

21

22

28

27

33

34

27

26

25

34

35

36

15


14

13

22

23

24

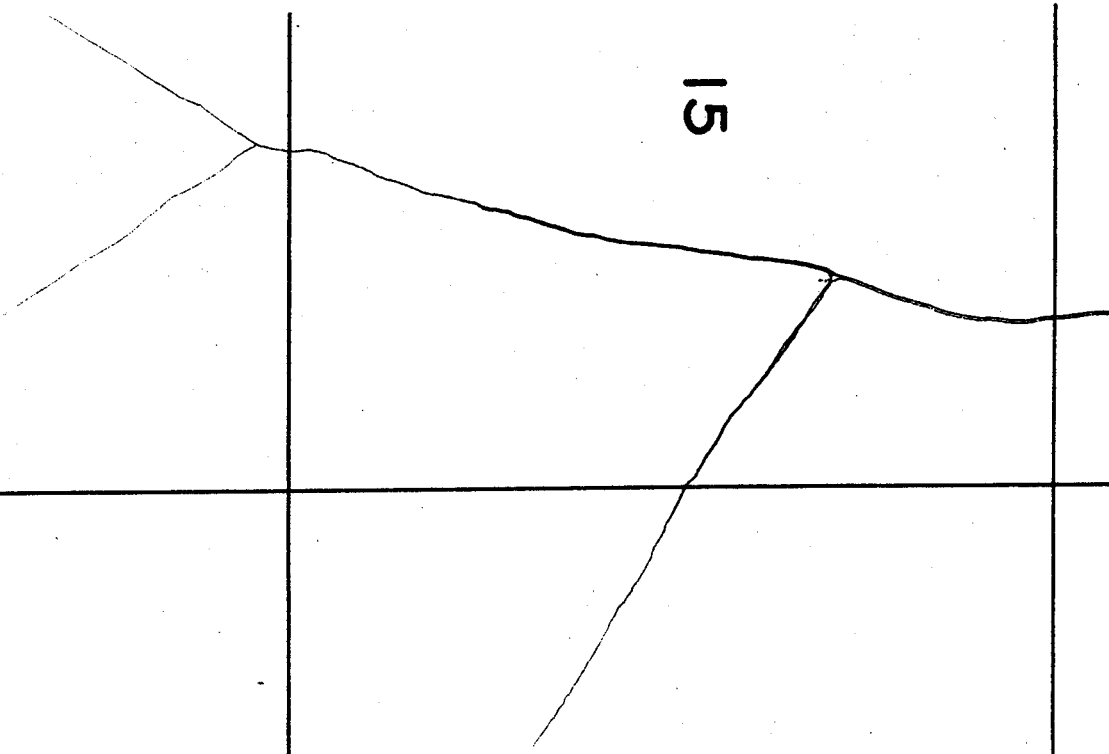

30

29

28

31

32

33

18

17


16


19

20

21

TOWNSHIP 10 S. RANGE 18 E.

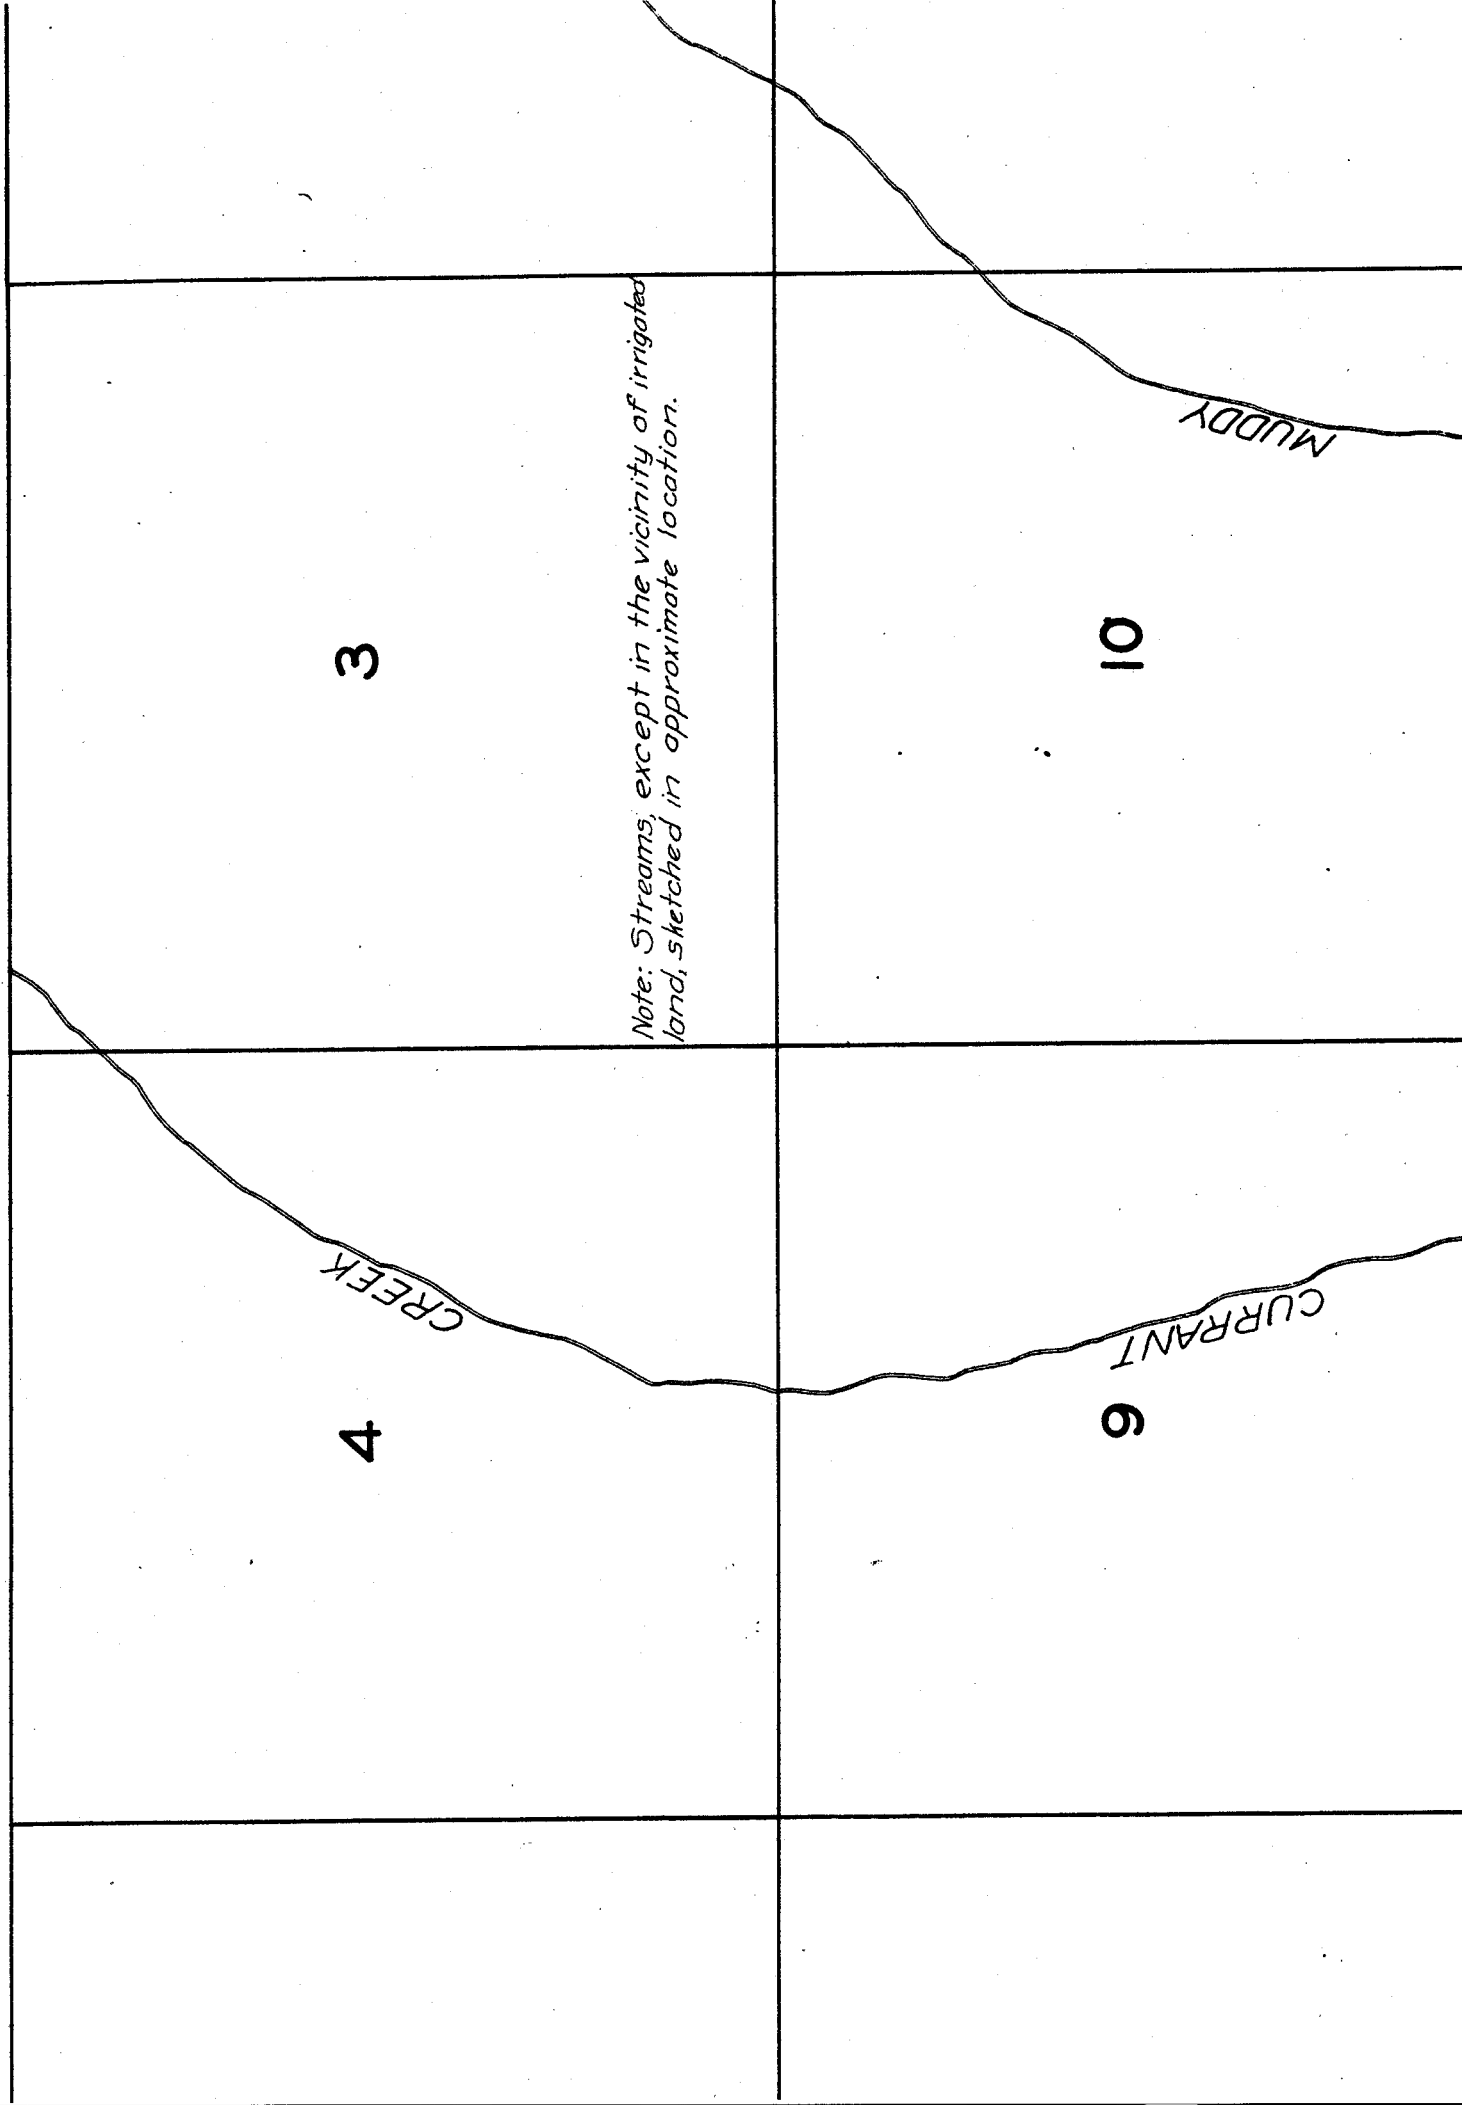

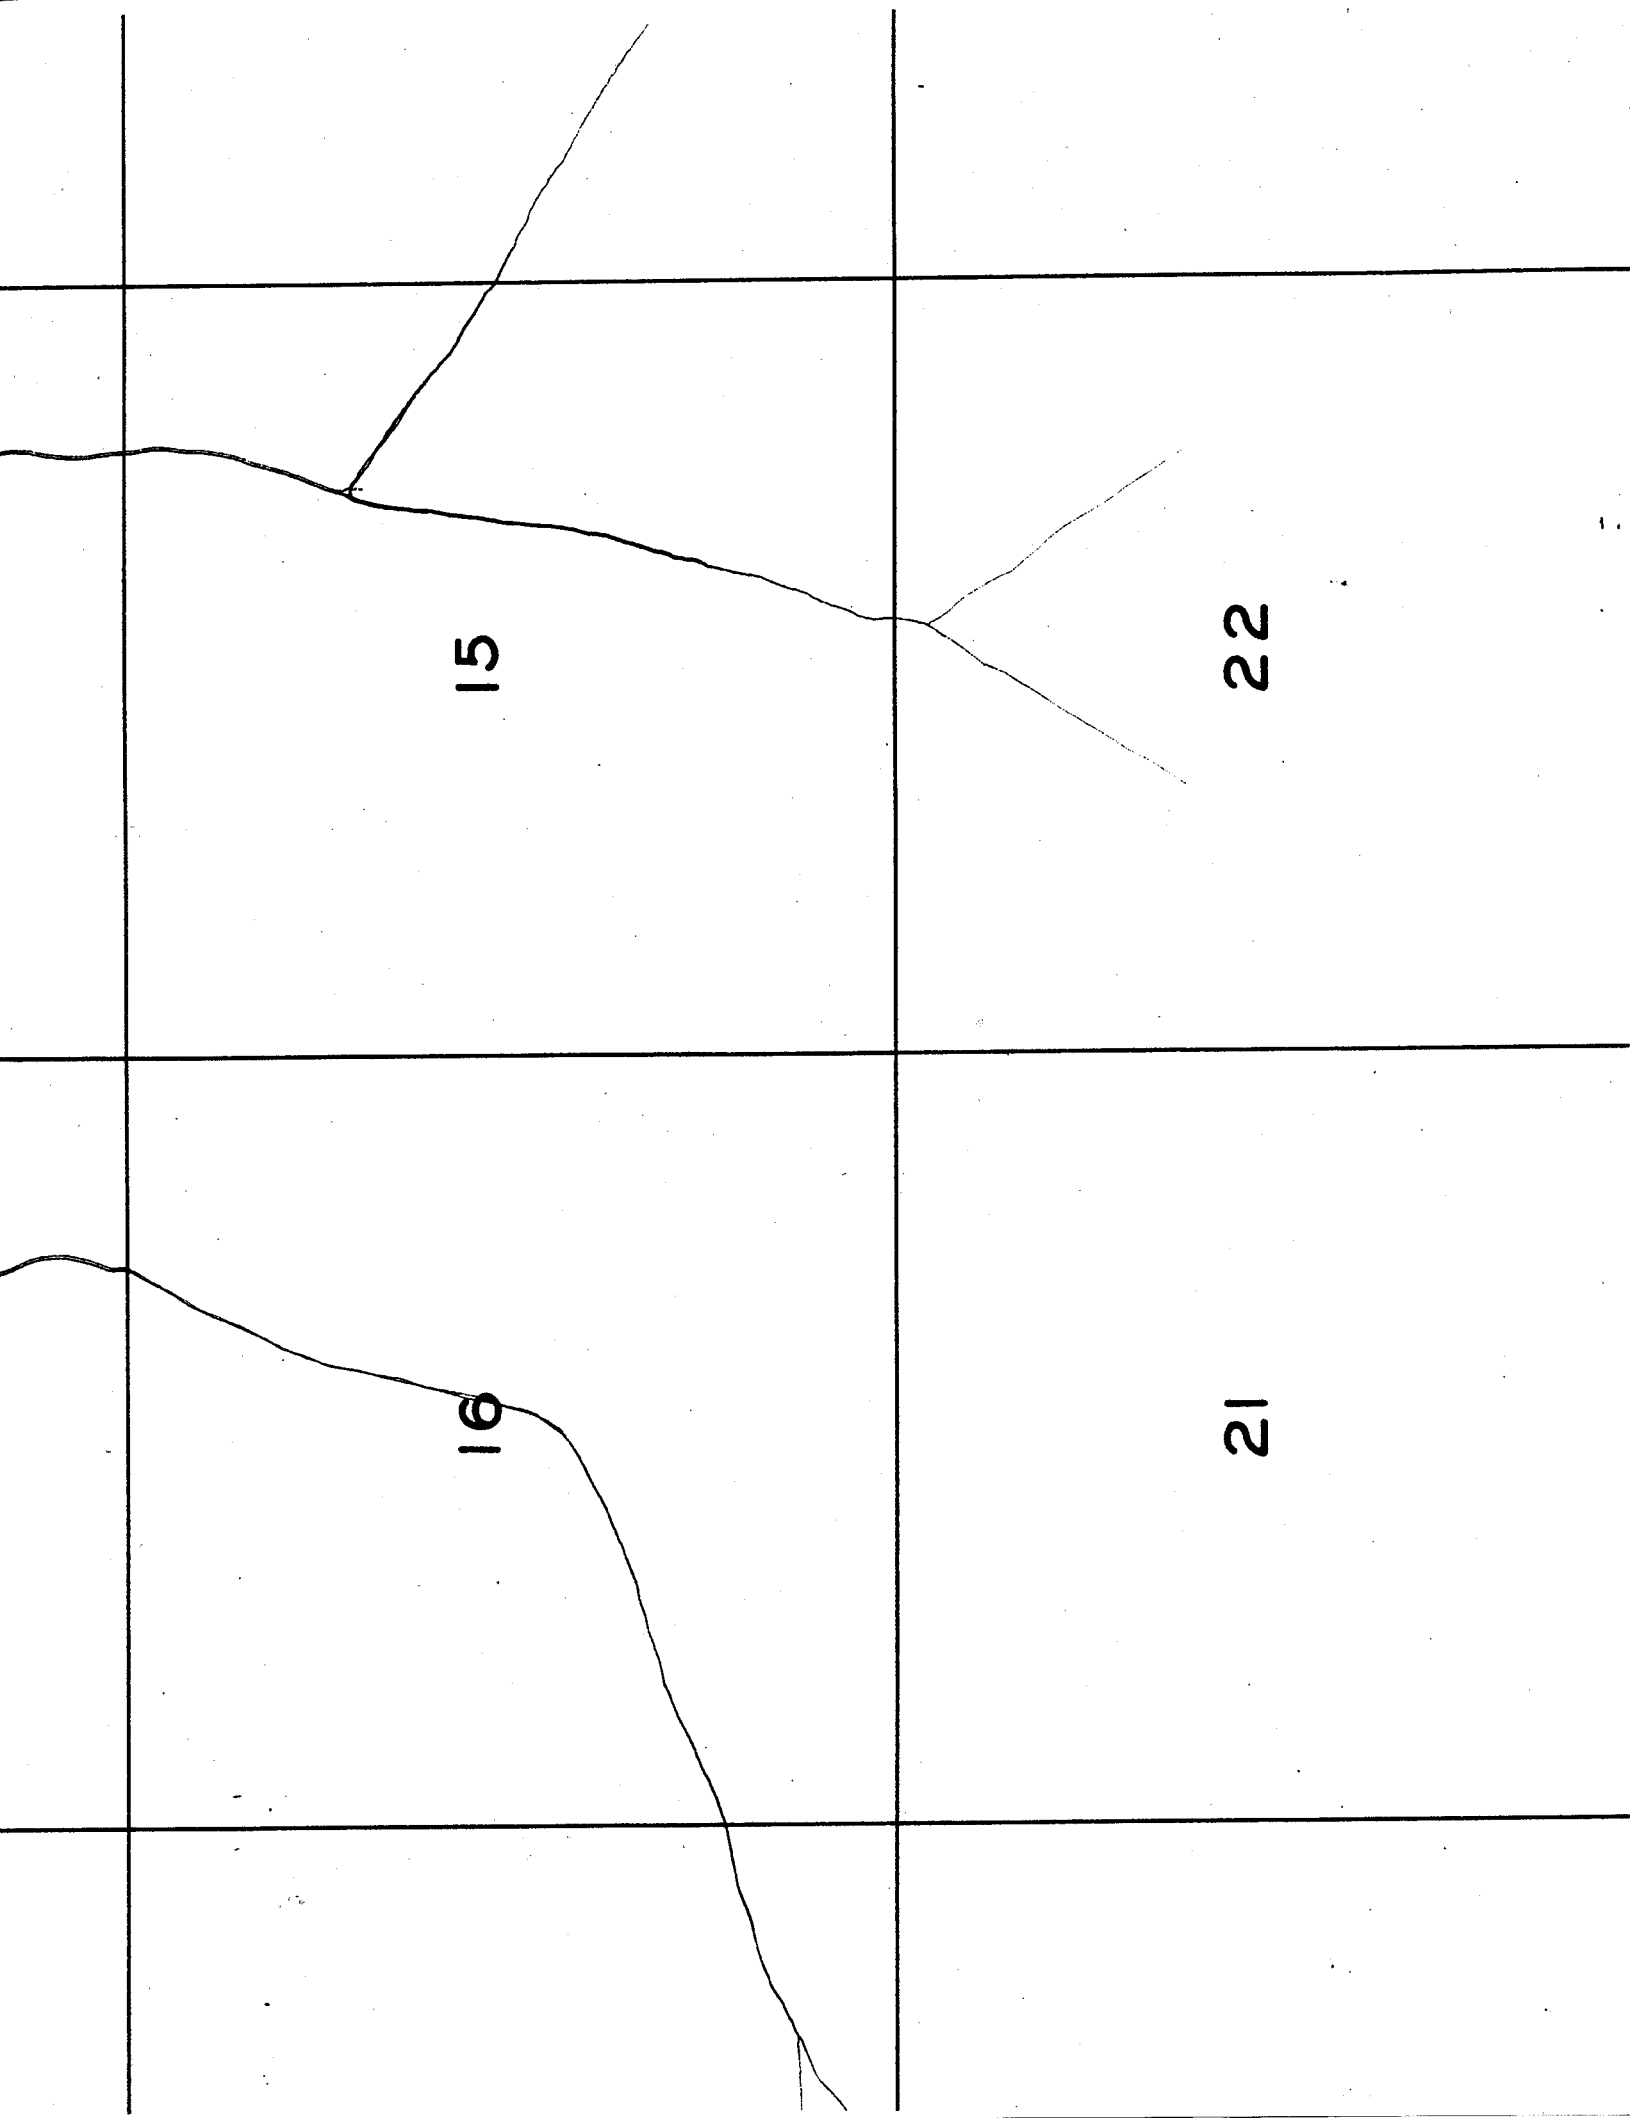

18

17

16

19

20

21

30

29

28

31

32

33

15

14

13

22


23

24

27

26

25

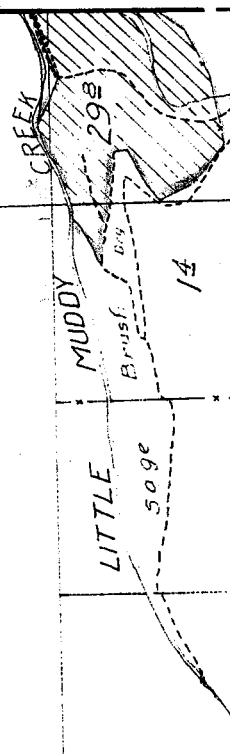


Prineville Land & Livestock Co.
James Scott (Supt.)
MUDY CREEK
BRUSH
sage

Surveyed Aug. 27, 1926.

34

35

36

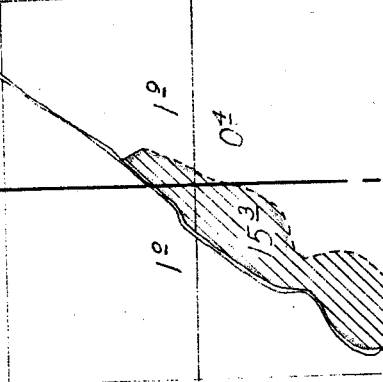

16

15

21

22

TOWNSHIP 9 S., RANGE 18 E.

4

3

9

10

2

1

11

12

14

13

6

5

7

8

18

17

21

22

28

27

33

34

6

5

7

8

18

17