

15

14

13

22

23

24

IVEY CREEK

62

02



17

RI Carner

05



Surveyed Sept. 29, 1925.

Palm Cr.

27

26

25

34

35

36

30

29

28

31


32


33

Surveyed Sept. 29, 1925.

Surveyed Se


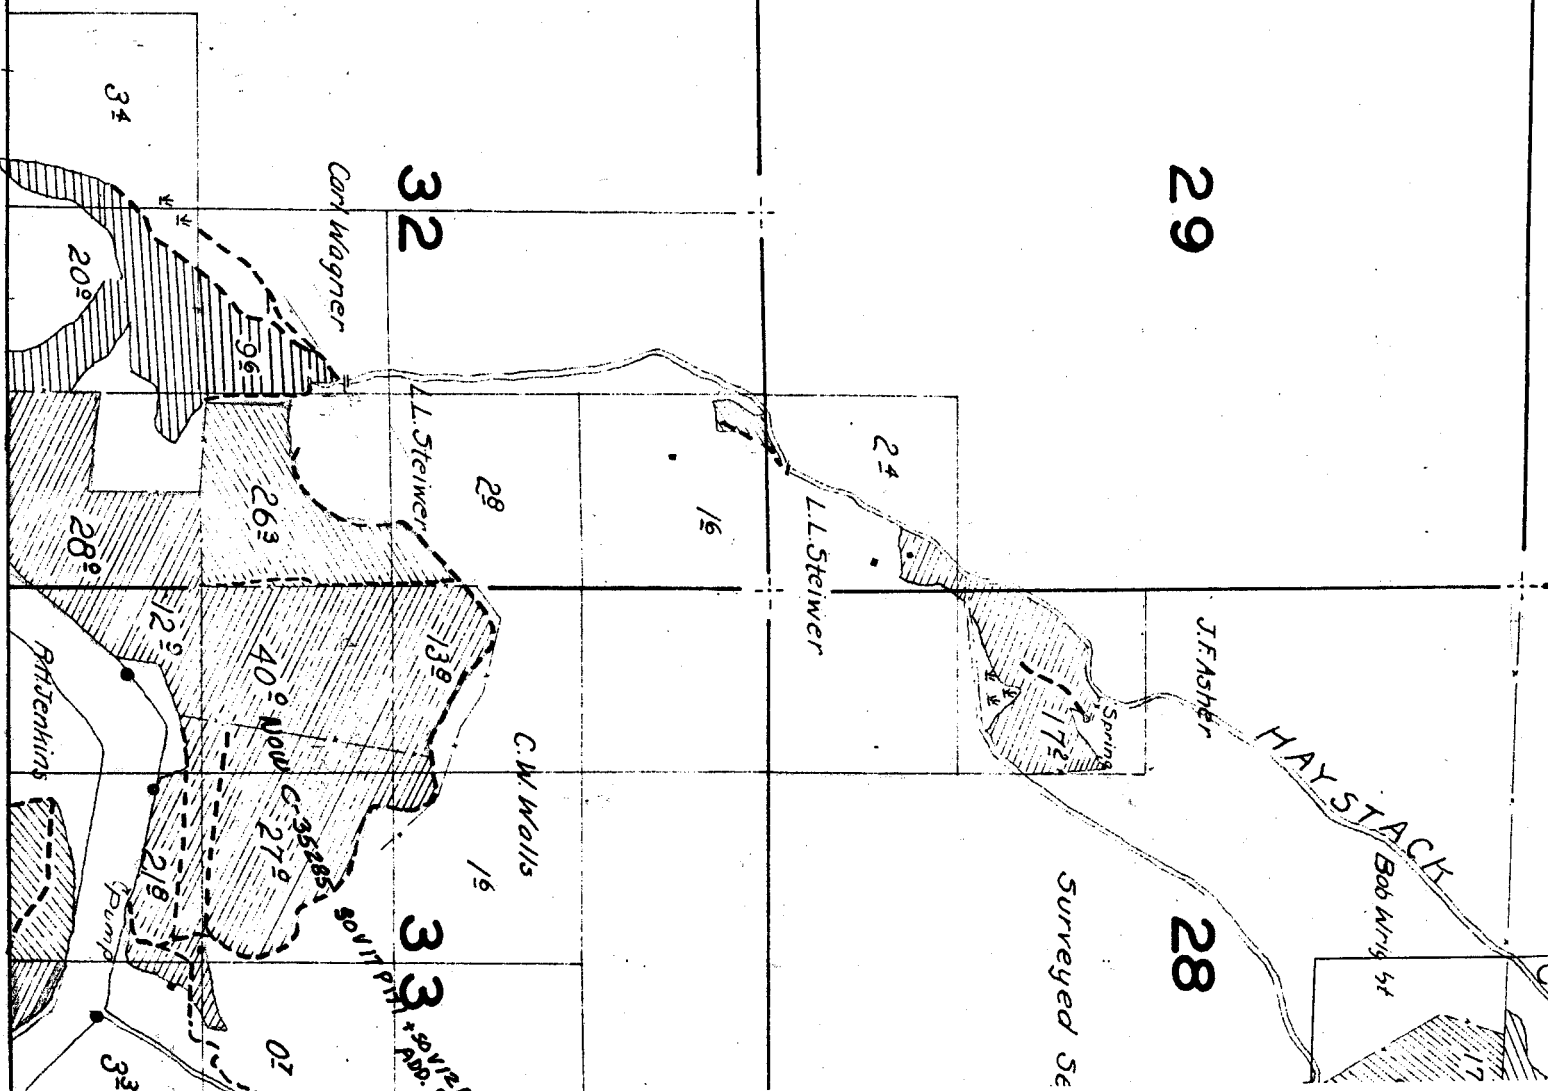

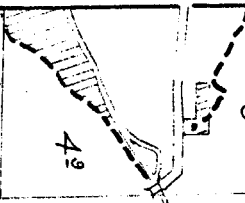

A.S. Borges

4²

18

17


16

19

20

21

Note: Location of streams and roads, except in the vicinity of irrigated land, is sketched in approximate location.

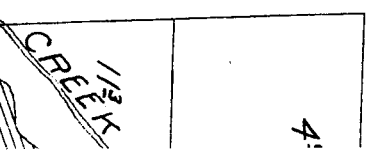

4¹


15

22

16

21

L.H. Donovan

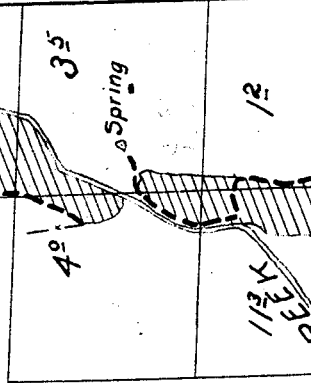

is, except
nd, is
ation.

6

5

7

13

03

8

Wage 8⁶
E.R. Modre

02

4⁹

A.S. Borges

18

17

2

1

11

12

14

13

21

22

4°

7°

3°

Spring

L.H. Donovan

11³
CREEK

1²

17°

4°

HAYSTACK

Bob Wright

J.F. Asher

28

27

Spring

17°

Surveyed Sept. 19 to 23, 1926

Steiner

5°

C.W. Walls

1°

A.E. Cress

1°

33

34

13°

40°

Now C-35285

27°

0°

12°

21°

Pump

3°

R.H. Jenkins

6m

TOWNSHIP 8 S., RANGE 25 E.

