

18


17

16

19

20

21

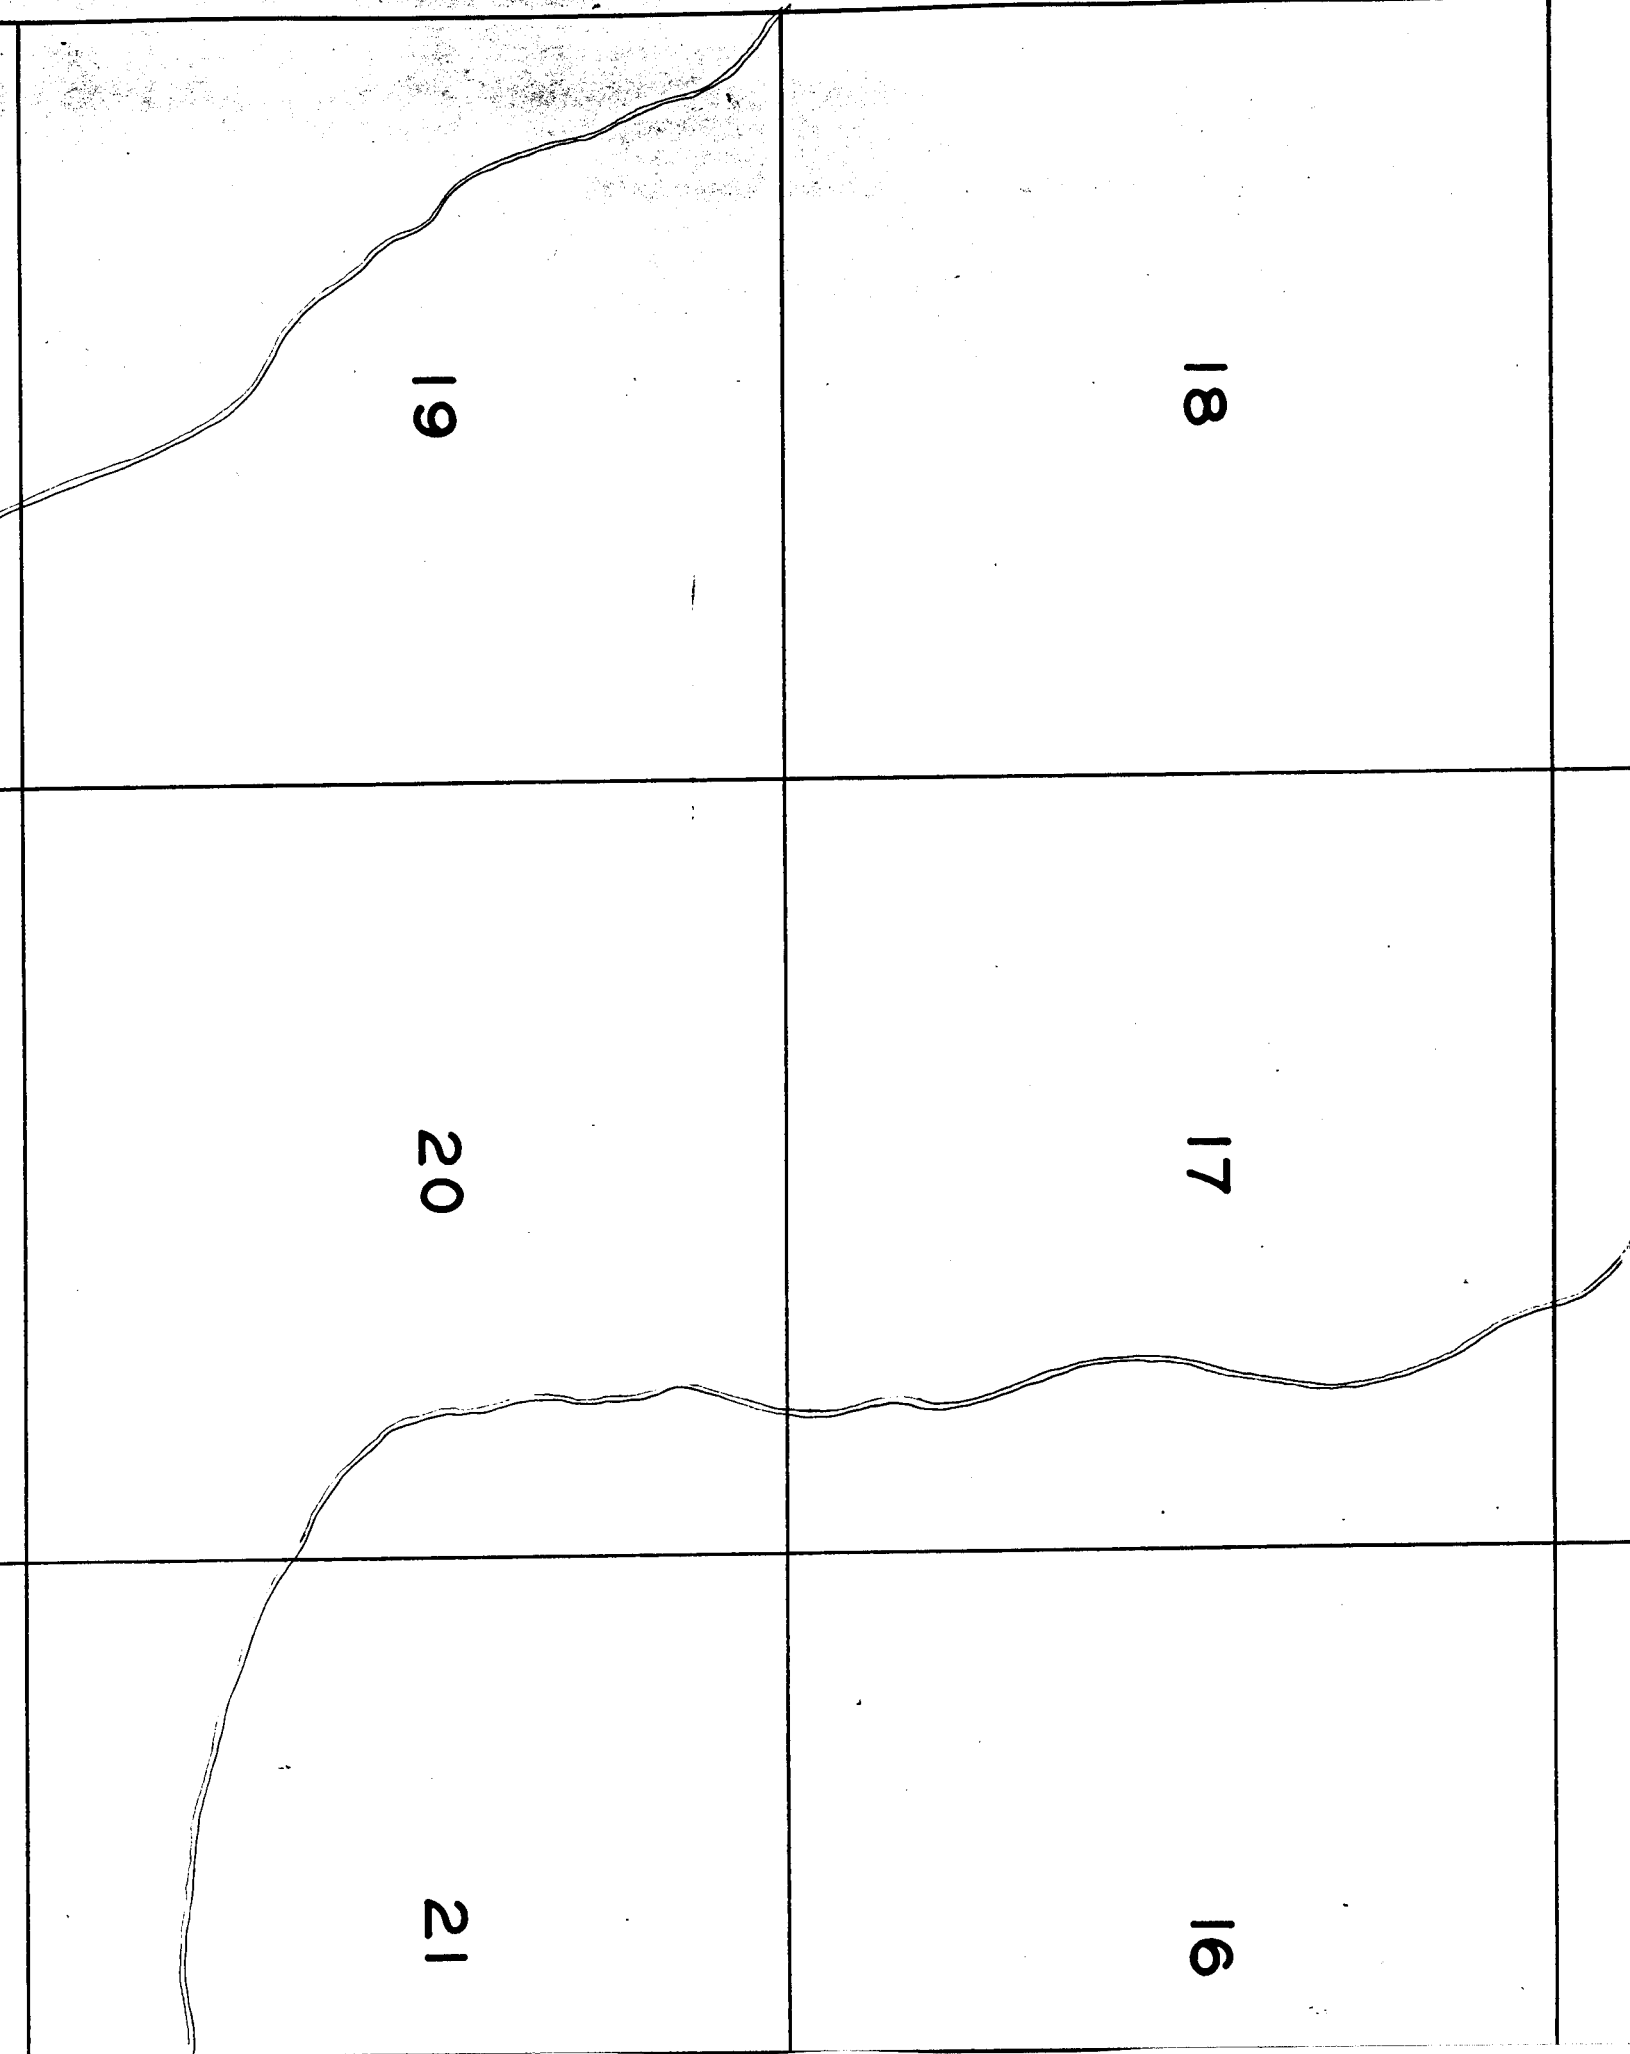

30


29

28


31

32

33

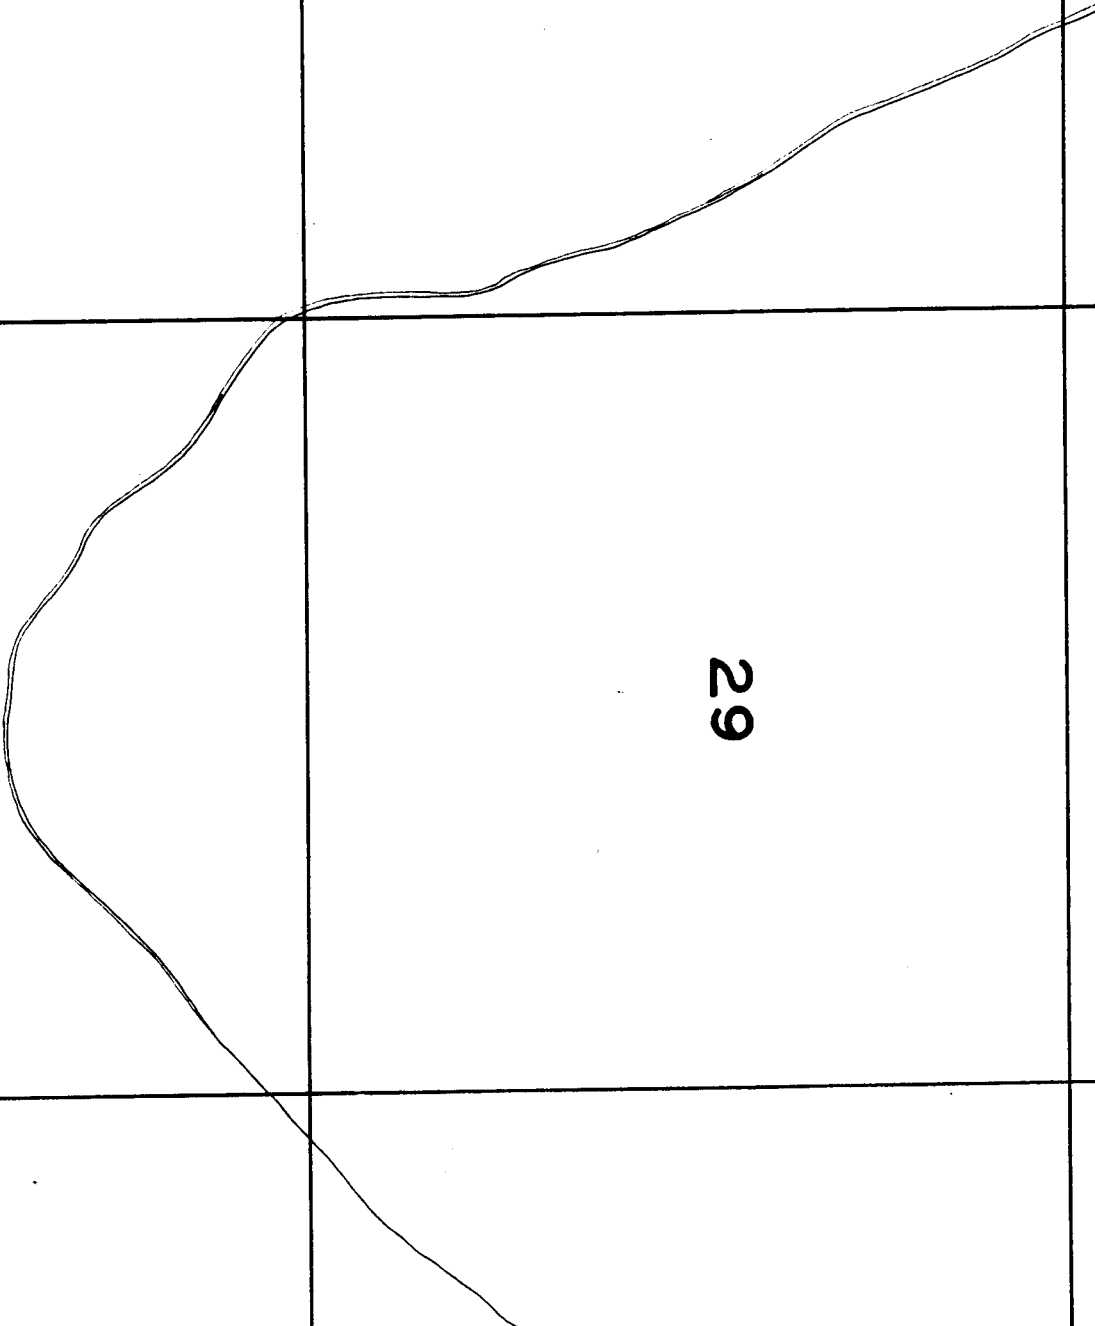

TOWNSHIP 5 S., RANGE 23 E.

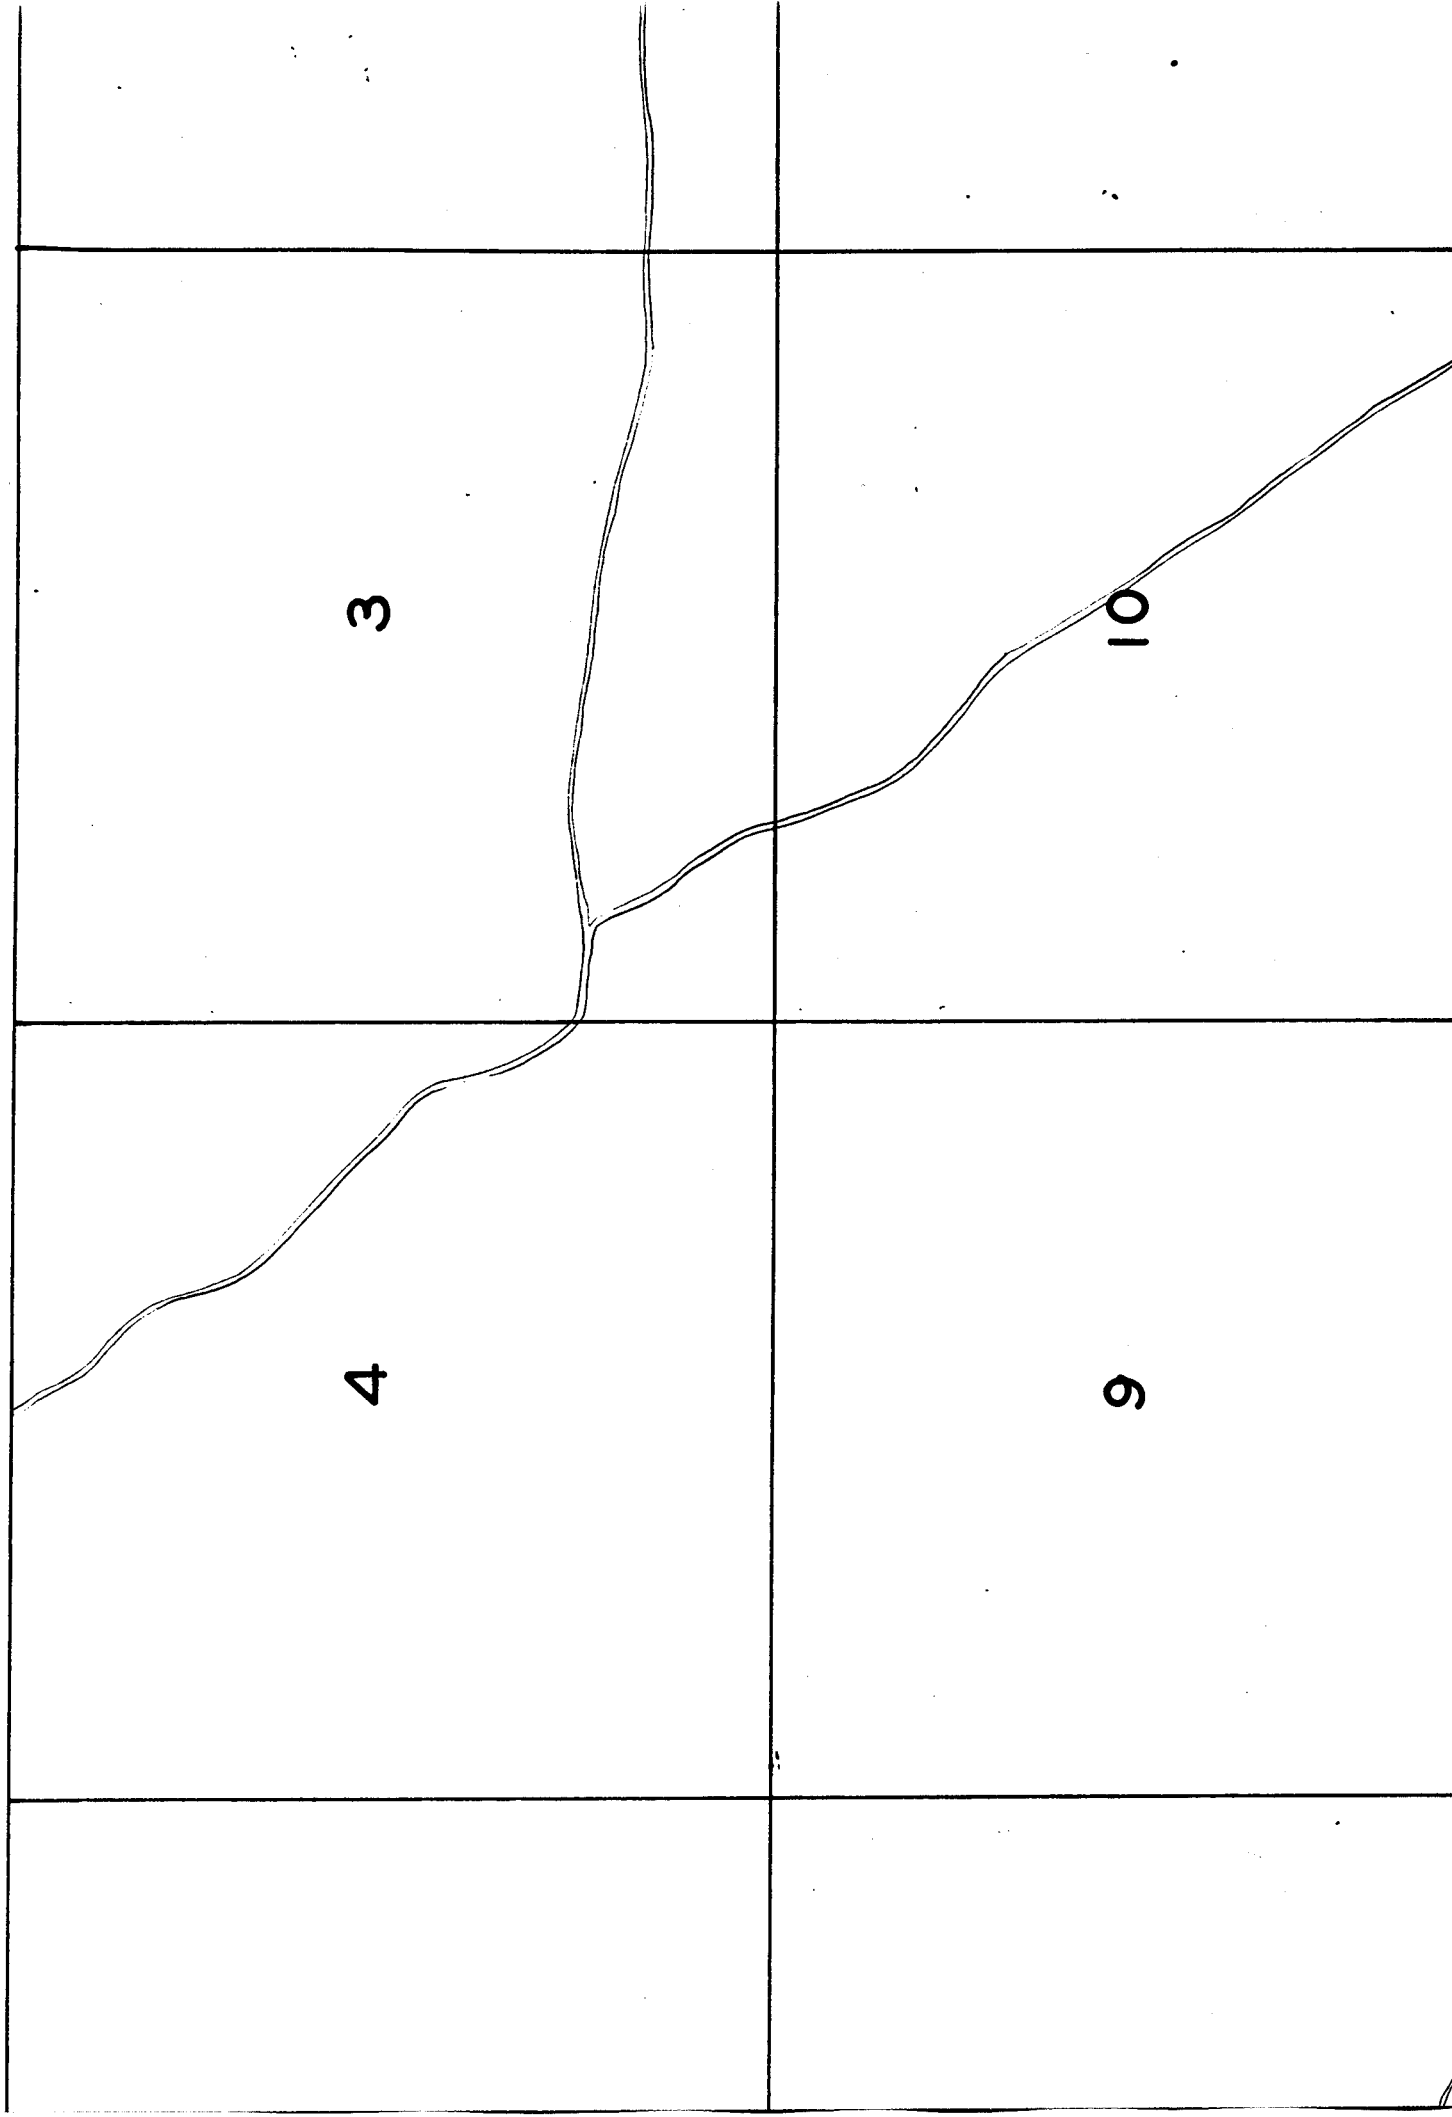


Q

5

— 2 —

22

Surveyed May 28, 1925.

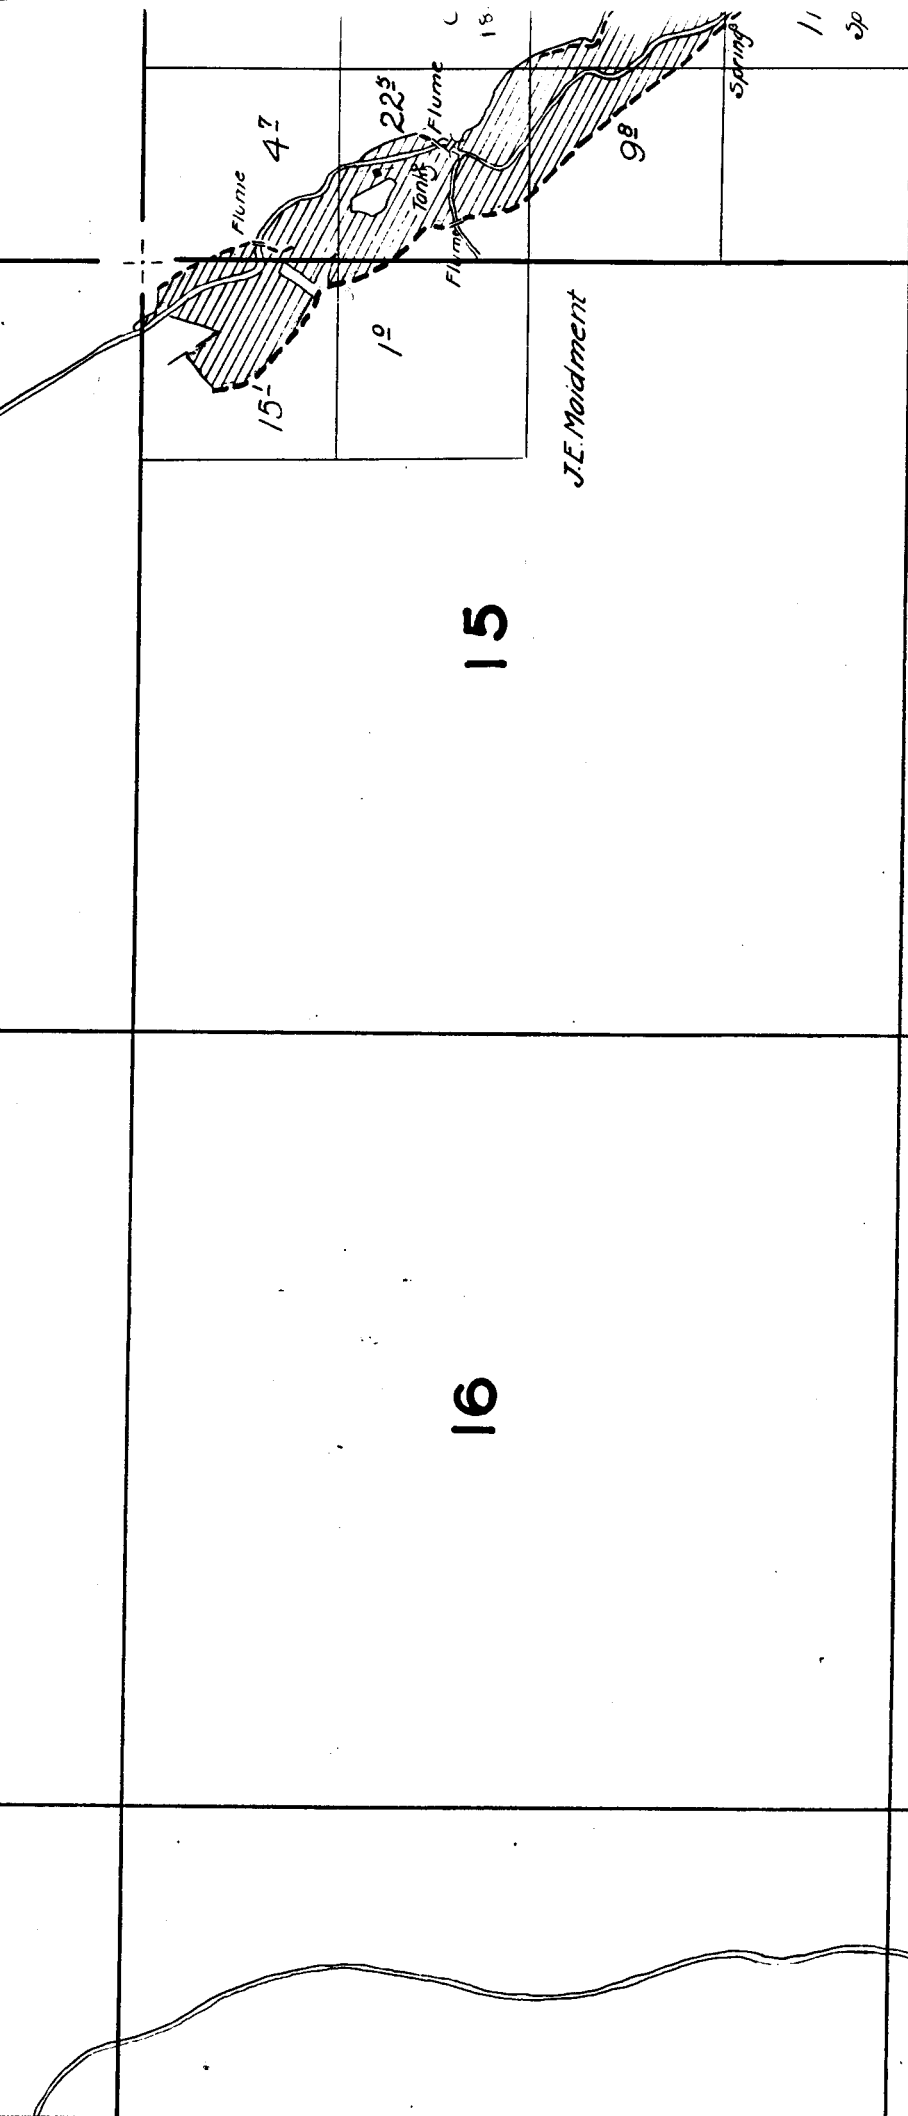

2


1


11

12

14

13

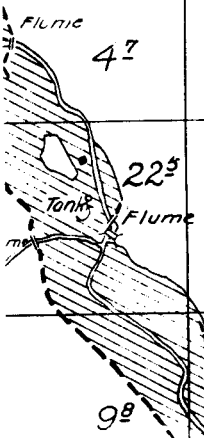

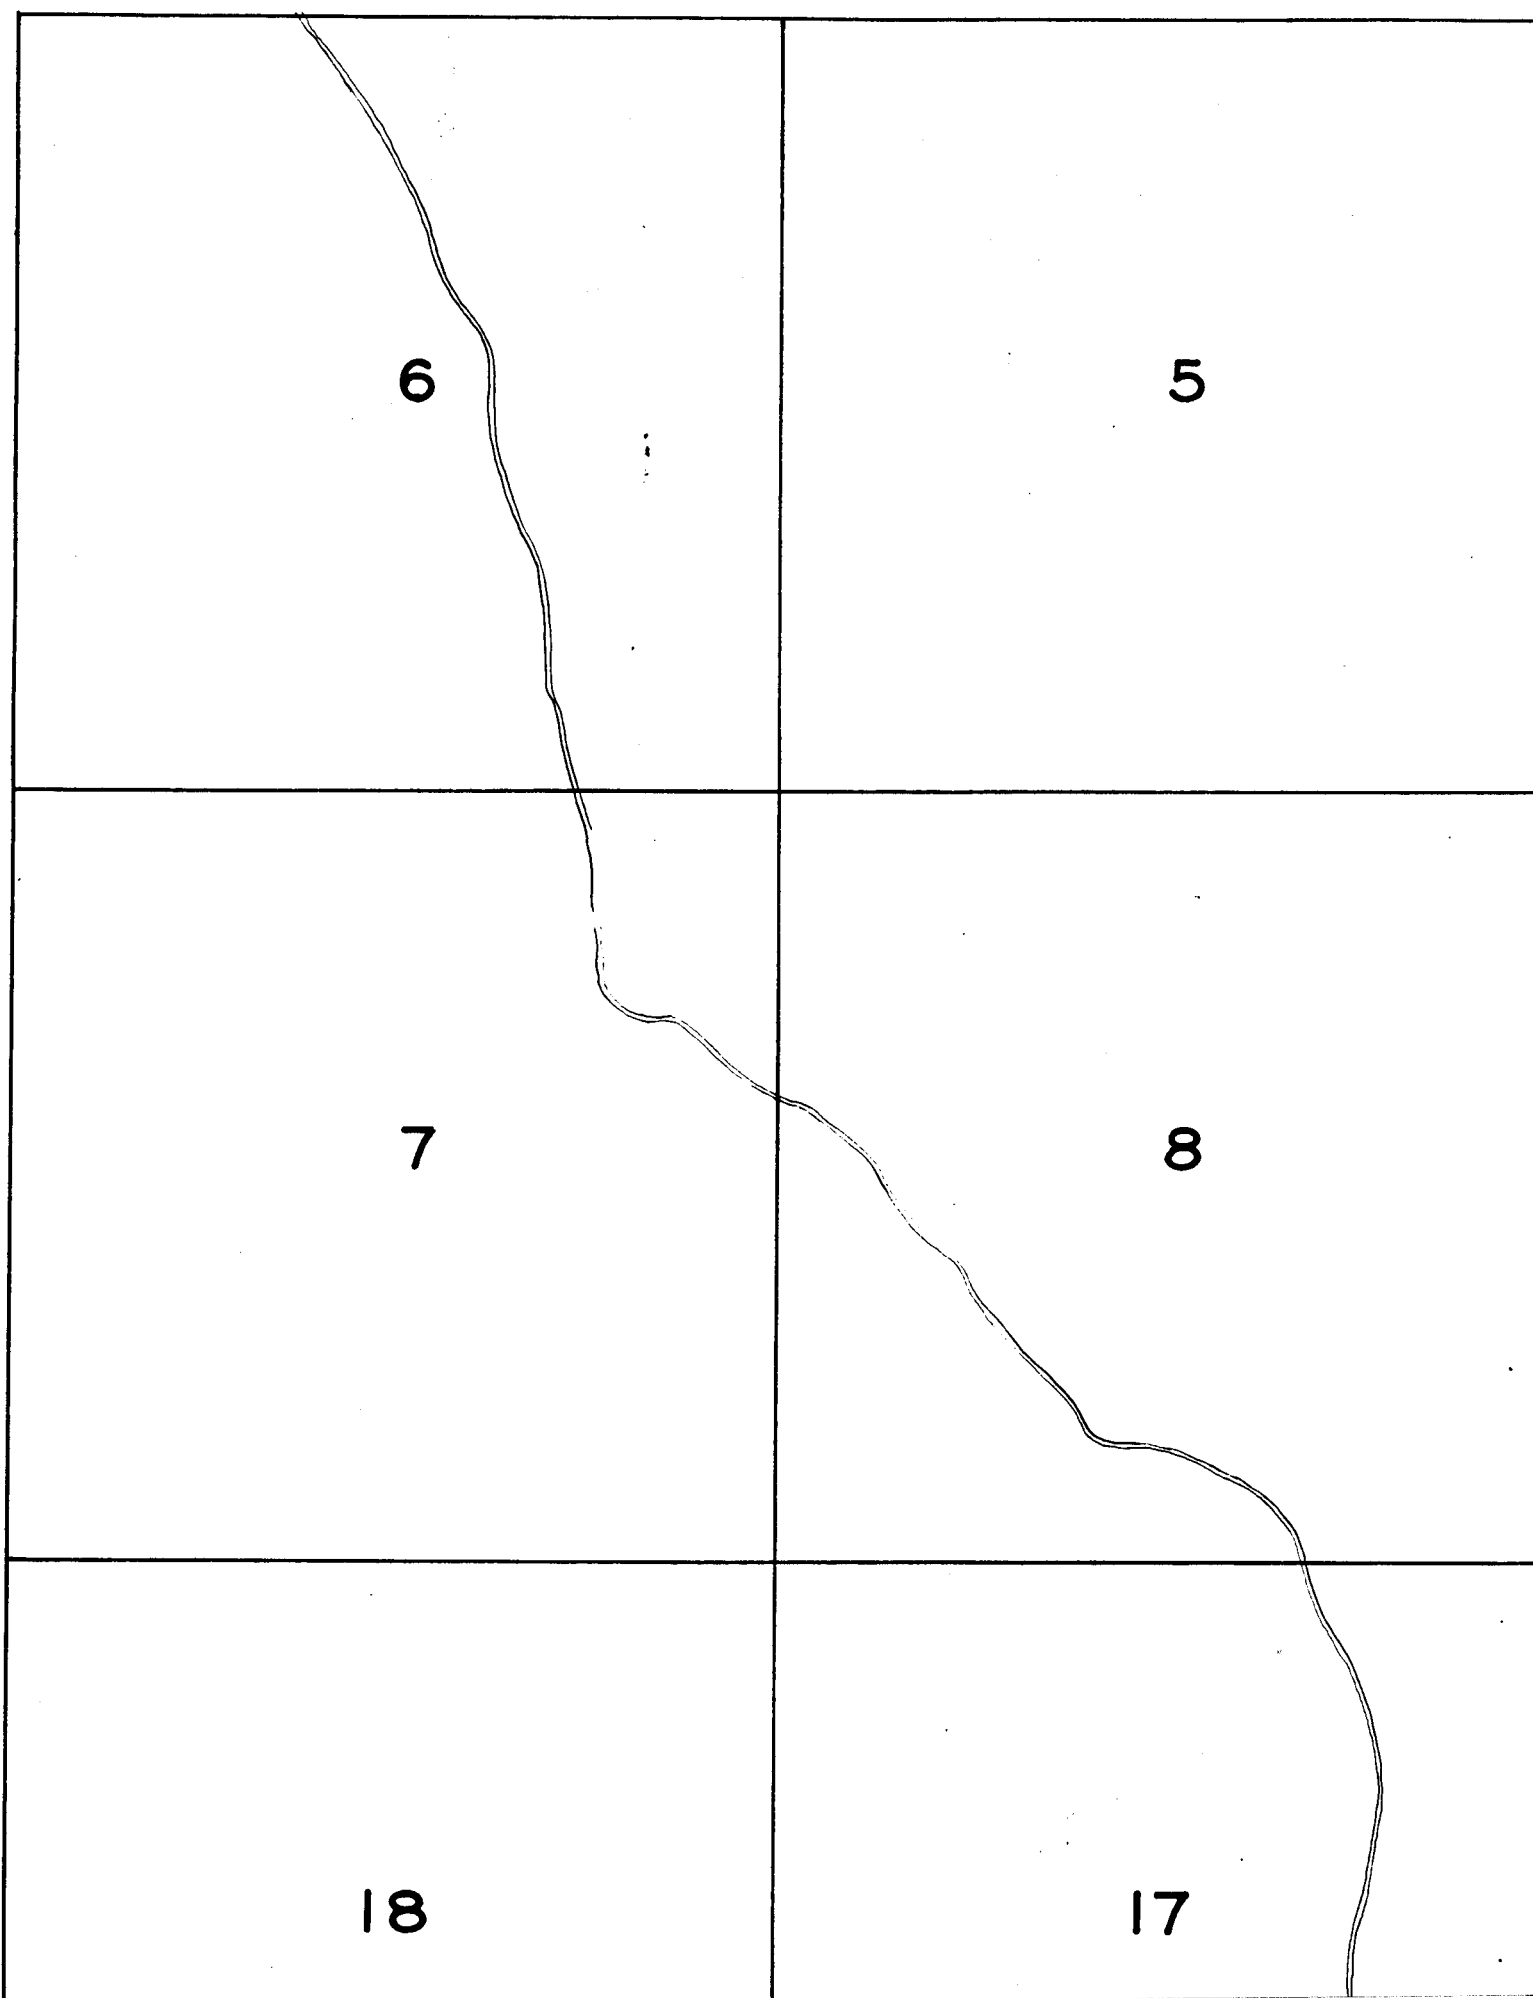

21

22

28

27

33

34

27

26


25

*Note: Streams except in the vicinity of
irrigated land are sketched in the
approximate location*

34

35

36

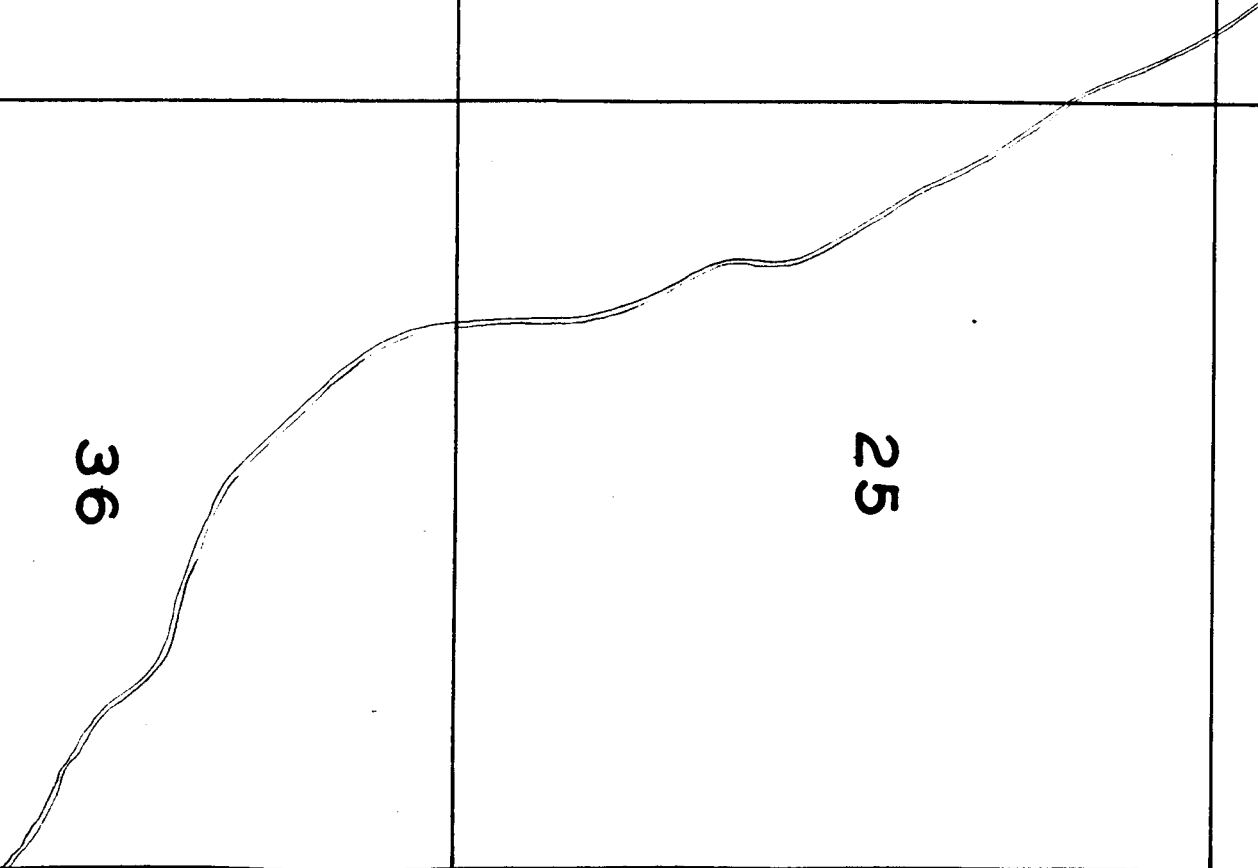

4







