

21

22

2^d
FWBall

*Note: Location according
to Mr. Ball.*

■ School

28

27

33

34

Note: Streams not in the vicinity of
project lands sketched in approximate location.

COTTONWOOD

7

C.L. Rindie 31

32

urveyed June, 1927

16

15

CREEK

0


21


22


22
FW/Ball

Note: Location according
to Mr. Ball.
School

TOWNSHIP 7 S., RANGE 21 E.

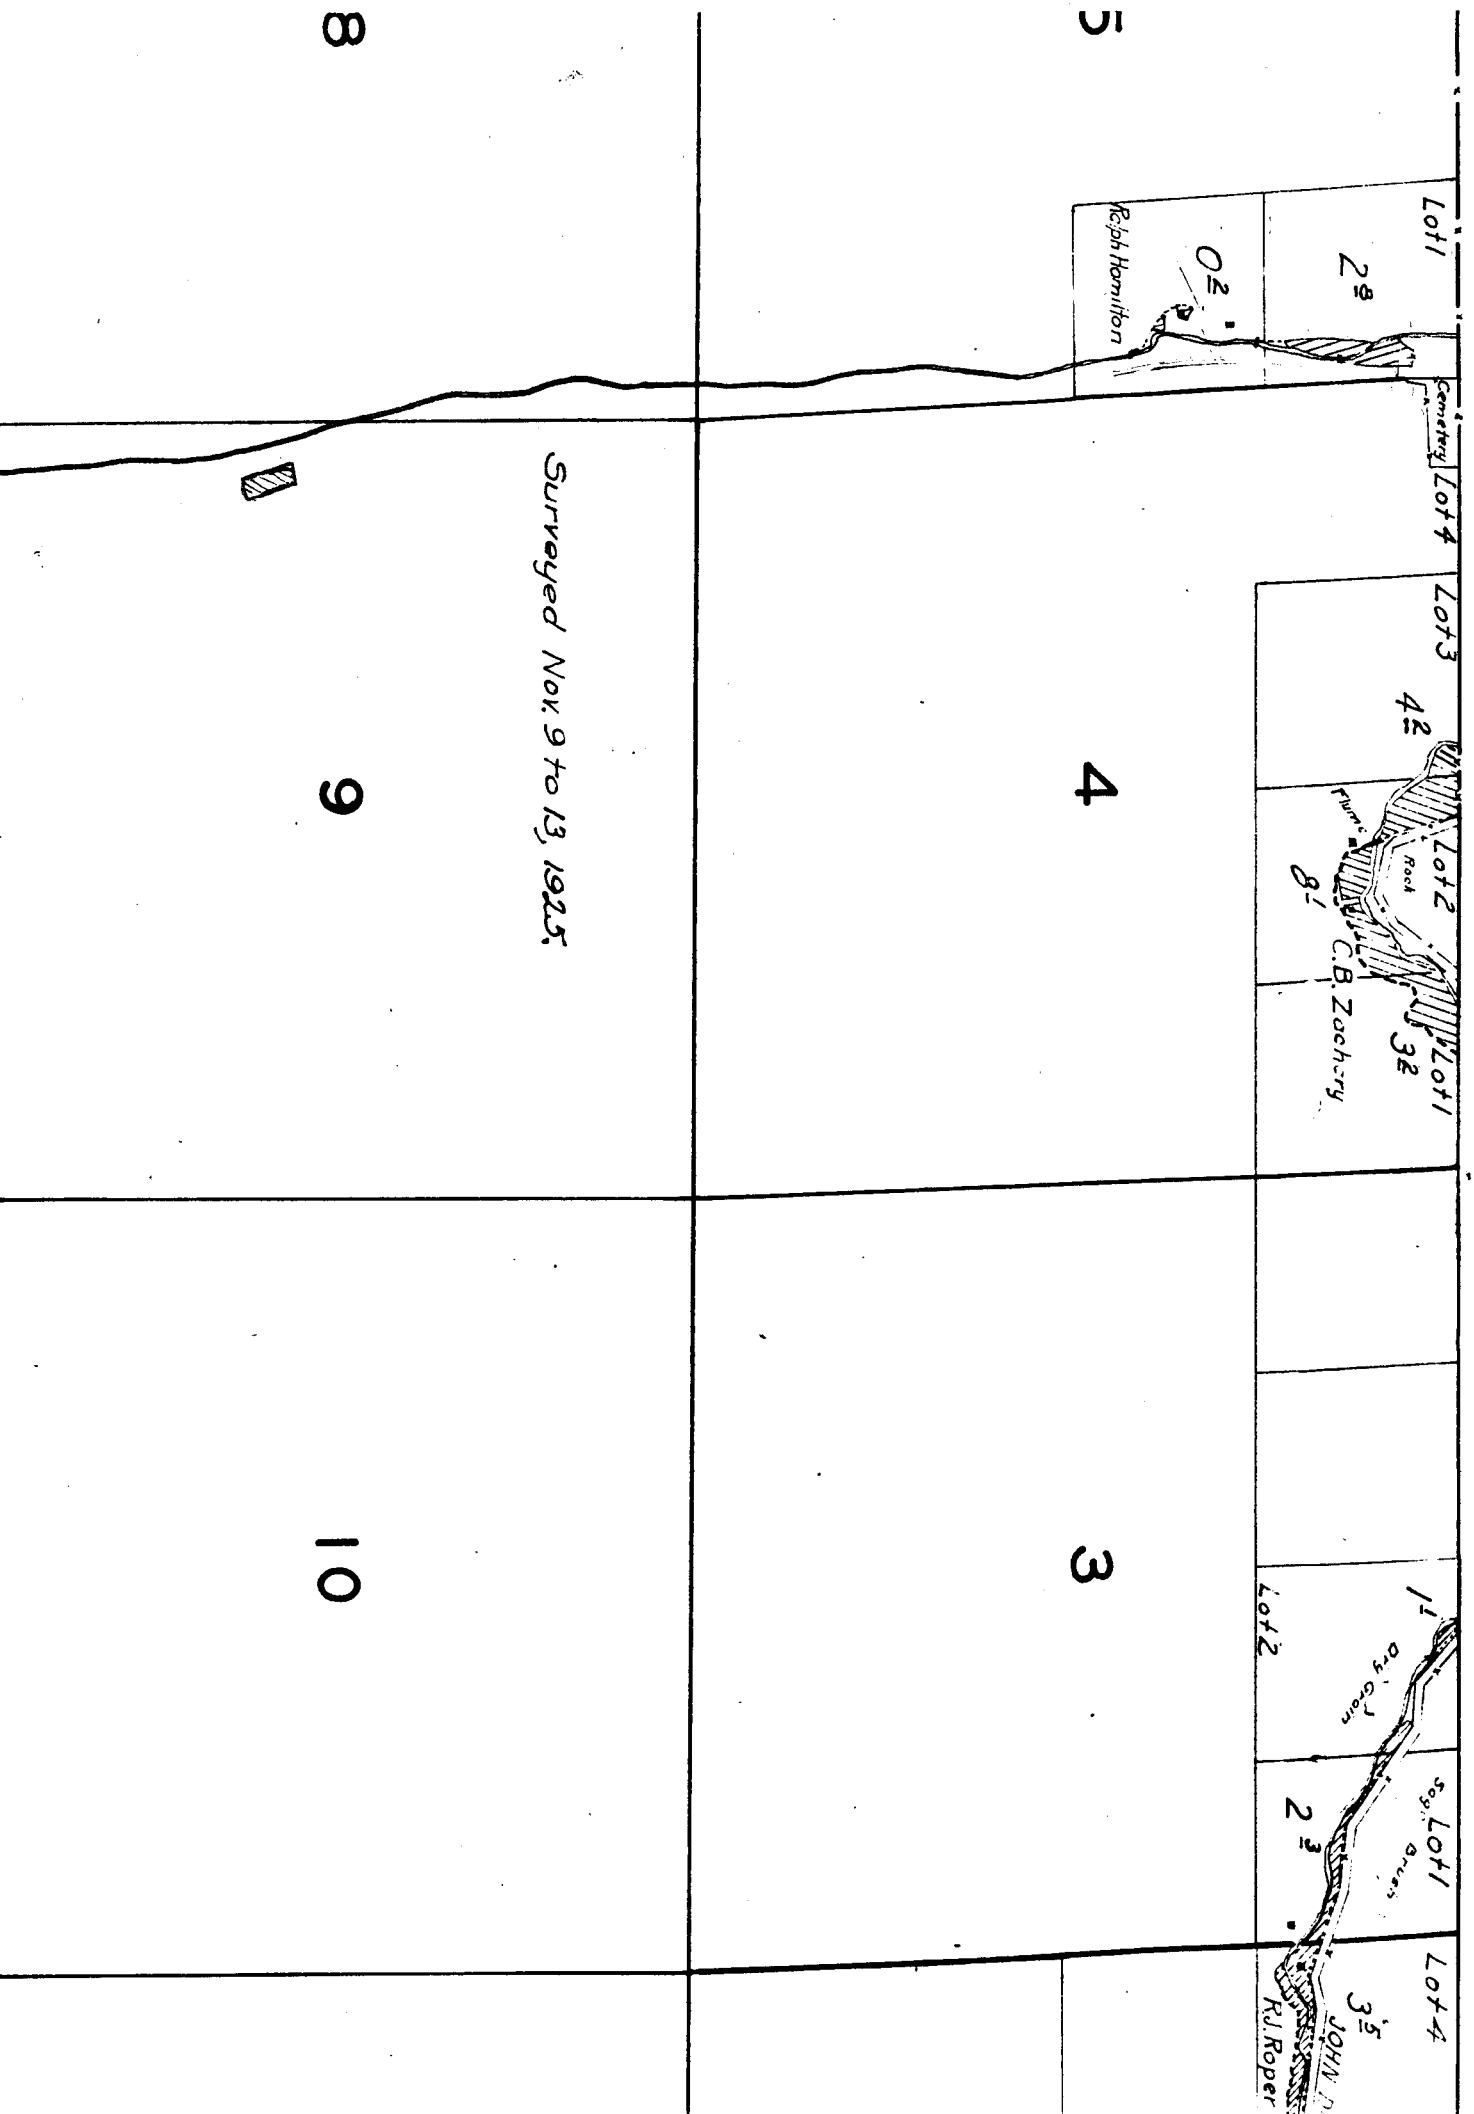

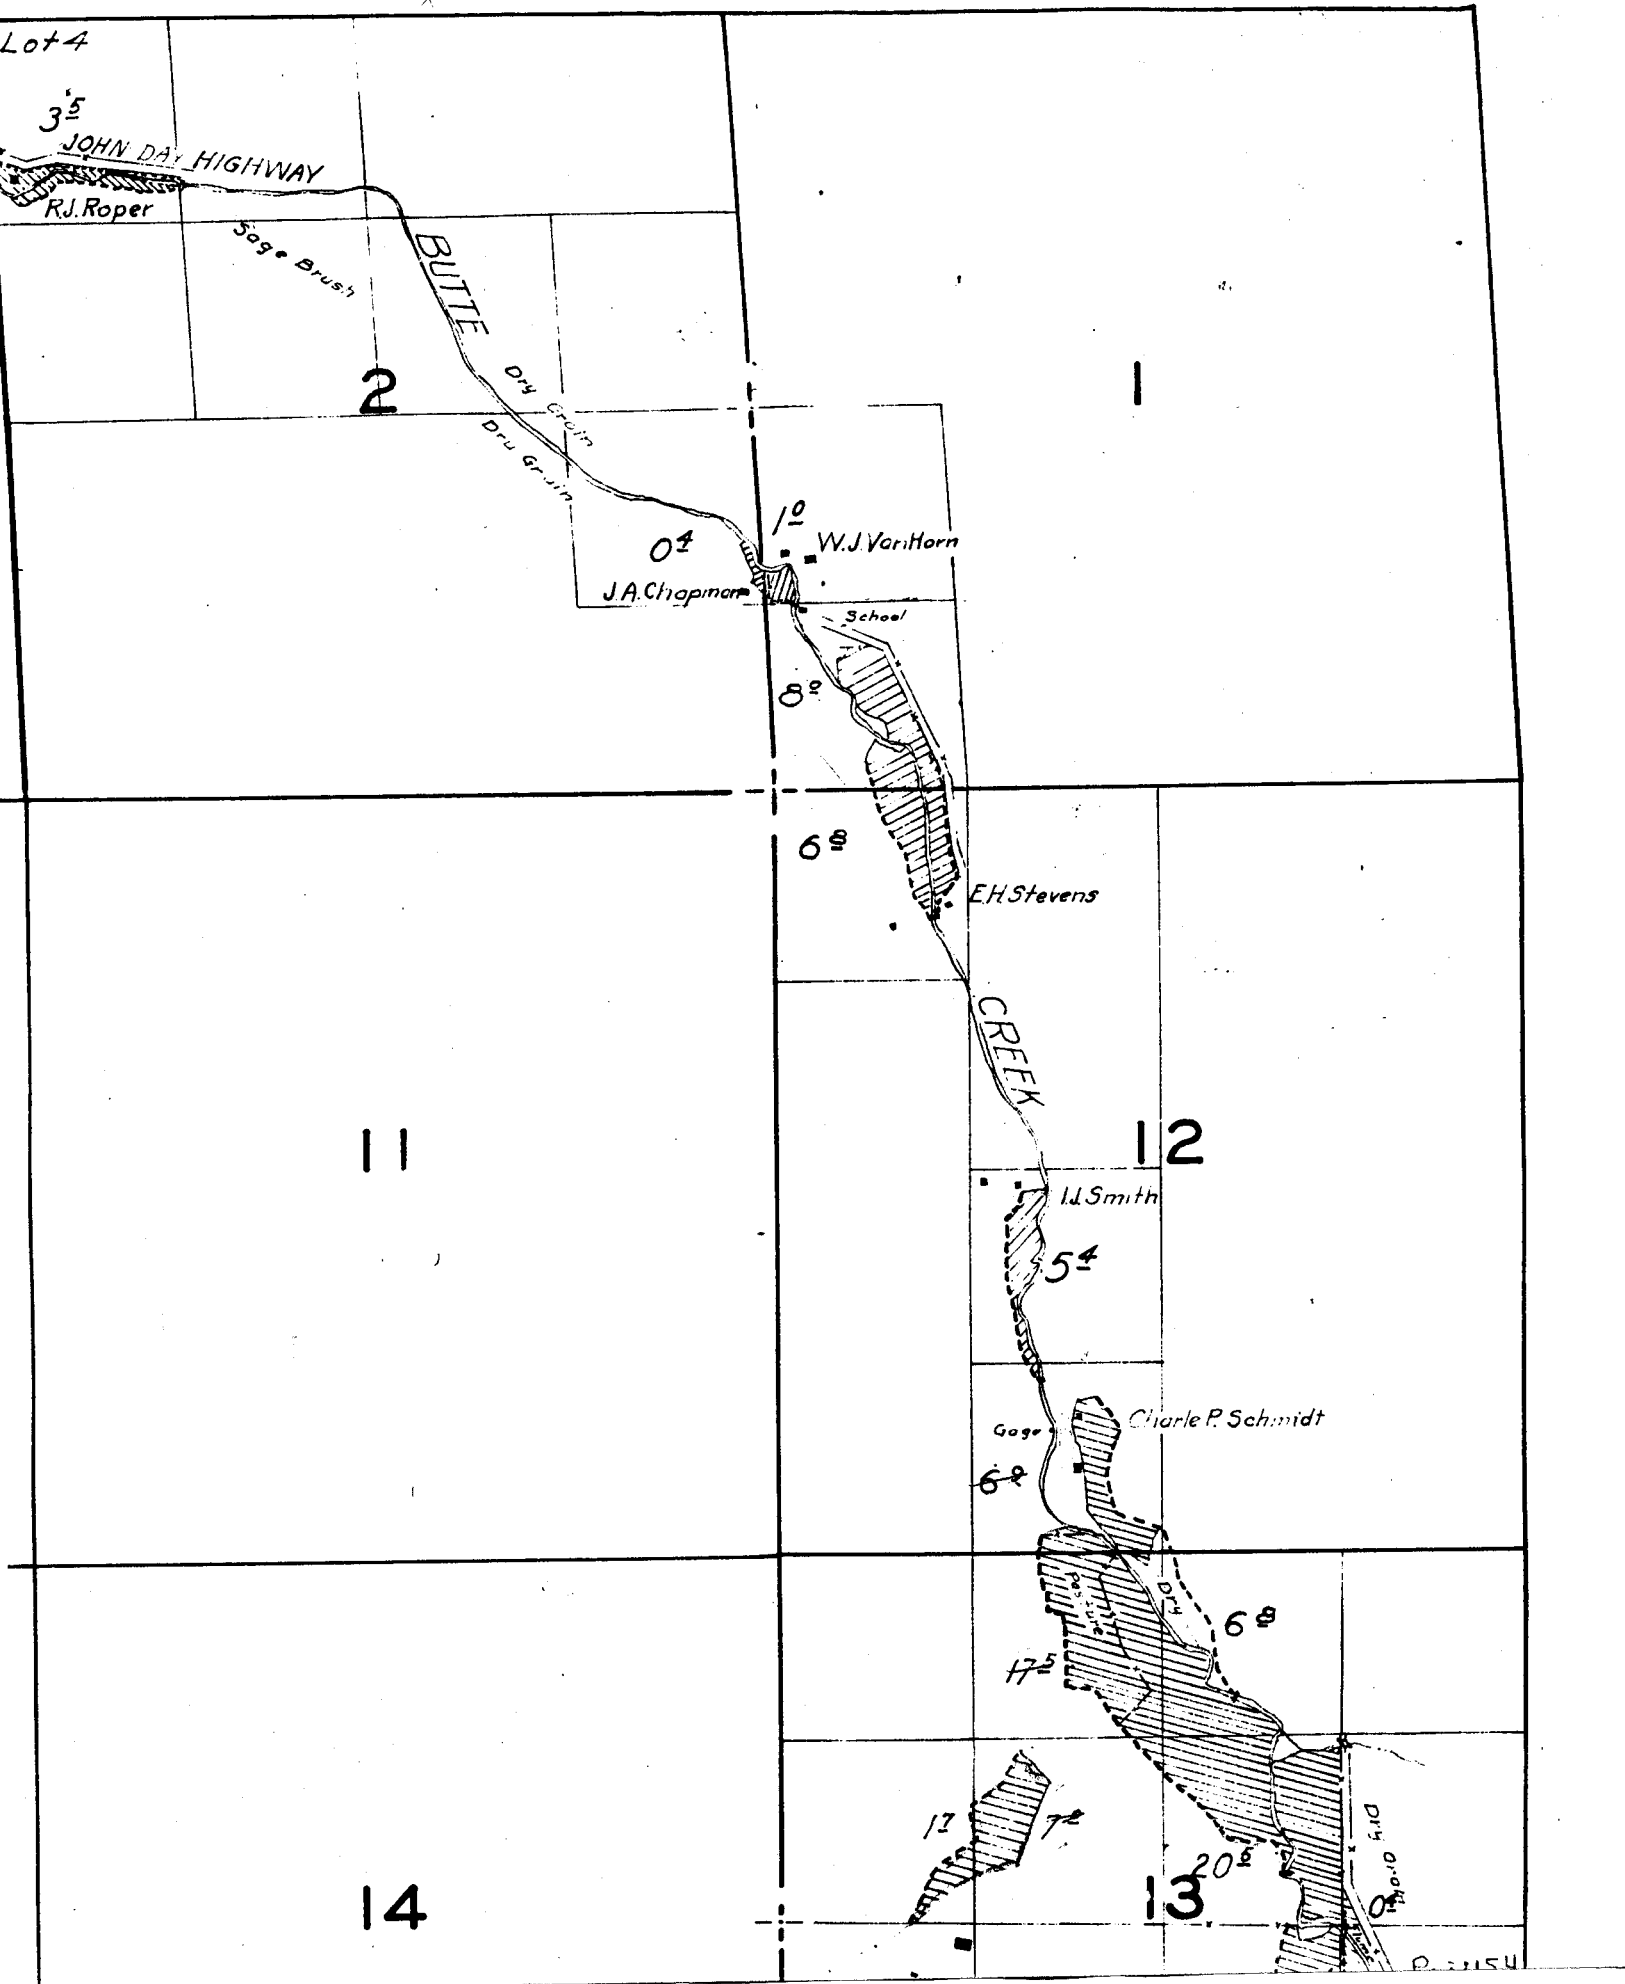

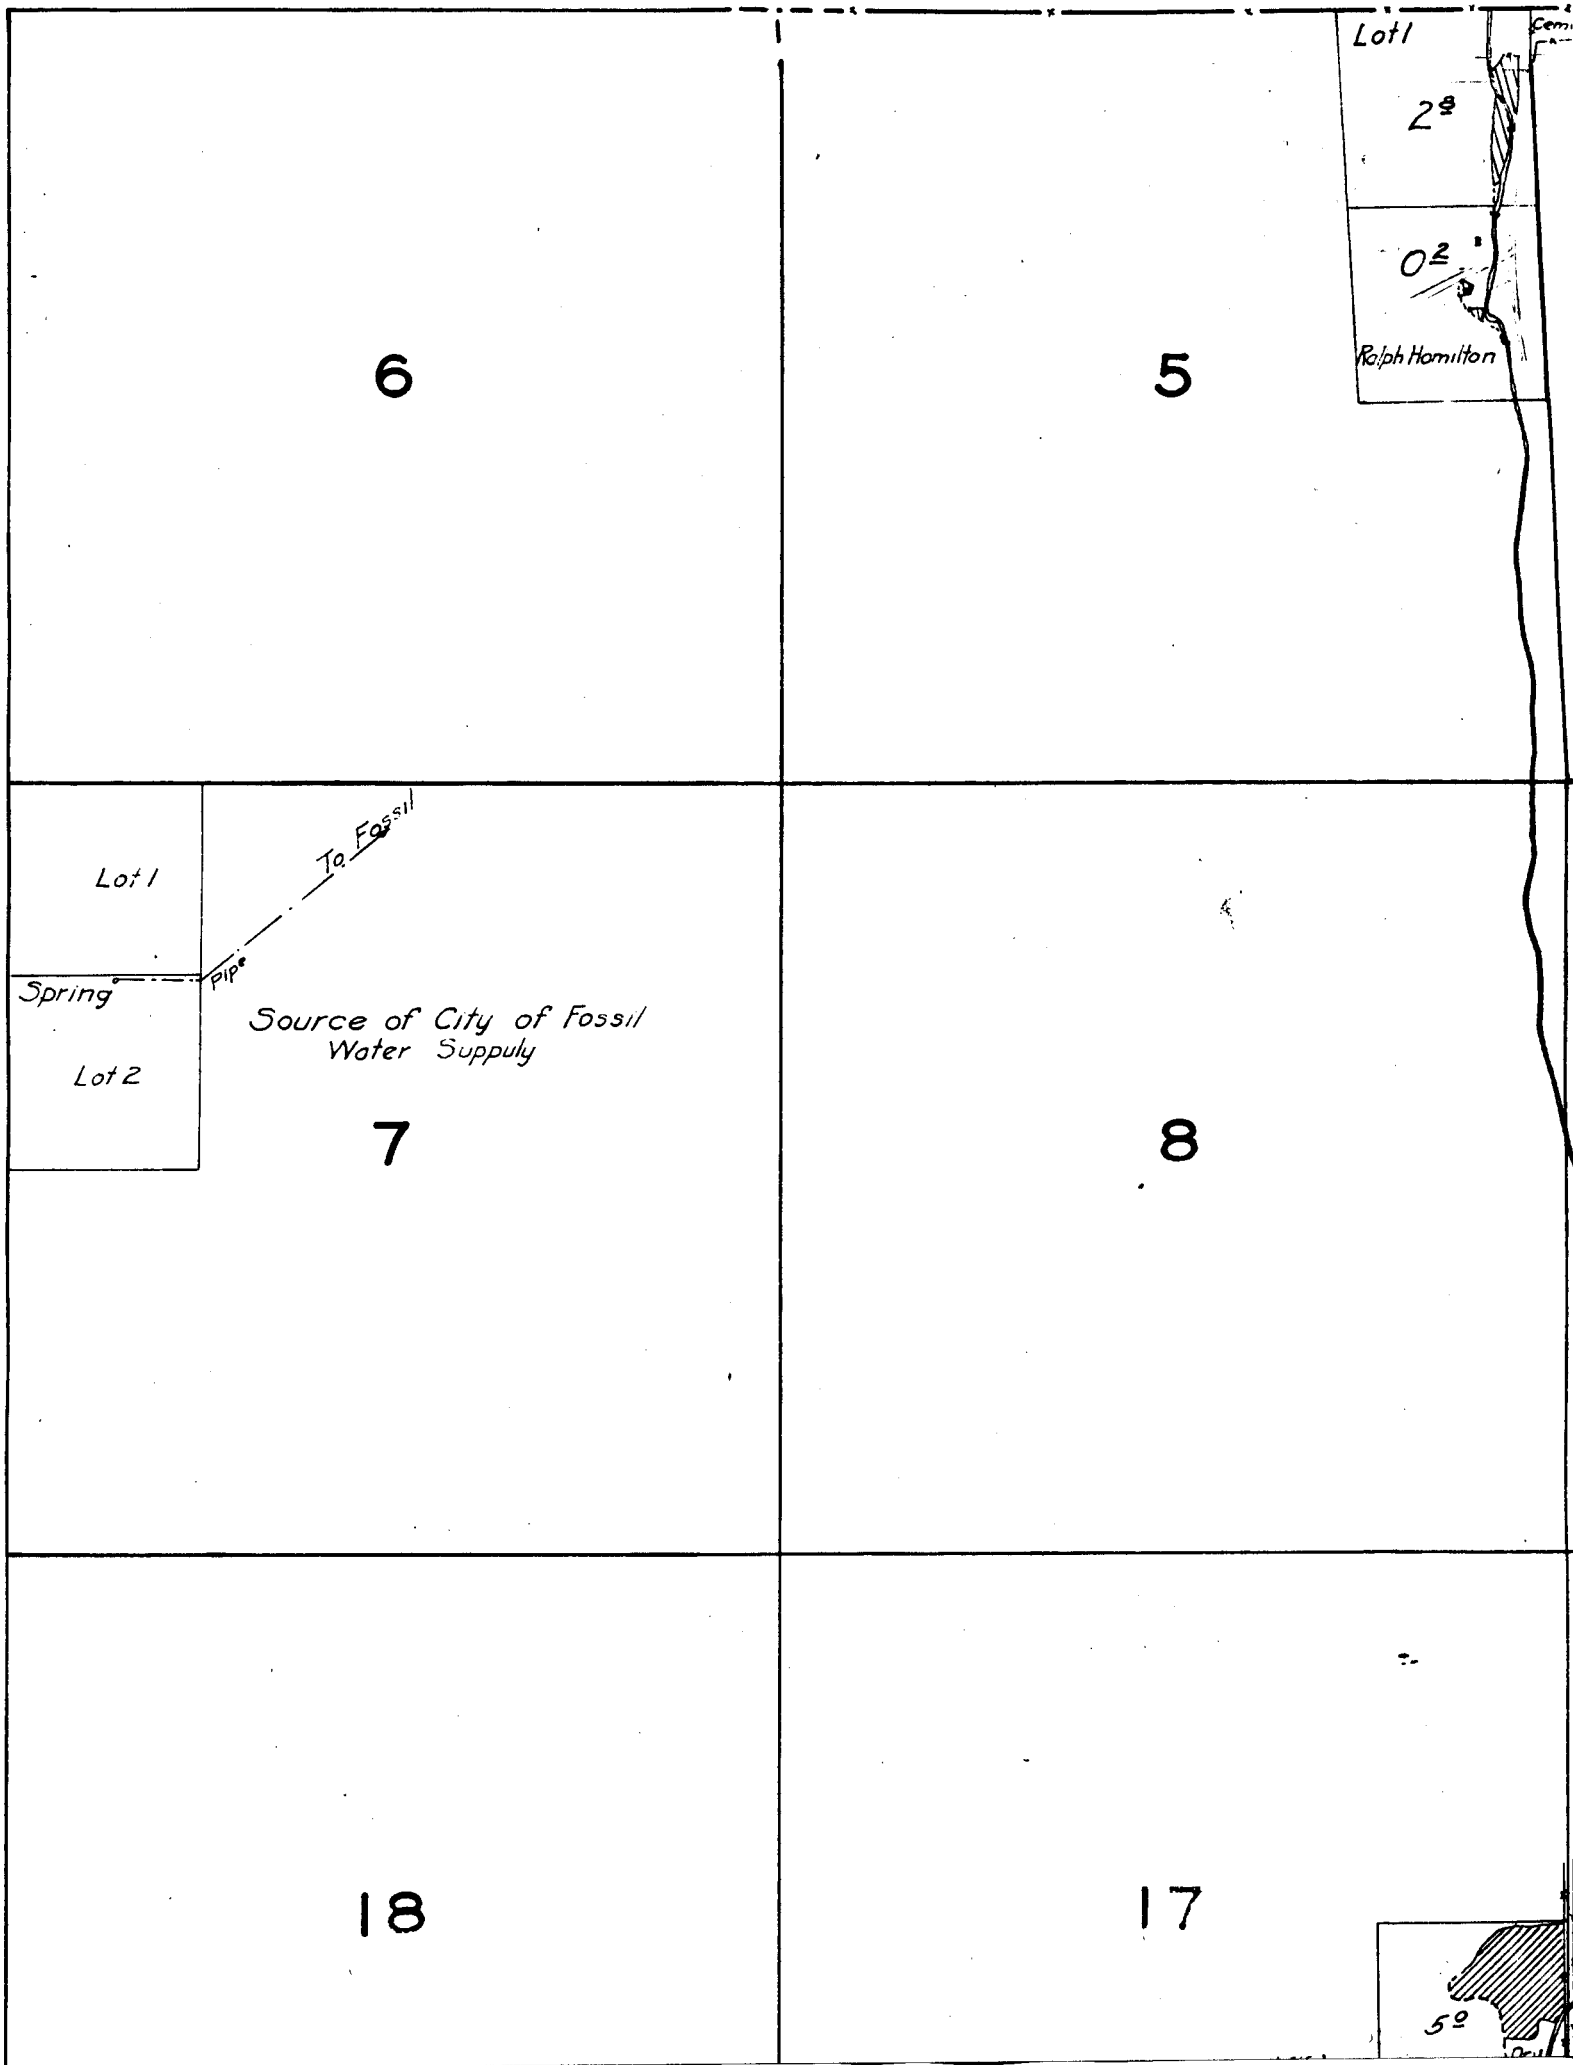

27

26

25

34

35

36

14

Ω

24


Note: Streams not in th.
irrigated lands sketched.

COTTONWOOD

18

17

16

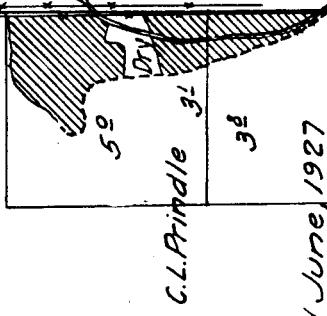

Surveyed June, 1927

CREL

19

20

21

28

29

30

33

32

31

