

27

26

25

34

35

36

2

1

11

12

14

13

6

5

7

8

18

18

21

22

28

27

*Surveyed May 2, 3, and 4, 1925.*

33

34

18

16

15

20

21

22

TOWNSHIP 1 S. RANGE 22 E.

5

4

3

8

9

10

16


18

18

21

20

19

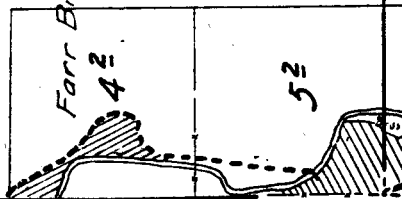


28

29

33

Surveyed May 2, 3, and 4.

Note: Streams and roads, except in the vicinity of irrigated land, are sketched in approximate location.

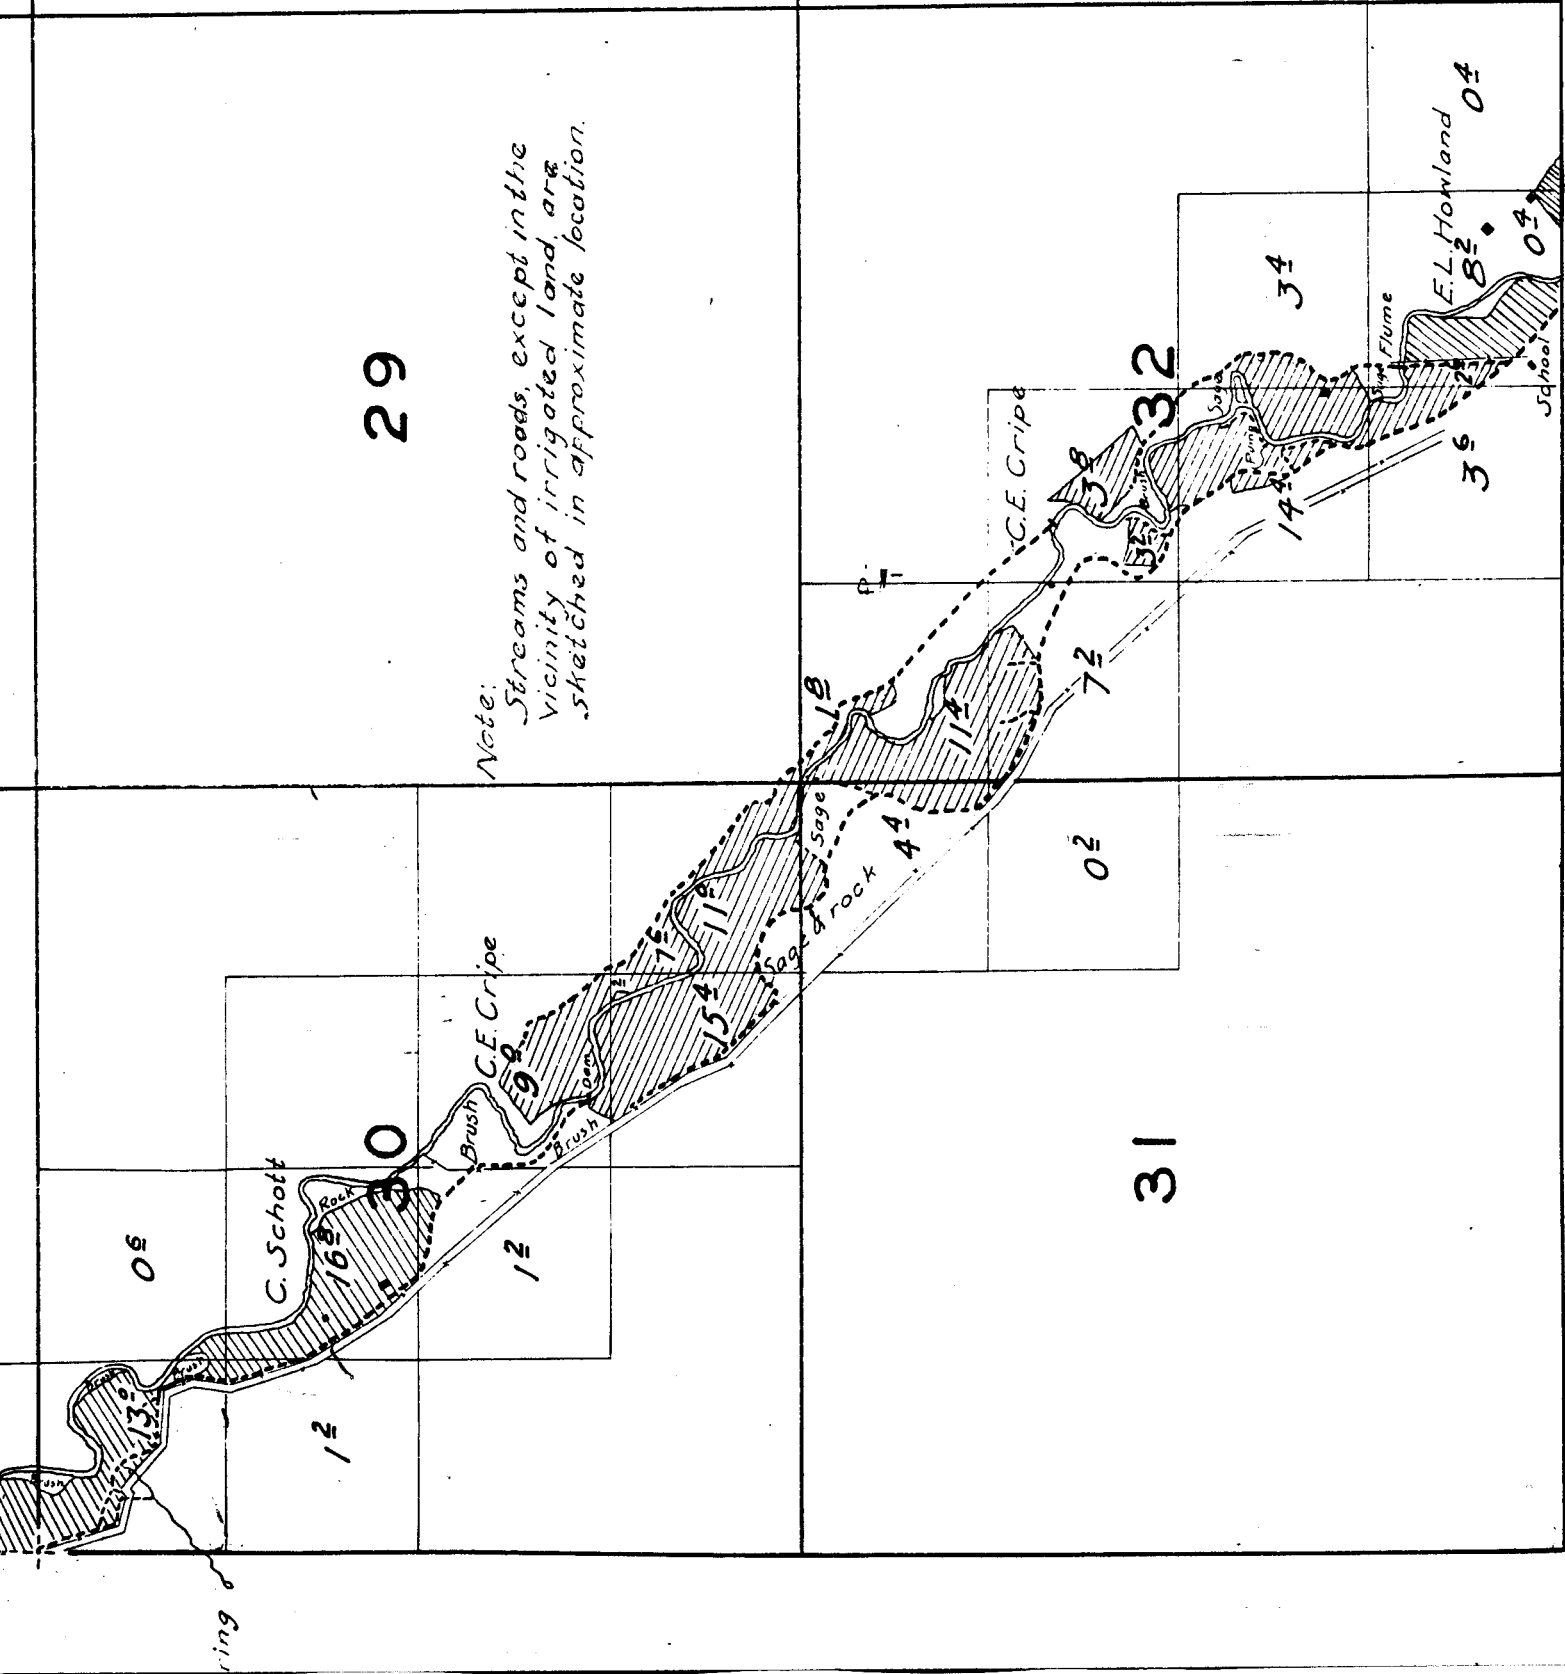

05

C. Scholt

16

30

C.E. Cripe

12

19

Sage & Rock

4

02

C.E. Cripe

32

34

Flume

E.L. Howland

04

82

School

04

35

14

72

31

ring



15

14

13

22

23

24