


TOWNSHIP 8 S., RANGE 25 E.

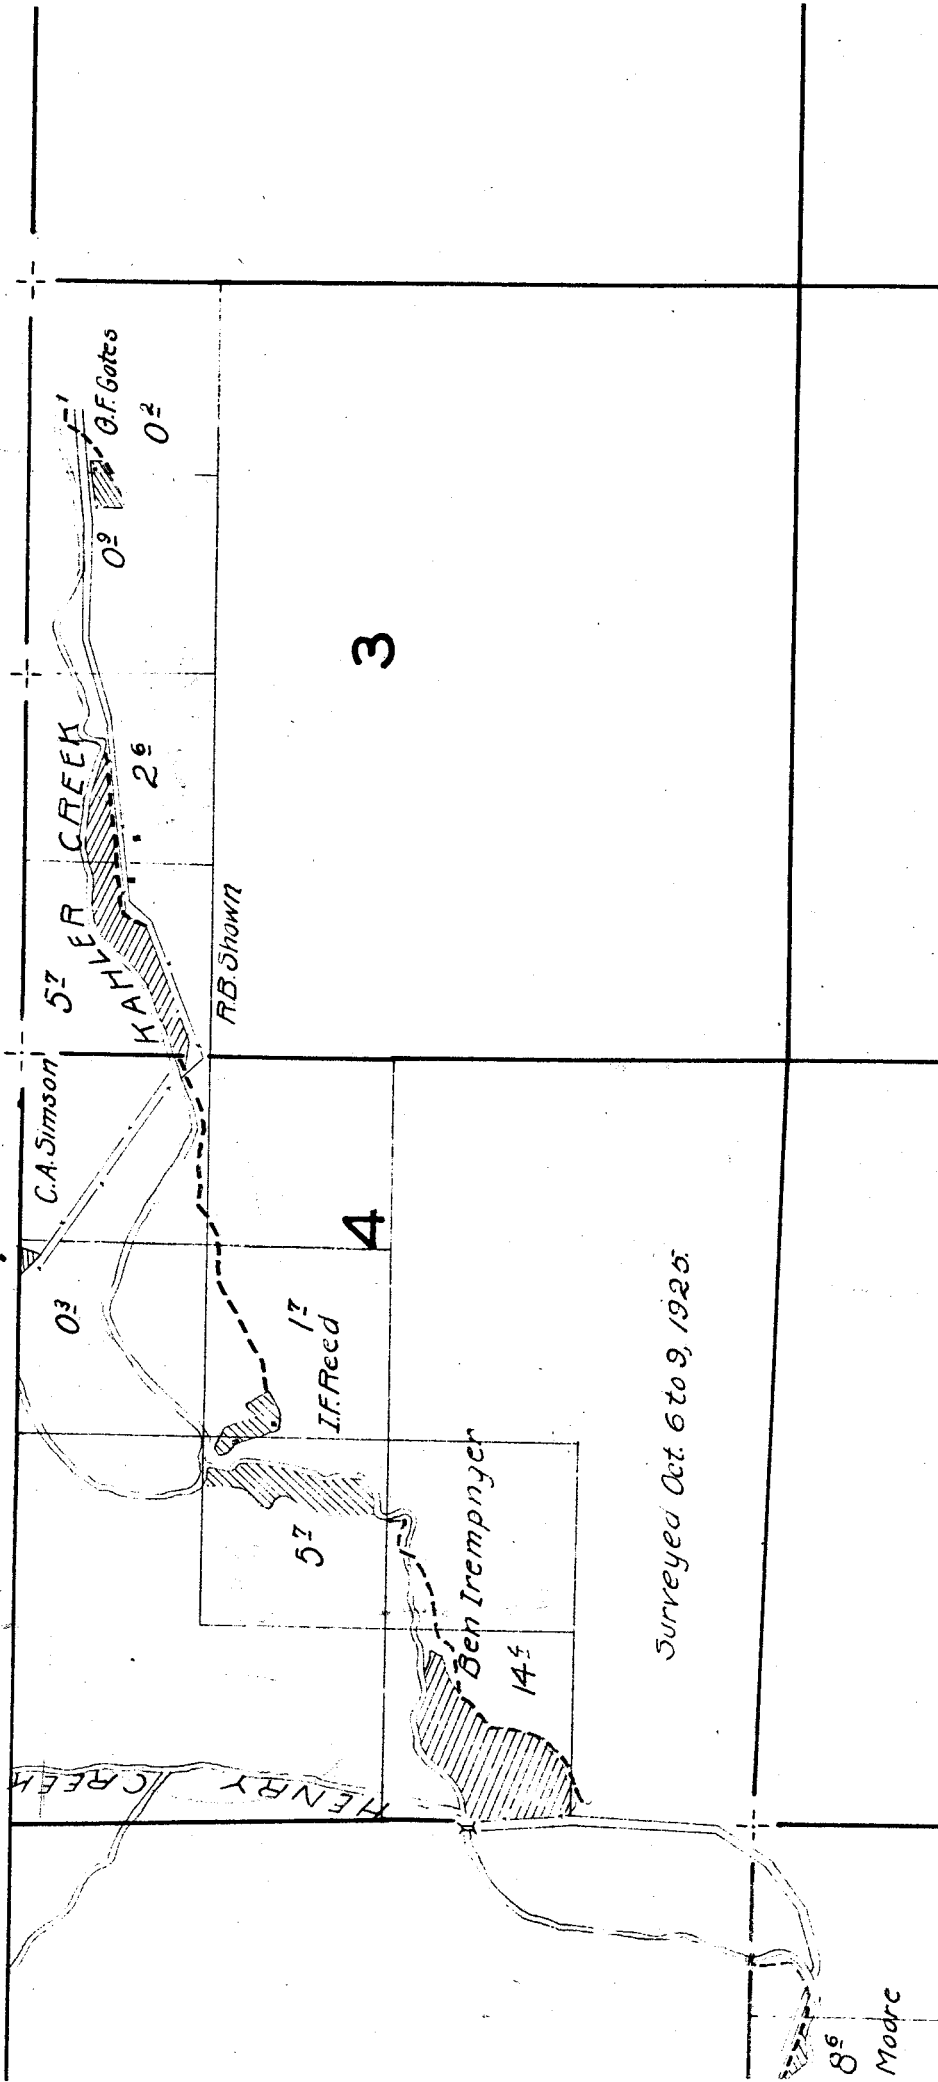


15

22

16

21

L.H. Donavon

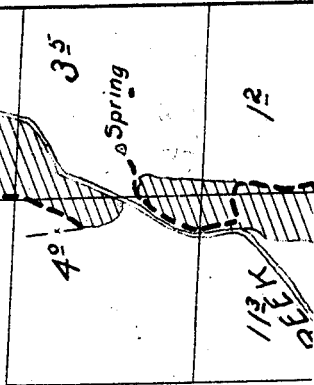

As, except
nd, is
tion.

21

22

4°

3°

Spring

L.H. Donavon

11/2
CREEK

1/2

17°

4°

HAYSTACK

Bob Wright

J.F. Asher

28

27

Spring

17°

Surveyed Sept. 19 to 23, 1926

Steiner

5°

C.W. Wallis

1°

A.E. Cress

1°

34

33

35285
50V17 PTH + 50V12 P506
ADD. P. 0.5

40°

Now C-35285

27°

0.7

12°

21°

Pump

33

Pri Jenkins

15

14

13

22

23

24

INVEST
CREDIT
02

69



RJ Carsner

05

17





Surveyed Sept. 29, 1925.

27

26

25

34

35

36

Balm Co.

16

21

17

20


*Note: Location of streams and roads, except
in the vicinity of irrigated land, is
sketched in approximate location.*

18

19

As Borges

4²

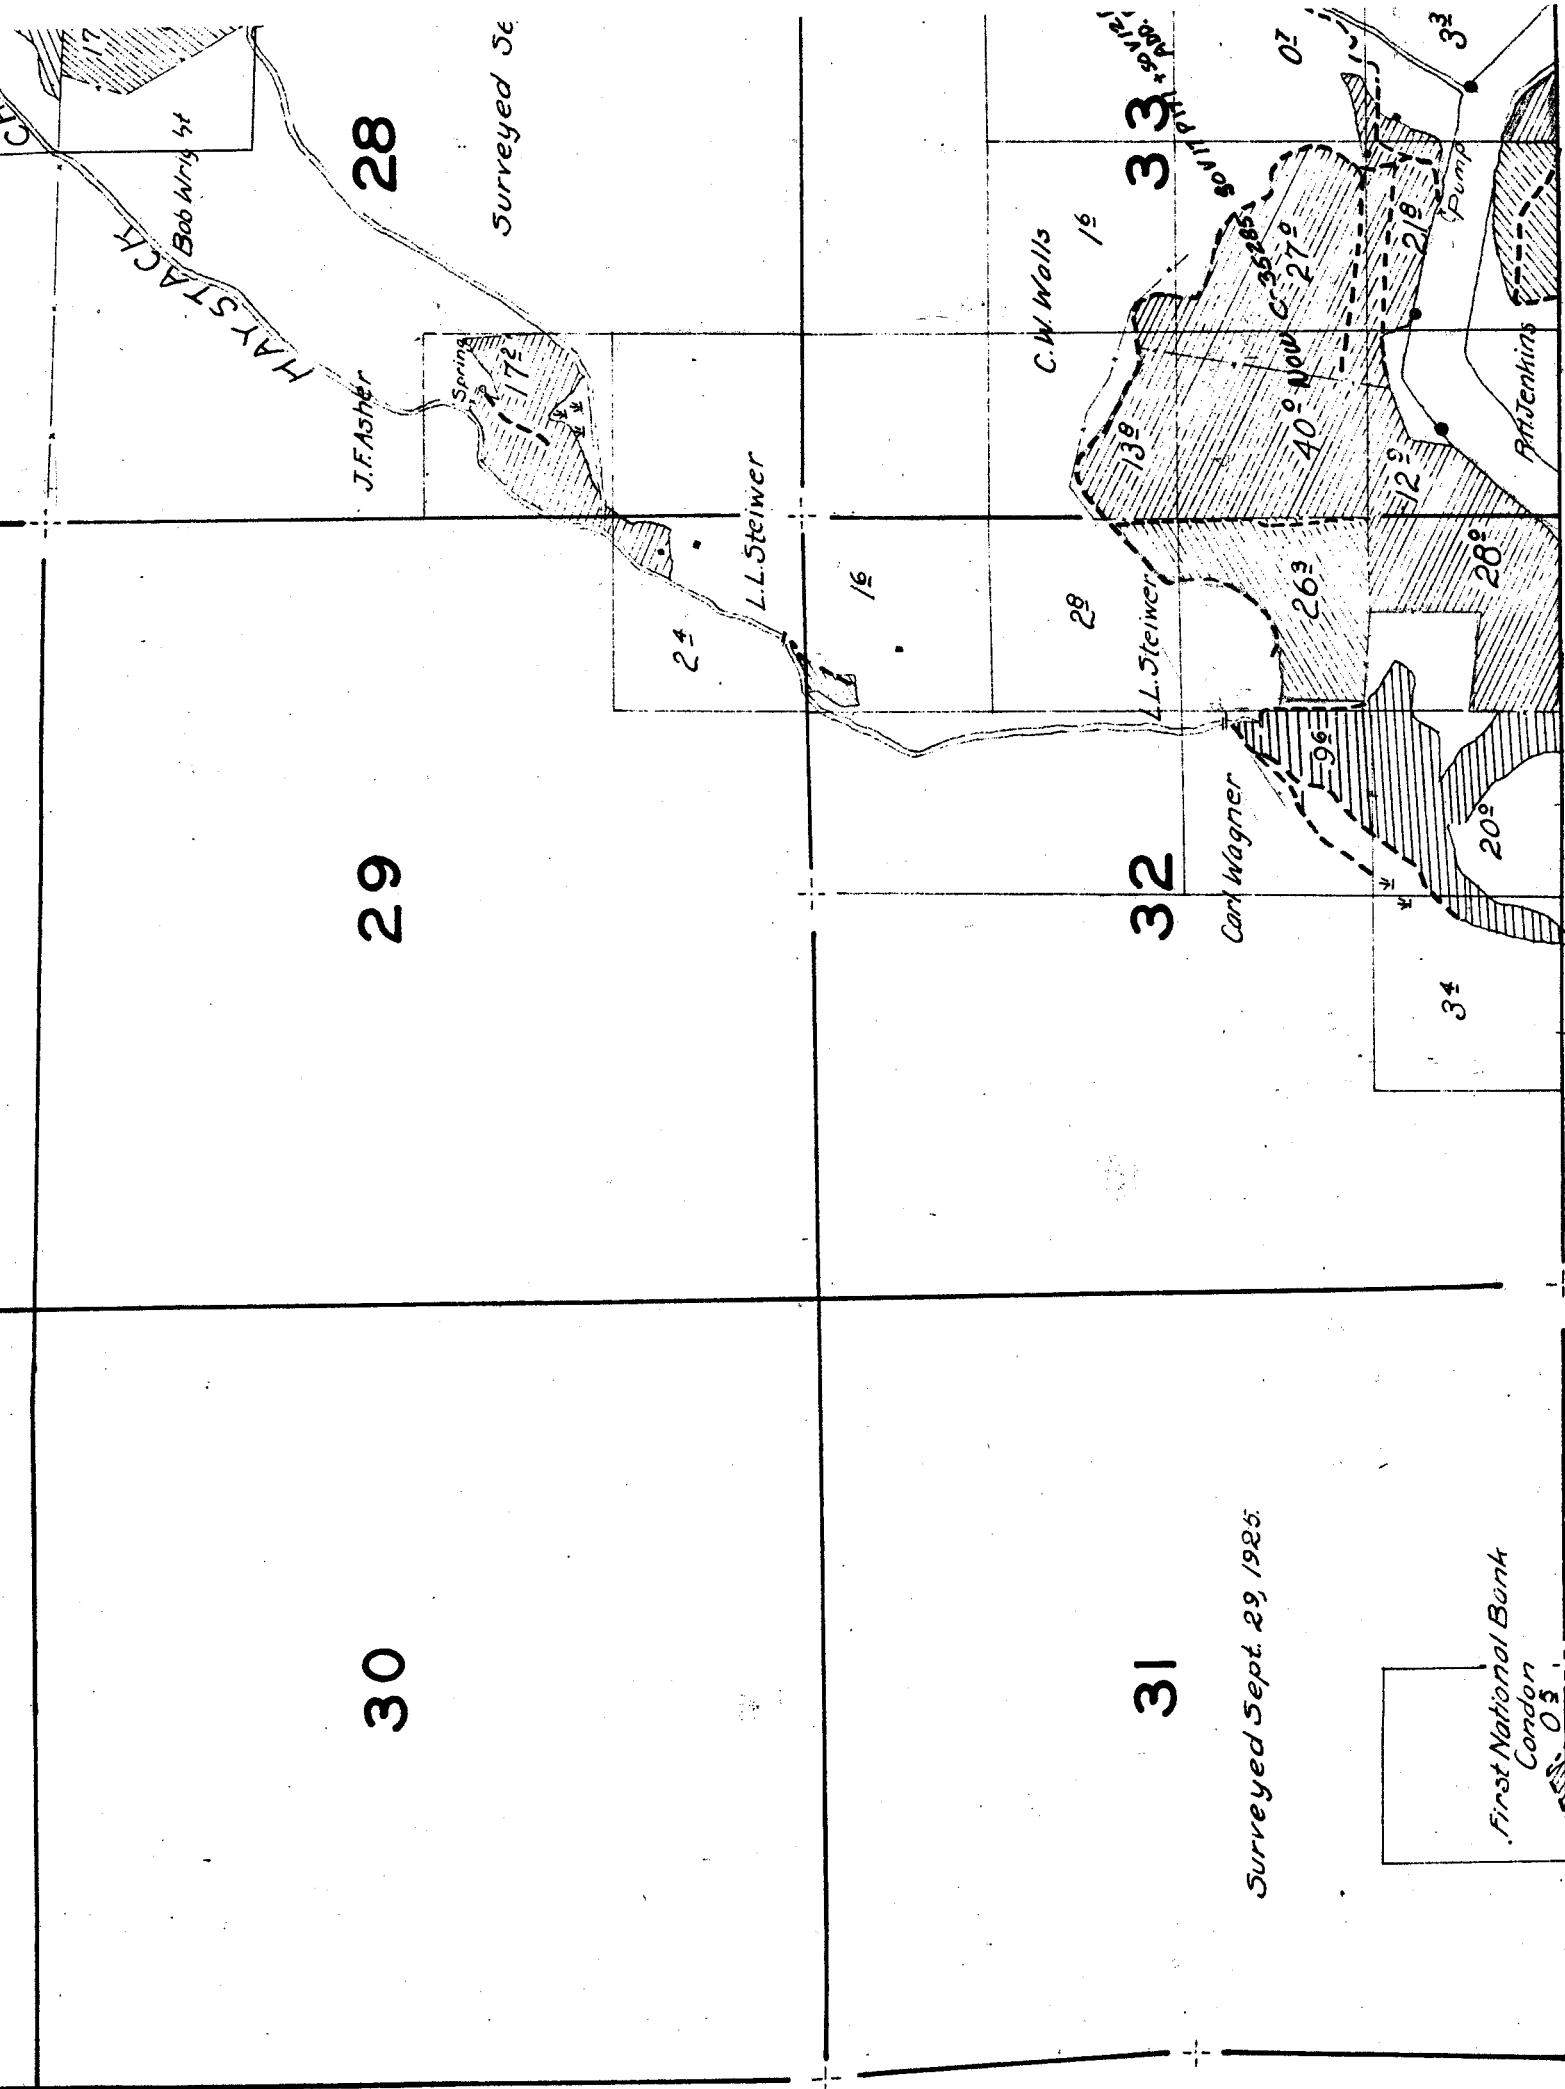

28

29

30

33

32

31

HAYSTACK

Bob Wright

J.F. Asher

Spring

L.L. Steiner

C.W. Walls

Carl Wagner

Antjenhins

Pump

Surveyed Sept. 29, 1925

First National Bank
Condon

03

Surveyed Se

16

24

16

28

138

02

27

40° NW

26

96


34

28

20

12

33

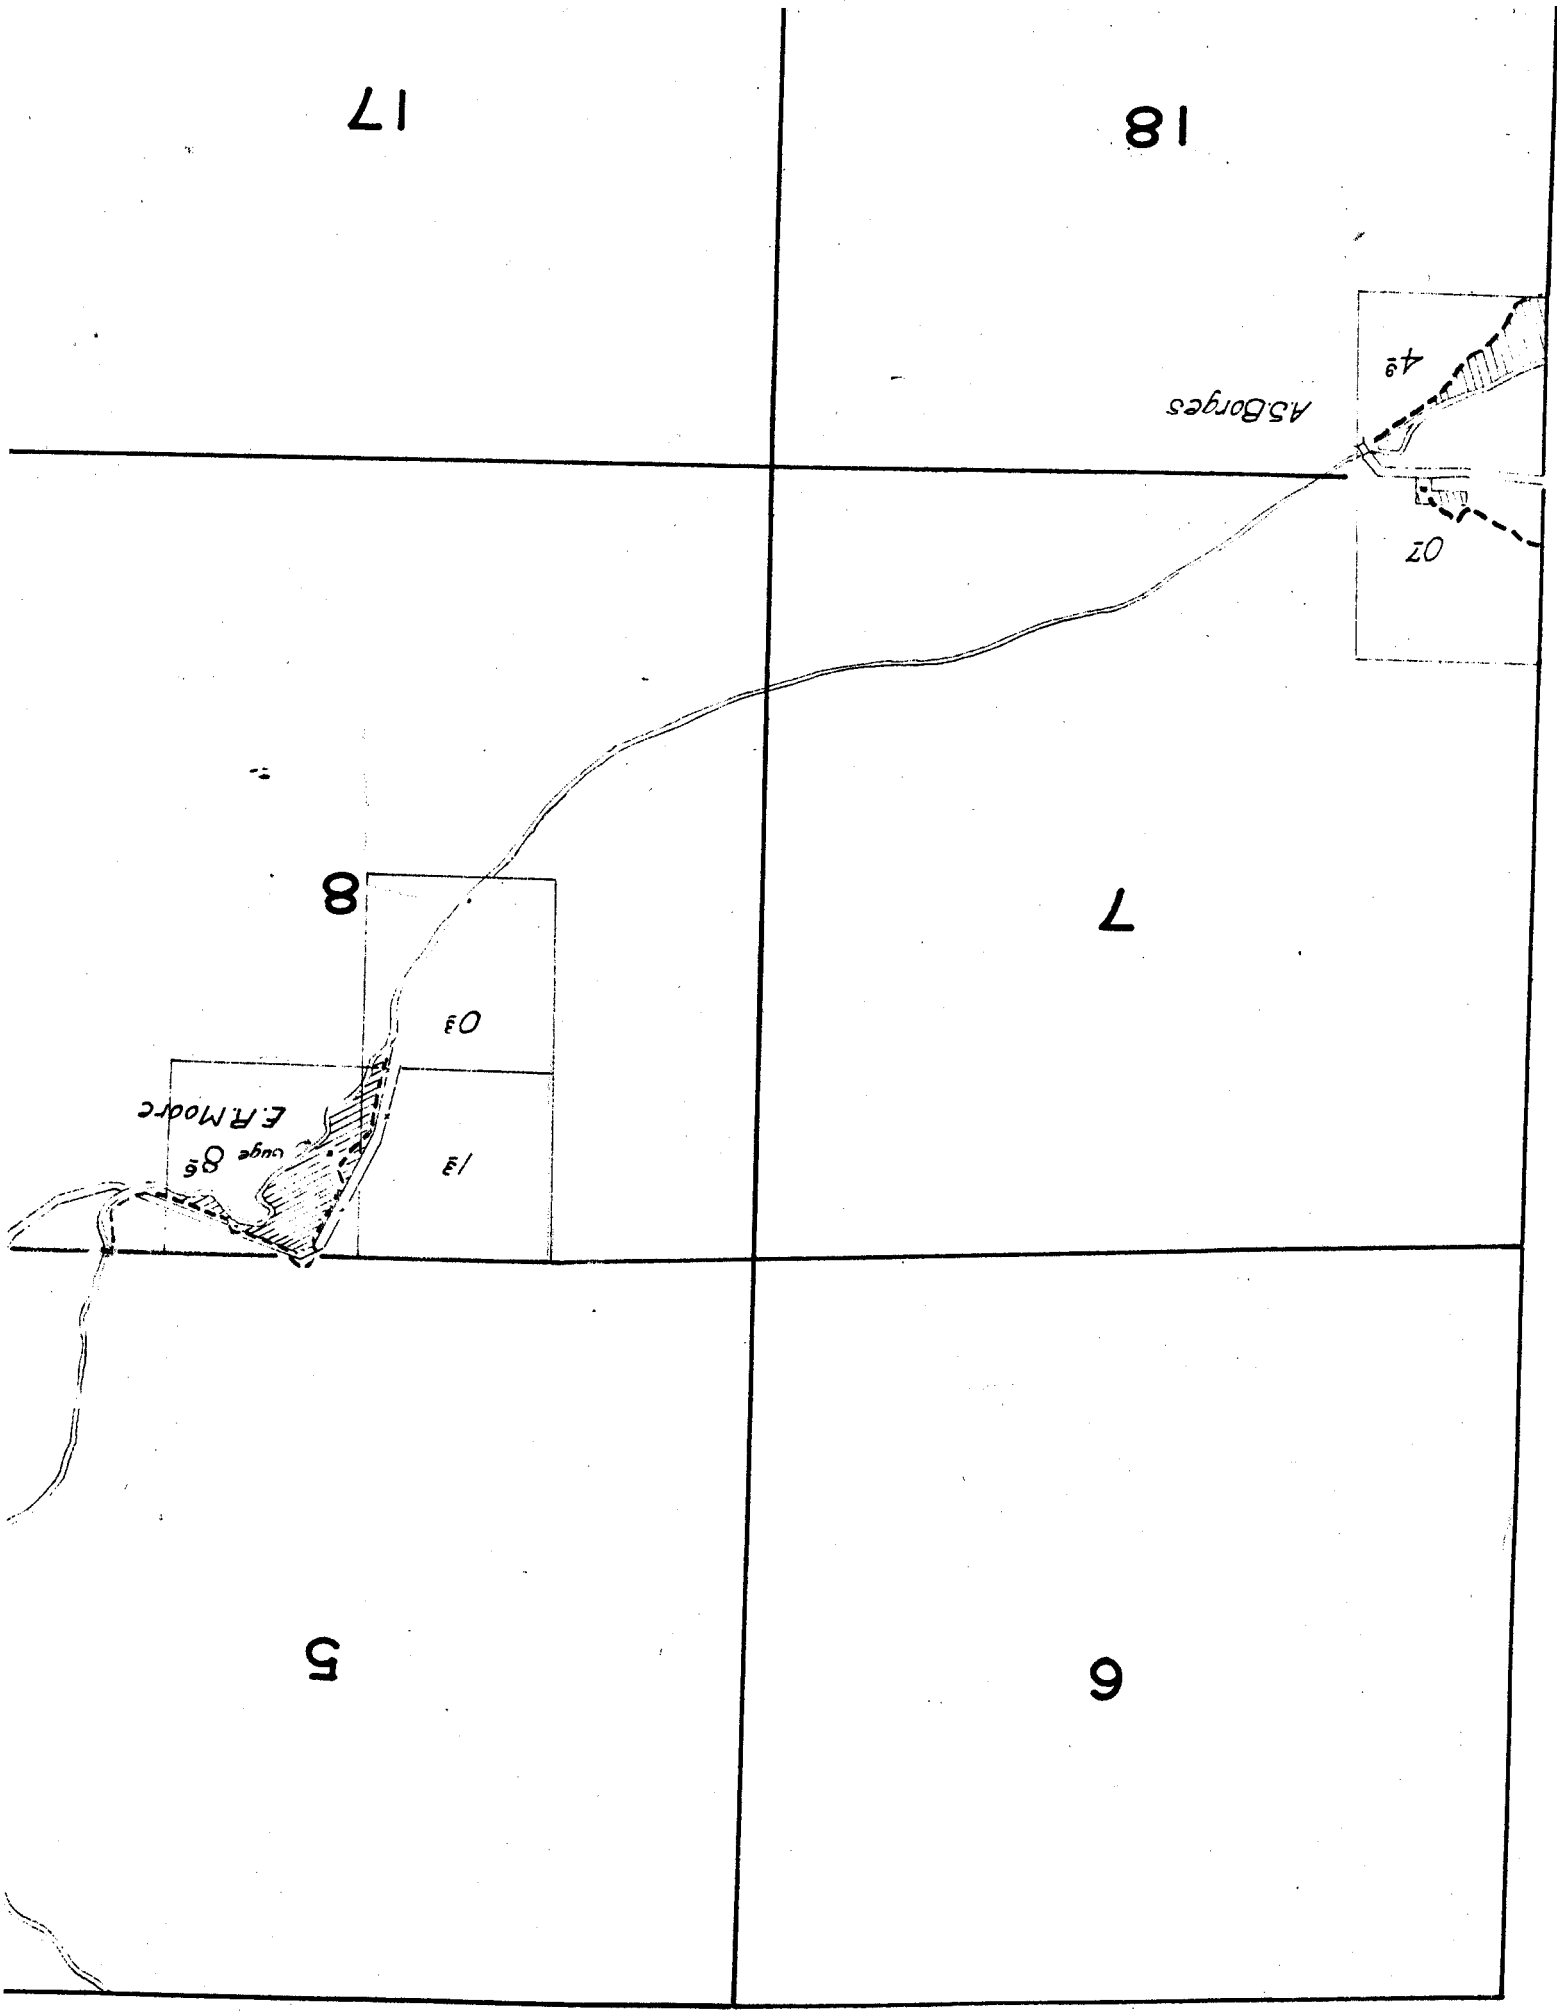

2

1

11

12

14

13