

9

28


27

5

2

33

34

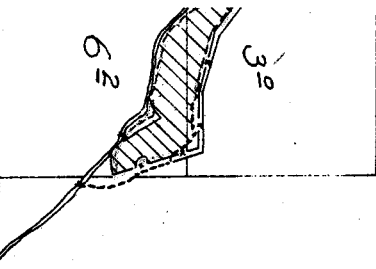

17

16

15

20

21

22

*Note: Streams and river, except in
vicinity of irrigated land, sketched in
approximate location.*

18


17

16

19

20


21

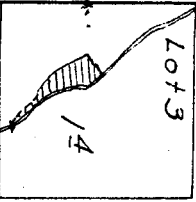

Charlie Shown

Note: Streams and river
vicinity of irrigated land, is
approximate location.

TOWNSHIP

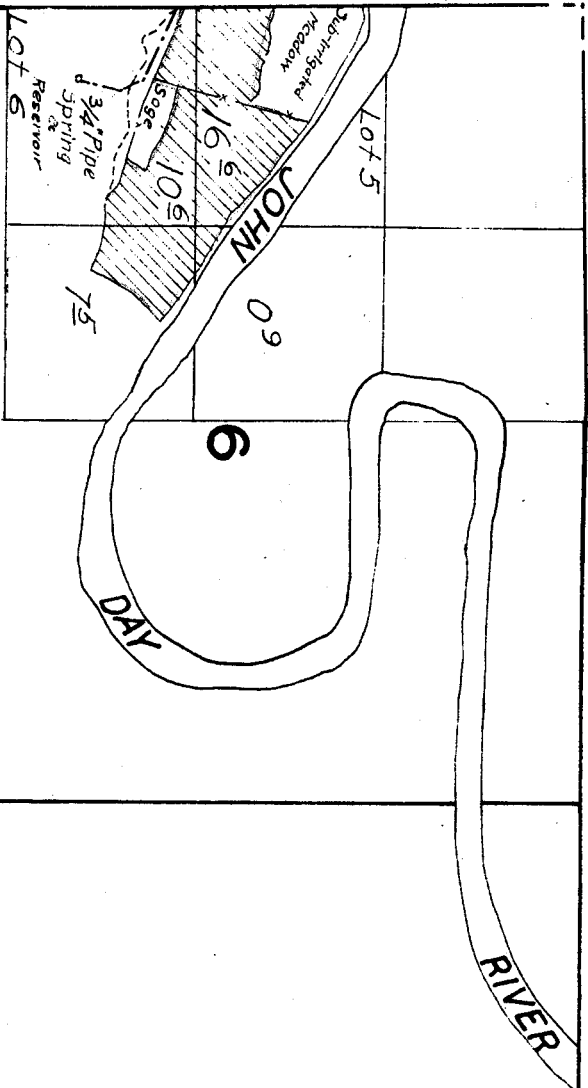

Surveyed Aug. 30, 1926

5

4


8

9

7

NGE 22 E.

75-2-22

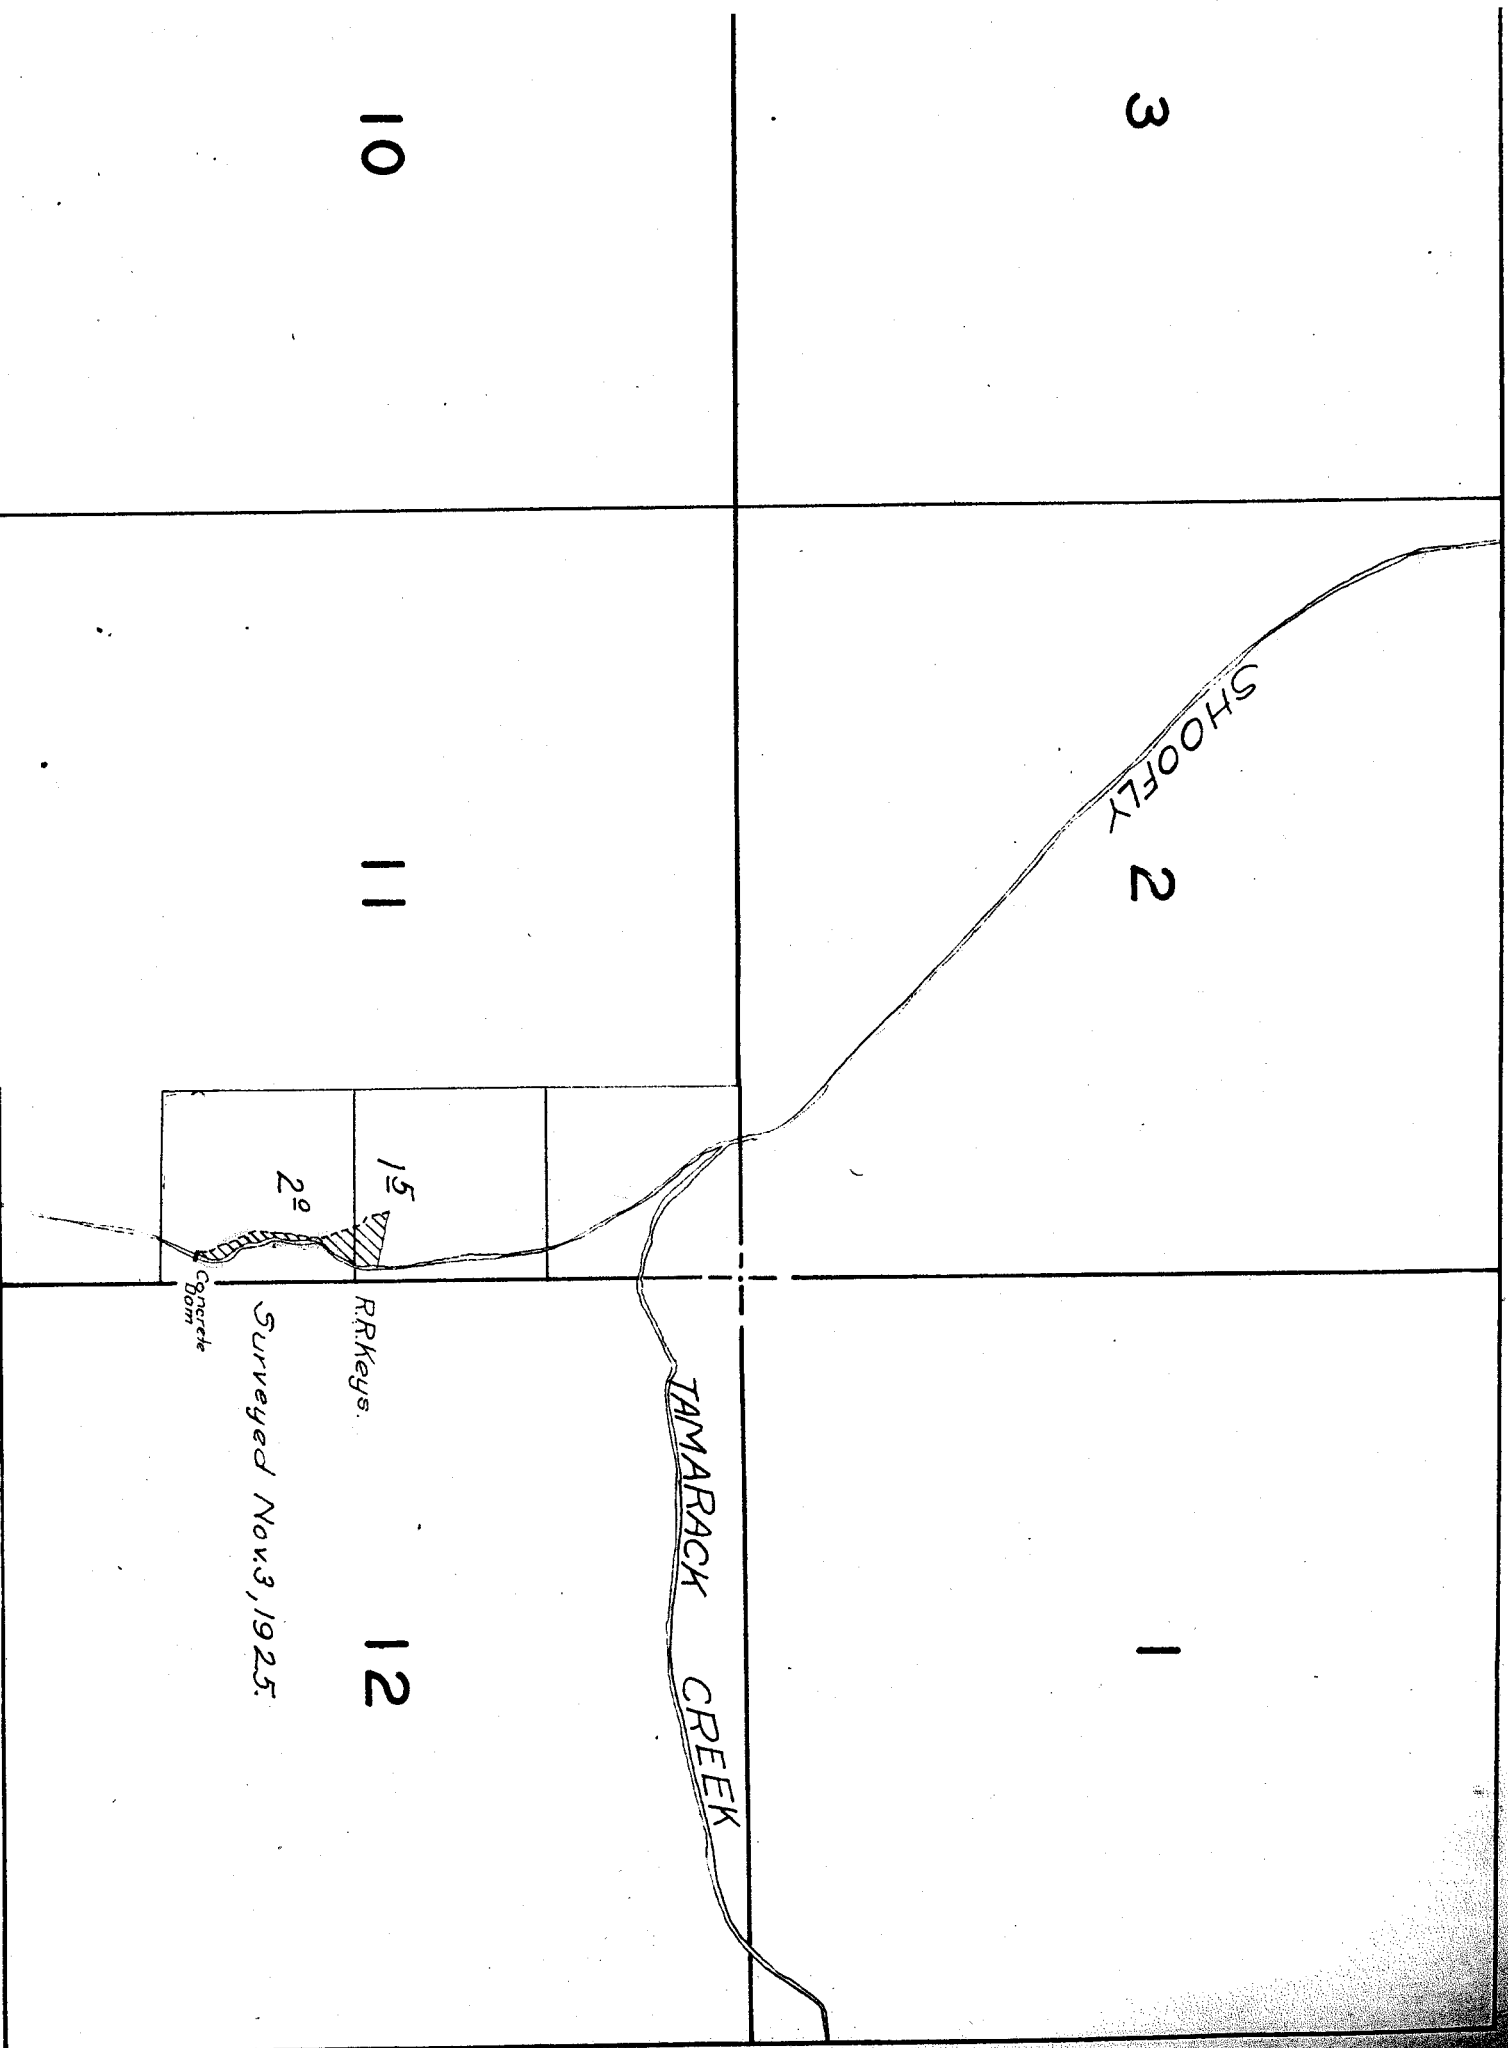

OWNSHIP 10 S., RANGE 22 E.

4

3

9

10

16

15

23

24

43

6²
Dom

6²

8²

7²
Flume

04

Ed. Shoun
(R.R. Wills)

25

4²

28²

04

27²

13²

Sage Brush

26

35

36

Surveyed Nov. 4, 1925.

19

20

Lot 3

14

Charlie Shown

GIRDS

Rim

Rim

Rocks

30

CREEK

29

7²

19

1²

Surveyed Sept. 4, 1926.

8¹

Spring
3 3/4 Acres

Winlock Hendricks

Pond

10²

6²

31

32

7¹

3²

6²