

23

24

4²6²6²8²7²

Flume

04

Ed. Shoun
(R.R. Willis)

25

4²28²

04

27²13²

Sage Brush

26

Surveyed Nov. 4, 1925.

35

36

19

20

Lot 3

14

Charlie Shown

GIRDS

Rim

Rim

Rocks

30

Rocks

CREEK

29

7^e

14

1^e

Surveyed Sept. 4, 1926.

8^e

Spring
2 3/4 Pans

Winlock Hendricks

Pond

10^e

6^e

31

32

7^e

3^e

6^e

OWNSHIP 10 S., RANGE 22 E.

4

3

9

10

16

15

15

14

13

Surveyed Oct. 24, 1925.

School

BLACK ROCK CREEK

CREEK

G.O. Butler

Martin Jackson

Thomas Noble

22

23

24

56

95

32

05

188

15

61

1239

02

82

69

62

42

Dam

NGE 22 E.

75-2-2

3

SHOOFLY 2

10

11

20

15

RR Keys.

Surveyed Nov. 3, 1925.

Concrete Dam

12

TAMARACK CREEK

TOWNSHIP

RIVER

4


5

9

8

6

7

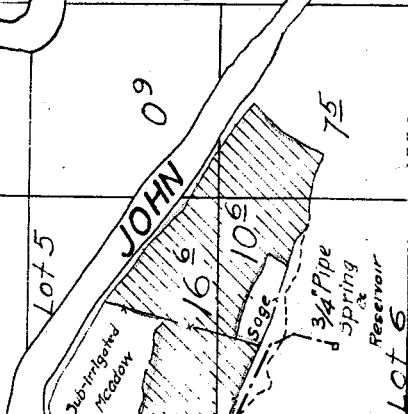

Surveyed Aug. 30, 1926

18


17

16

19

20

21

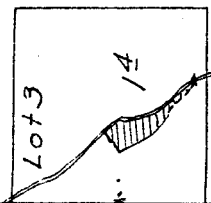

Charlie Shown

Note: Streams and river
vicinity of irrigated lands
approximate location.

17

16

15

20

21

22

*Note: Streams and river, except in
vicinity of irrigated land, sketched in
approximate location.*

9

28

27

51

2

33

34

