

Elmer McQuinn

Lot 4.


20'

31'

6

5

CREEK

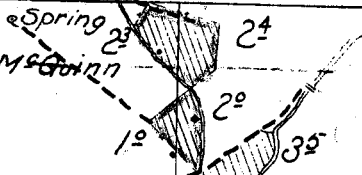

Mrs Elmer McQuinn

Lot 1.

Surveyed October 16, 1925.

Lot 2.

ALDER

04'

7

8

09'

Lot 3.


Lot 4.

139'

49'

18

17

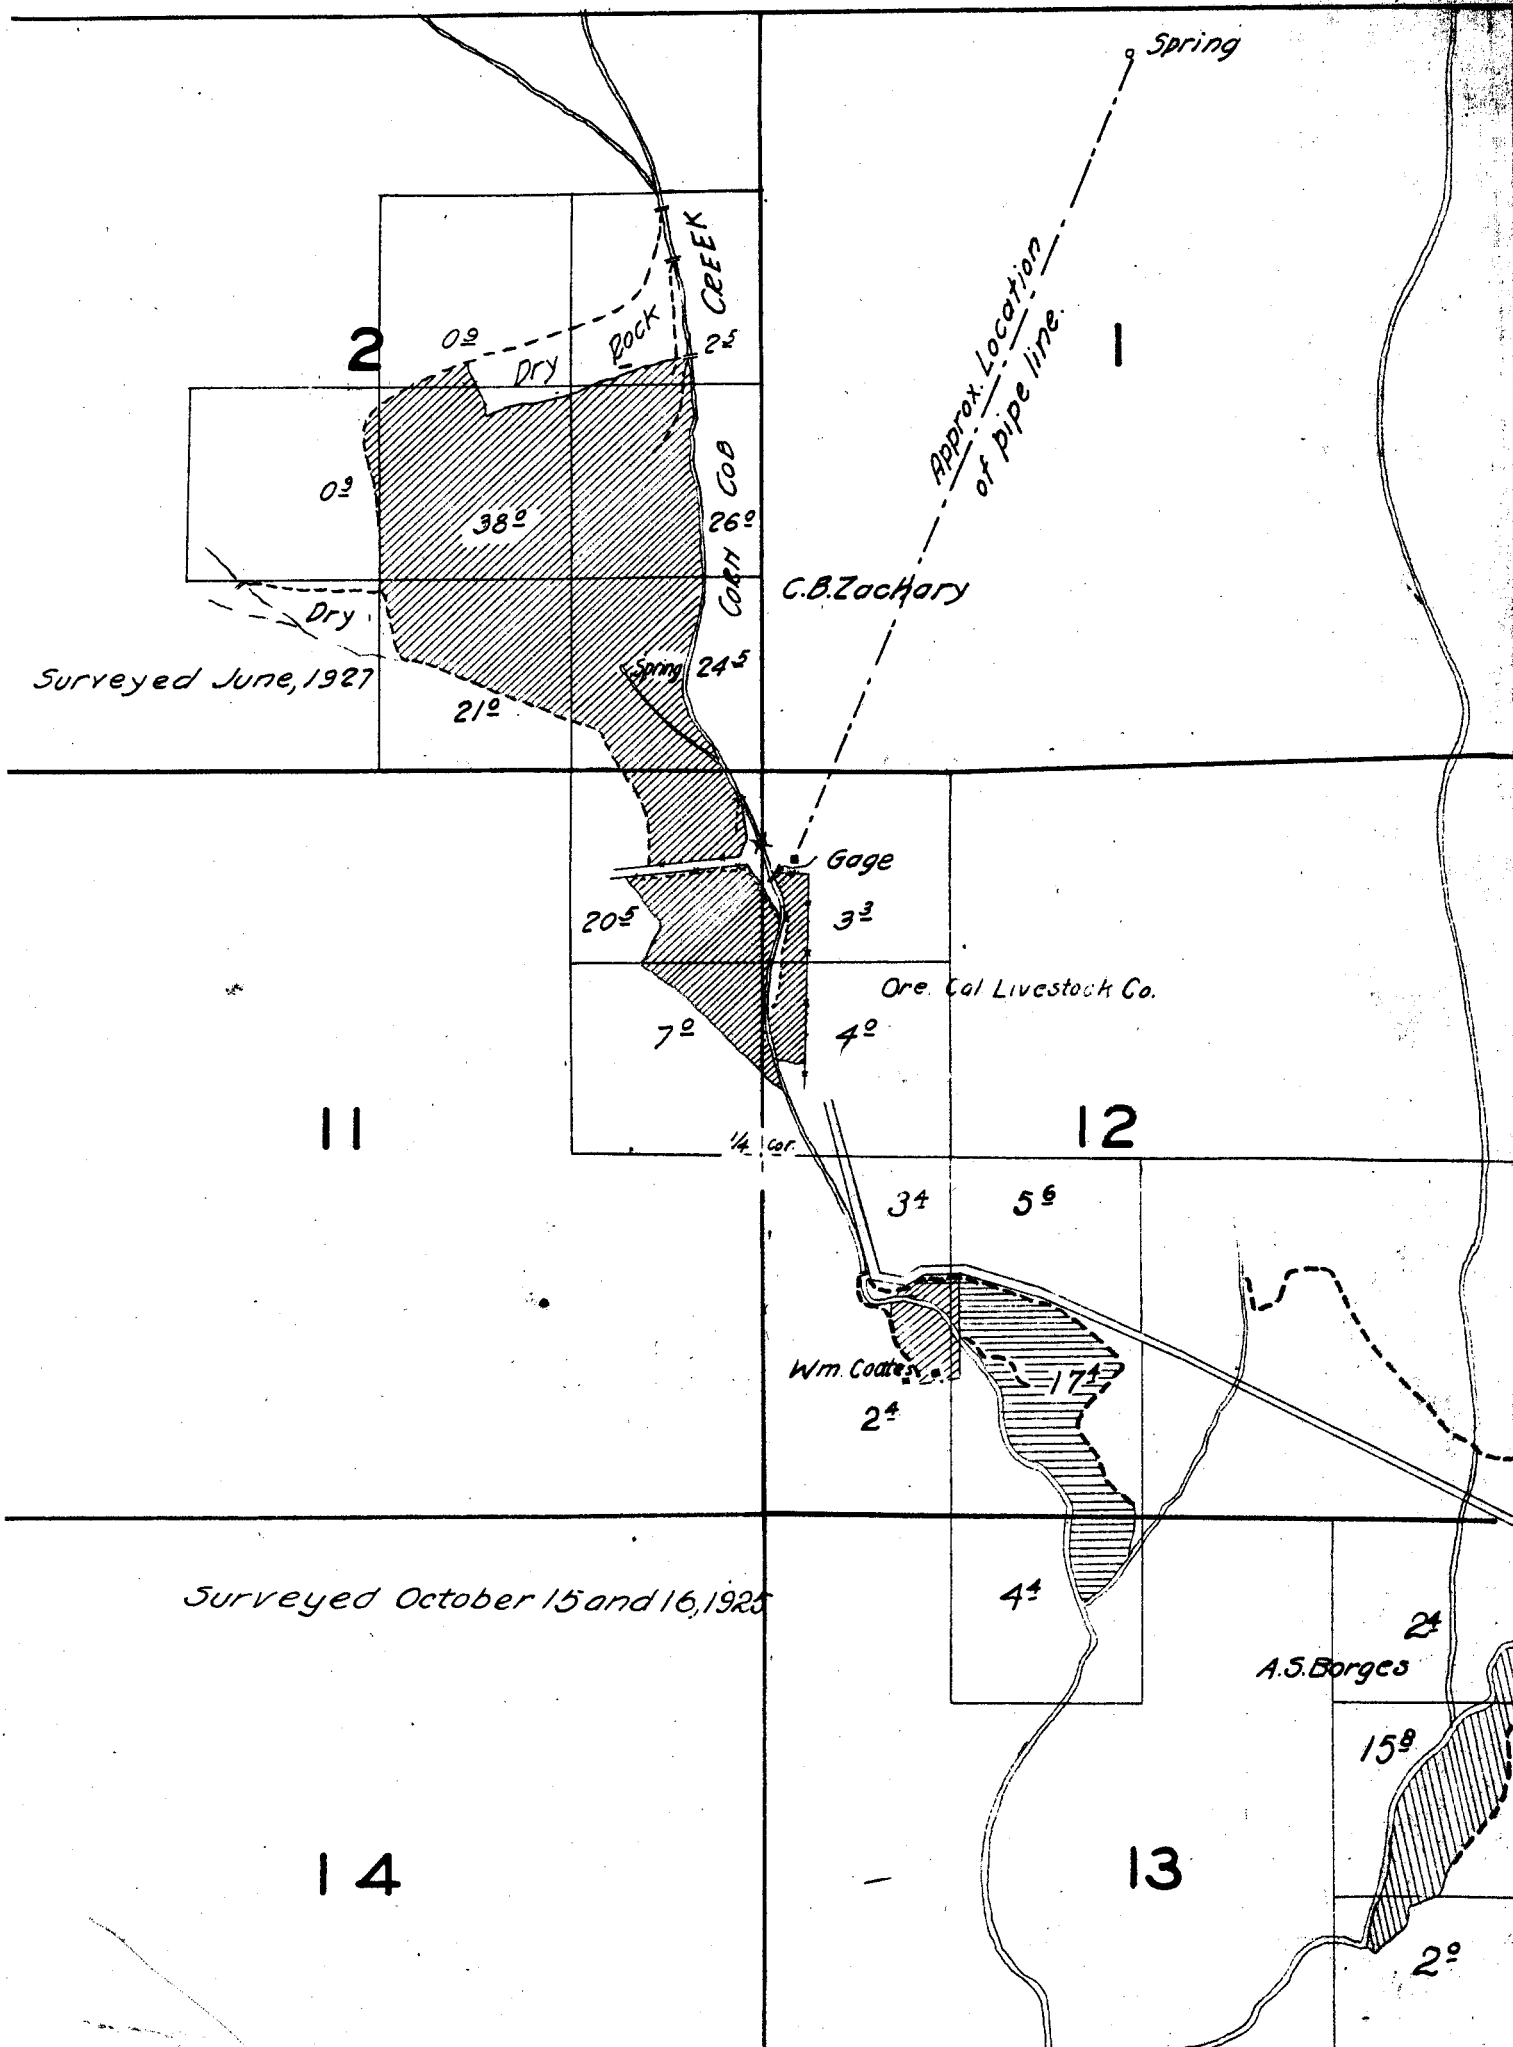




15

14

22

23

44

13

24

24

Amos Hawk


52

A.S. Borges


24

159

29

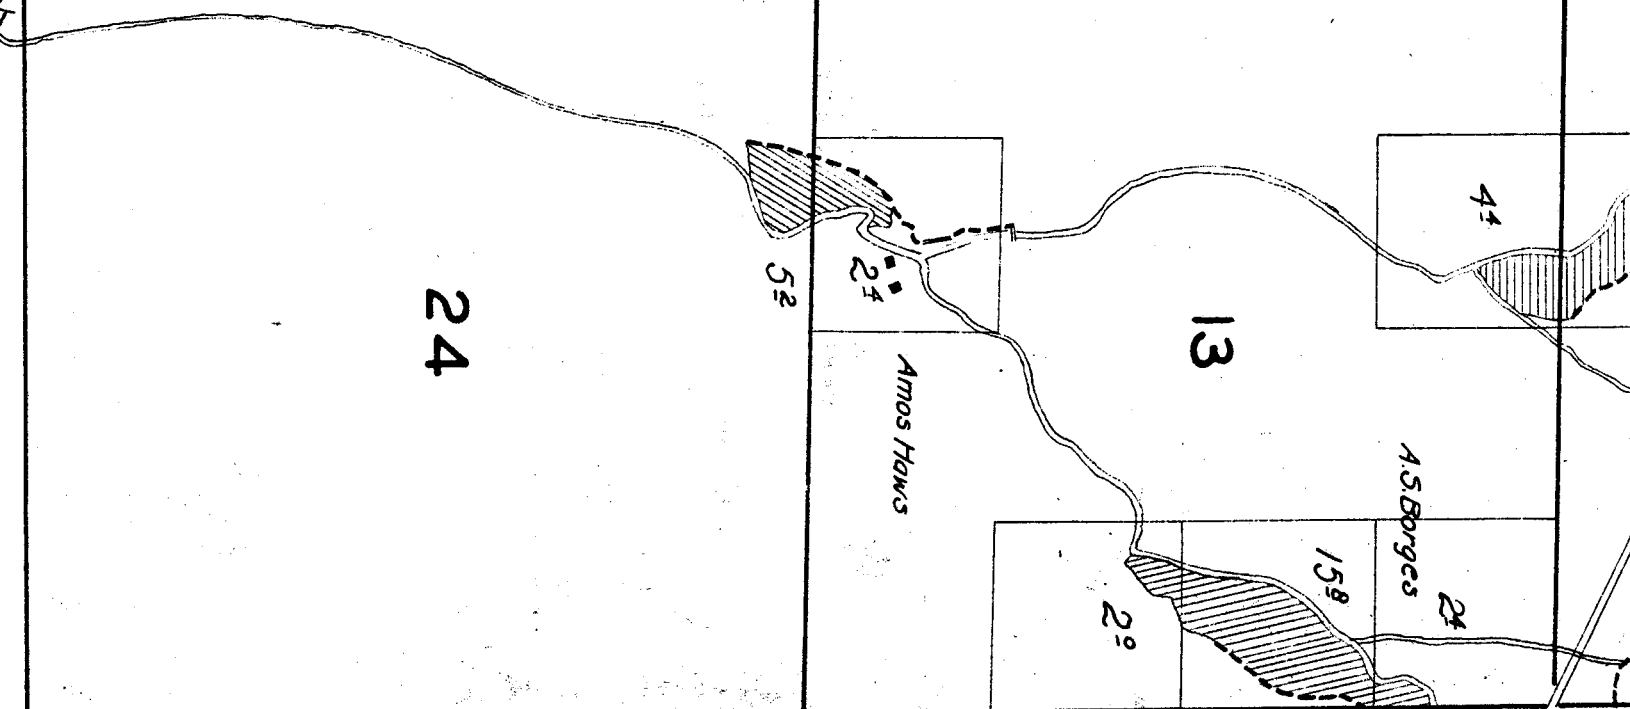

TOWNSHIP 8 S., RANGE 24 E.

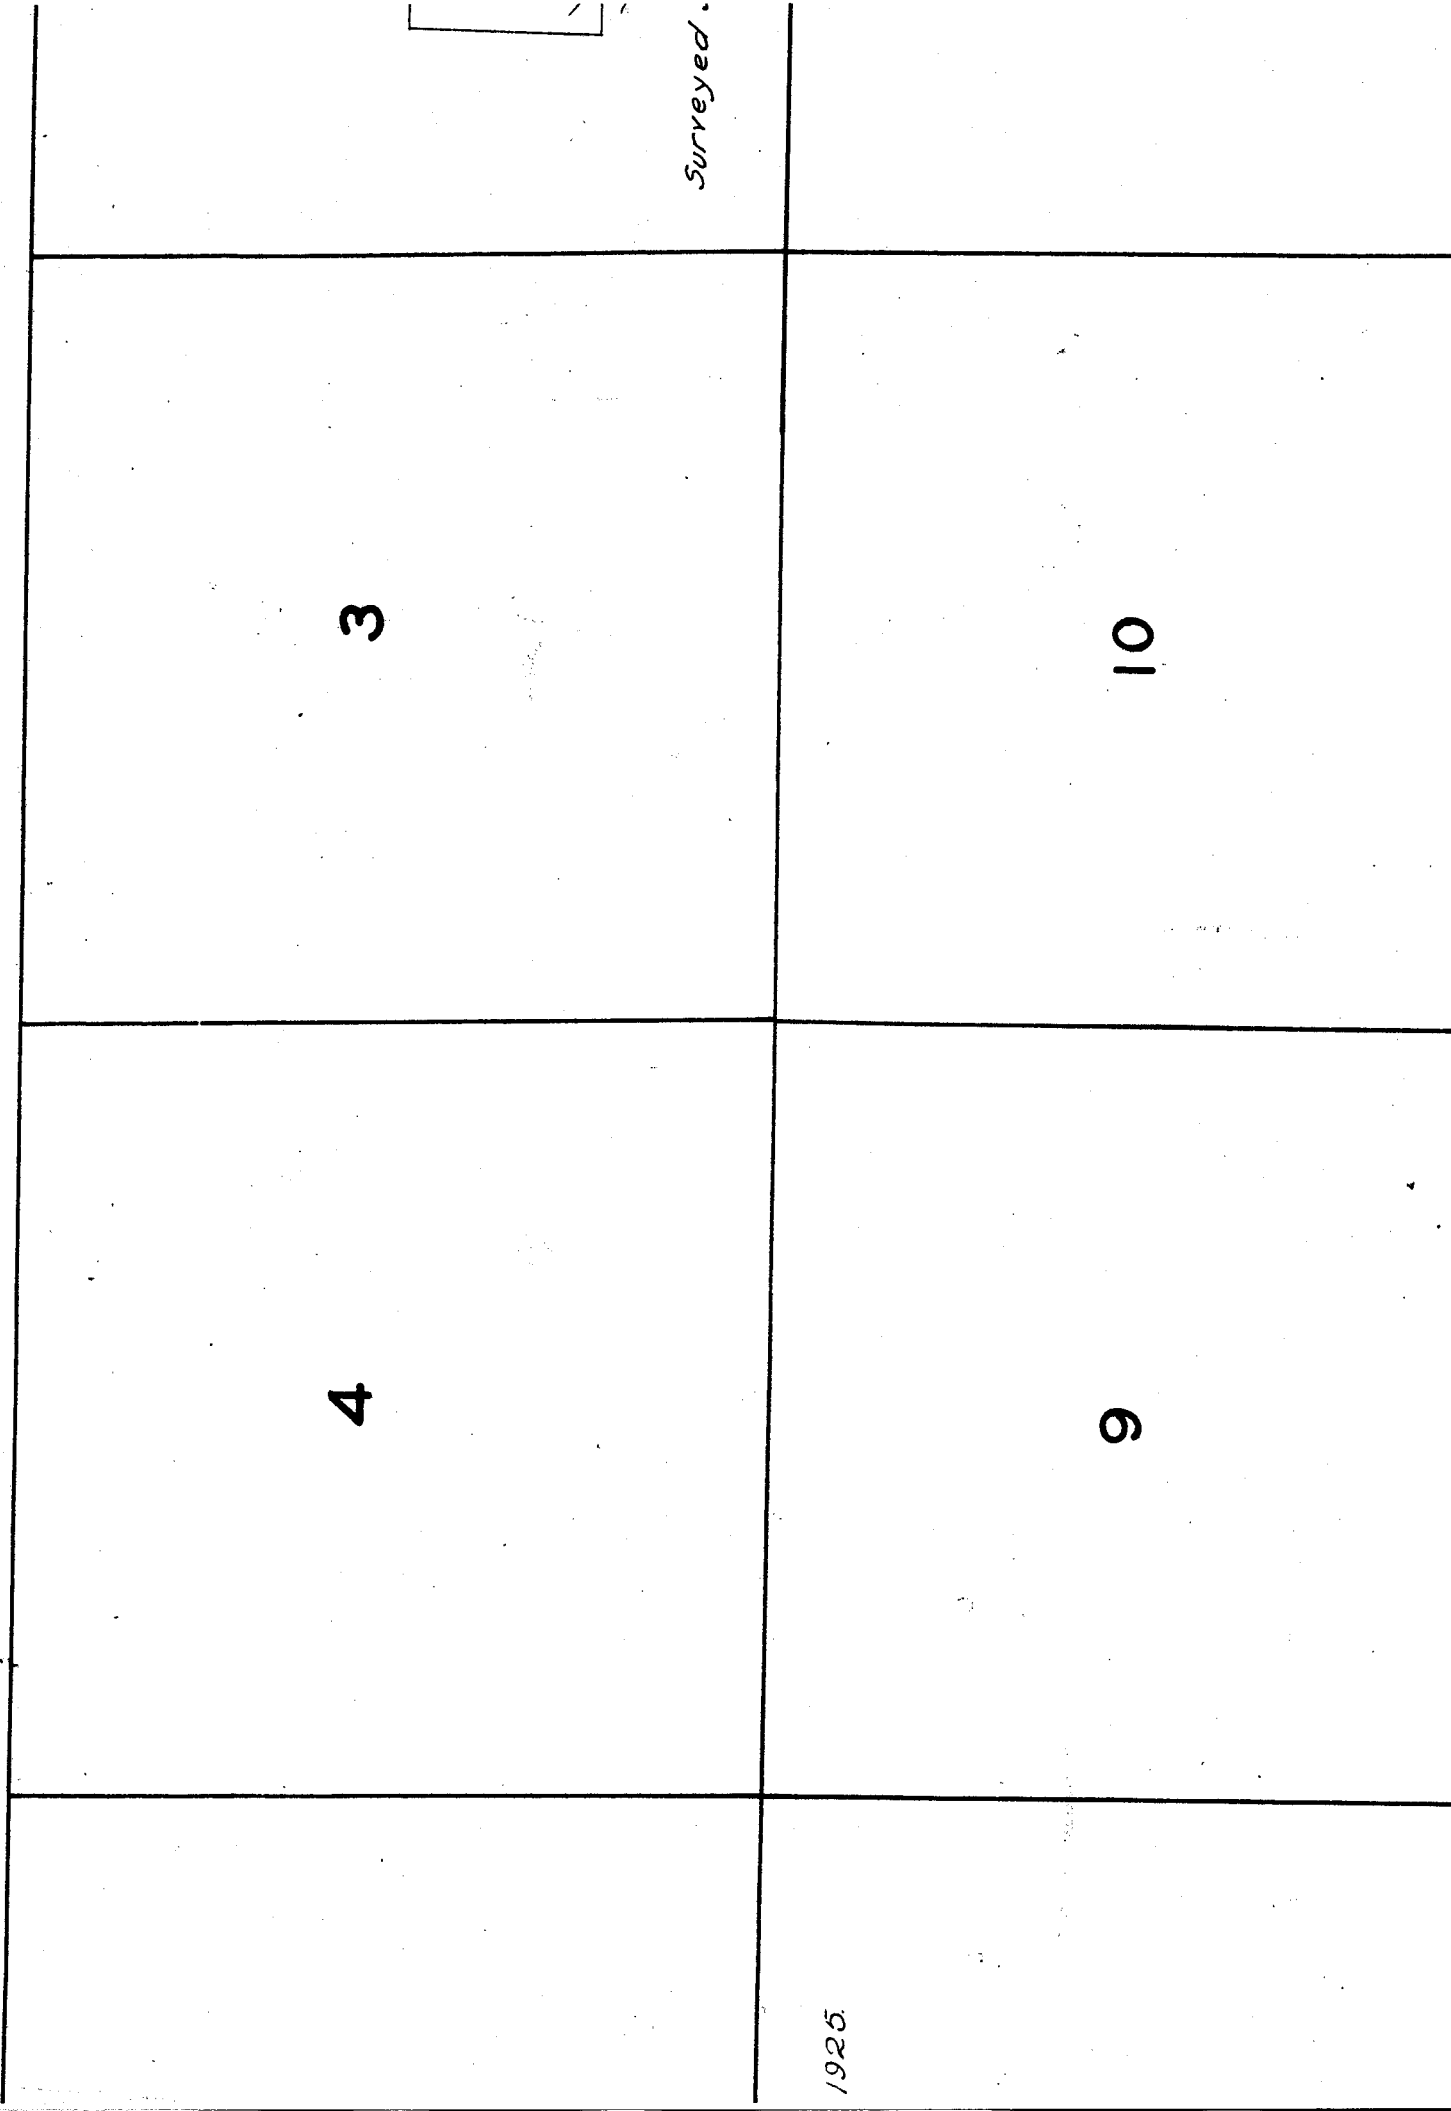

3

4

9

10

Surveyed.

1925

50

15

22

16

21

21

22

28

27

*Surveyed Sept. 24 and 30, 1925.*

33

34

*Baughn*


0<sup>3</sup>

6<sup>3</sup>

*pump*

*Snable*

JOHN DAY RIVER

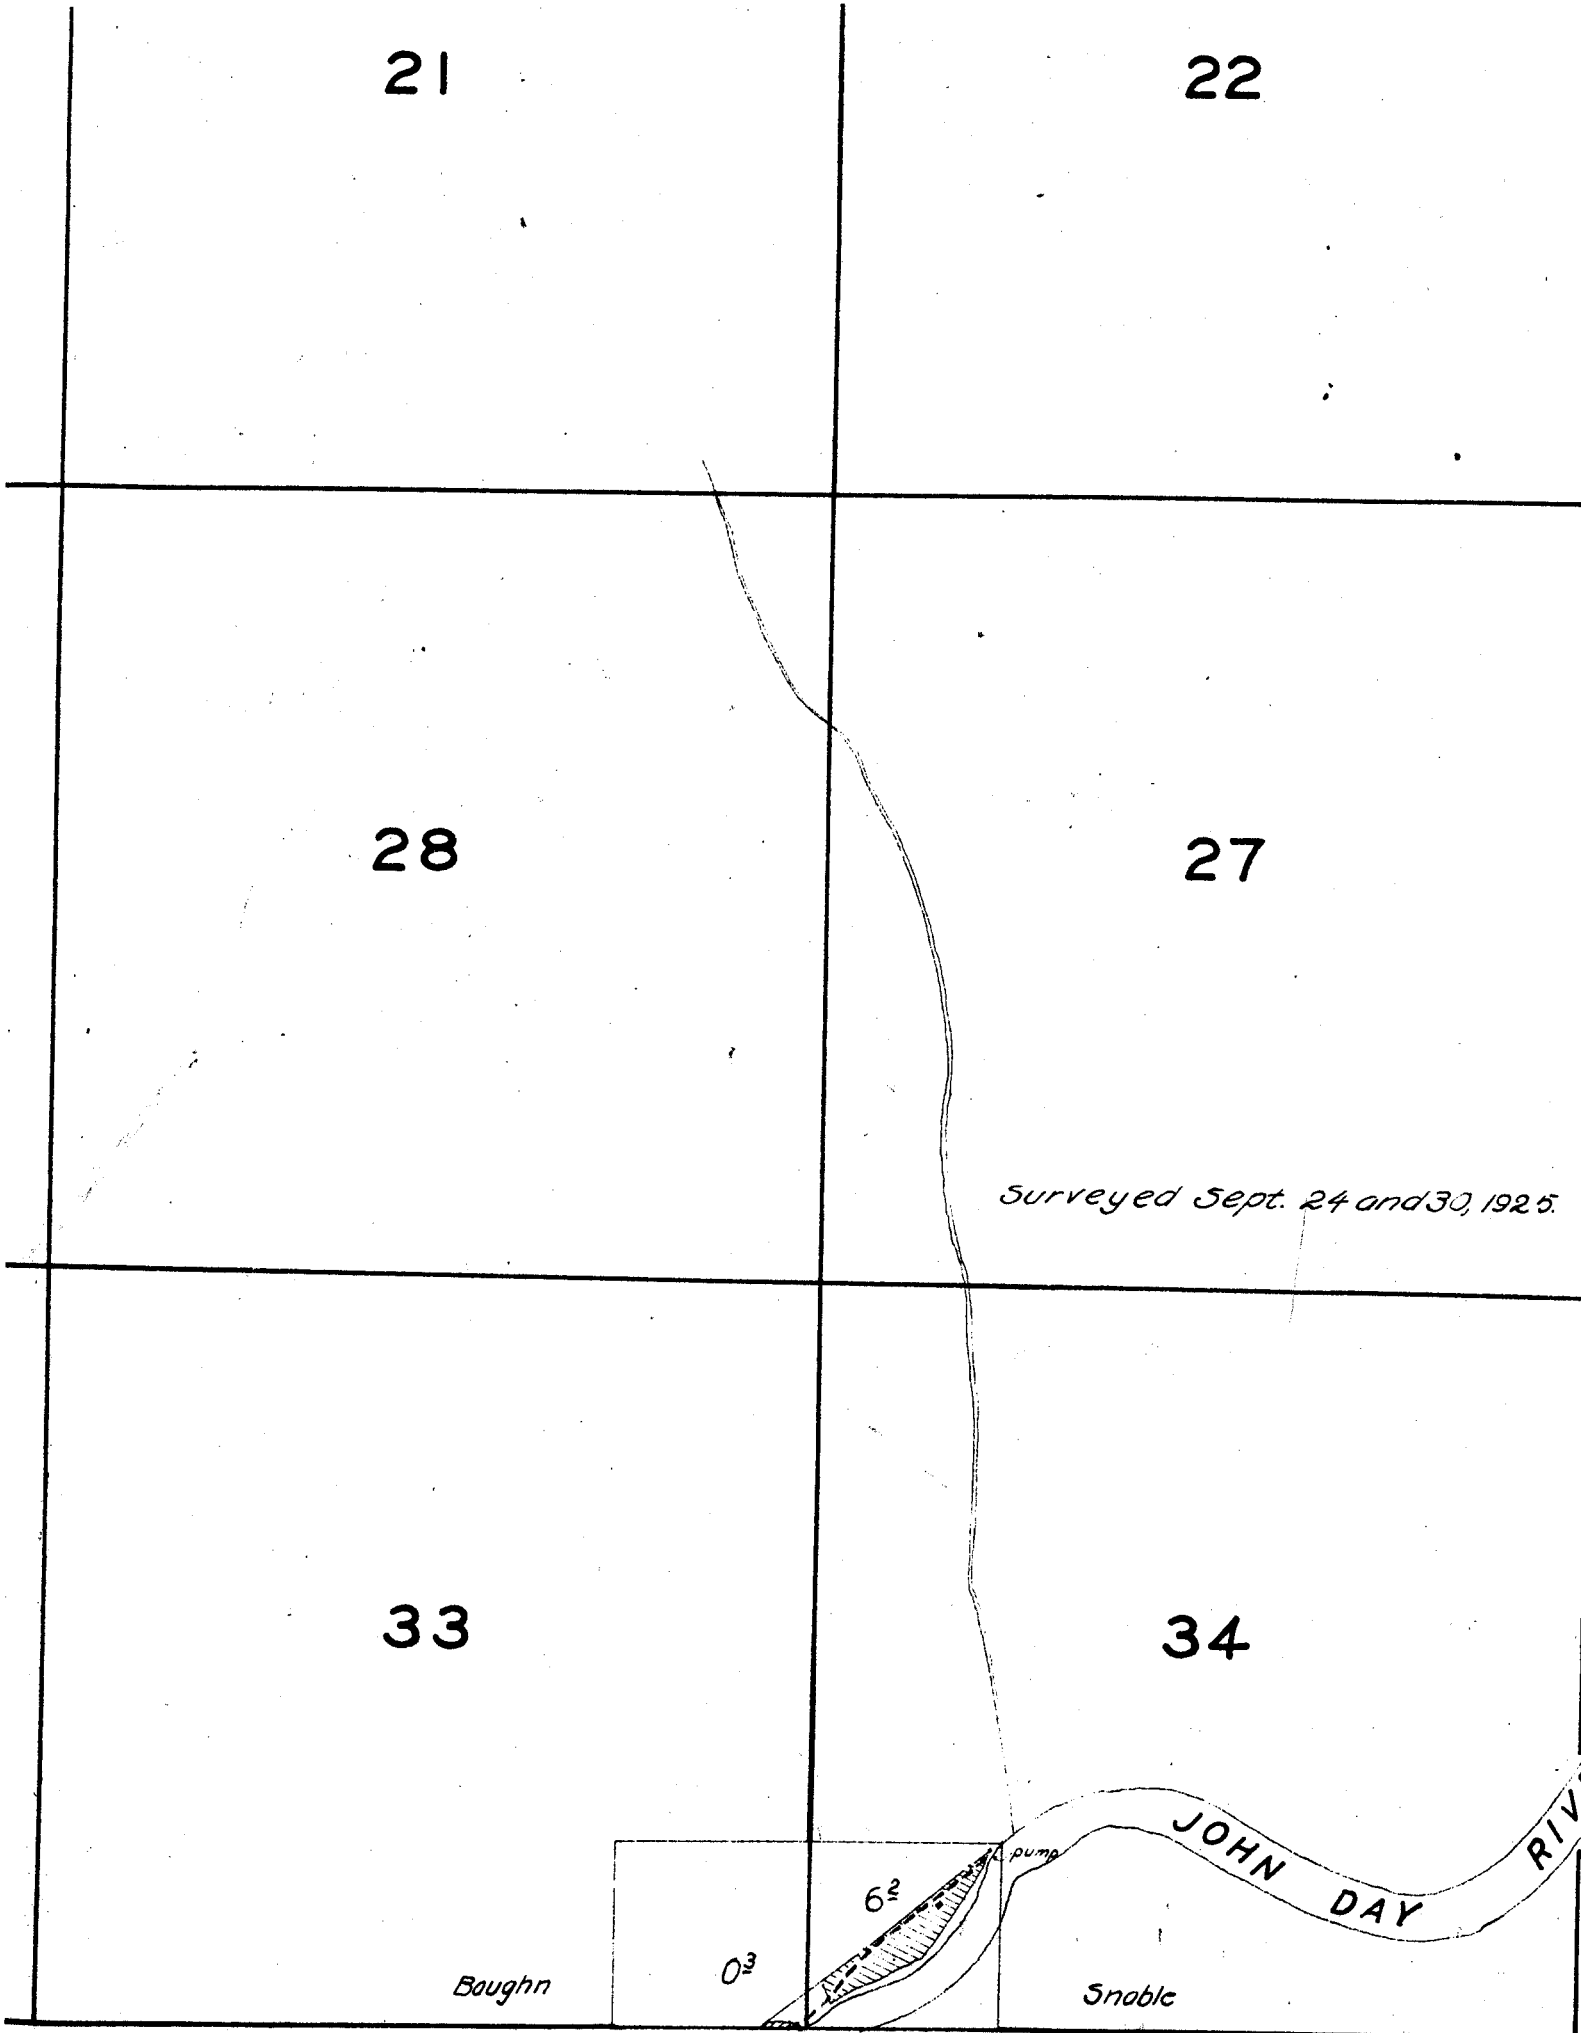

16

21

17

20

18

19



28

29

30



*Note: Streams and Rivers except in the vicinity of irrigated land, sketched in approximate location.*

33

32

MATHIS

Surveyed Oct 29, 1925

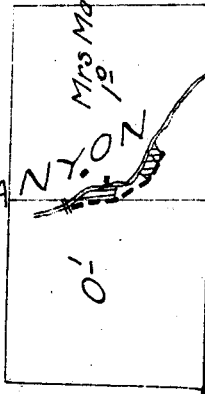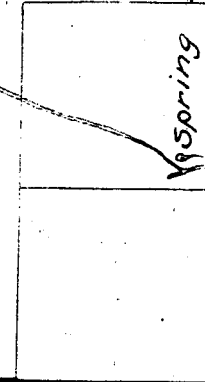

Baugh

6