


TOWNSHIP 8 S., RANGE 25 E.

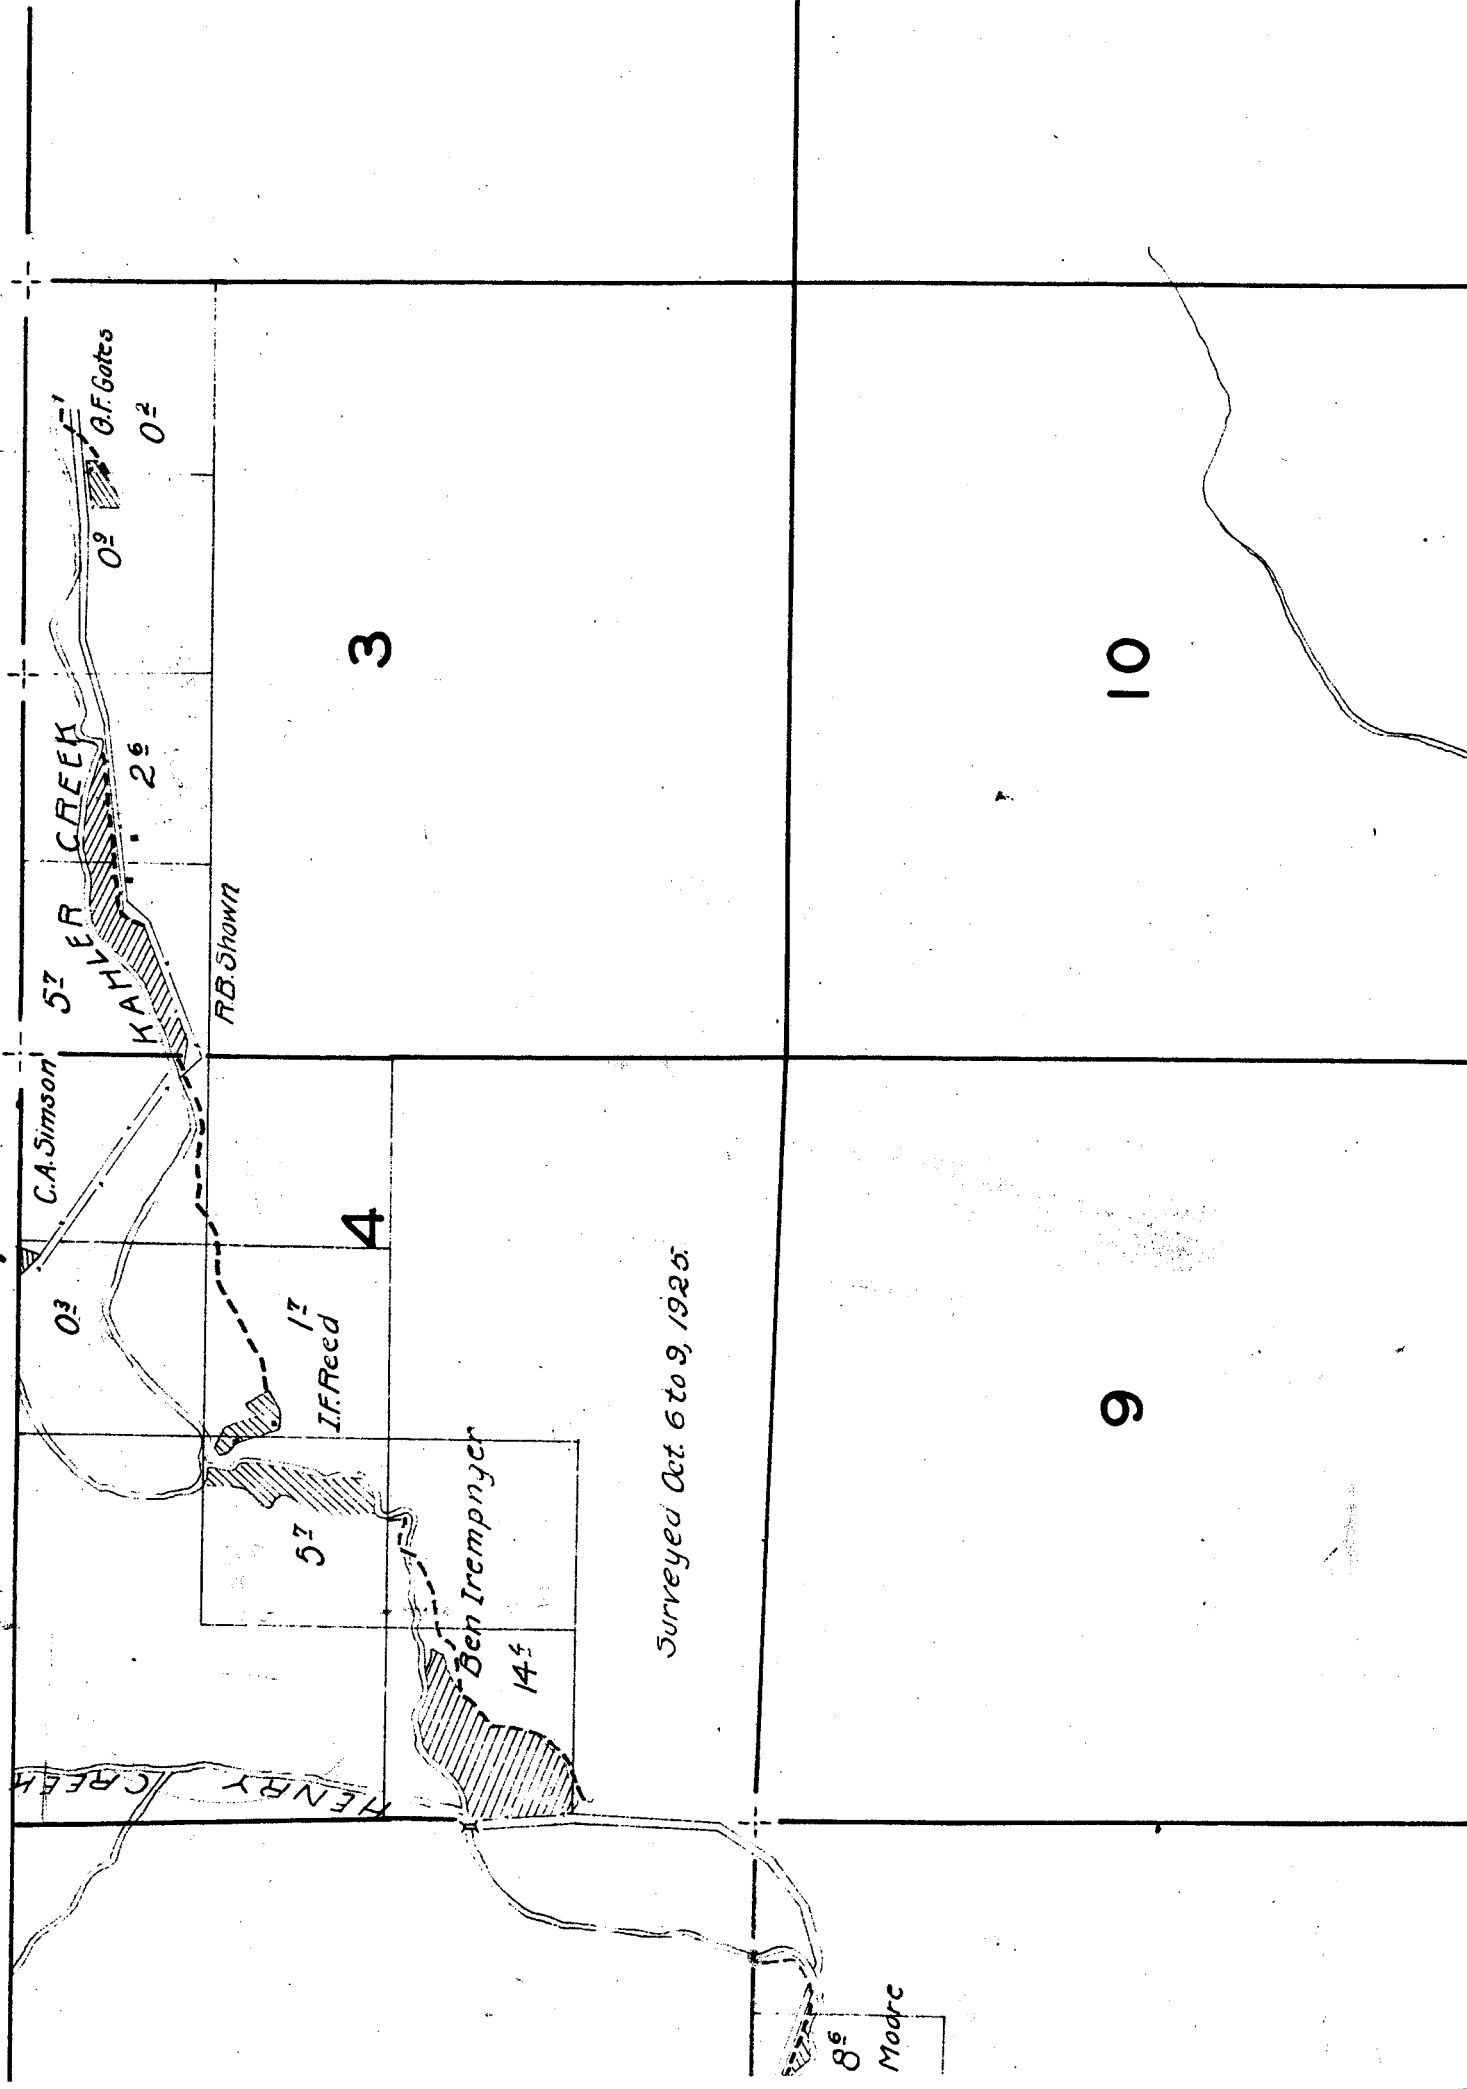


15

22

16

21

L.H. Donavon

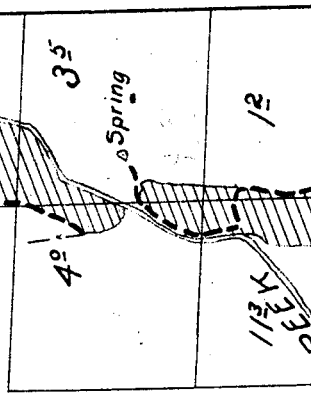

As, except
nd, is
ation.

21

22

4°

7°

3°

Spring

L.H. Donavon

1 1/2
CREEK

1/2

17°

4°

HAYSTACK

Bob Wright

J.F. Asher

28

Spring

17°

Surveyed Sept. 19 to 23, 1926

Steiner

27

5°

C.W. Walls

1°

A.E. Cress

1/2

33

34

40° Now C-35285

27°

0°

3°

Pump

Pr. Jenkins

Vm

2

1

11

12

14

13

6

5

7

13

03

8

page 8⁶
E. R. Moore

02

4⁹

A. S. Borges

18

17

30

29

28

HAYSTACK

Bob Wrig 54

J. Fisher

Spring

Surveyed Se

L.L. Steiner

24

16

C.W. Wells

28

16

32

33

33

31

Surveyed Sept 29, 1925

Cam Wagner

L.L. Steiner

263

139

40° N 00° W

C 35285

279

218

218

07

33

33

33

33

12

20°

28°












34

First National Bank
Condon
Oct. 03

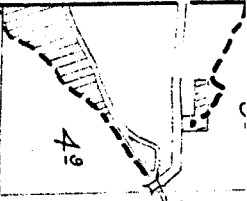

AS Borges

4²

18

17

16

19

20

21

Note: Location of streams and roads, except in the vicinity of irrigated land, is sketched in approximate location.

4¹

11³/₄ CREEK

Surveyed Sept. 29, 1925.

Palm Cr.

27

26

25

34

35

36

15

14

13

22

23

24

IVEG CREEK

02

62

RI Conster

17

05



TOWNSHIP 7 S., RANGE 25 E.

4

3

9

10

16

15

23


24

26

25

35

36

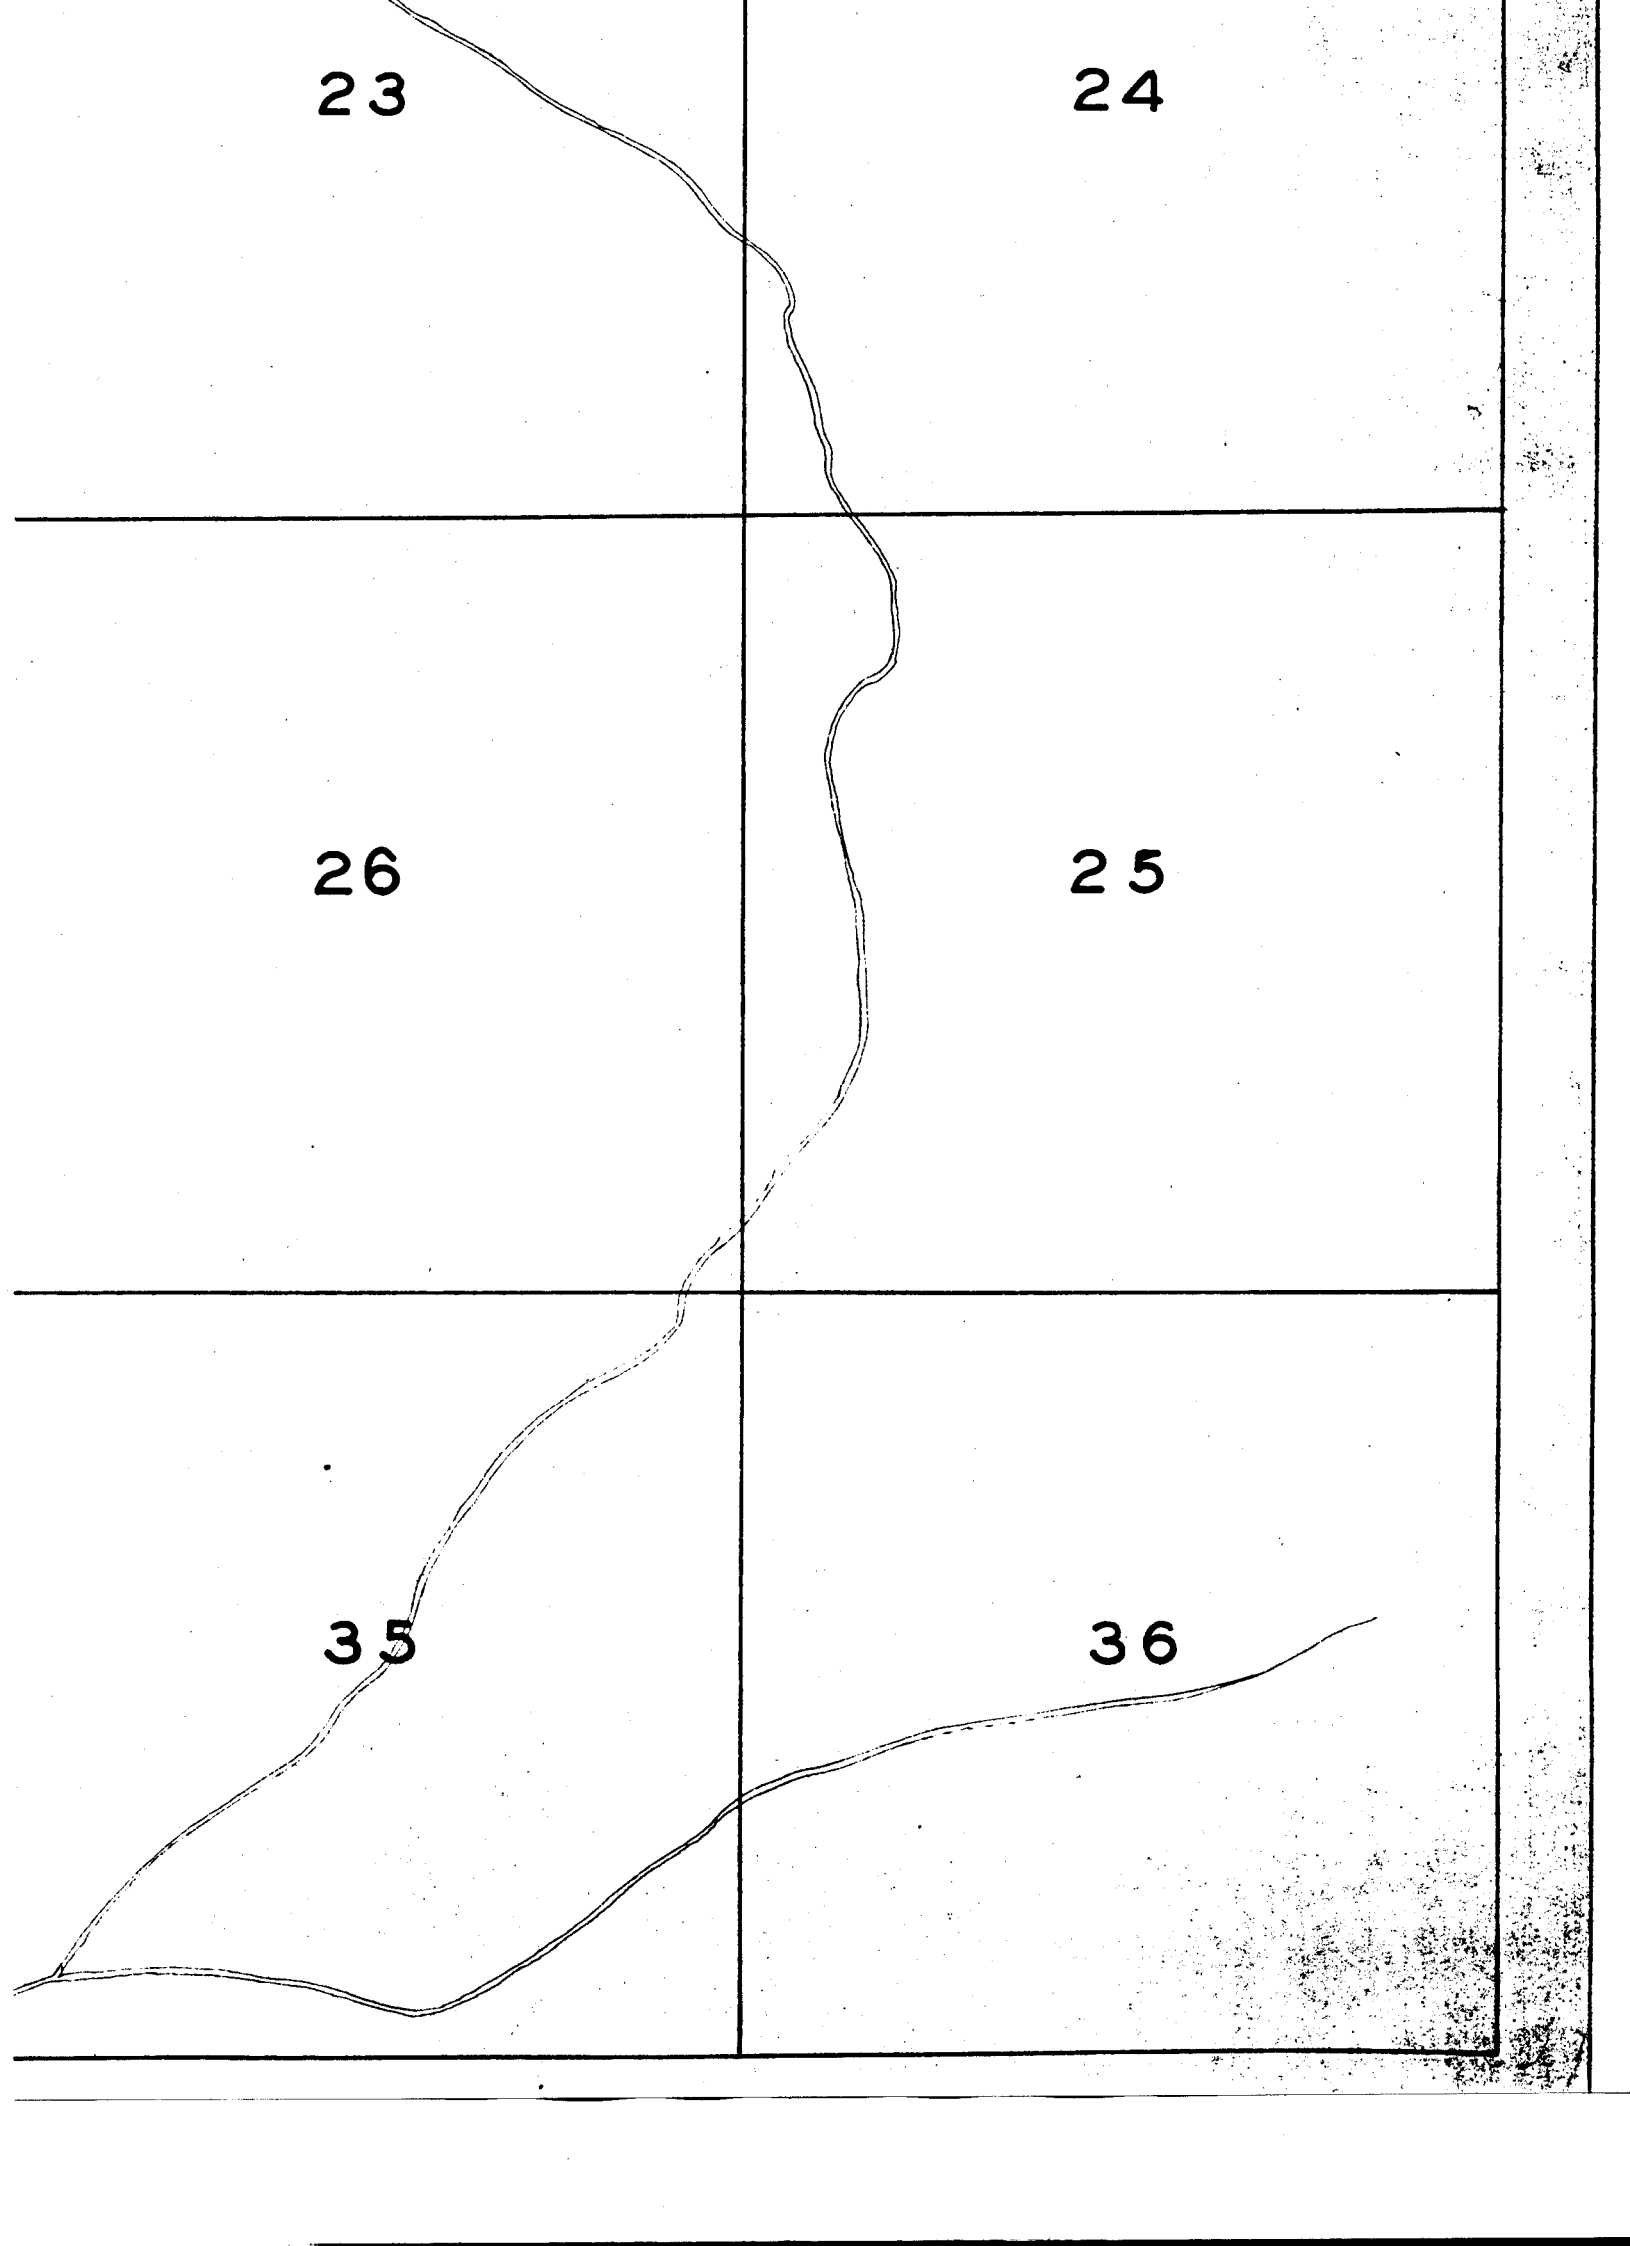

15


20

30

29

31

Clarence Bisbee 32

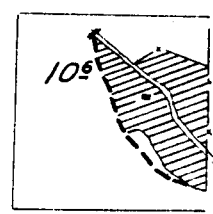

28

27

33

34

HENRY

CREEK

Bruce Engard

E. HEVONS

Surveyed Oct. 10, 1926.

1/8

1/2

Ch. Simson

29

Spring

36

16

15

21

22

Note: Location of streams, except in the vicinity of irrigated land, is sketched in approximate location.

15


14

13

22

23

24

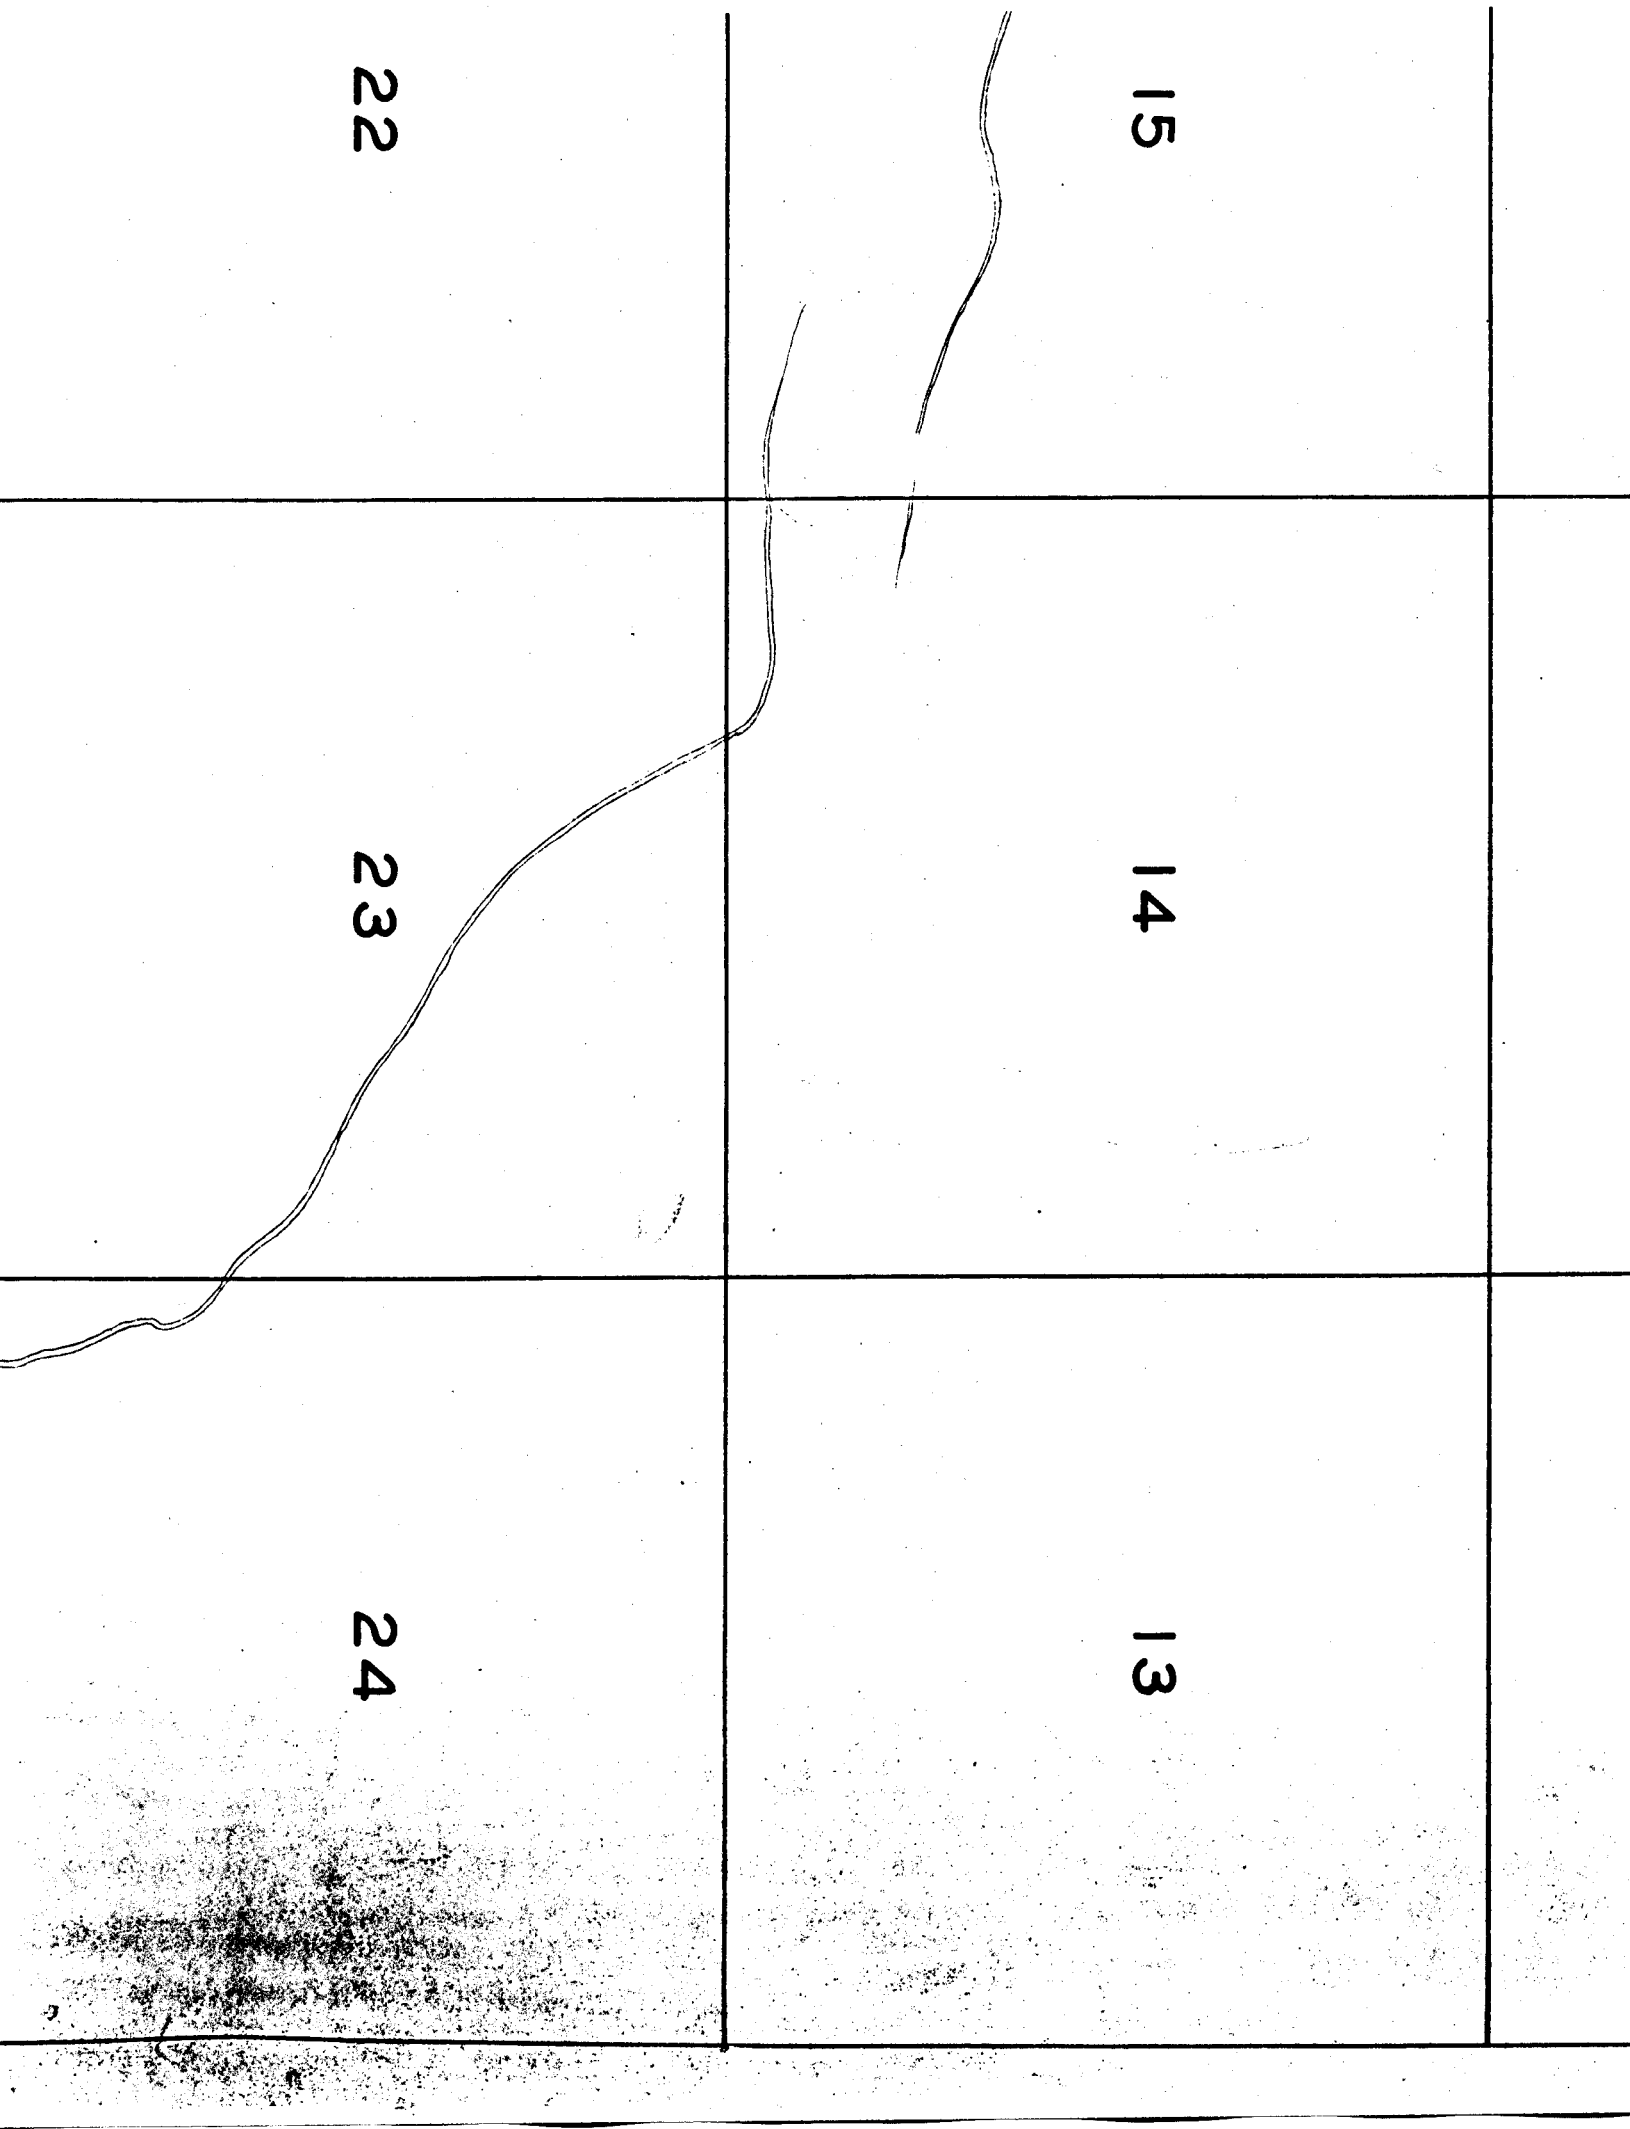

3E25E.

35-2-1

3


2

1

10

11

12

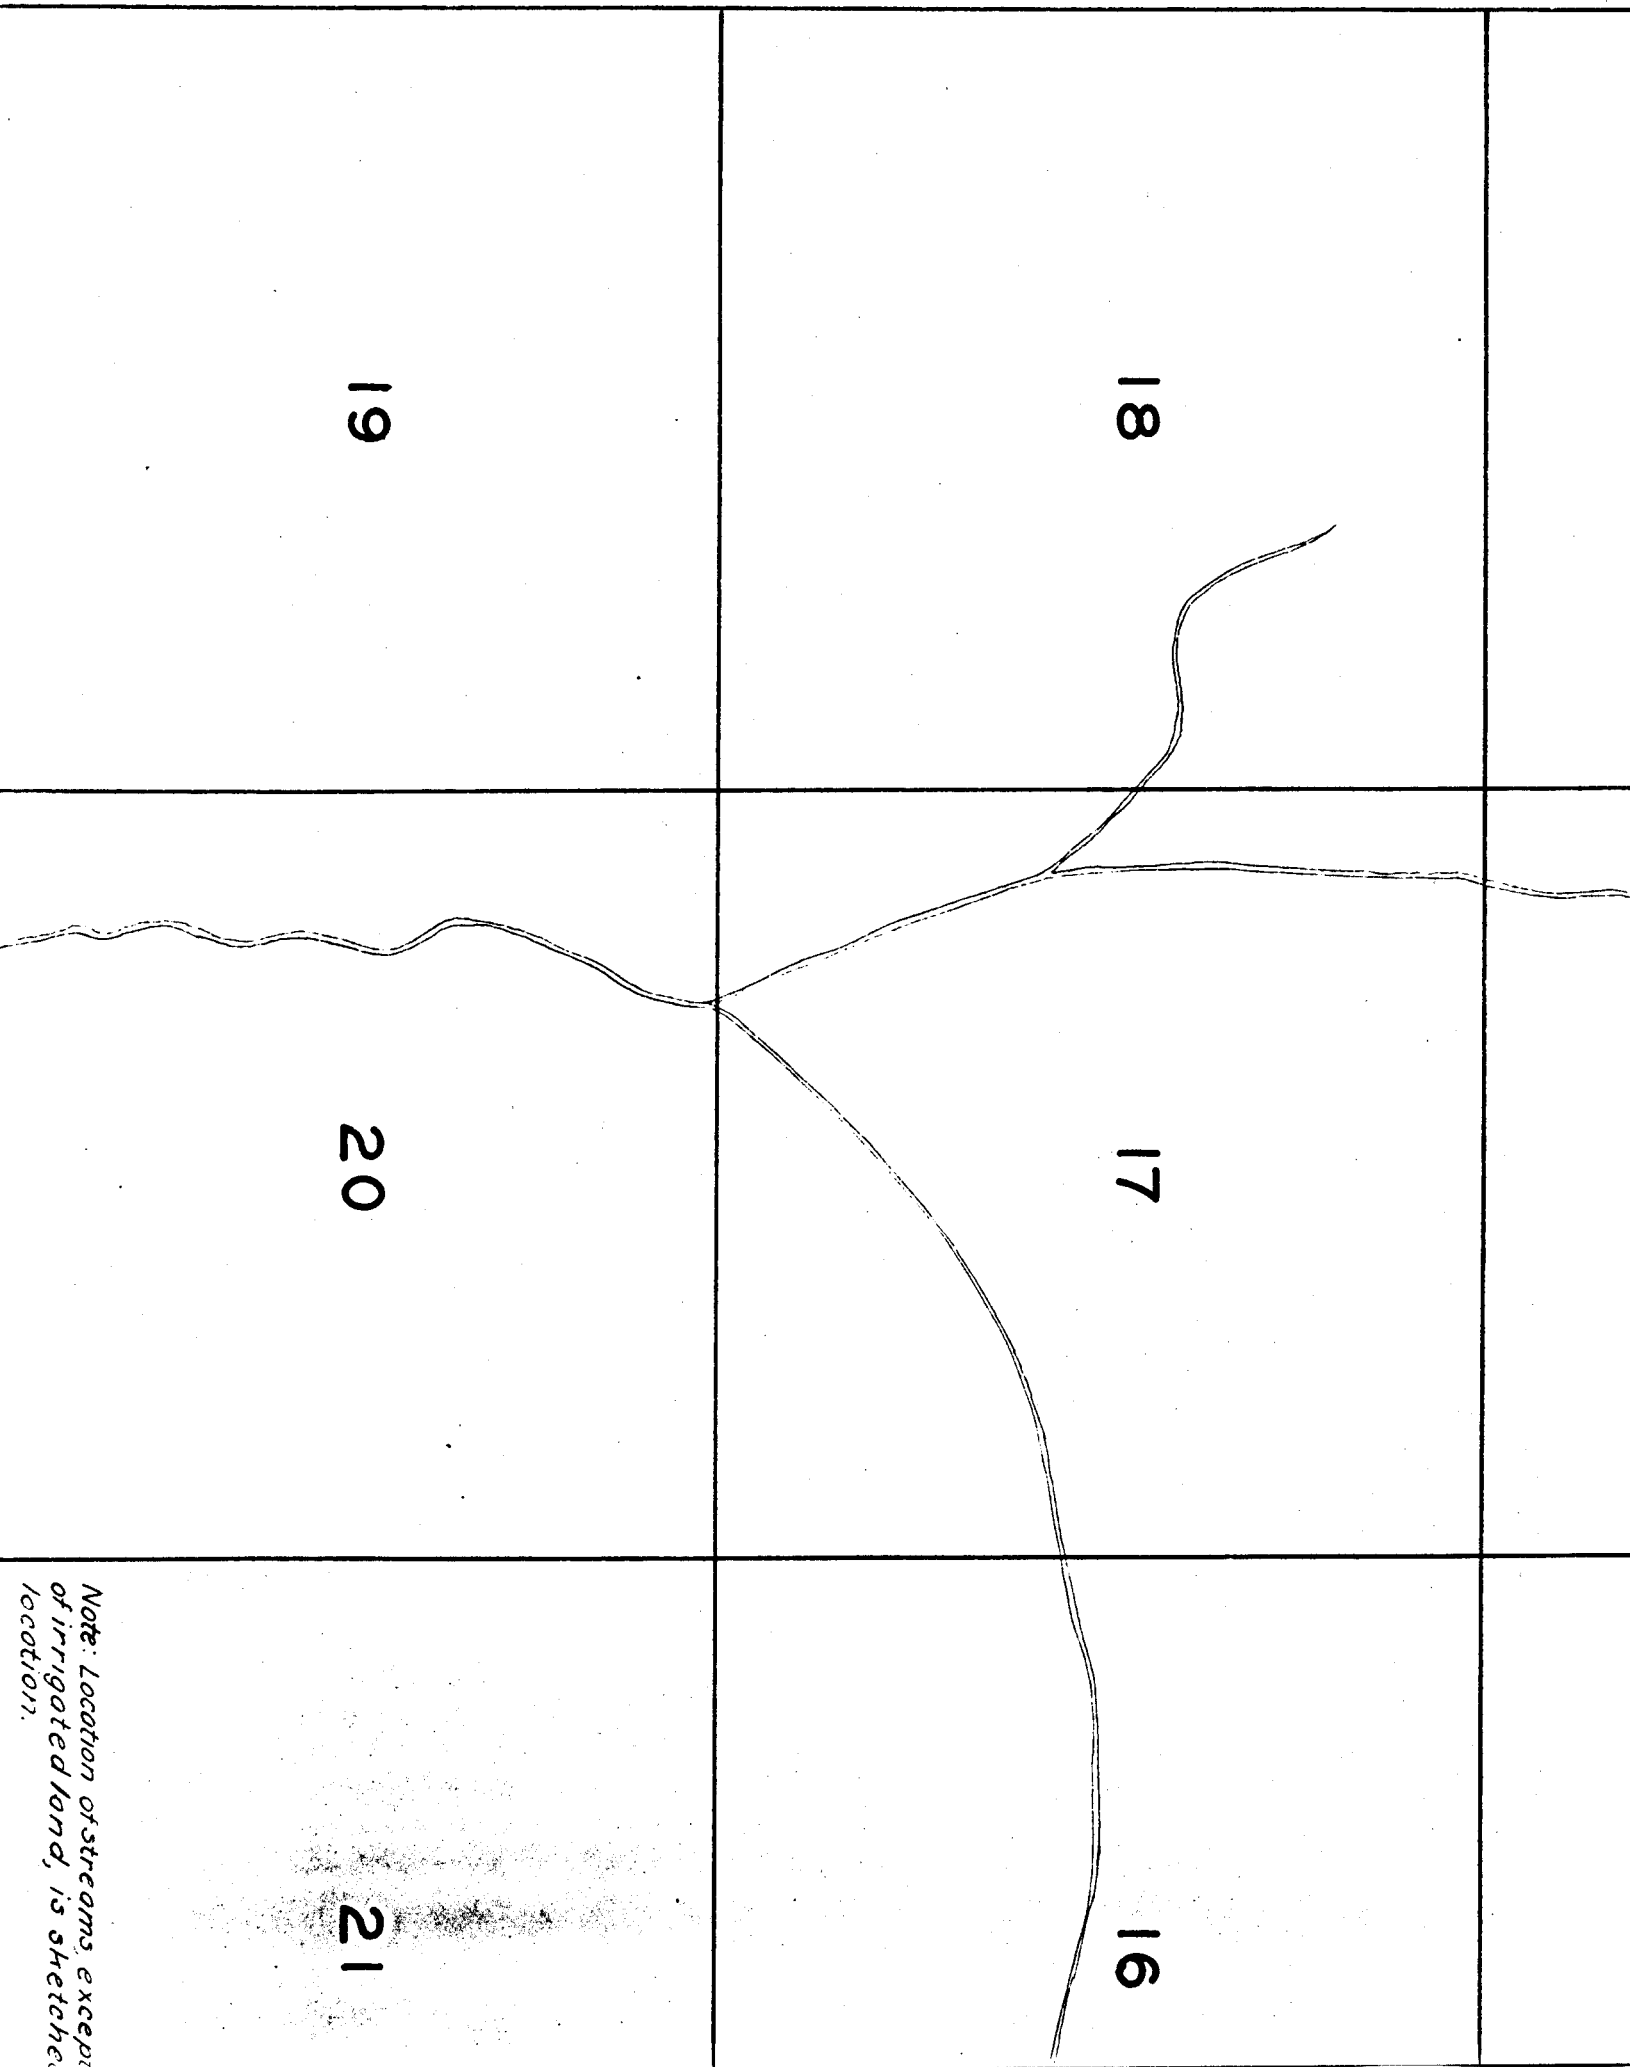

TOWNSH

6

5

4

7

8

9

