


16

15

21

22

Note: Streams, except in the vicinity of irrigated land, are sketched in approximate location.

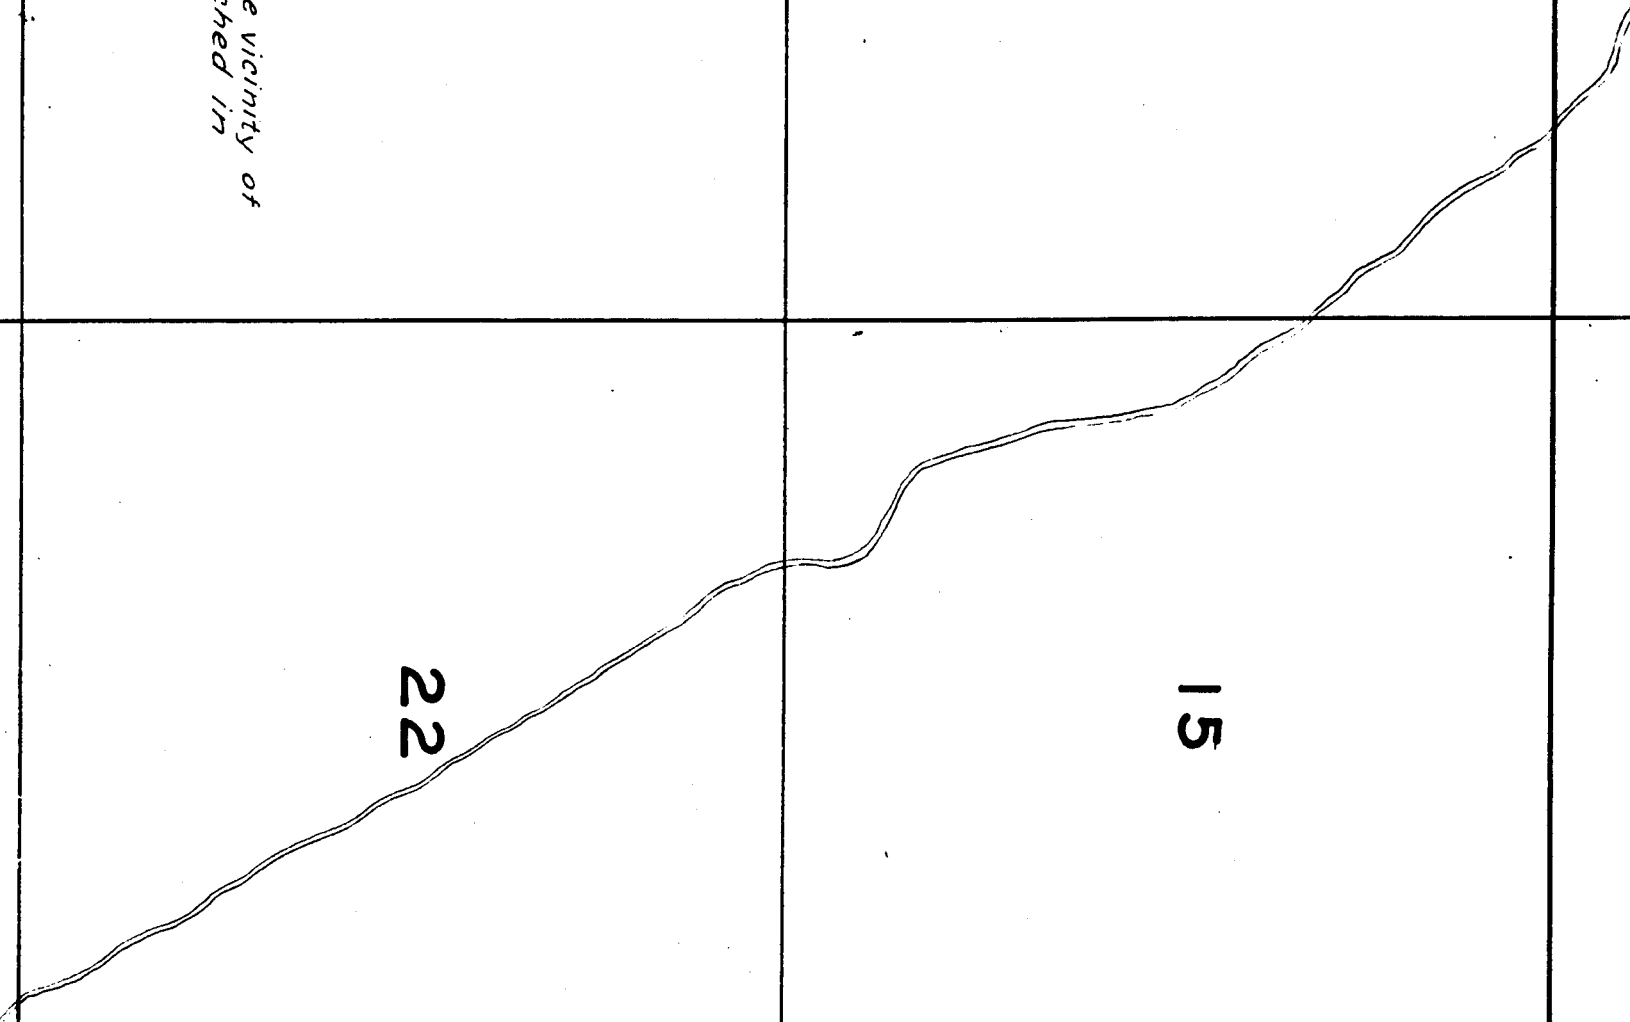

28

27

33

34

19

20

30

29

31

32

23


24

26

25

35

36

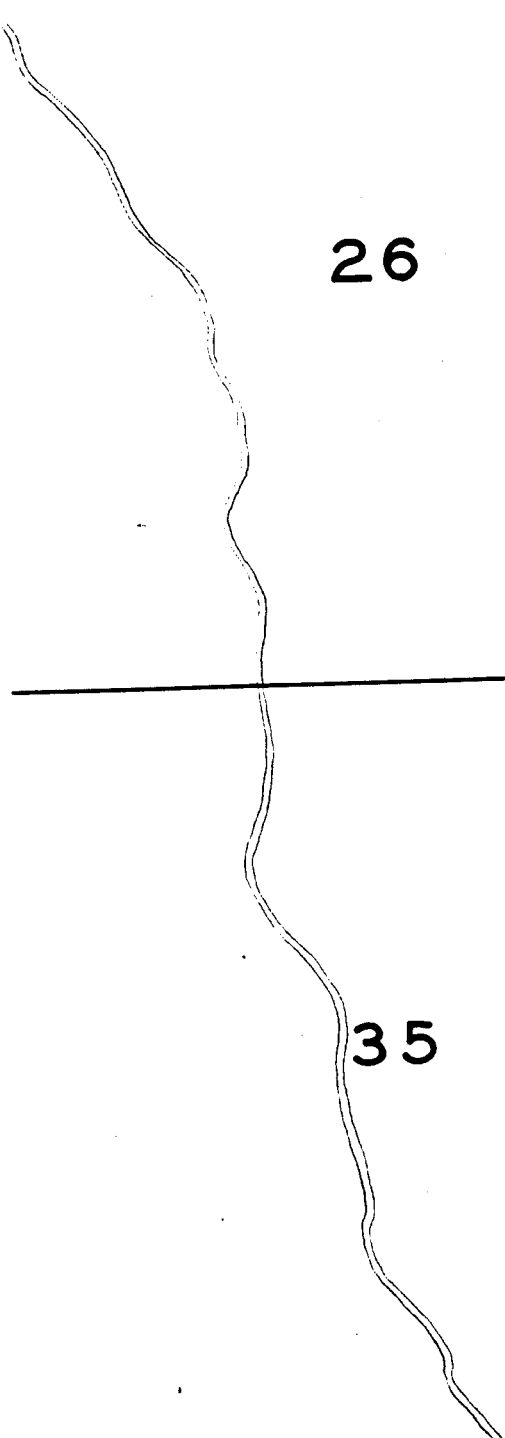

TOWNSHIP 5 S., RANGE 21 E.

Lot 4.

06

THIRTY

MILE

CREEK

4

C.M. Smith

35

73

02

01

3

Surveyed August 24, 1926.

9


10

16

15

SE 21 E.

20-2-1

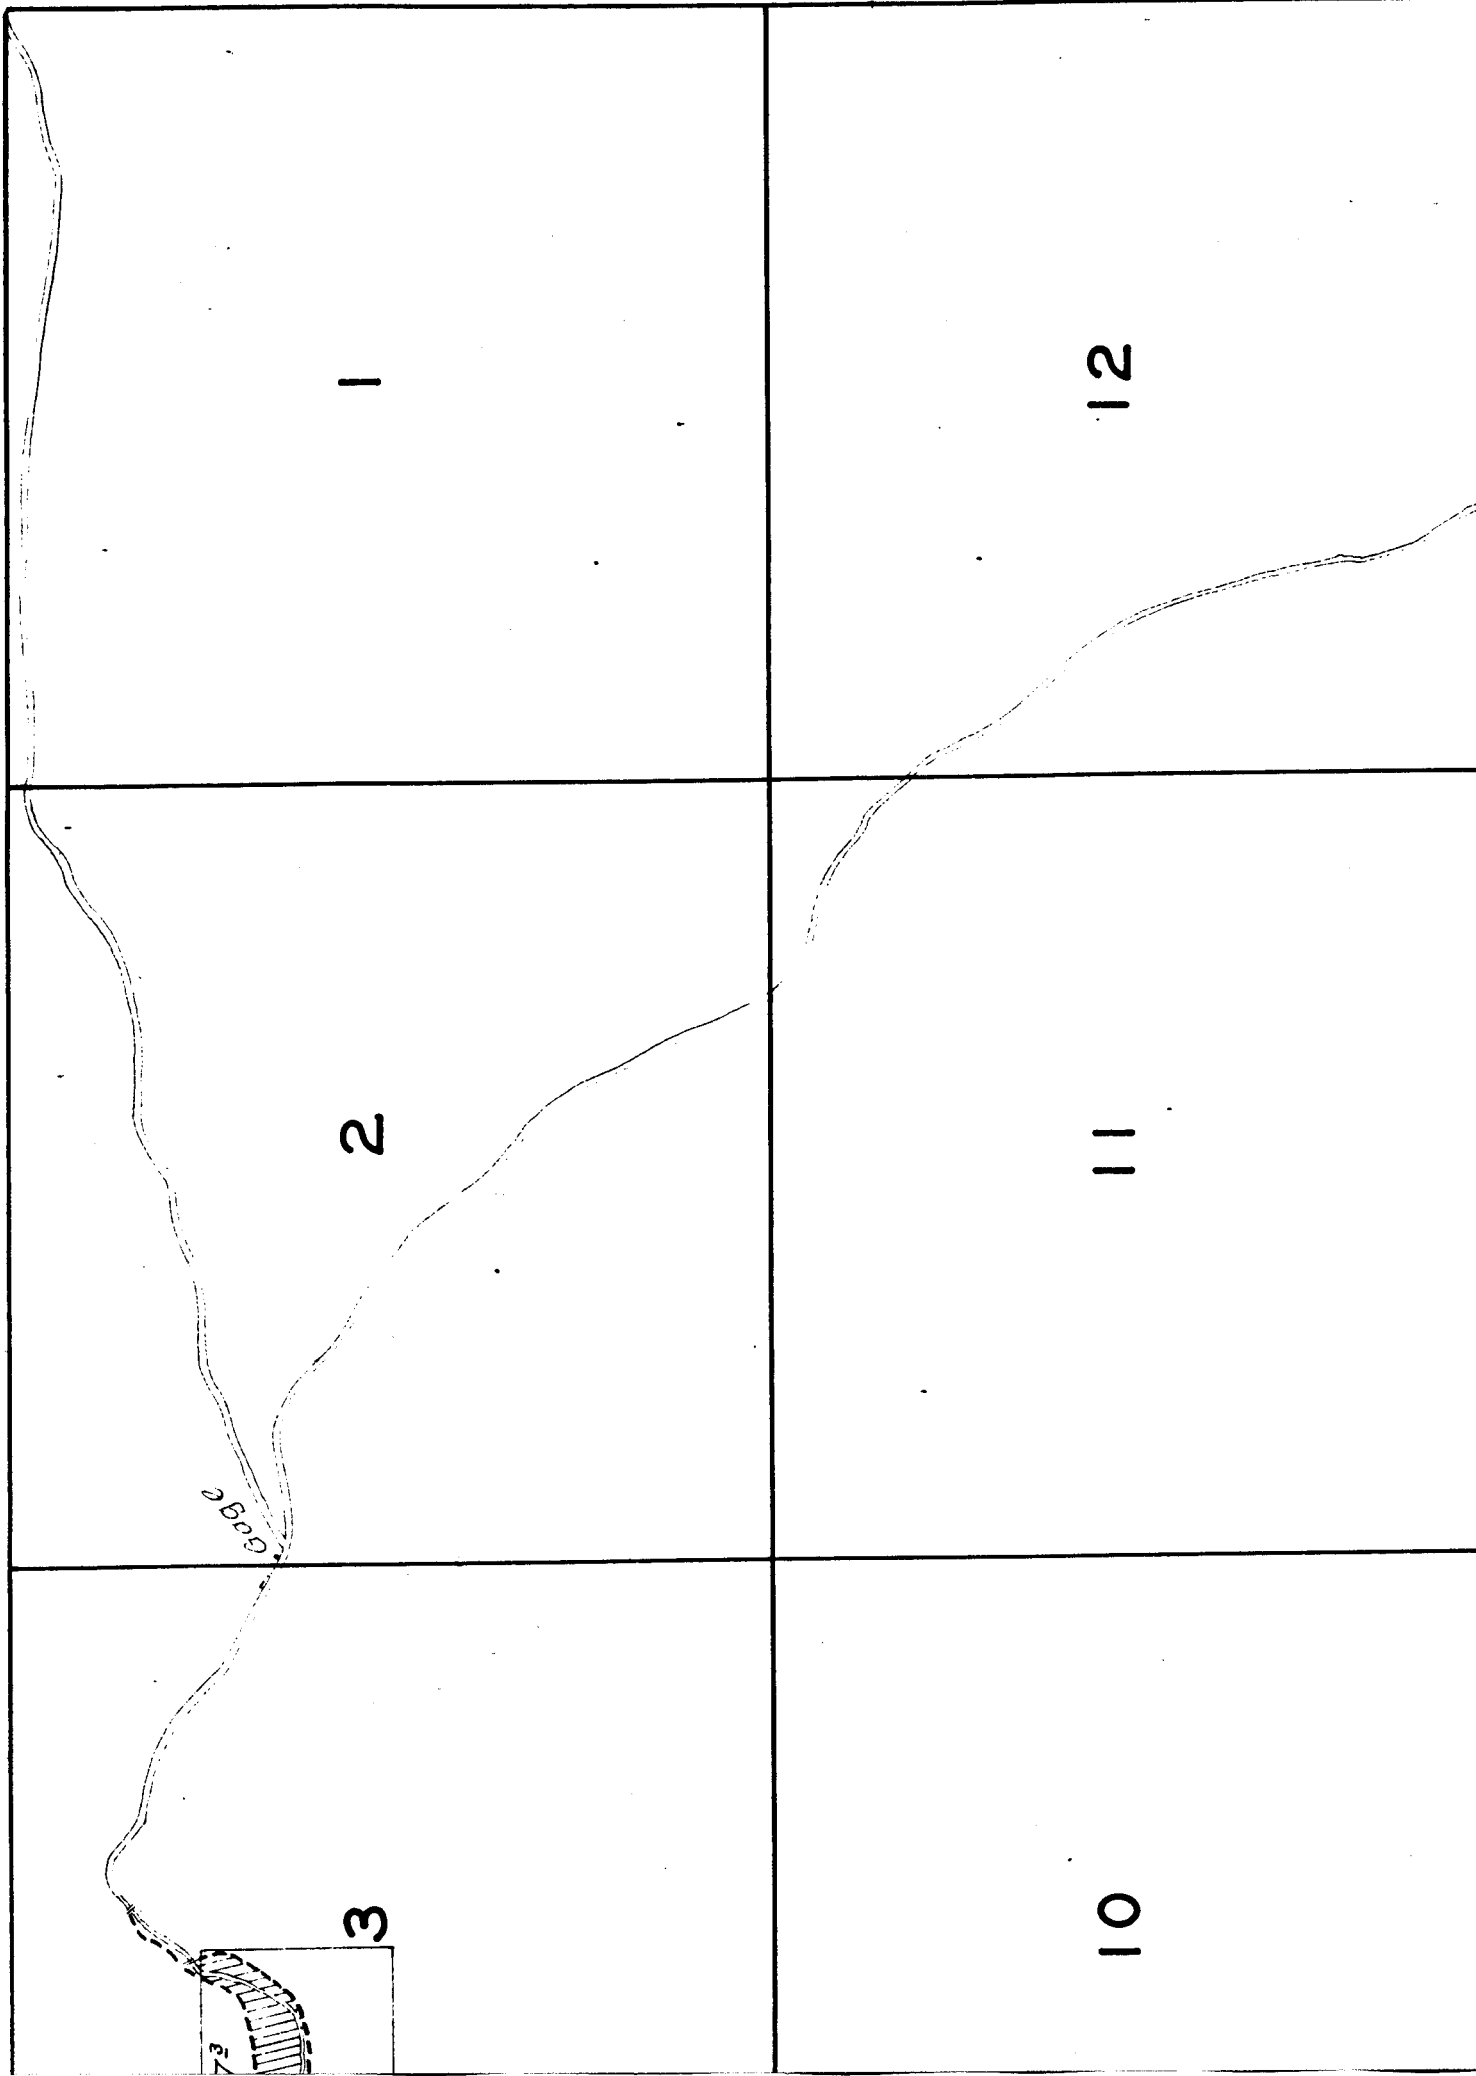

15

14

13

George Stewart

0-

1°


Surveyed August 23, 1926.

22

23

24

TOWNSHIP

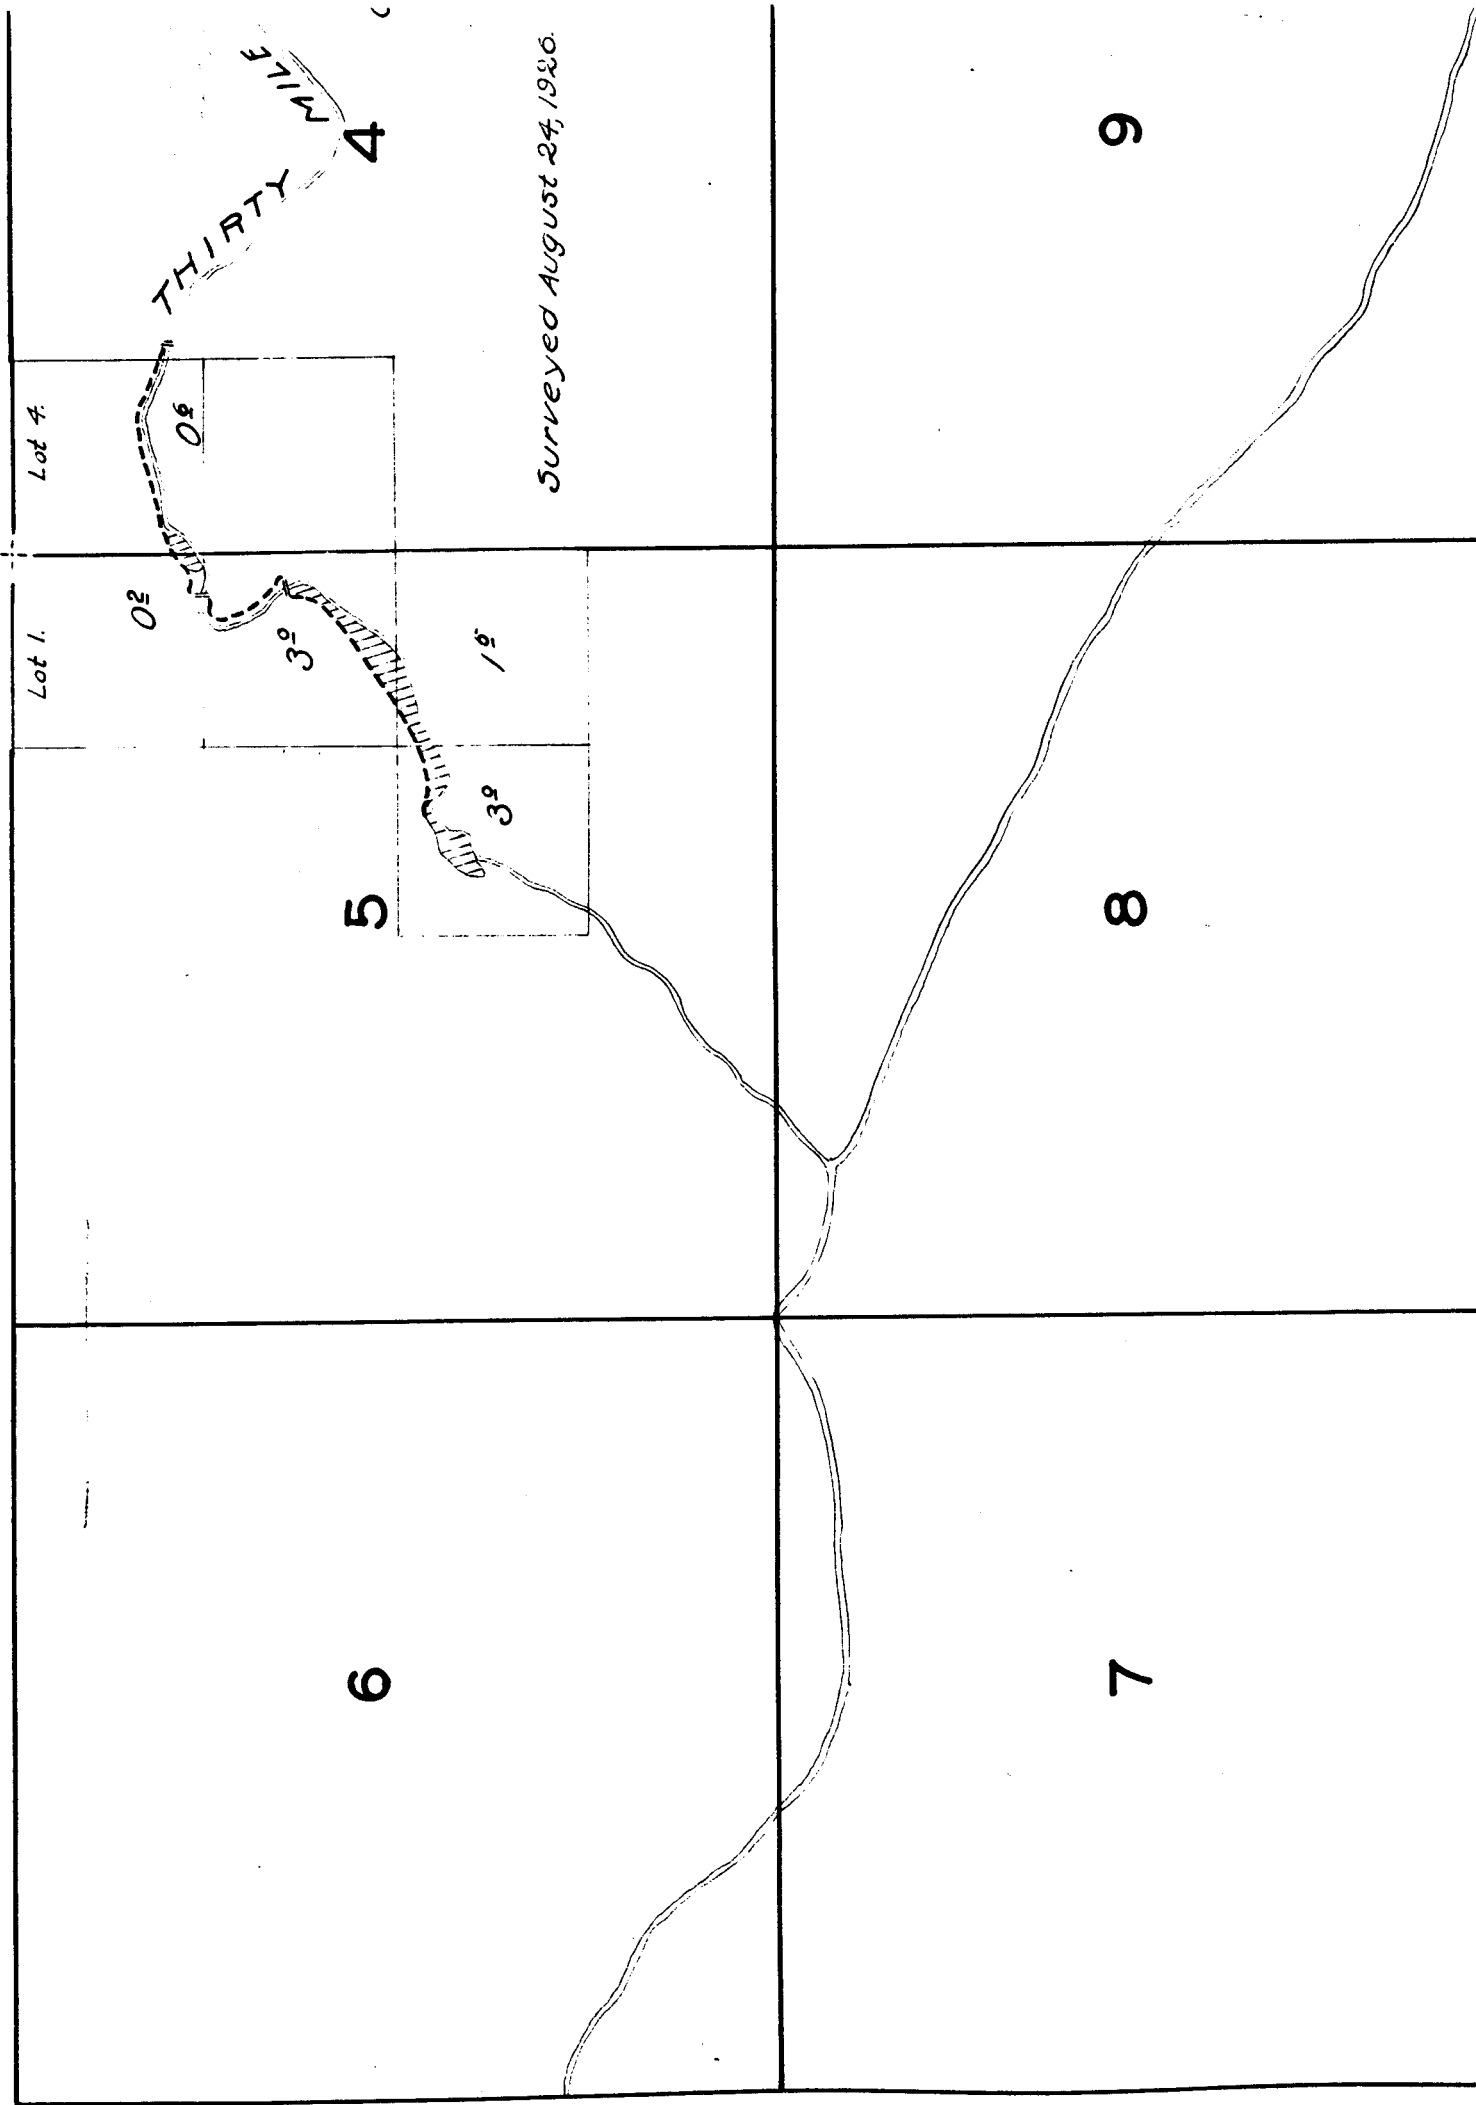

18

17

16

19

20

21

*Note: Streams, except in the vic
irrigated land, are sketched
approximate location.*