

27

26

34

35

Stewer & Carpenter Bank

12

500 ft. Pipe
Spring

36

Blunt Stamp Creek

32


10

Mrs. Margaret E. Barnera
Clt Brown

23

25


35

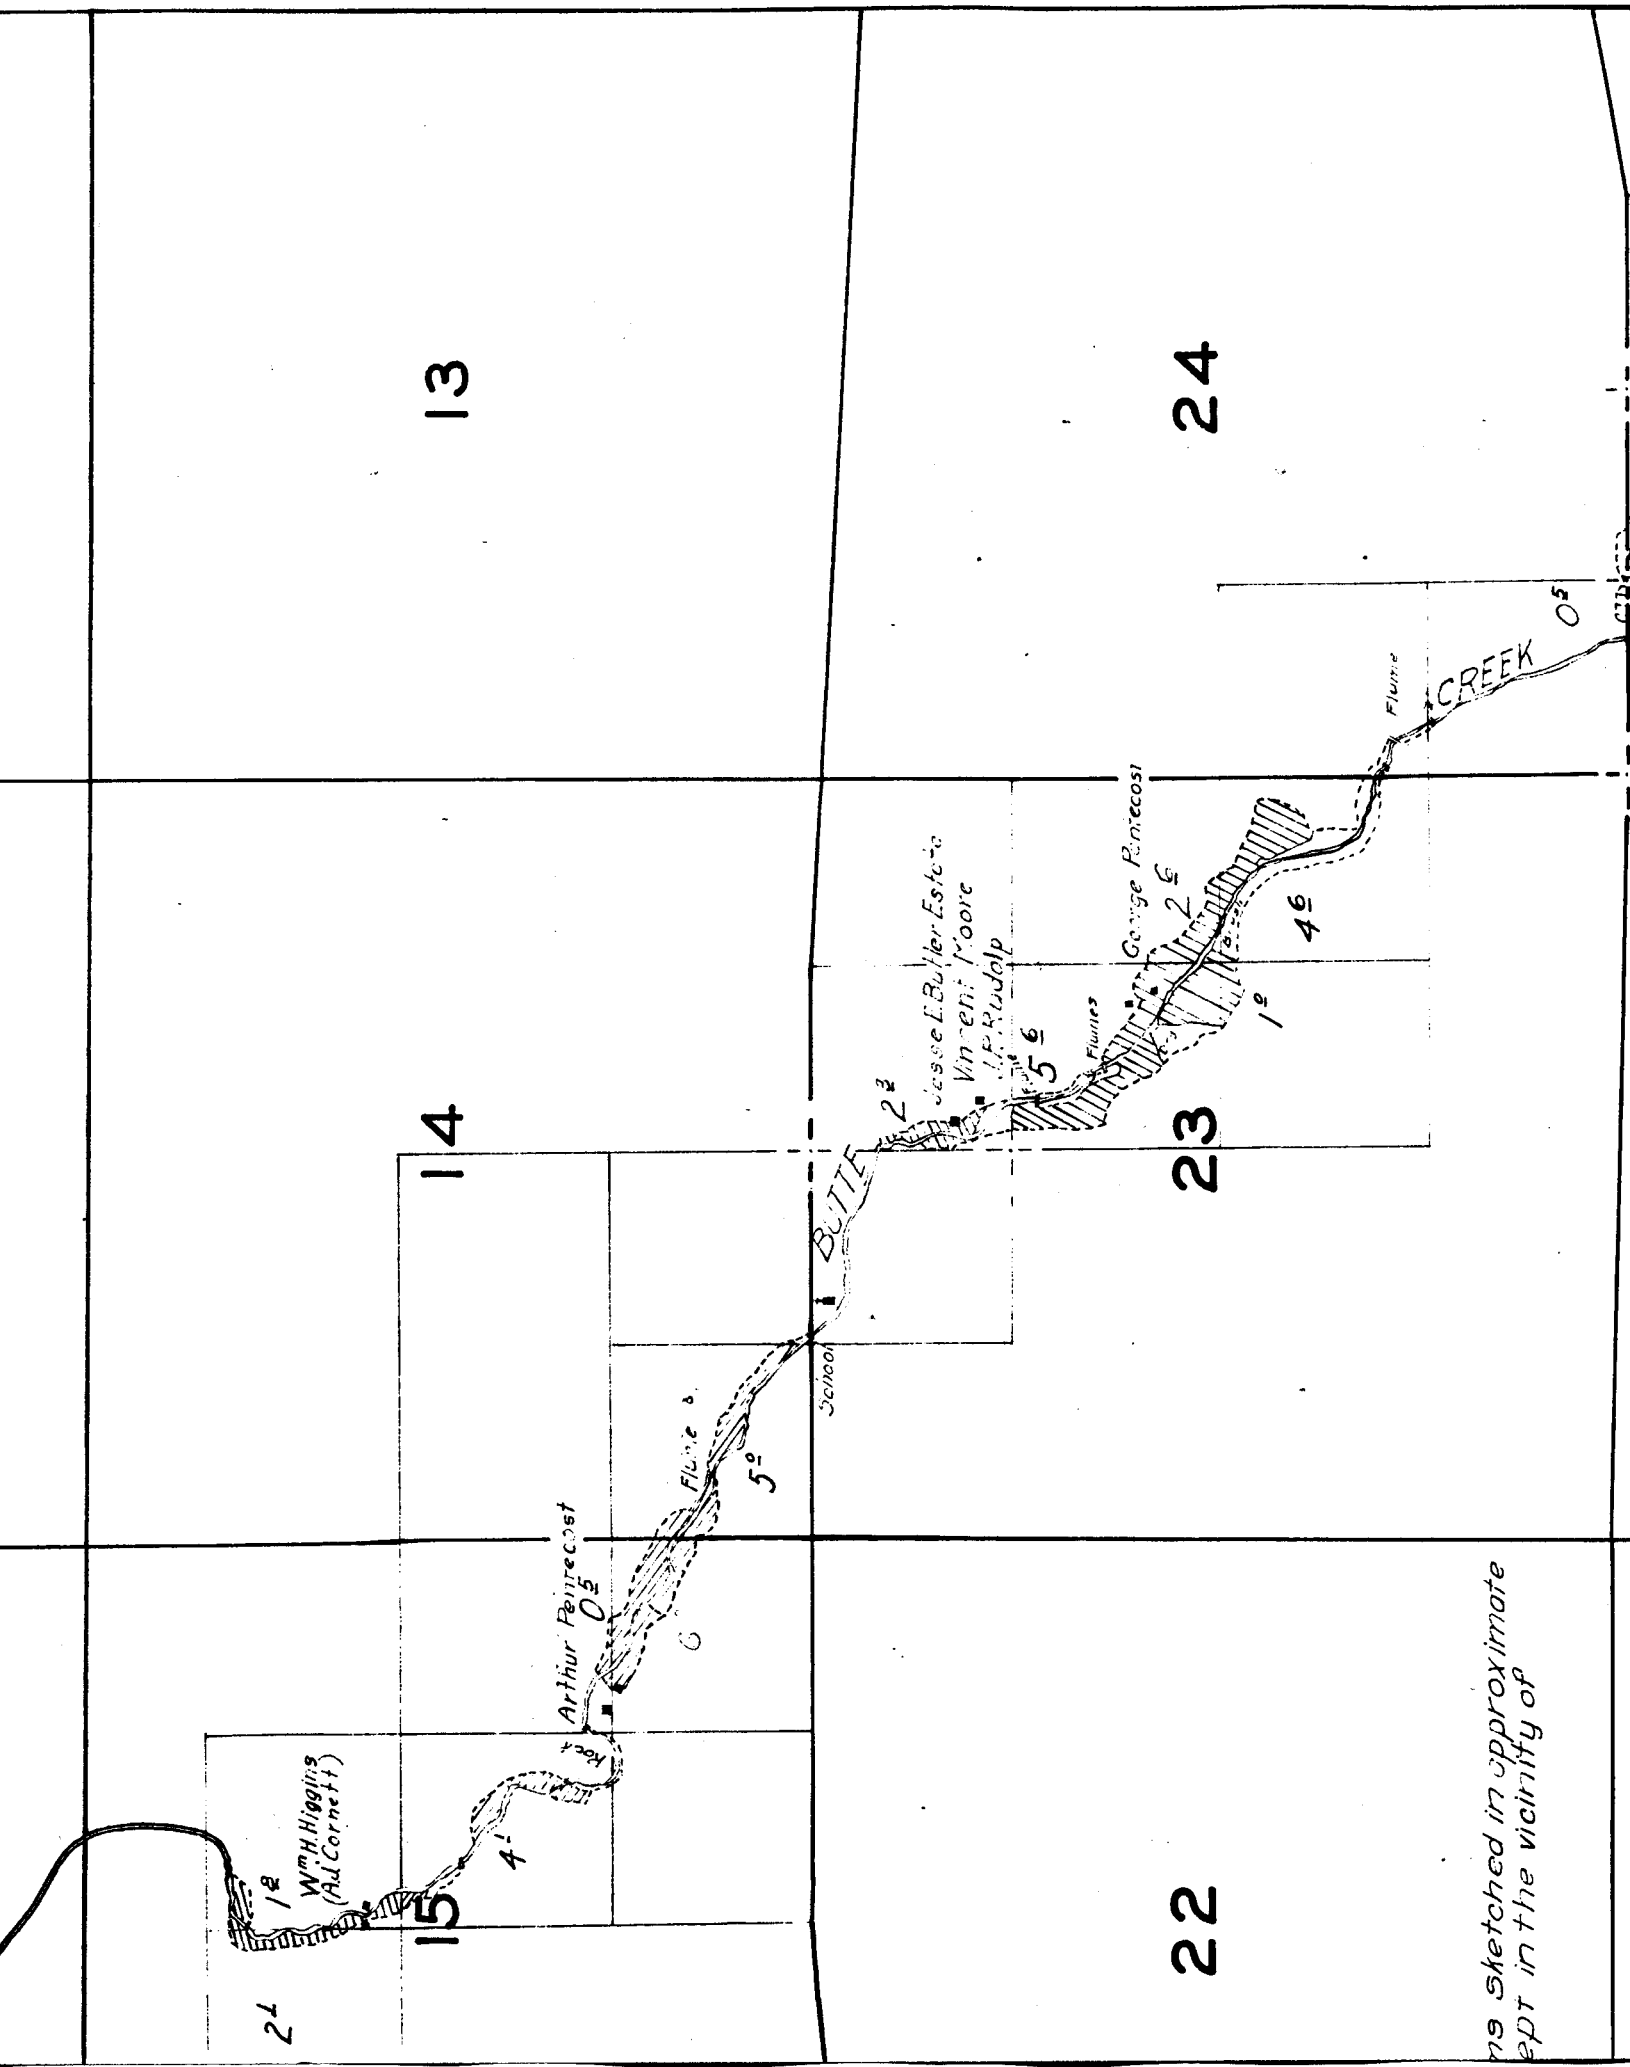


ns sketched in approximate
 ept in the vicinity of

5

8

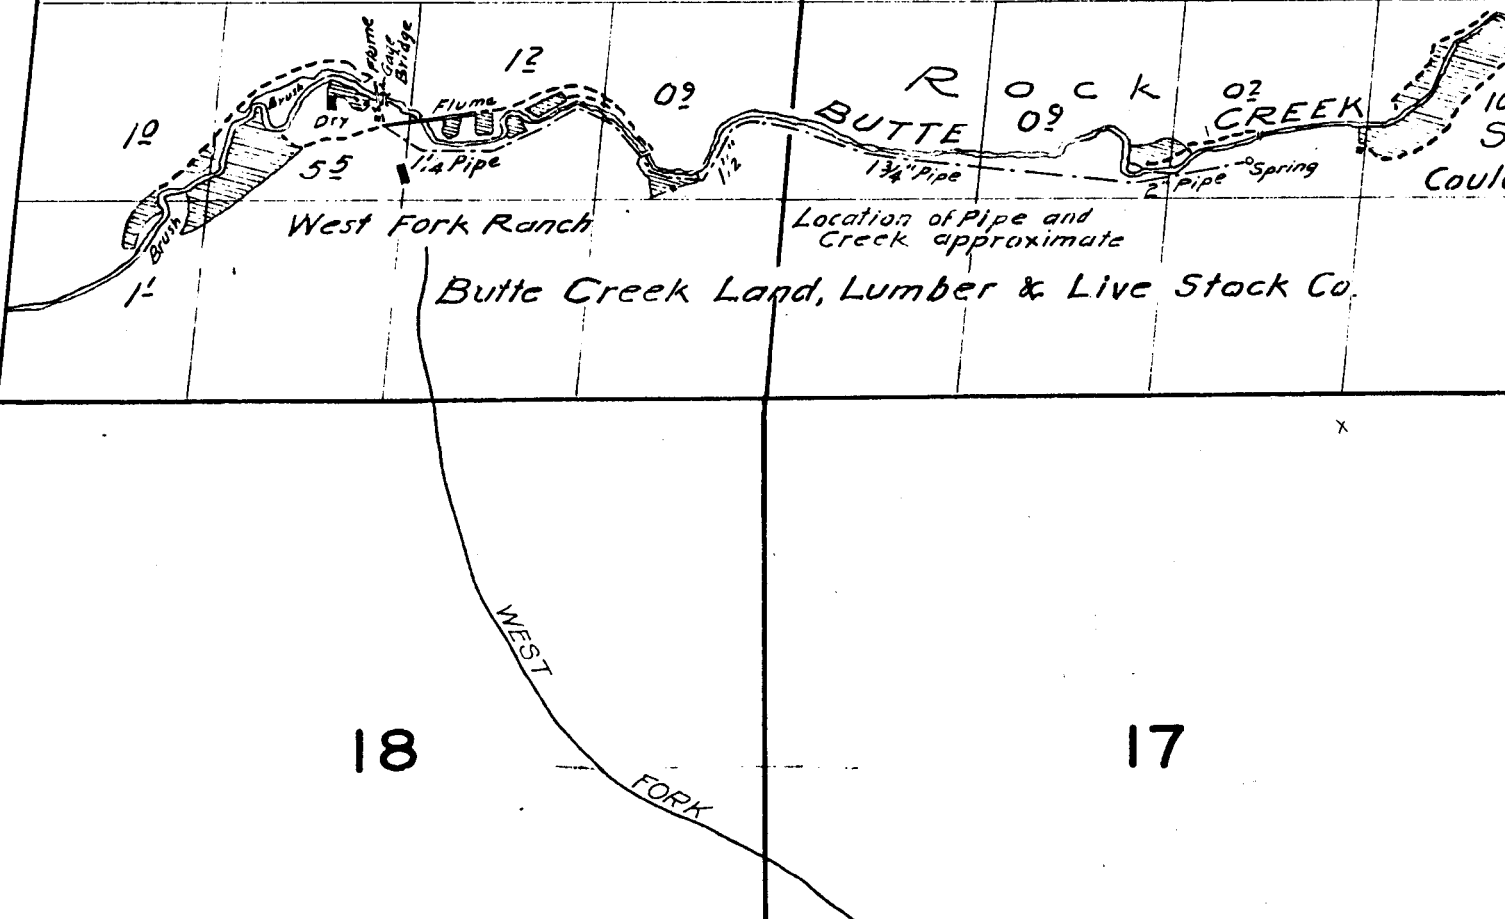

TOWNSHIP 6 S., RANGE 20 E.

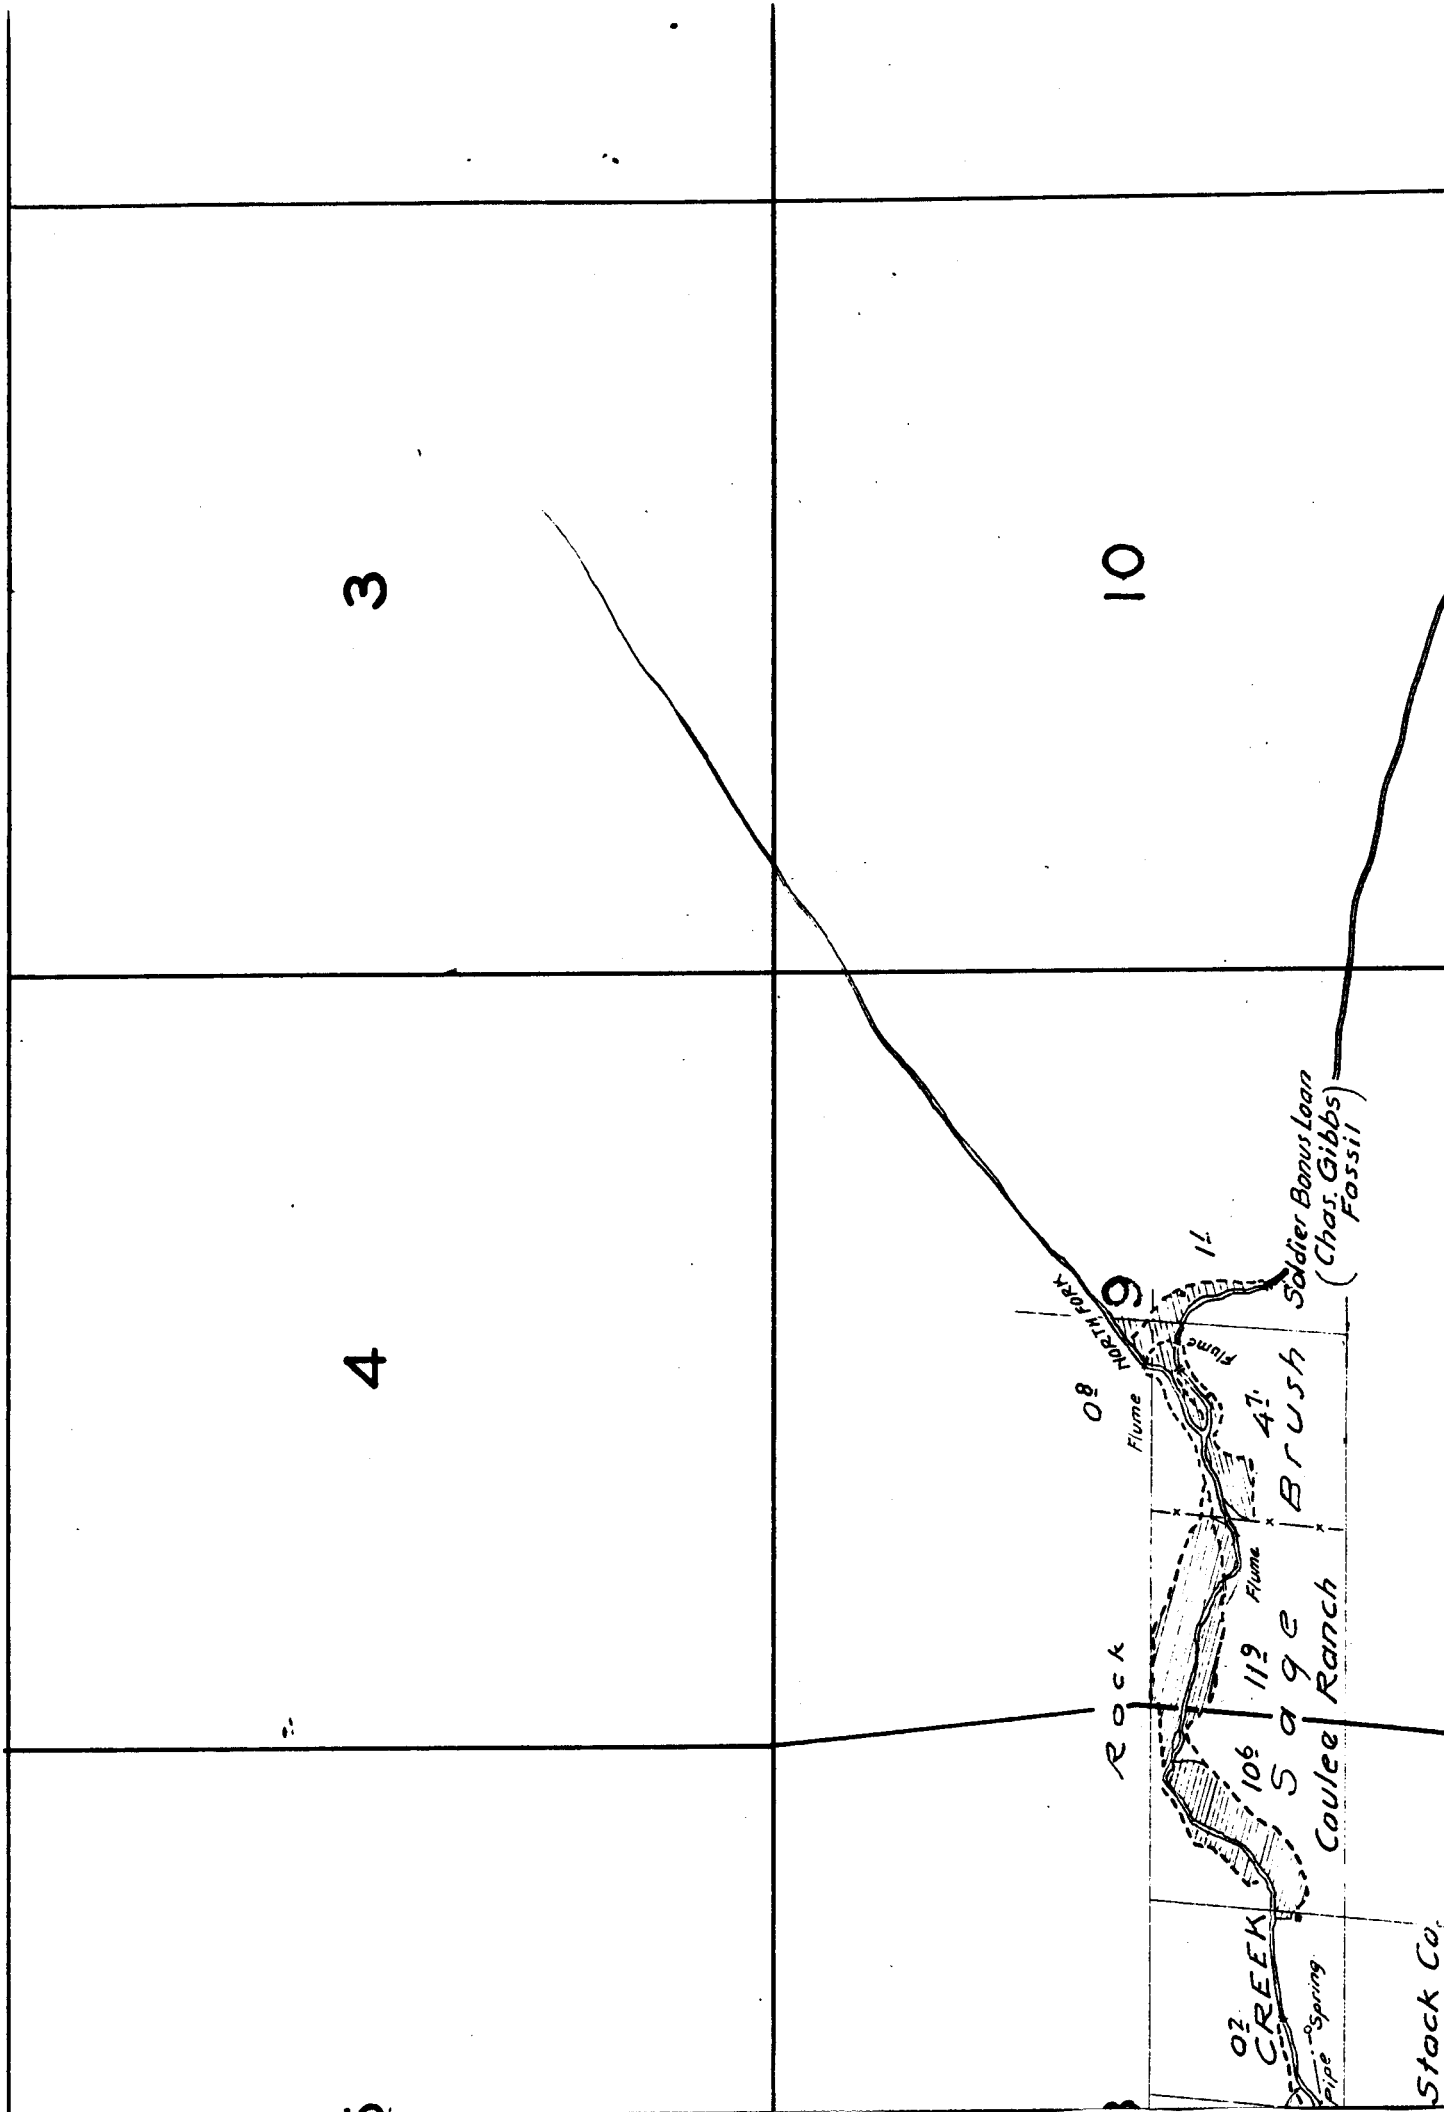

Stock Co.

x

Surveyed Nov. 14 to 18, 1925.

16

24

18

Wm. H. Higgins
(Ad. Cornett)

15

41

Keok

Arthur Penrecoast

05

Flume 1

6

5°

Schoe

21

22

NOTE: Streams sketched in approximate location except in the vicinity of irrigated land.

Surveyed Nov. 14 to 18, 1925.

16

21

17

20

CREEK

FORK

WEST

18

19

x

28

33

29

32

30

31

21

22

NOTE: Streams sketched in approximate location except in the vicinity of irrigated land.

28

27

33

34

2

1

11

12

14

13