


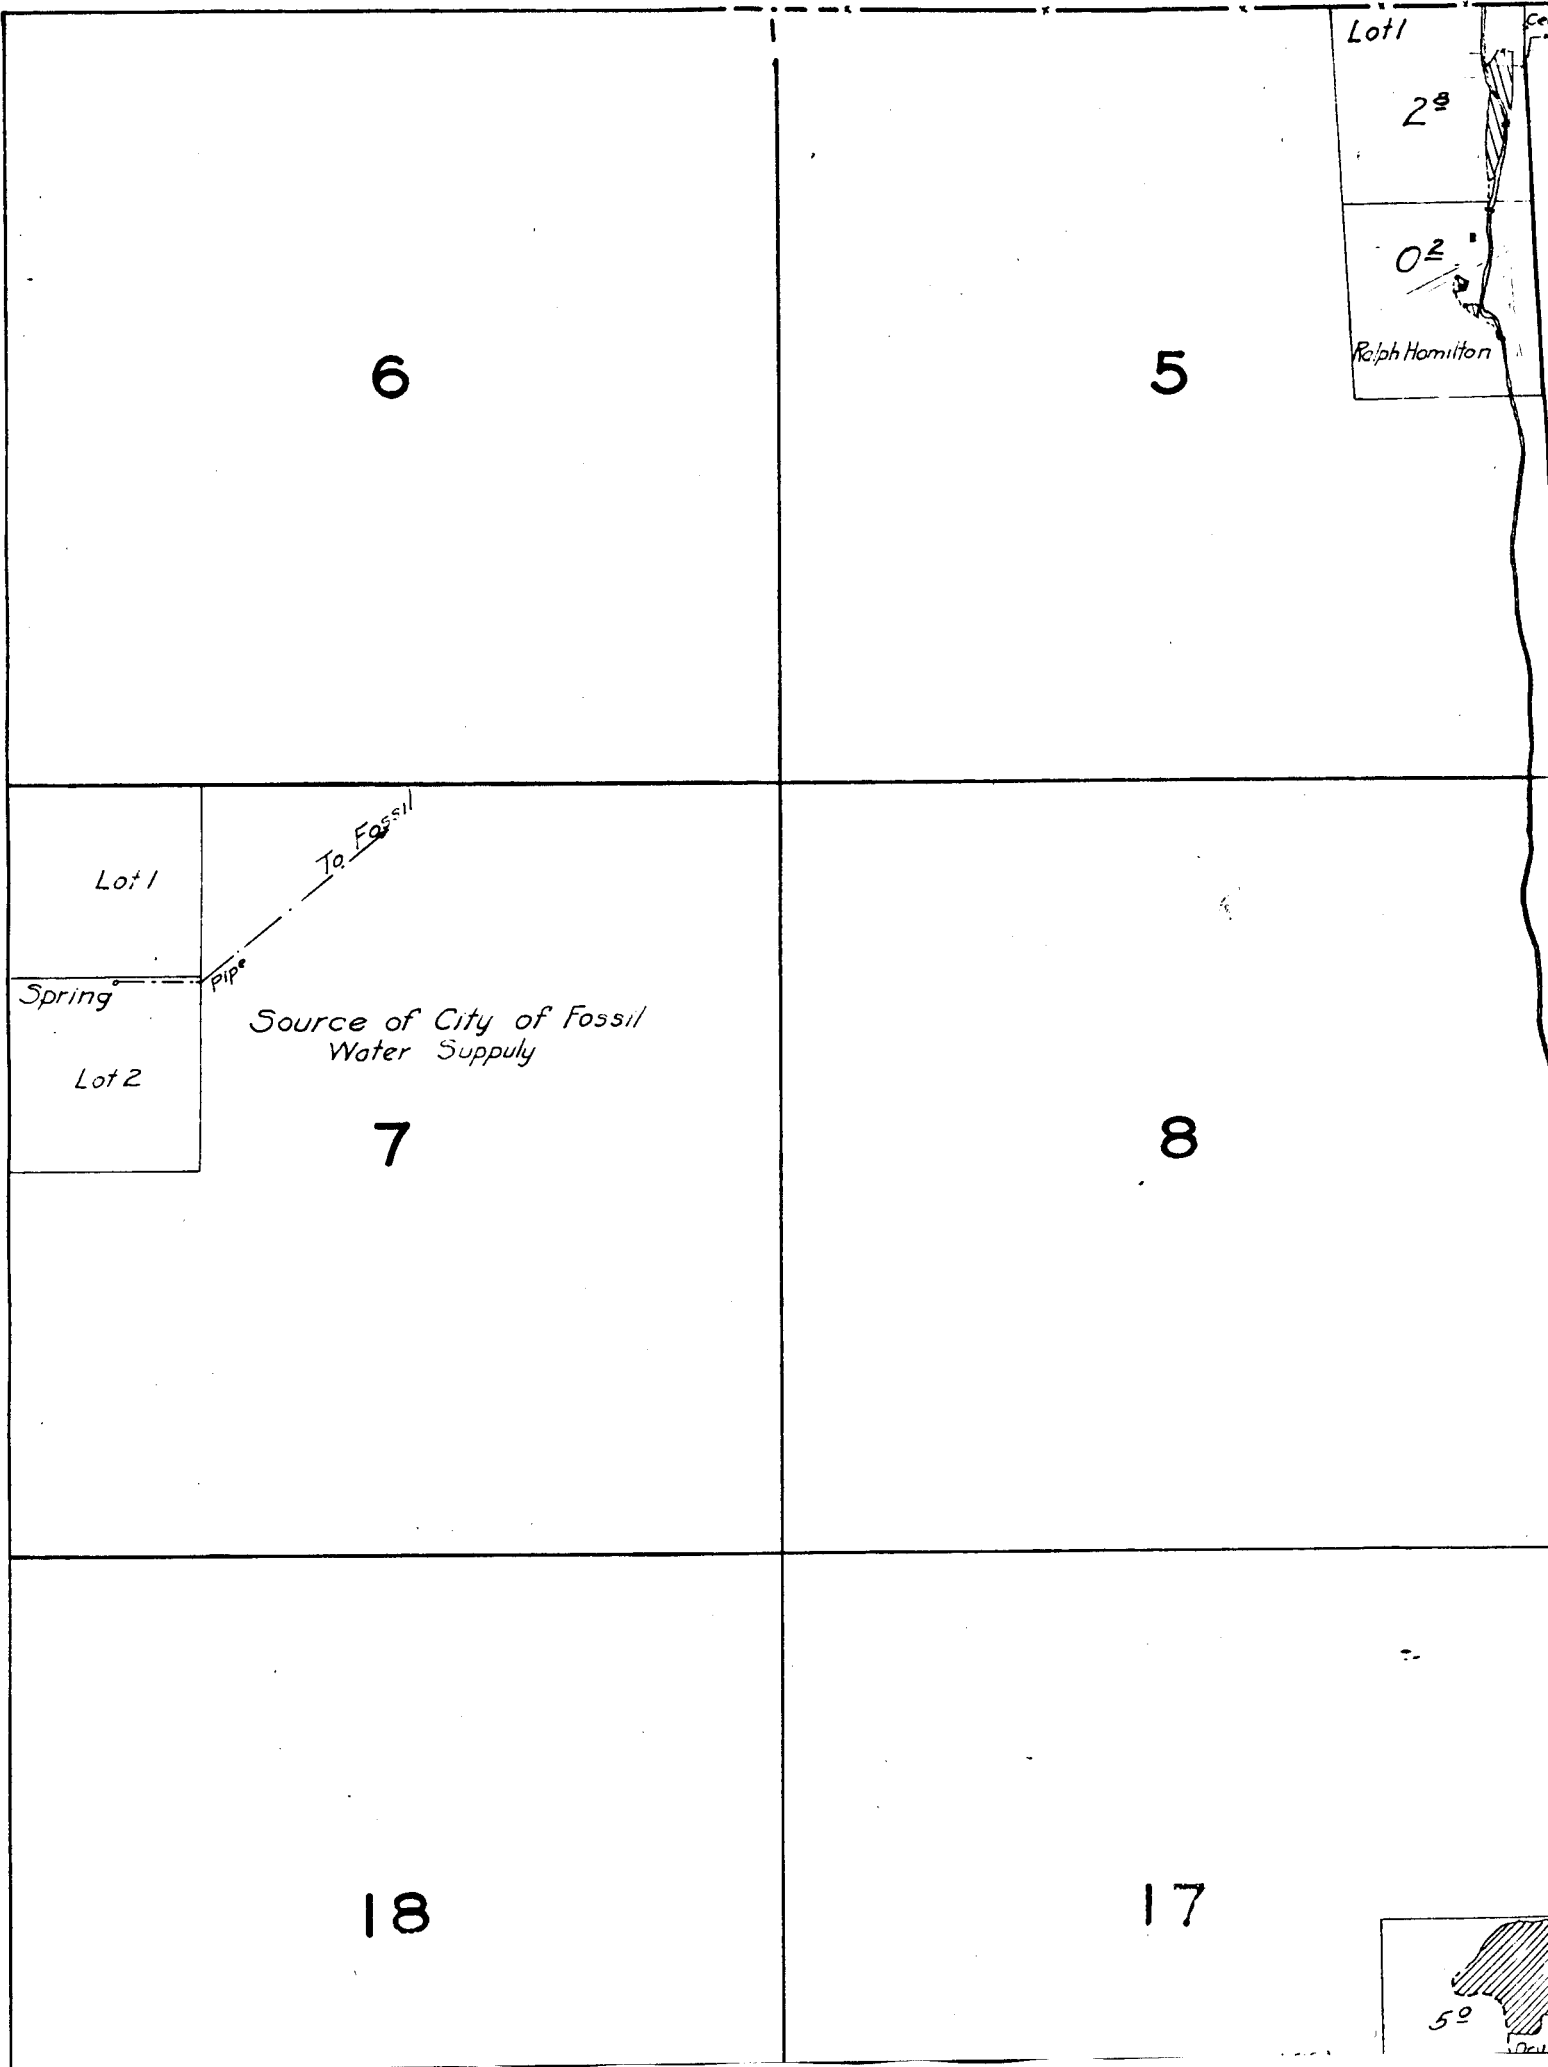

6

5

Lot 1

2<sup>nd</sup>

02

Ralph Hamilton

Lot 1

Spring

Lot 2

To Fossil

pipe

Source of City of Fossil  
Water Supply


7

8

18

17

5<sup>th</sup>

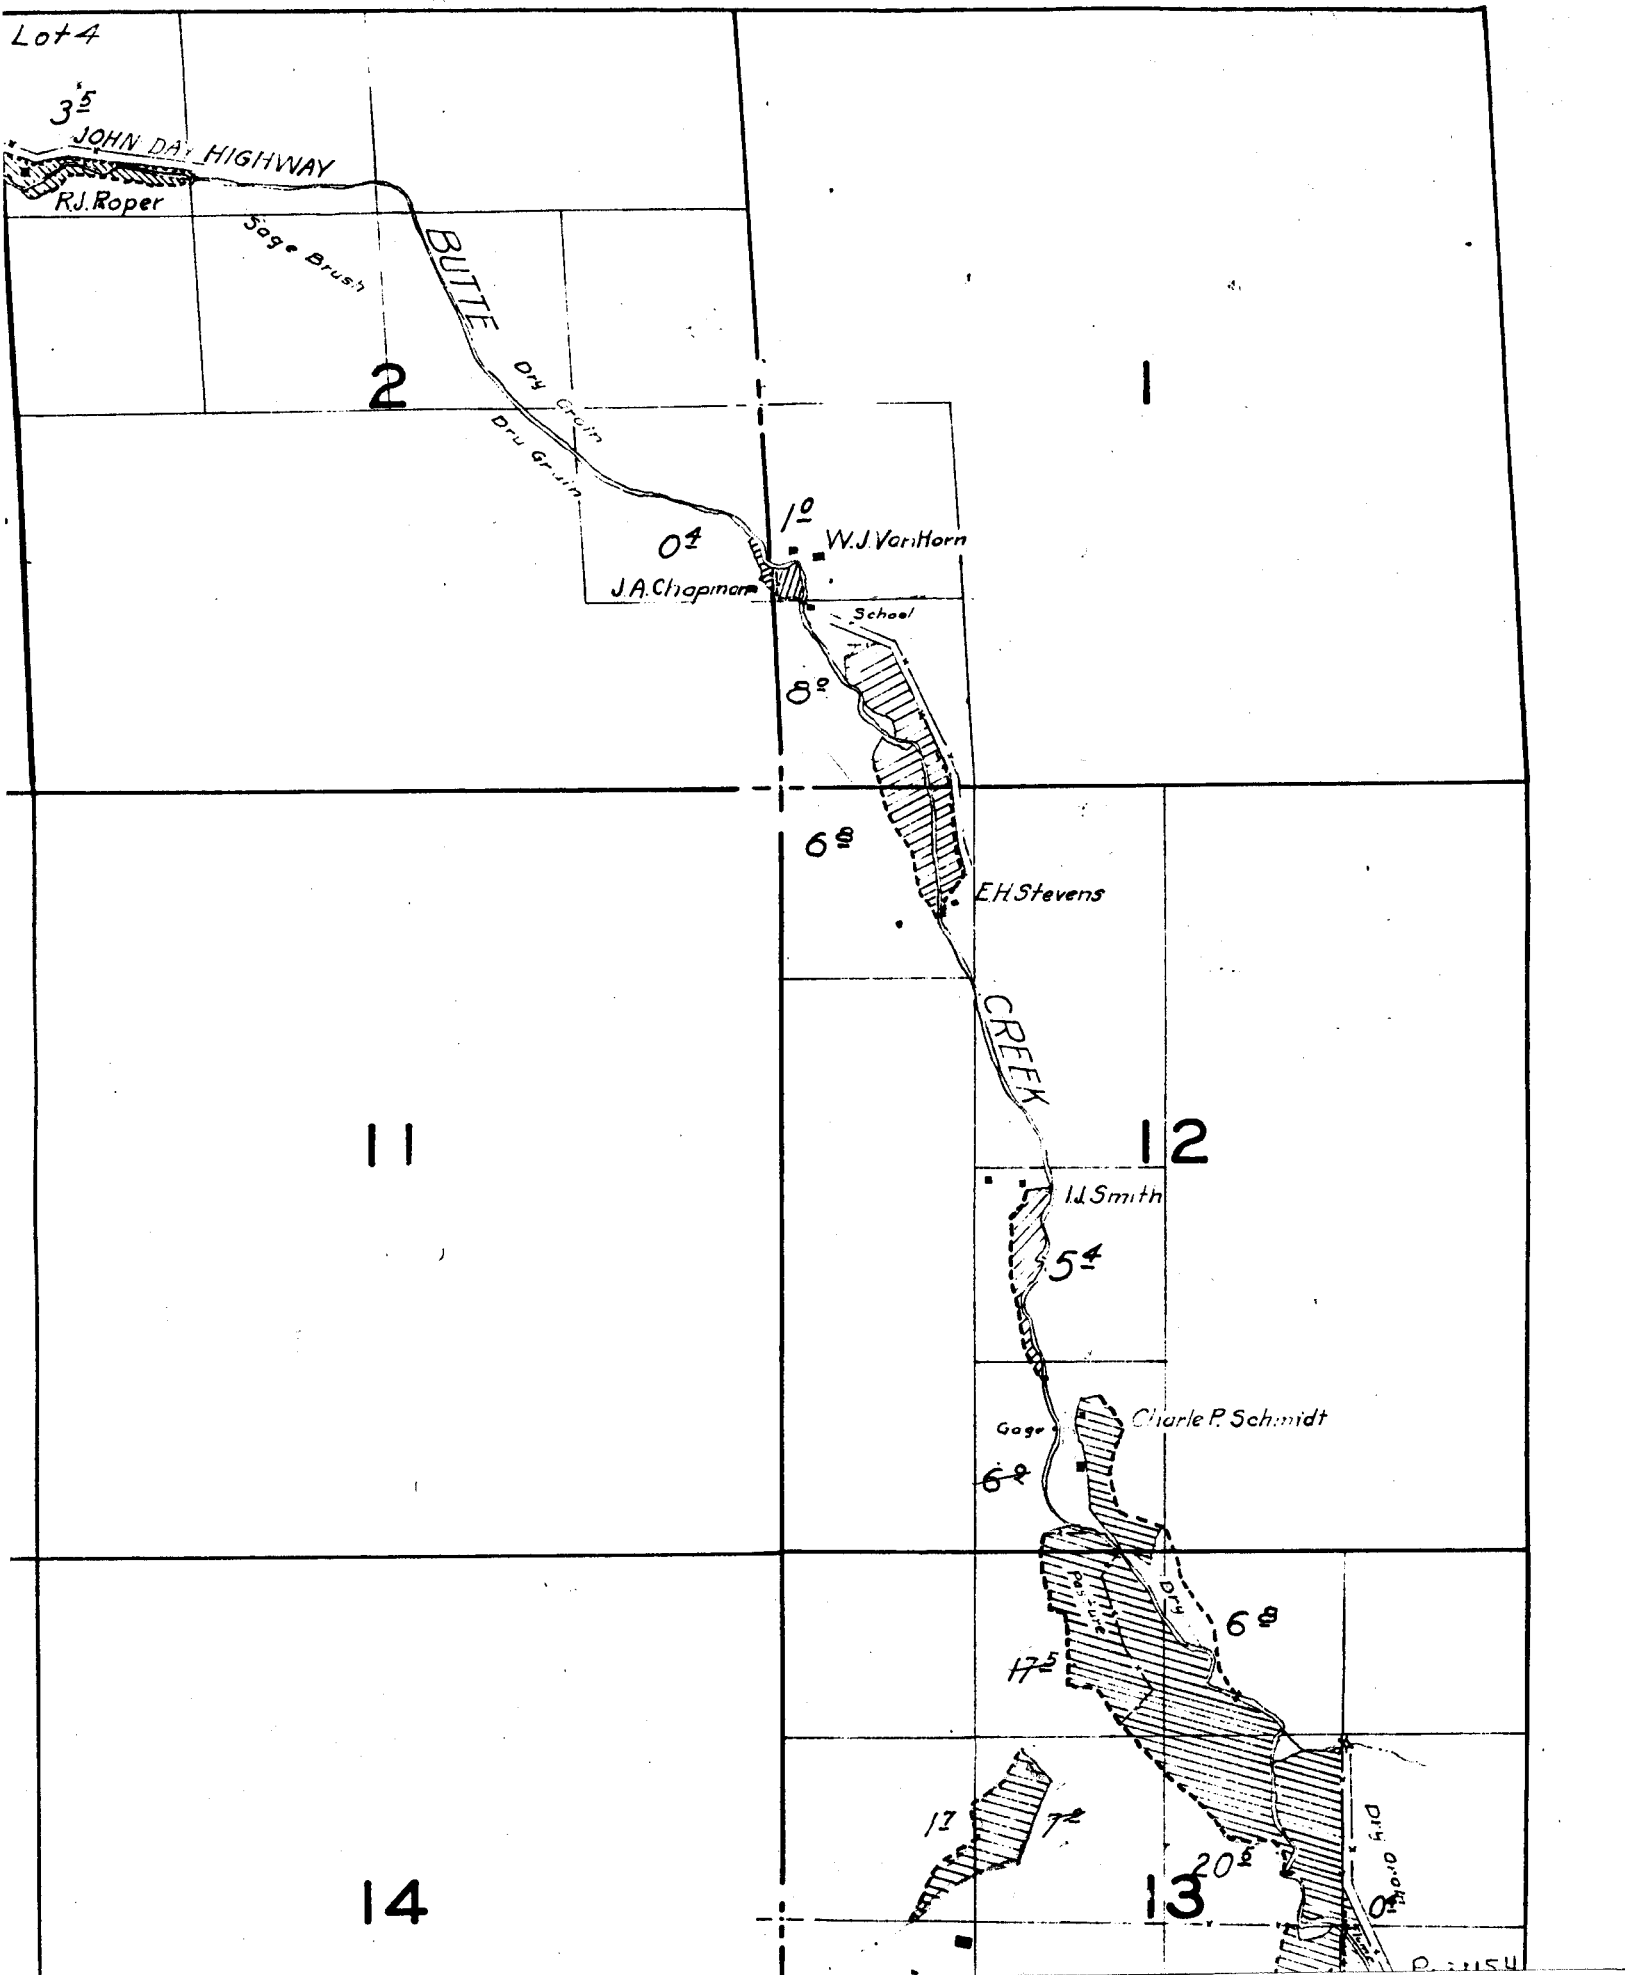

21

22

2<sup>d</sup>  
FWBall

*Note: Location according  
to Mr. Ball.*

School

28

27

33

34


Note: Streams not in th.  
irrigated lands sketched.

COTTONWOOD

18

17

16

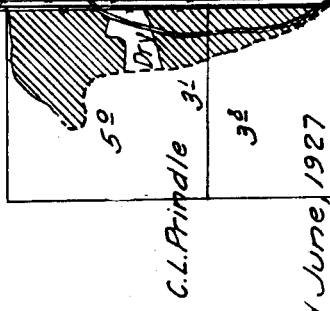

19

20

21

28


29

30


33

32

31

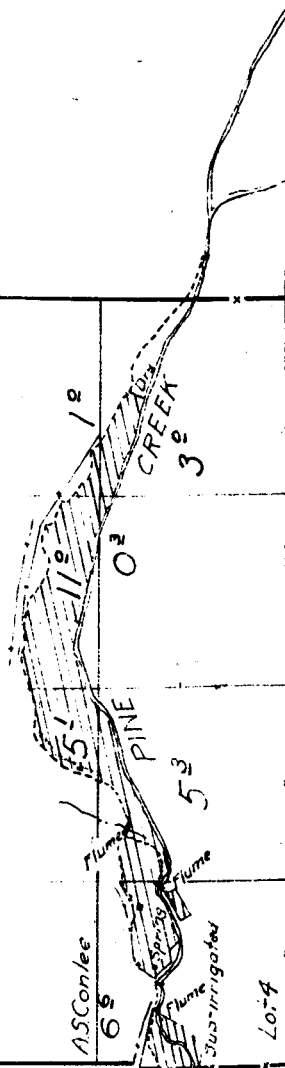

# TOWNSHIP 7 S., RANGE 21 E.

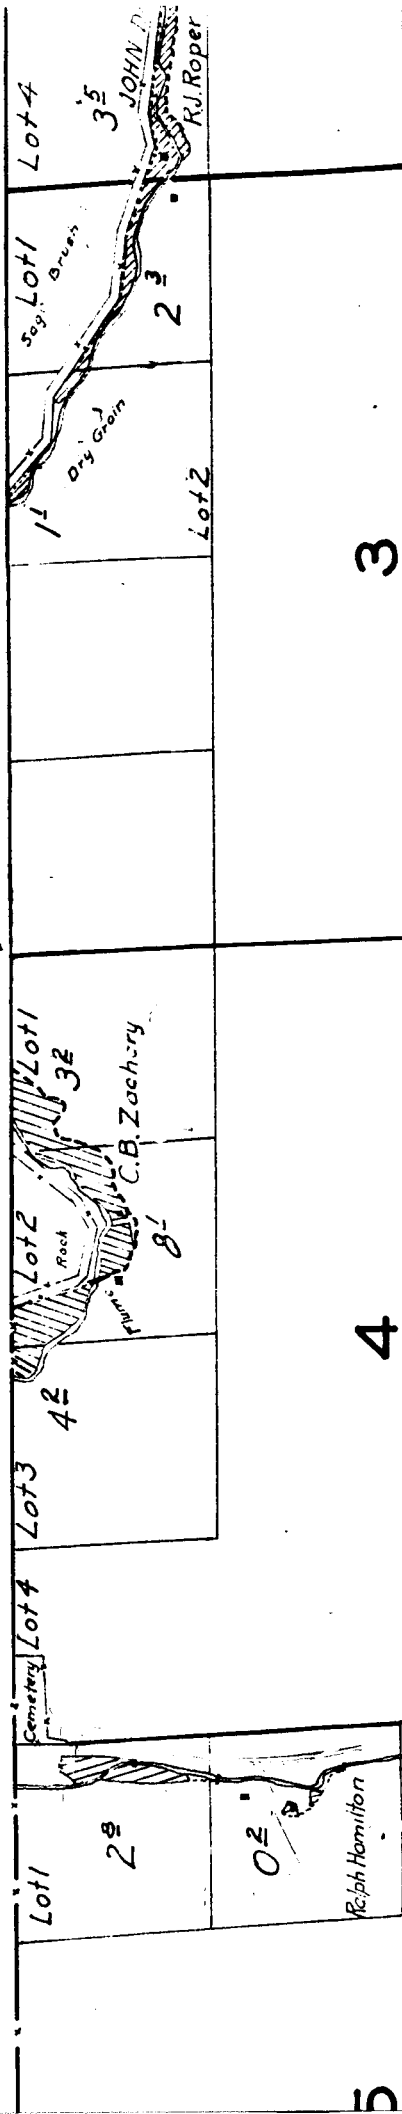

3

4

5

10

9

8


Note: Streams not in the vicinity of  
irrigated lands sketched in approximate location.

COTTONWOOD

15

16

7

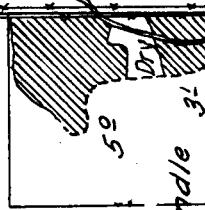

C.L. Prindle 30

30

veyed June, 1927

CREEK

22

21

0

Note: Location according  
to Mr. Ball  
School  
FWBall  
2°



27


26

25

34


35

36

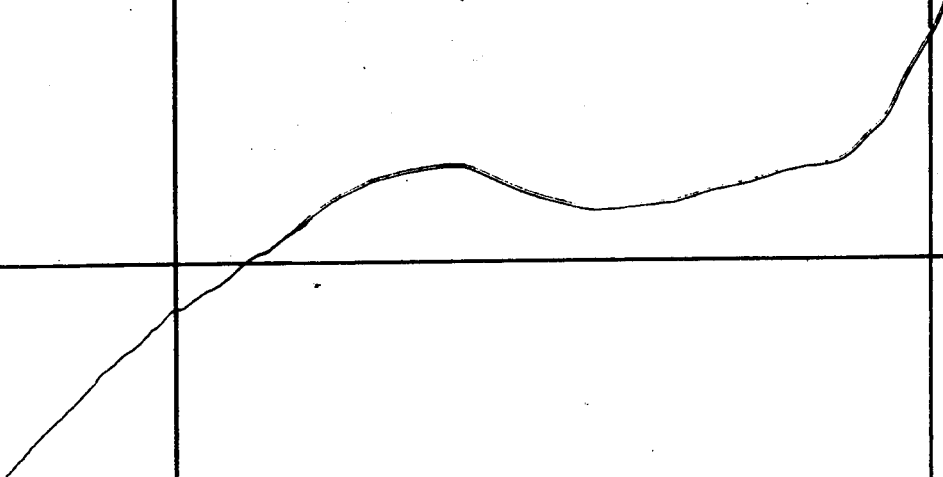

15

14

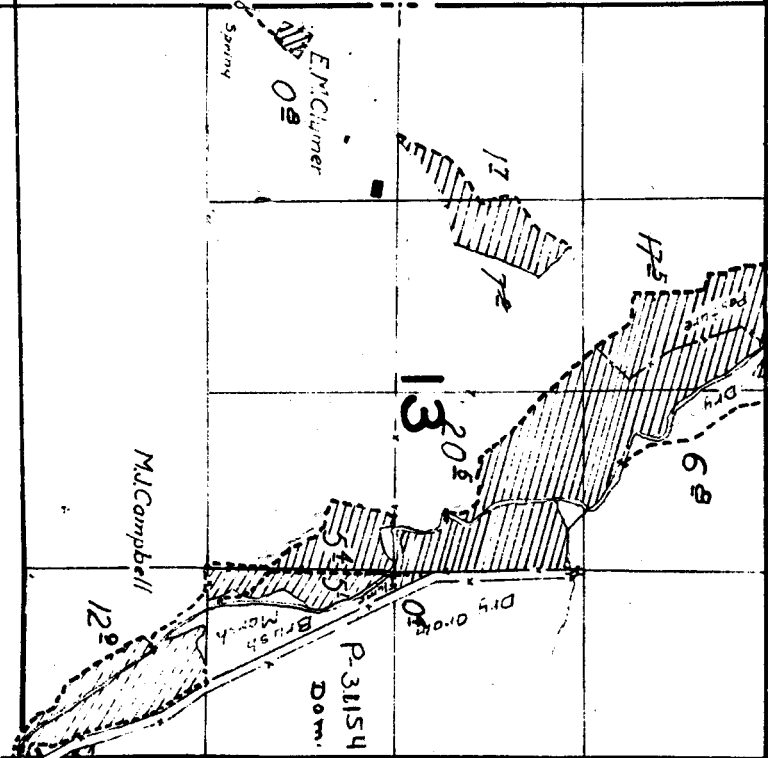

22

*Location according  
to Mr. Boll.*

23

24